


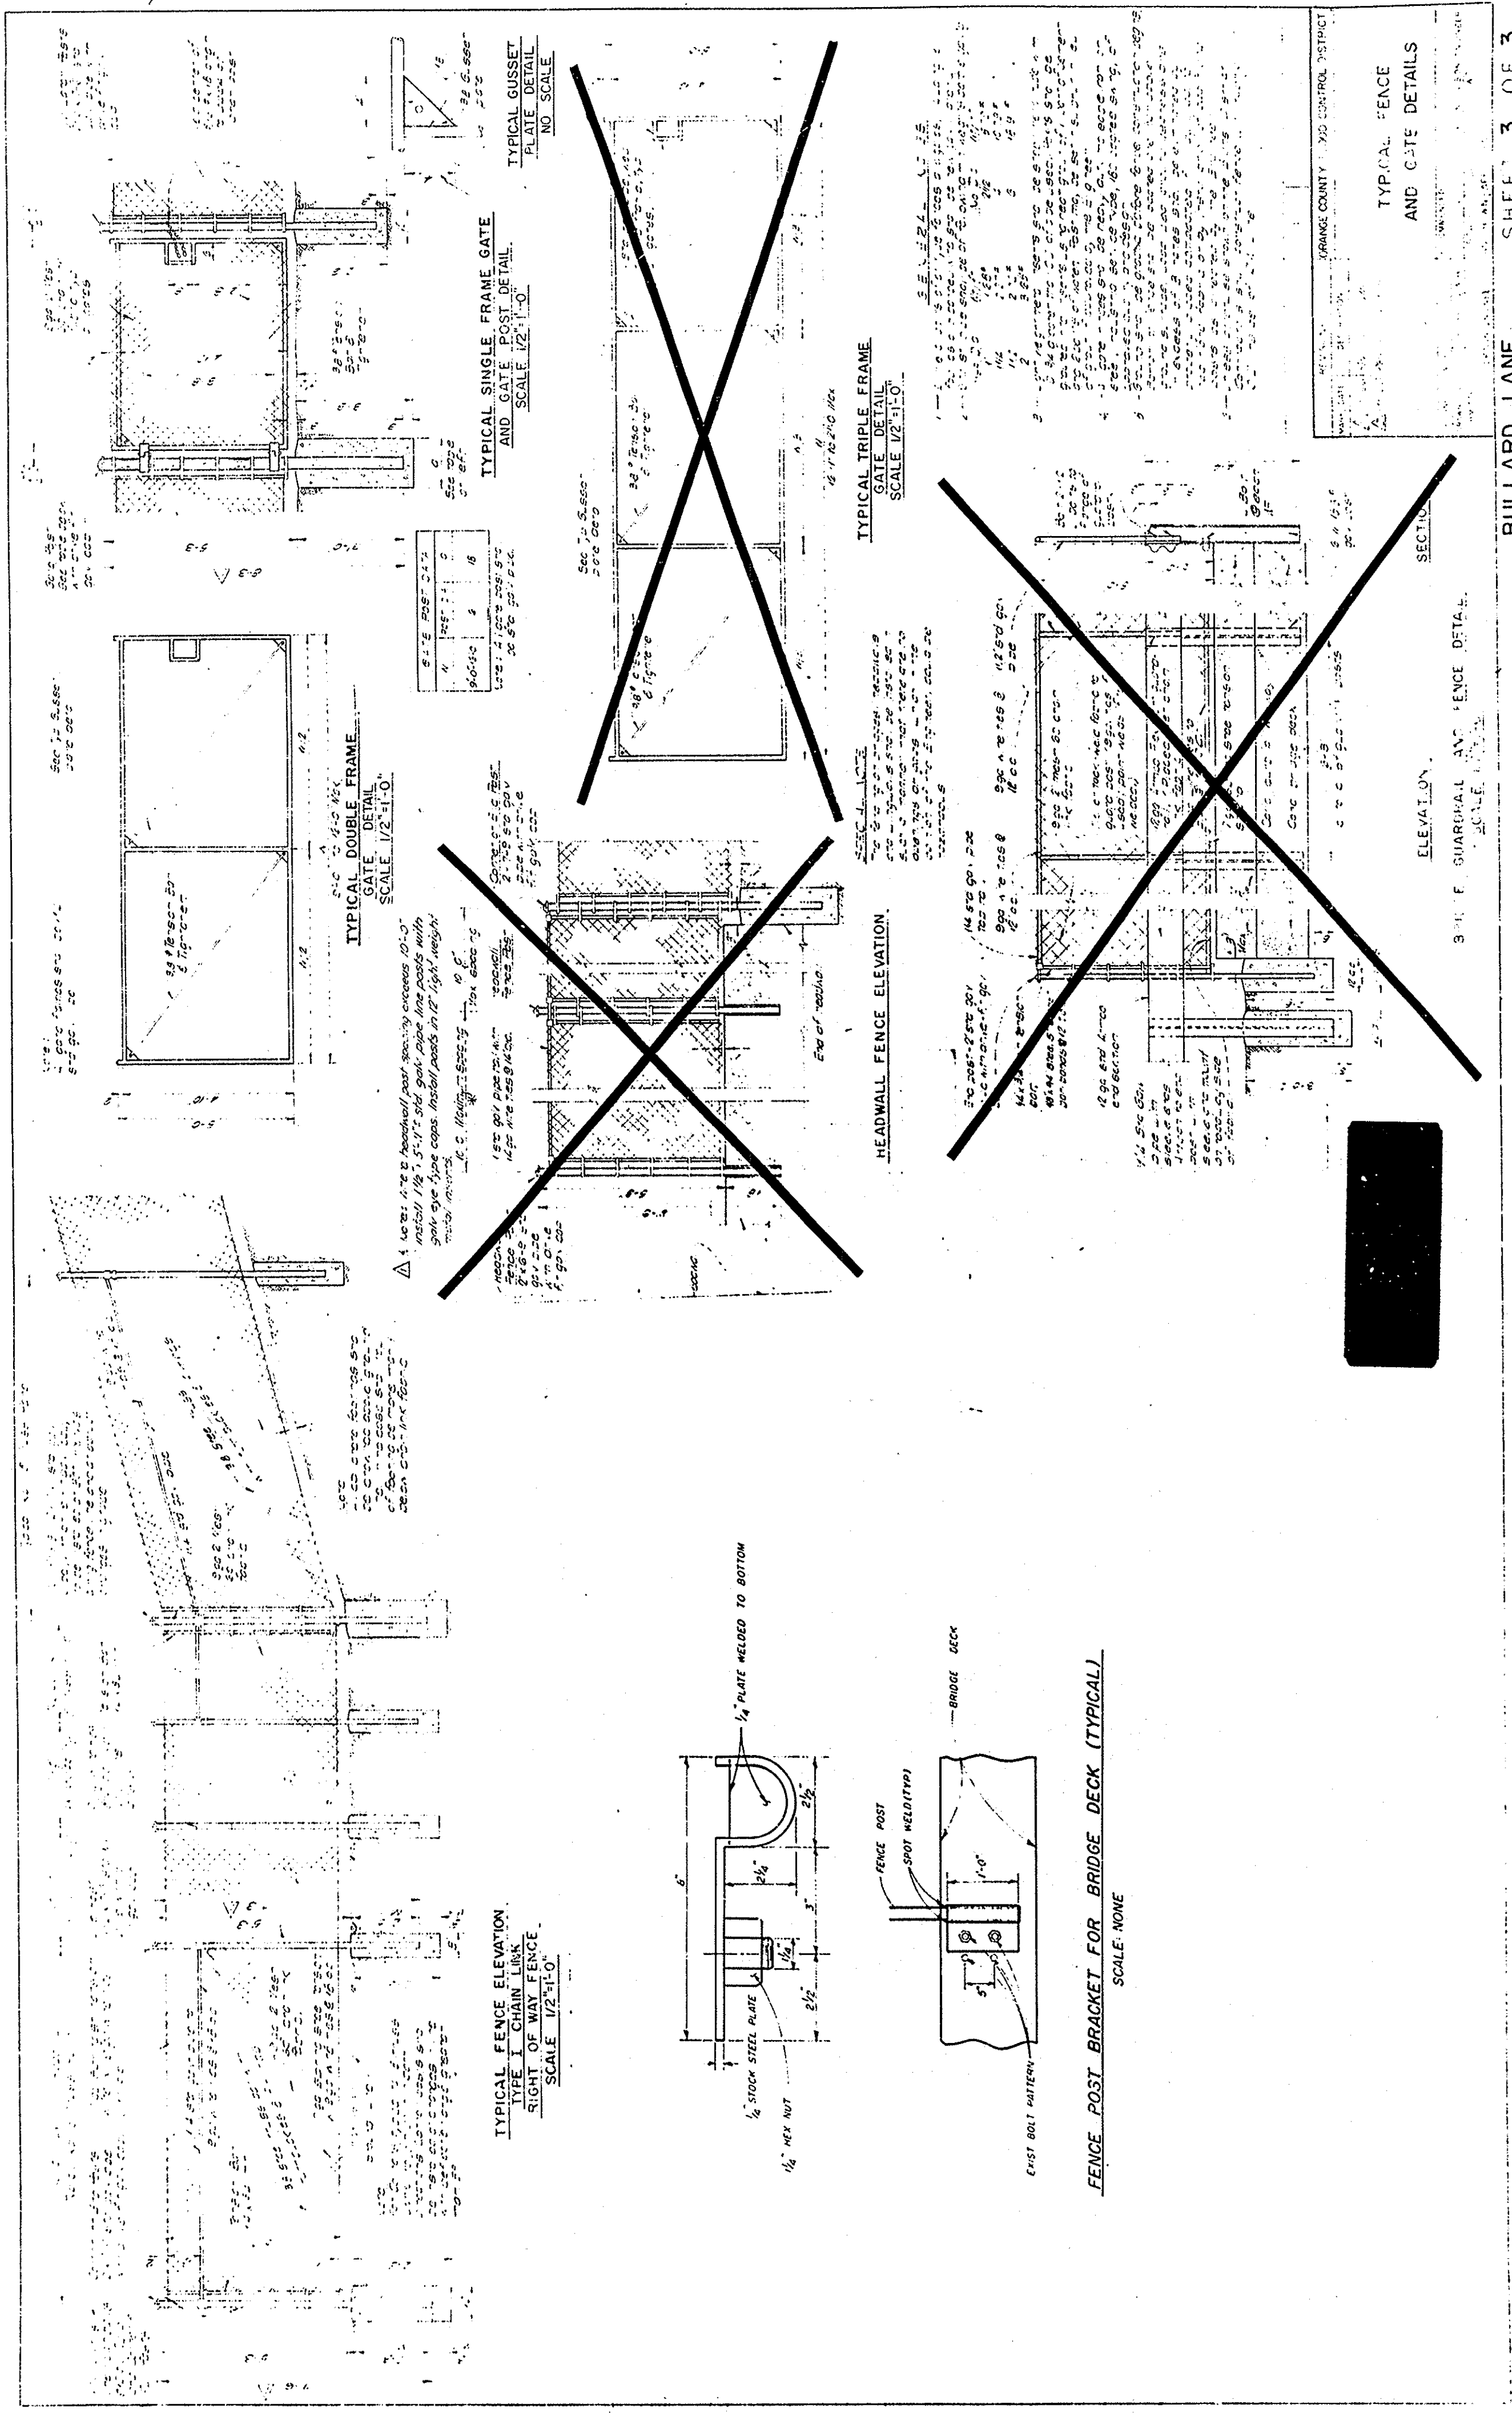

DR. 10 (12095)