



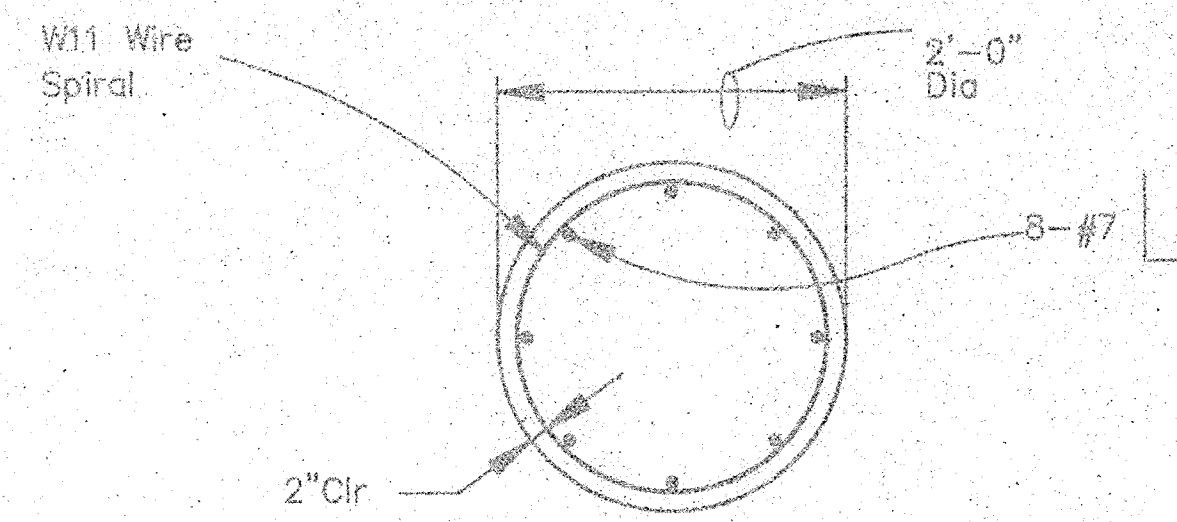


SECTION A-A
SCALE 3/4" = 1'-0"

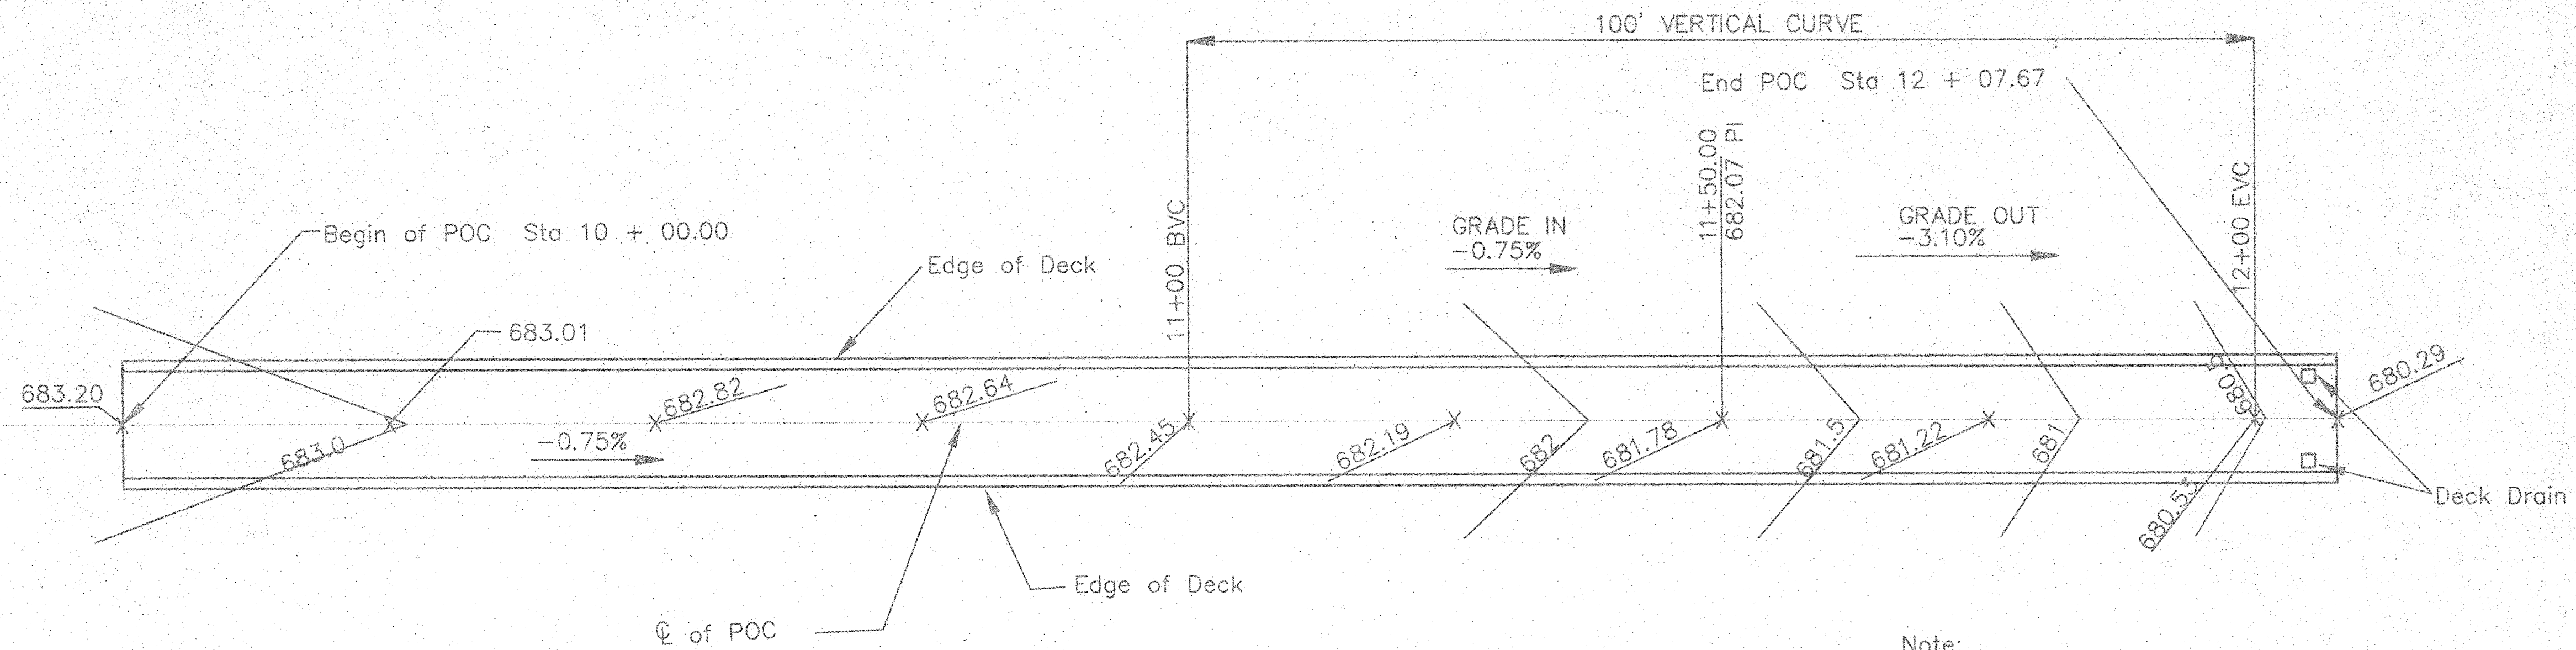


DECK CONTOURS
Scale: 1"=10'

Note:
Contours Do Not Include Camber
Contour Interval 0.5'
X - Indicates Spot Elevation

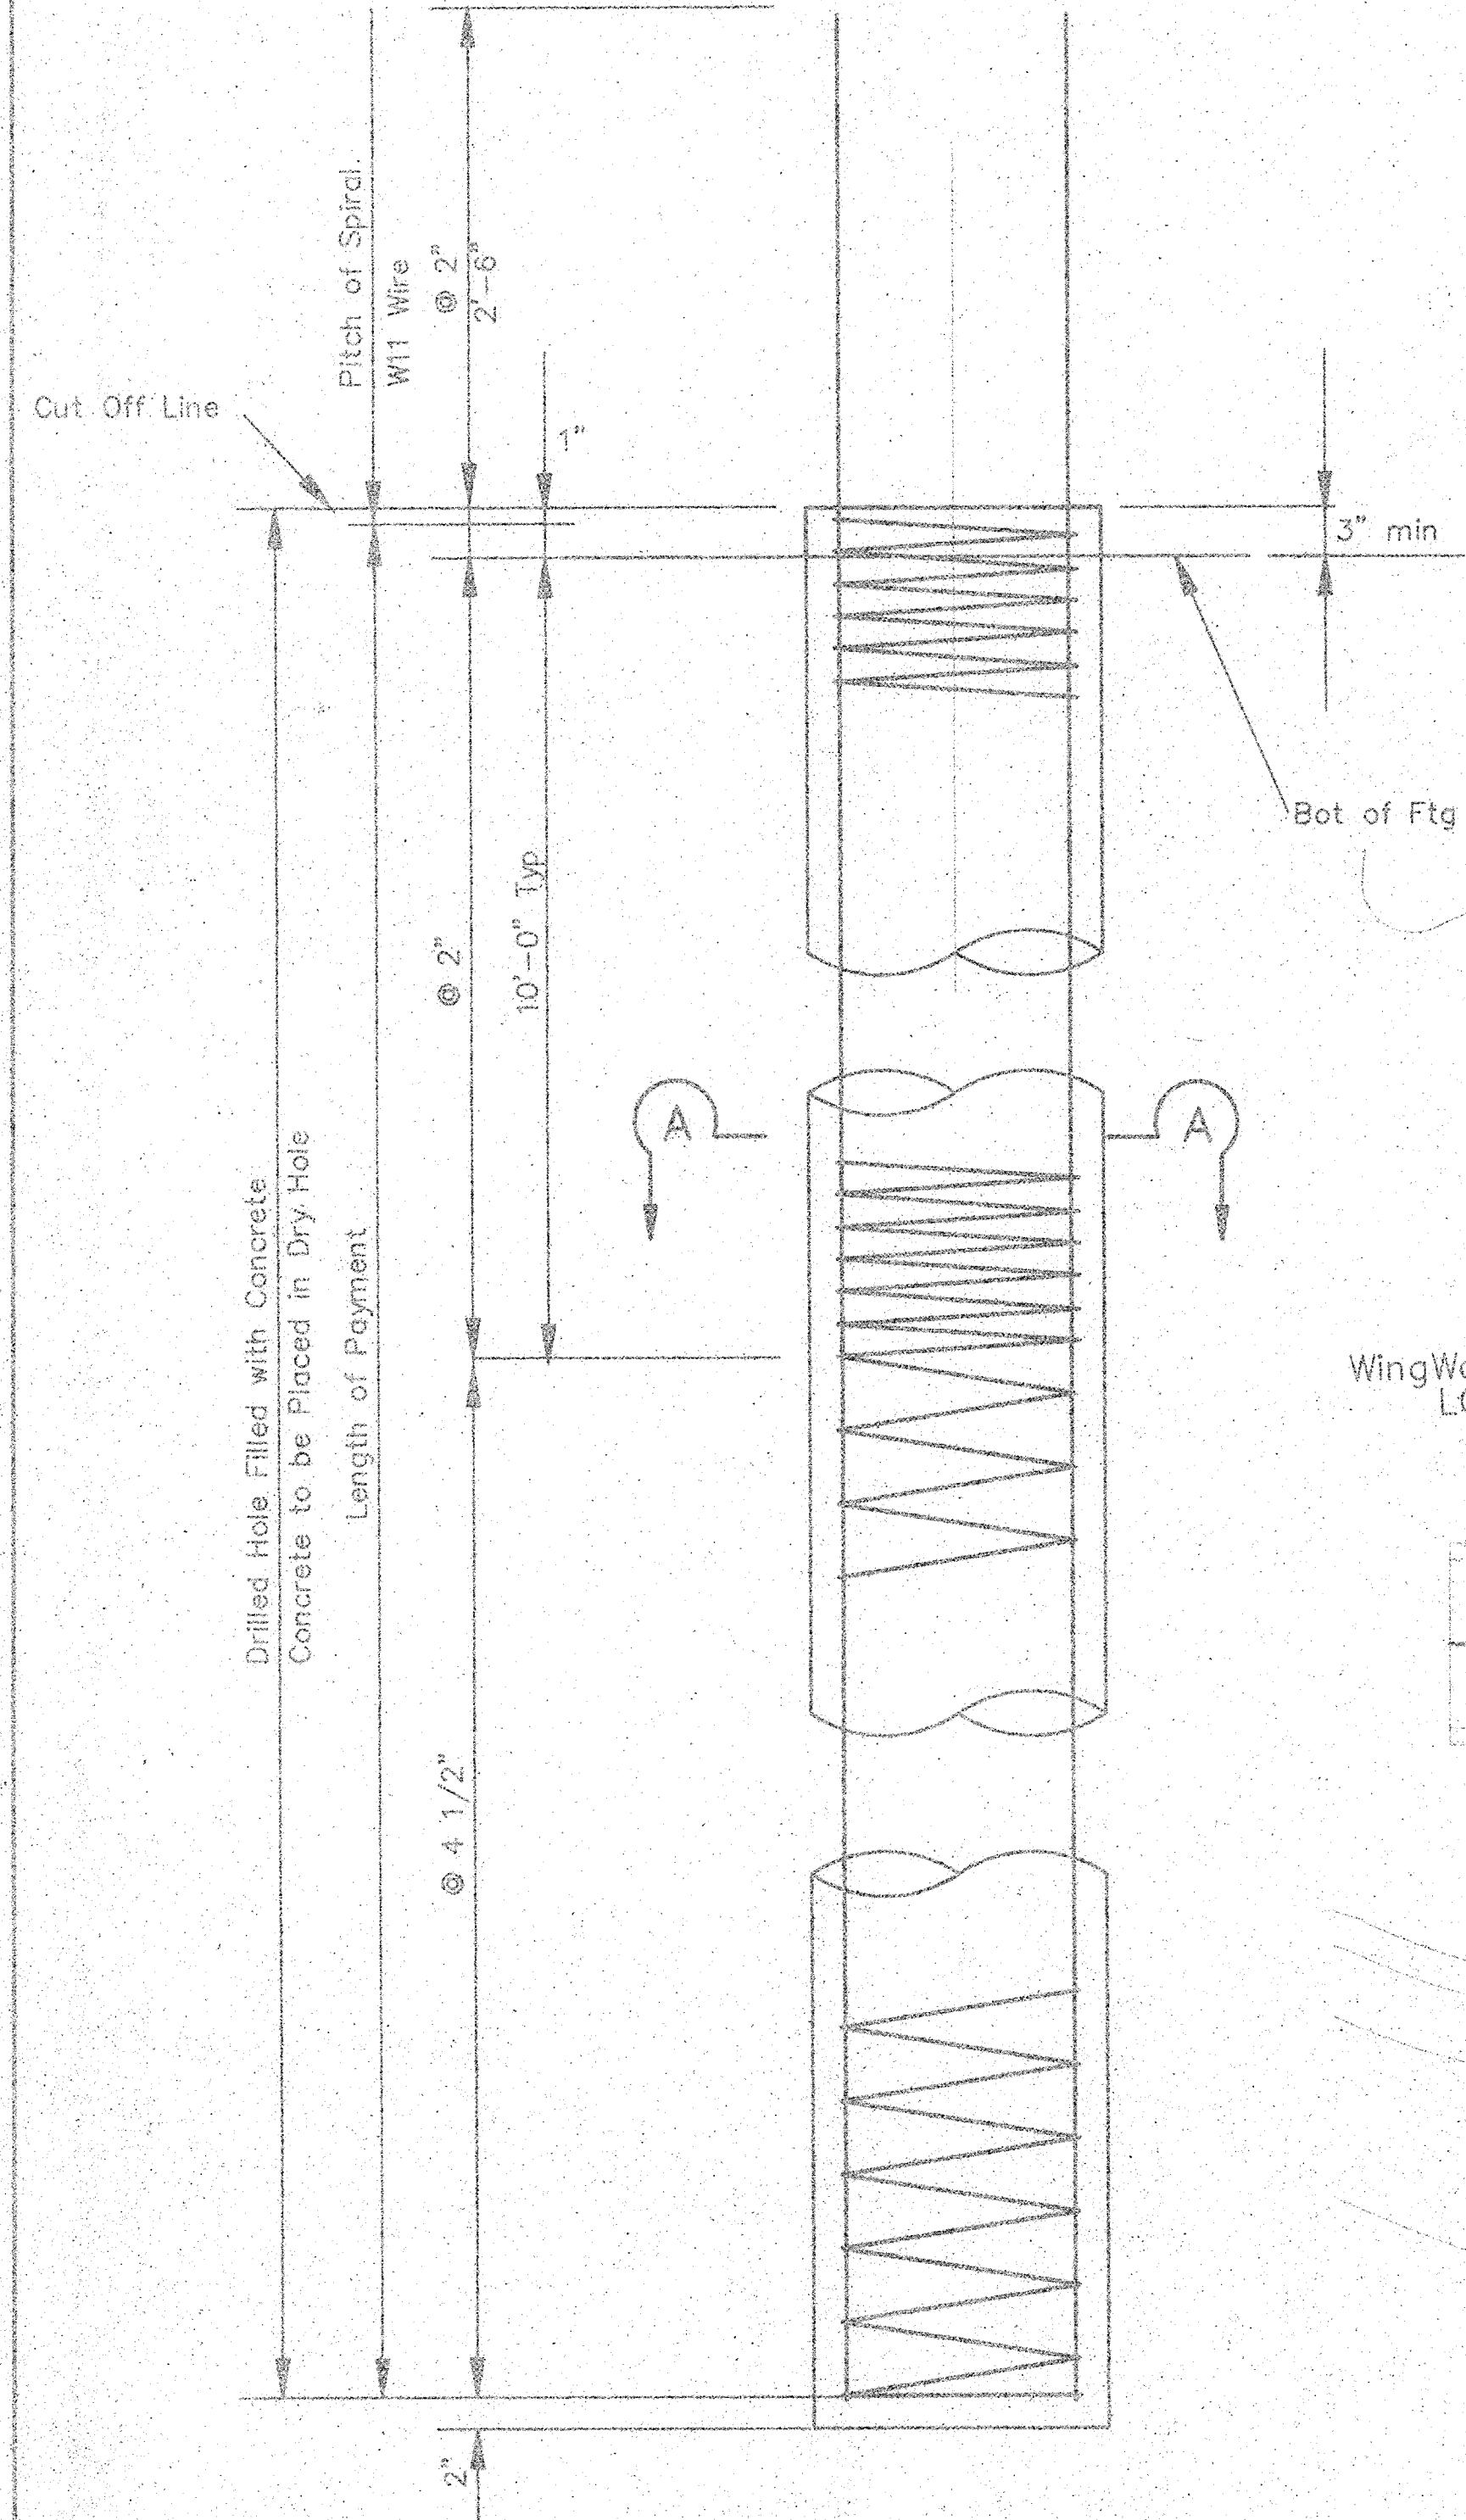

24" CIDH PILE DETAIL
SCALE 3/4" = 1'-0"

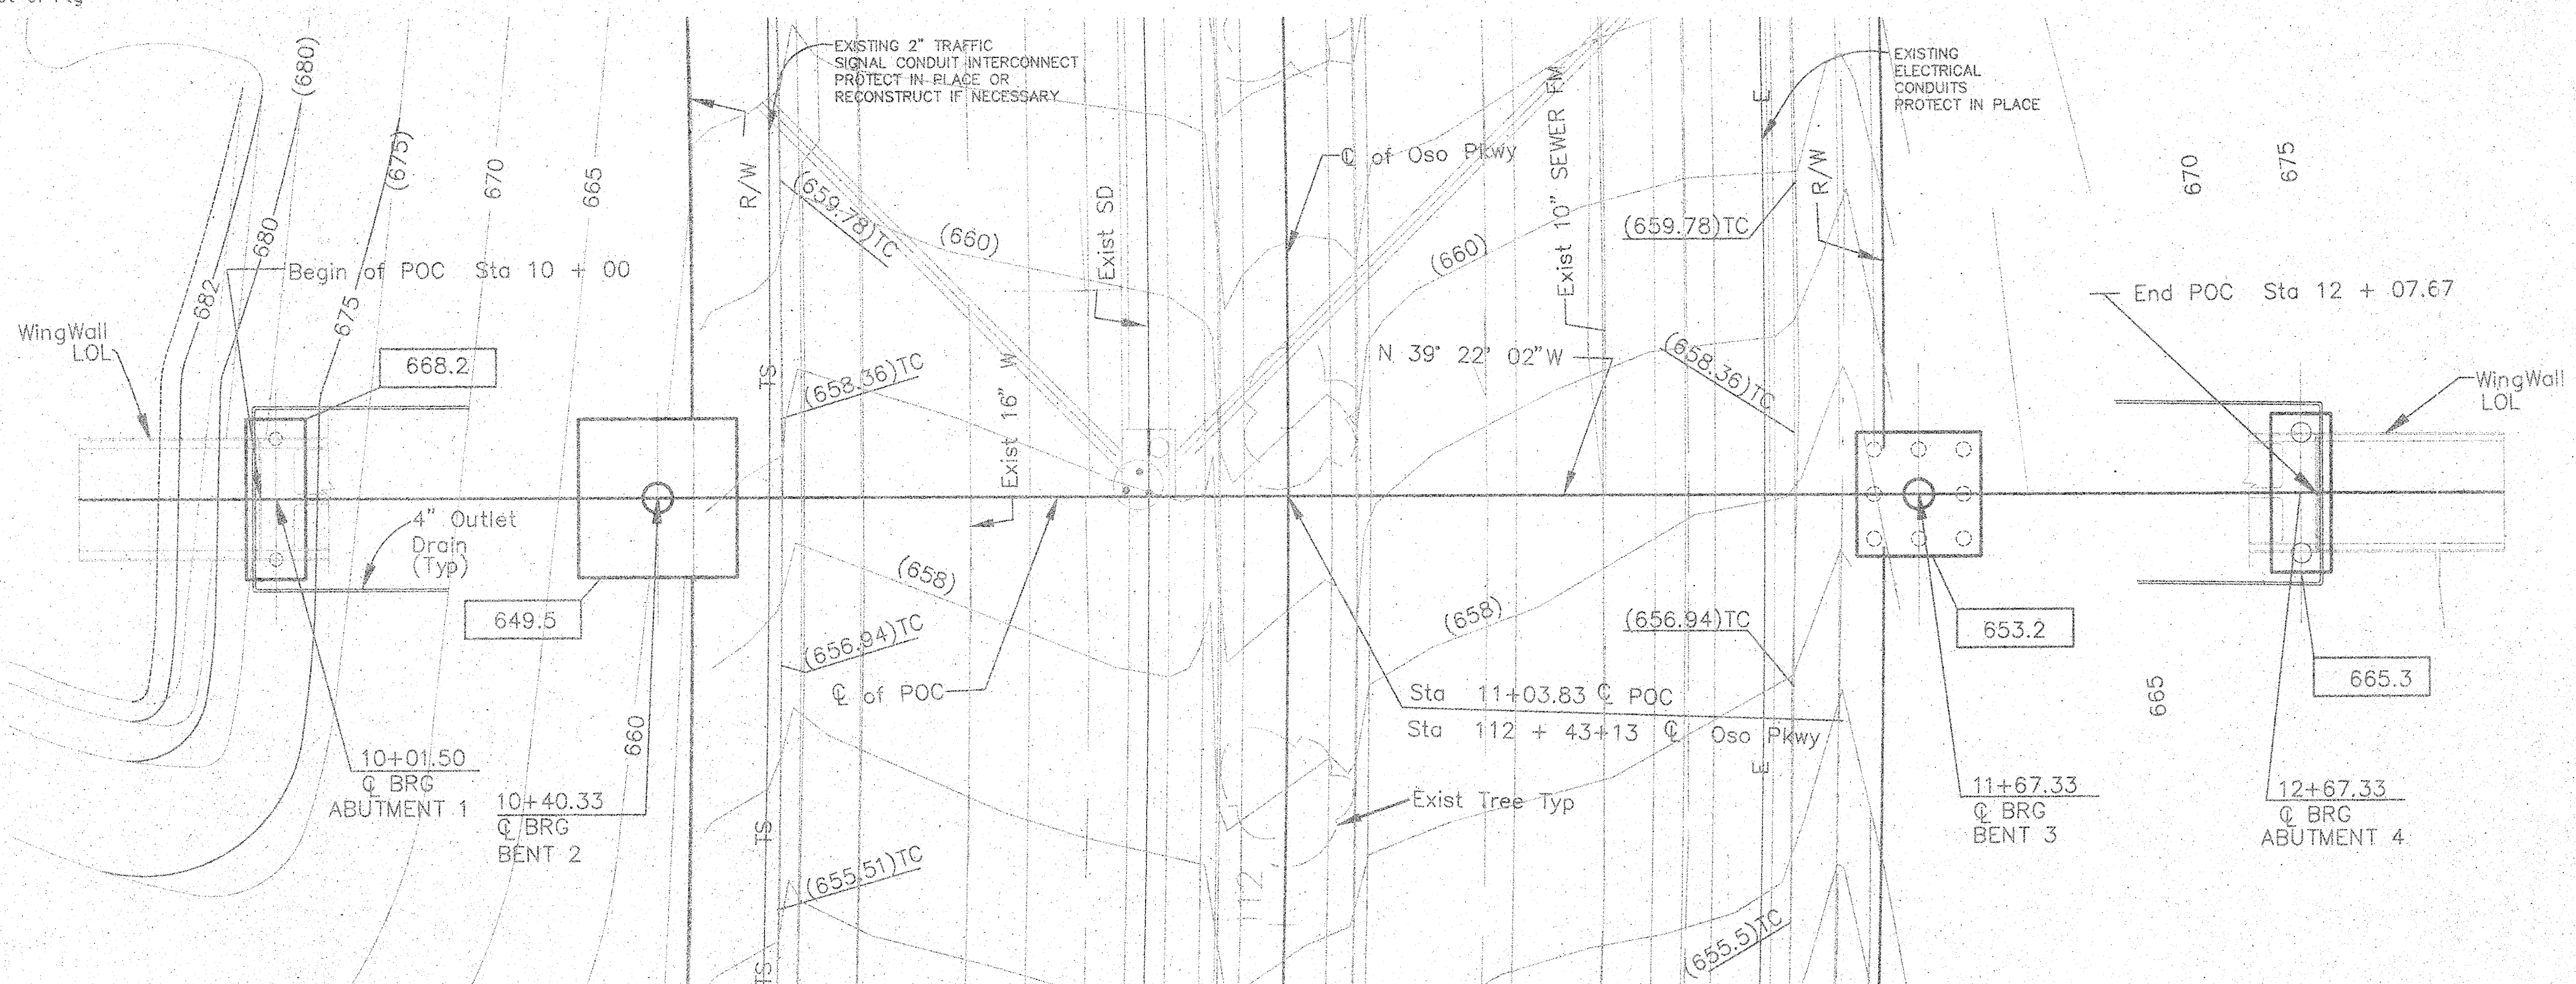

FOUNDATION PLAN
Scale: 1"=10'

INDICATES ELEVATION AT
THE BOTTOM OF FOOTING

				HUITT-ZOLLARS Huitt-Zollars, Inc. 15101 Red Hill Avenue, Tustin, CA 92780 (714) 256-7900 PREPARED UNDER THE SUPERVISION OF <i>William Earl</i> WILLIAM R. EARL		PROFESSIONAL ENGINEER W.R. Earl No. C45852 Exp. 12-31-98 CIVIL STATE OF CALIFORNIA DESIGNED BY WRE DRAWN BY MMF/LL CHECKED BY RJM FIELD BOOK		FOUNDATION PLAN AND DECK CONTOURS OSO PARKWAY PEDESTRIAN BRIDGE LAS FLORES		SHEET 3 OF 10 SHEETS JOB NO. 10-0402-03	
NO.	DESCRIPTION	BY/DATE	APPROVED/DATE								

DR. 14 41622320