




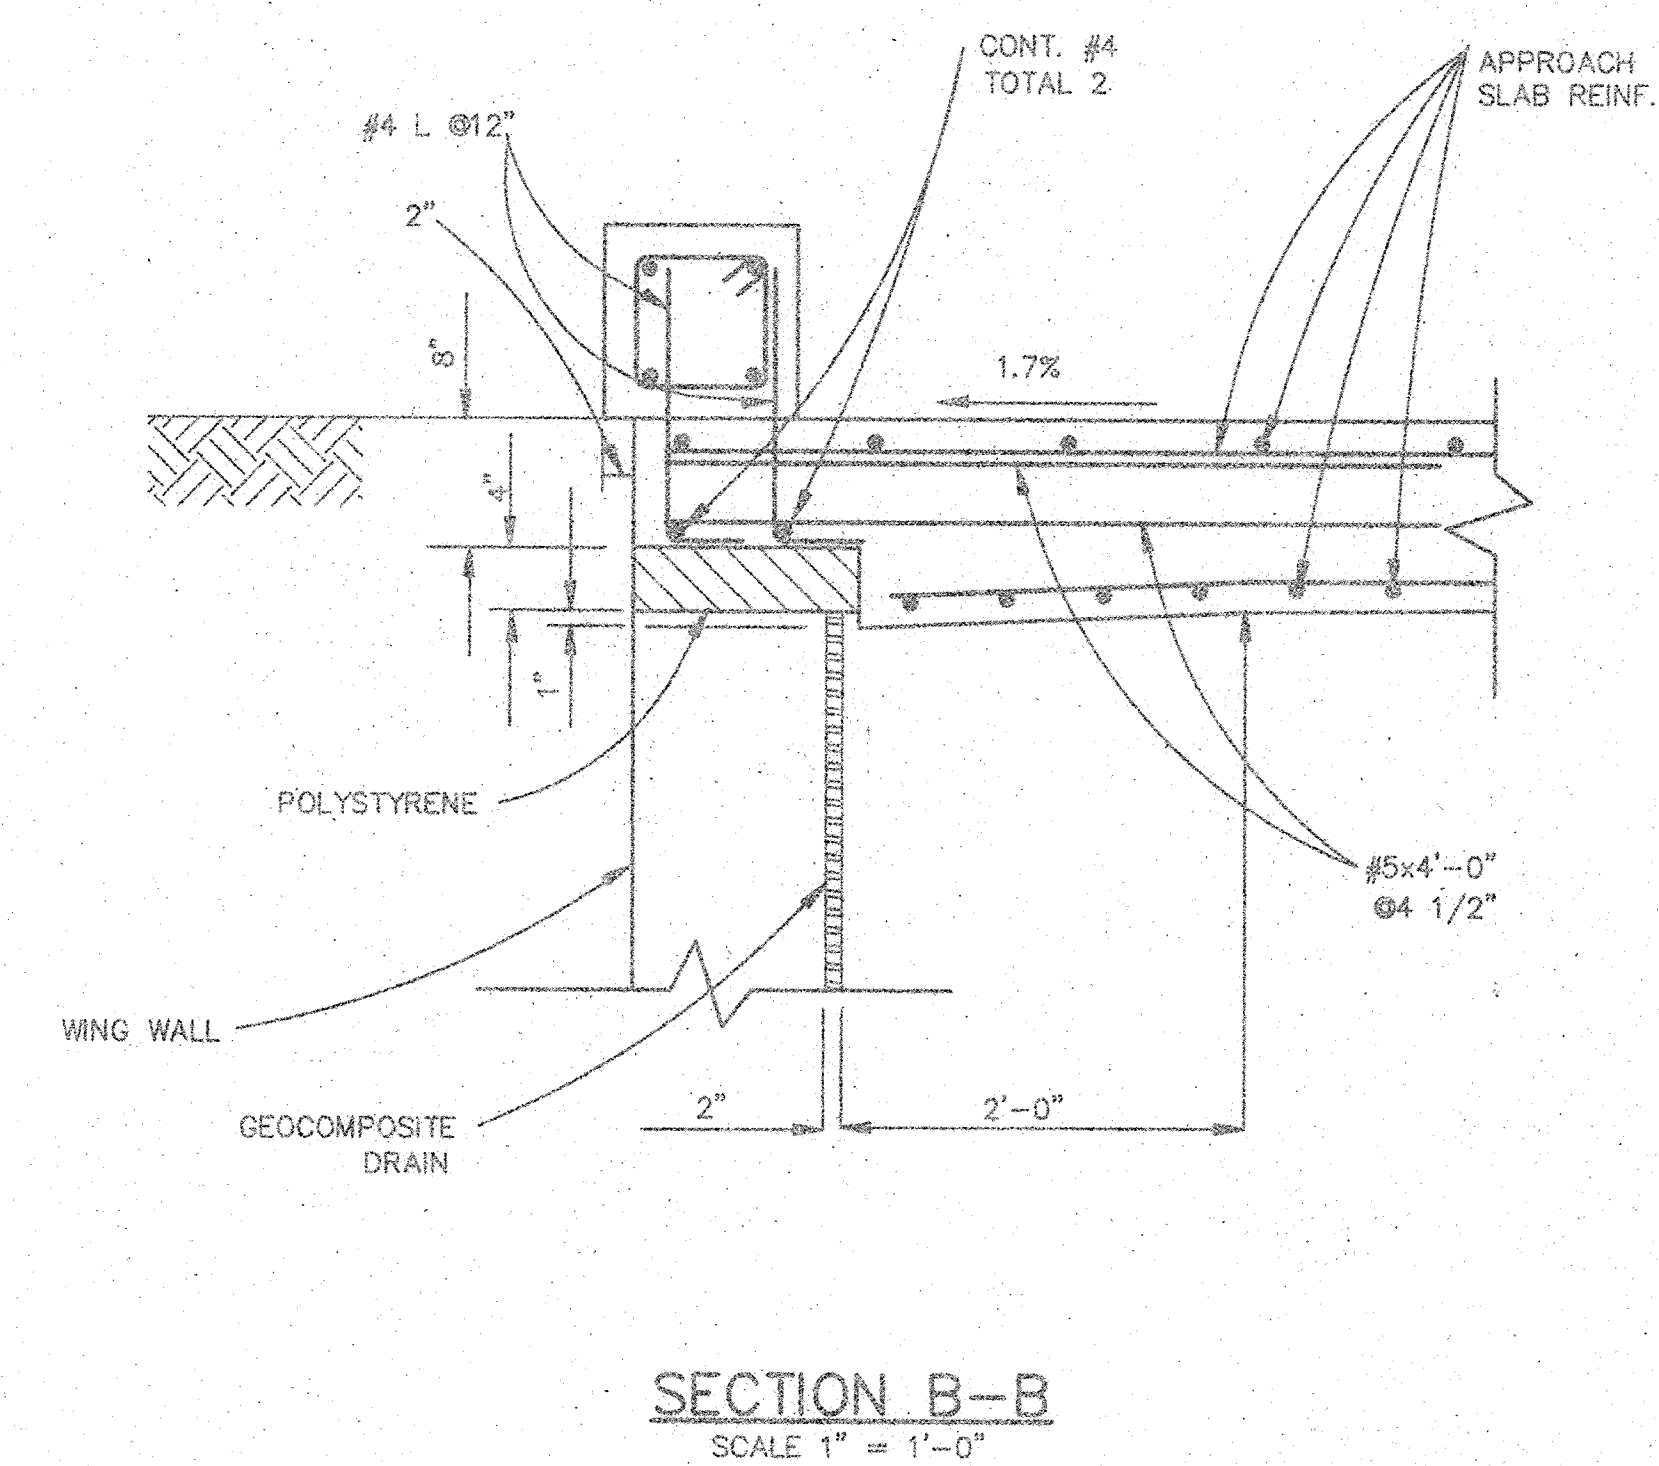

SECTION B-B
SCALE 1" = 1'-0"

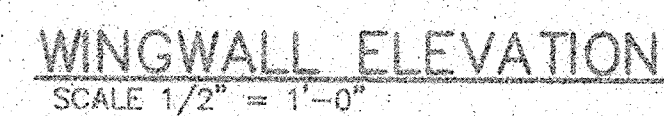

BAR CHAIR DETAIL
NTS

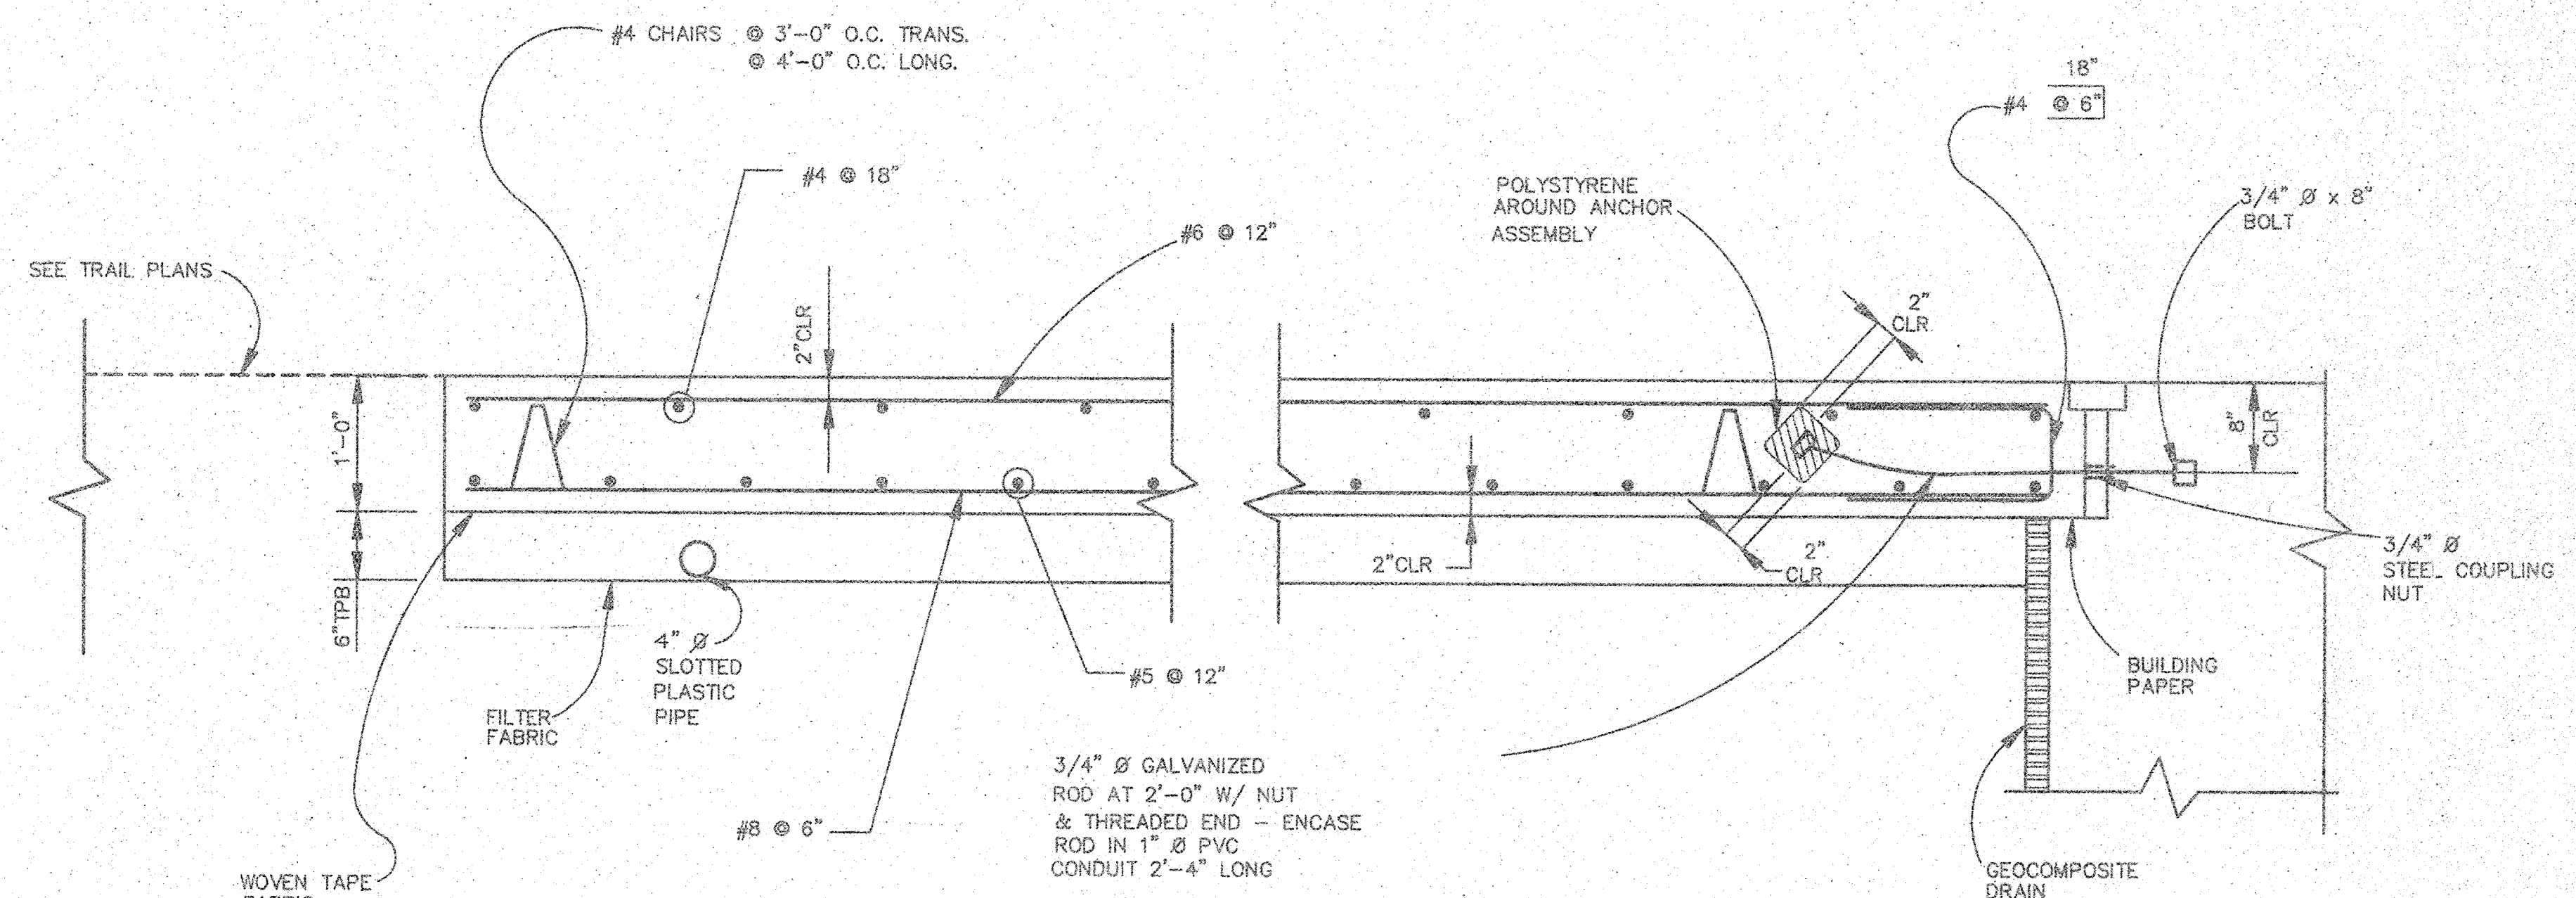

SECTION D-D
SCALE 1/2" = 1'-0"

SECTION C-C
SCALE 1" = 1'-0"

[illegible]