


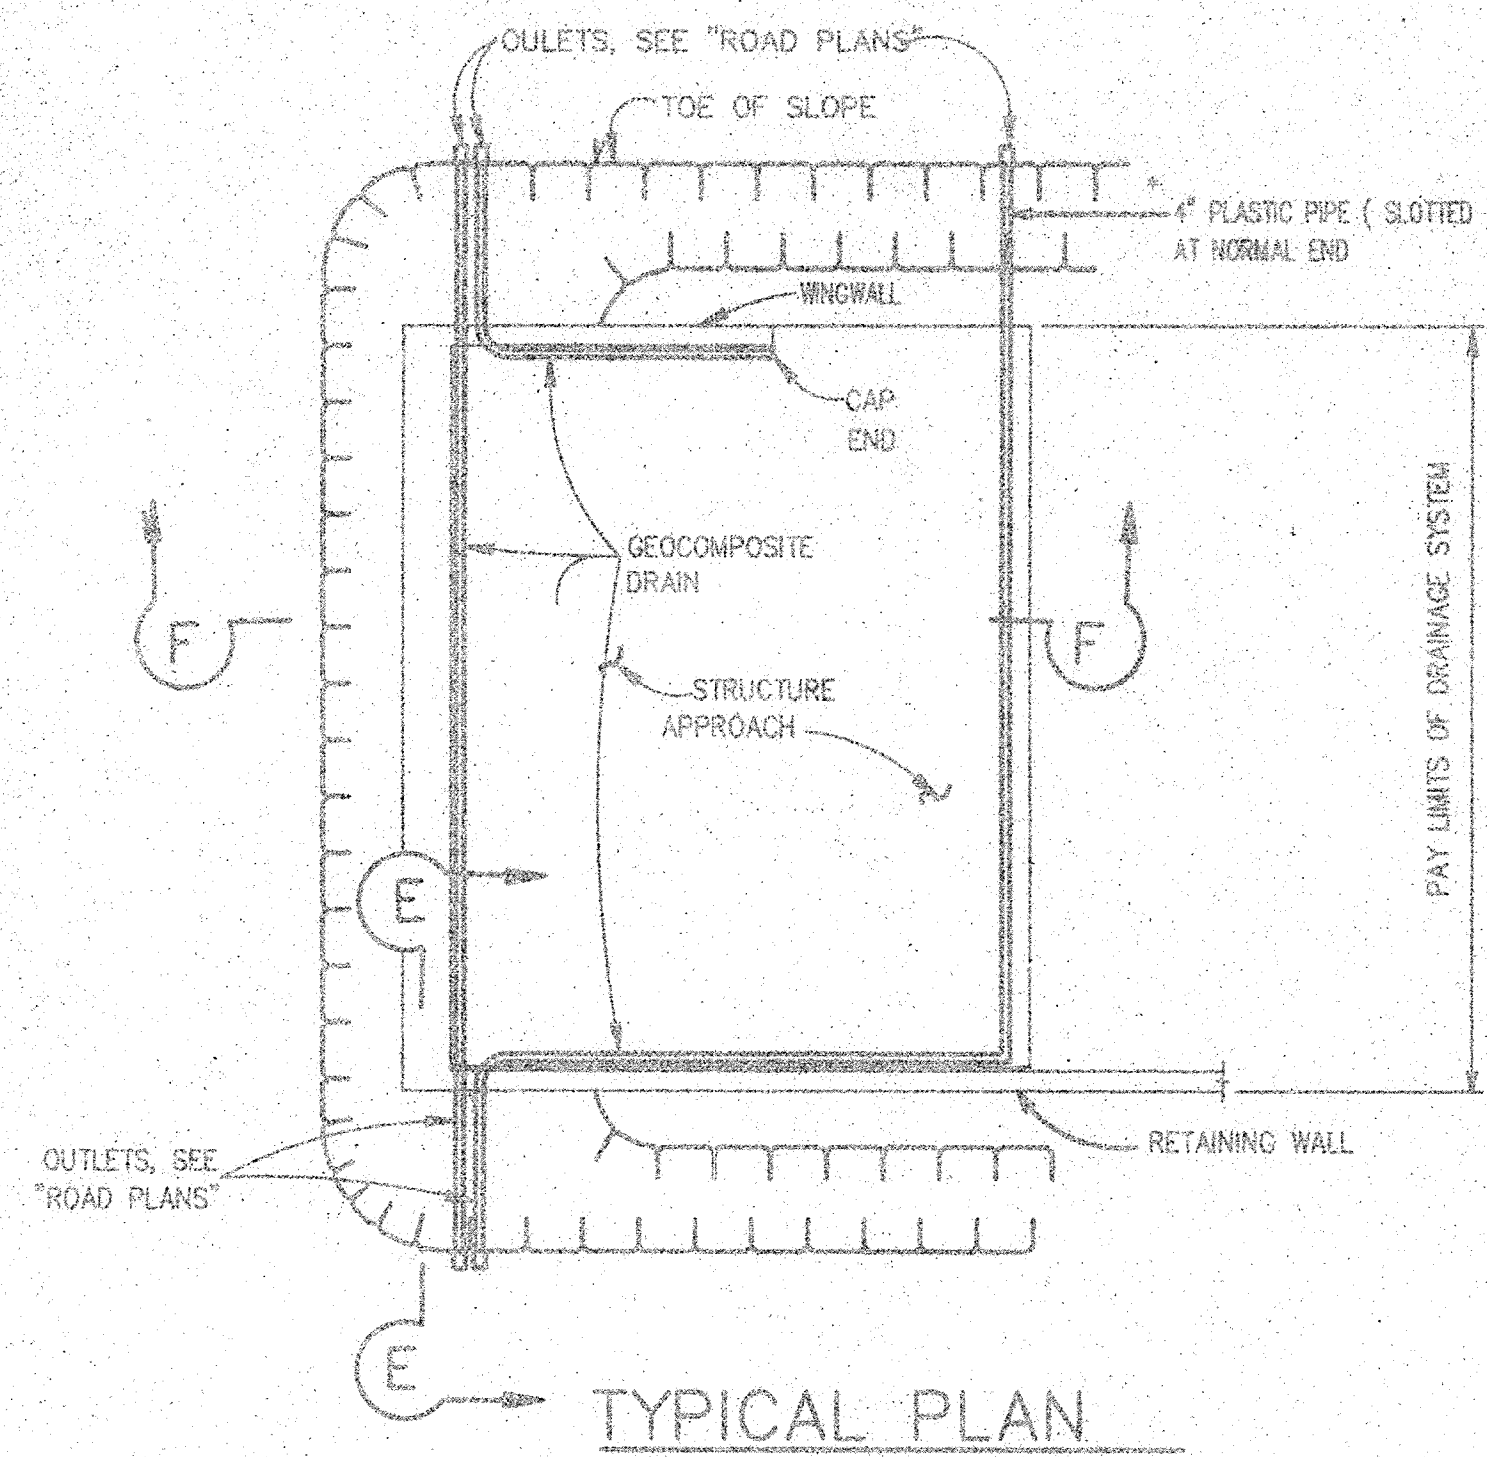
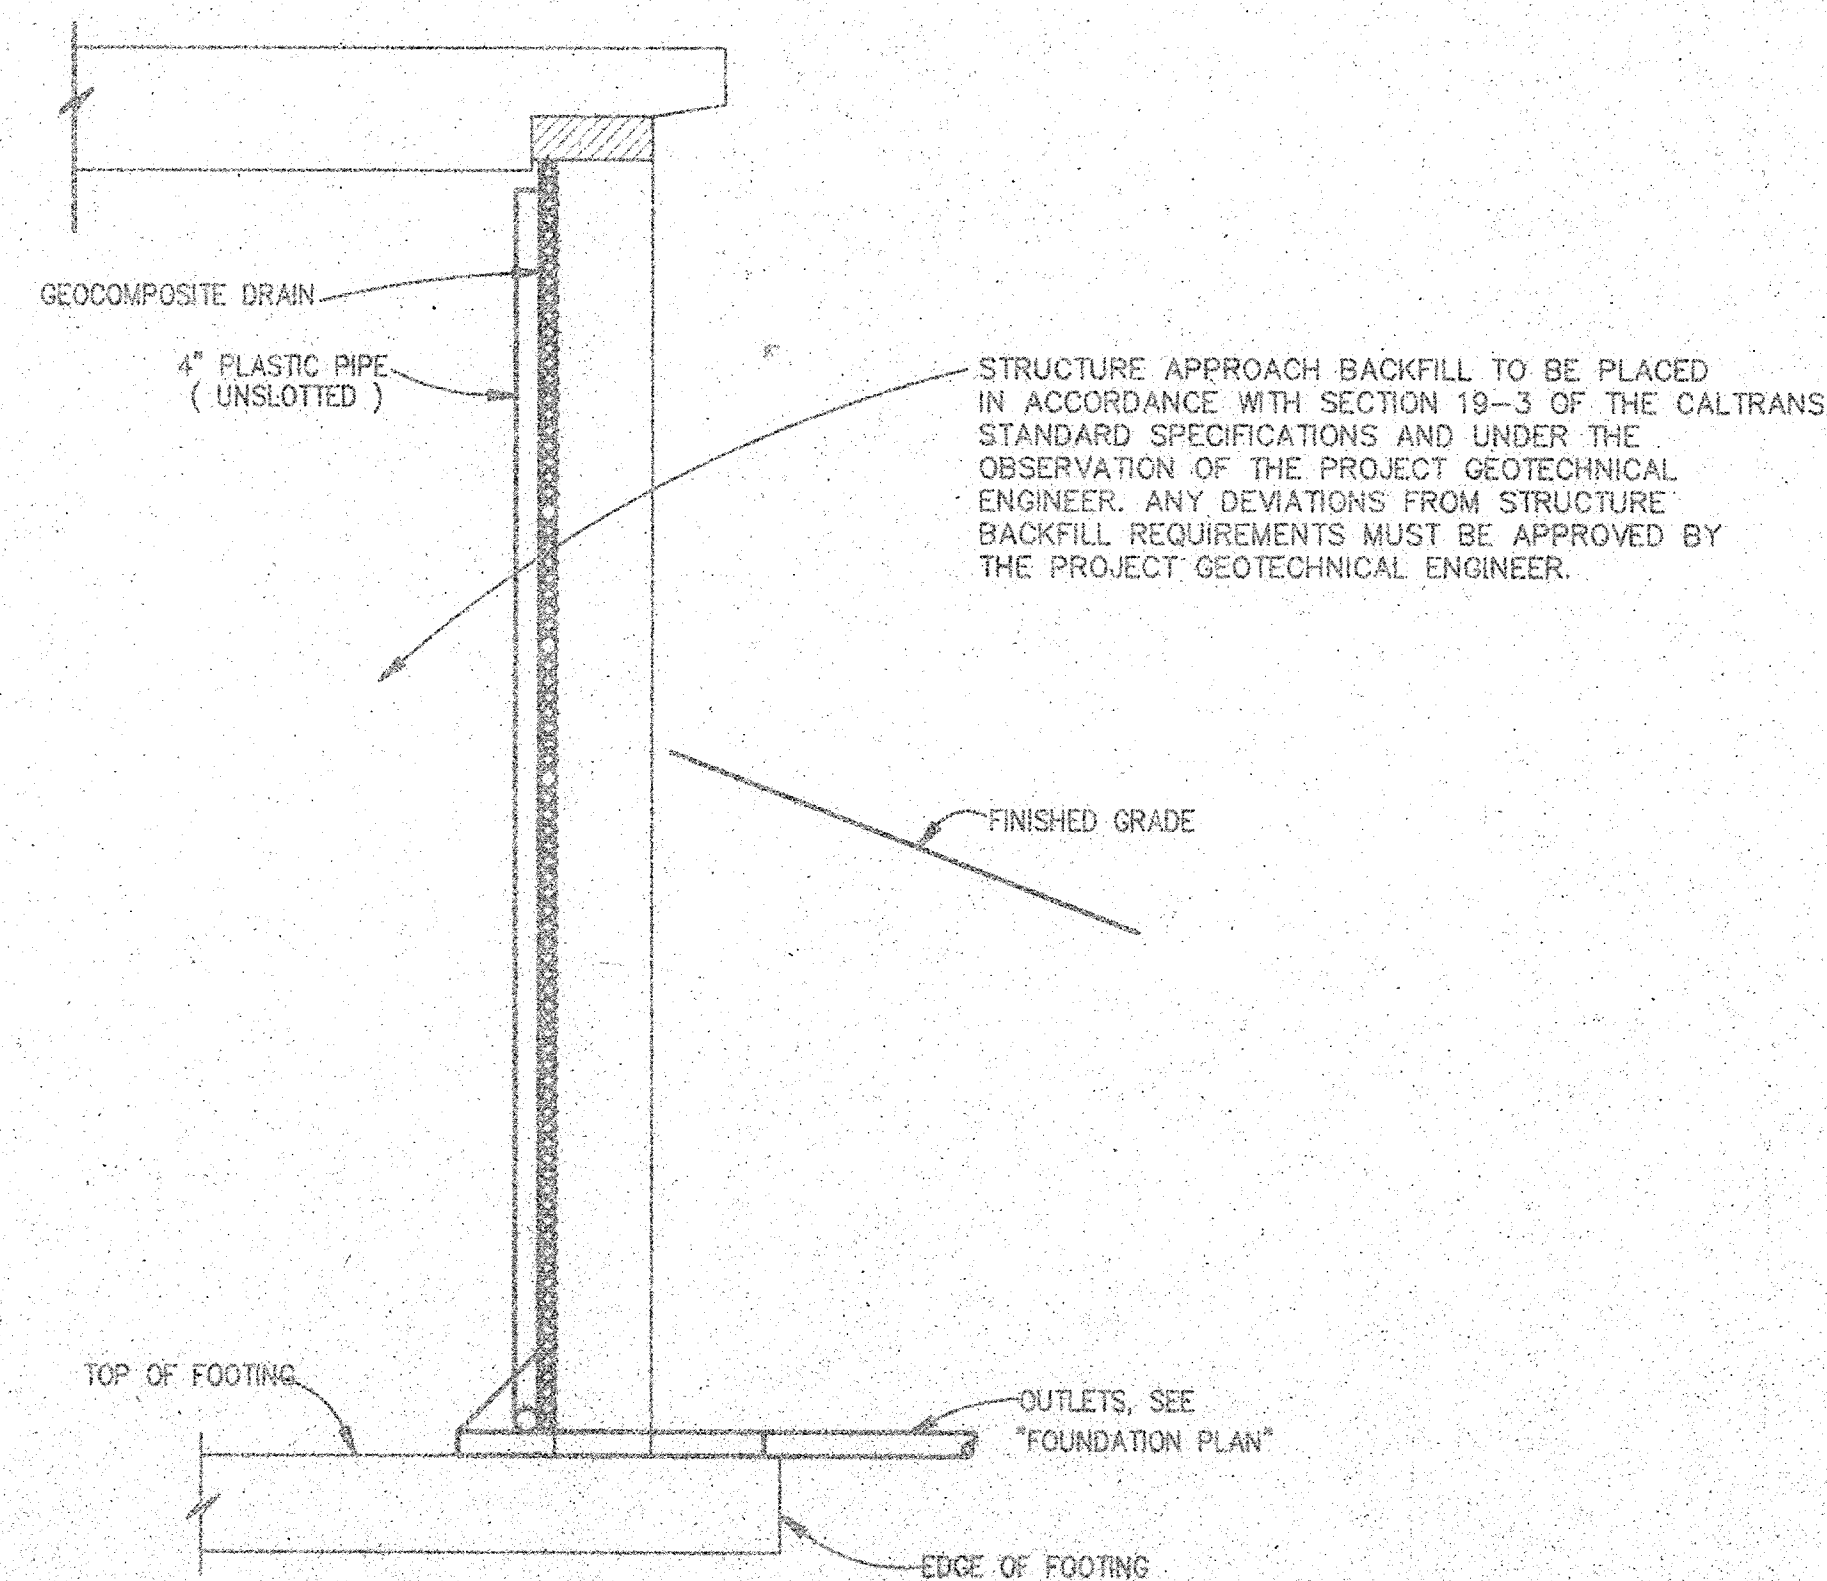


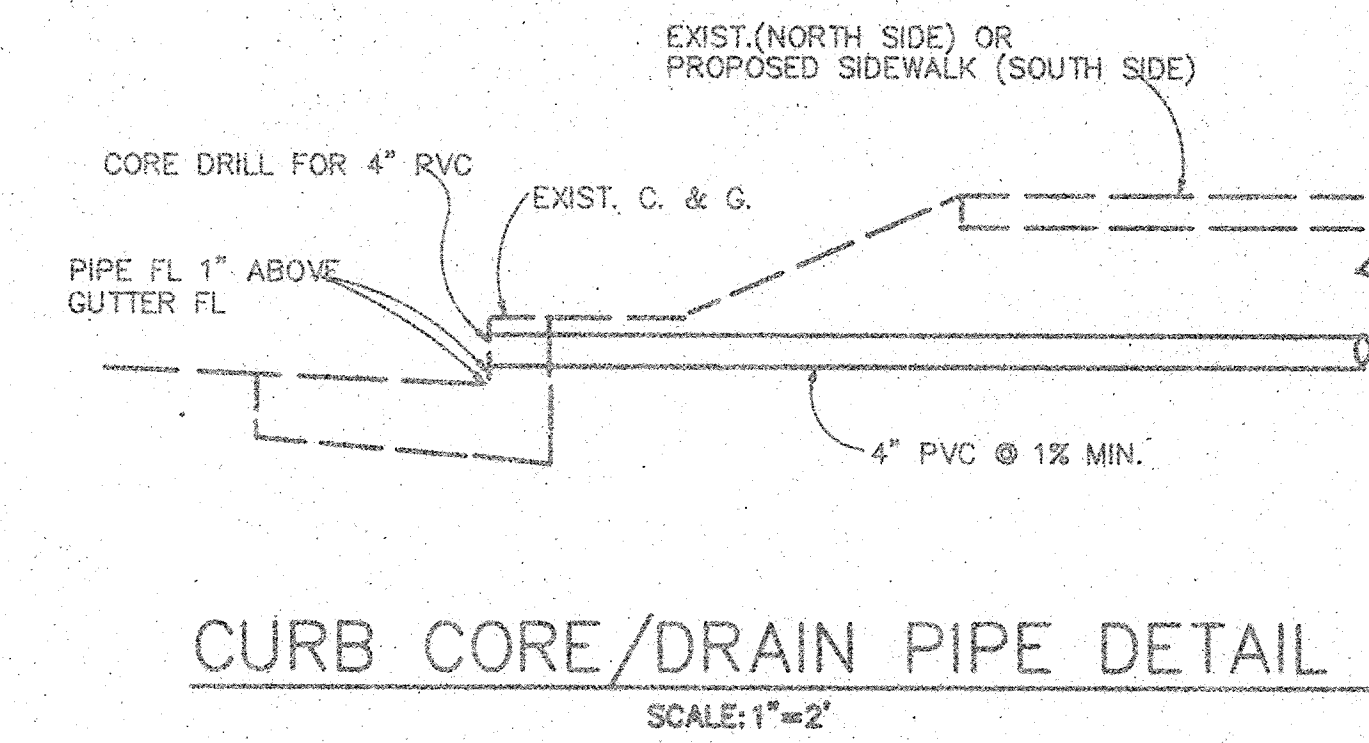

* FOR PIPE LAYOUT AT STAGGERED END, SEE "DETAIL B."

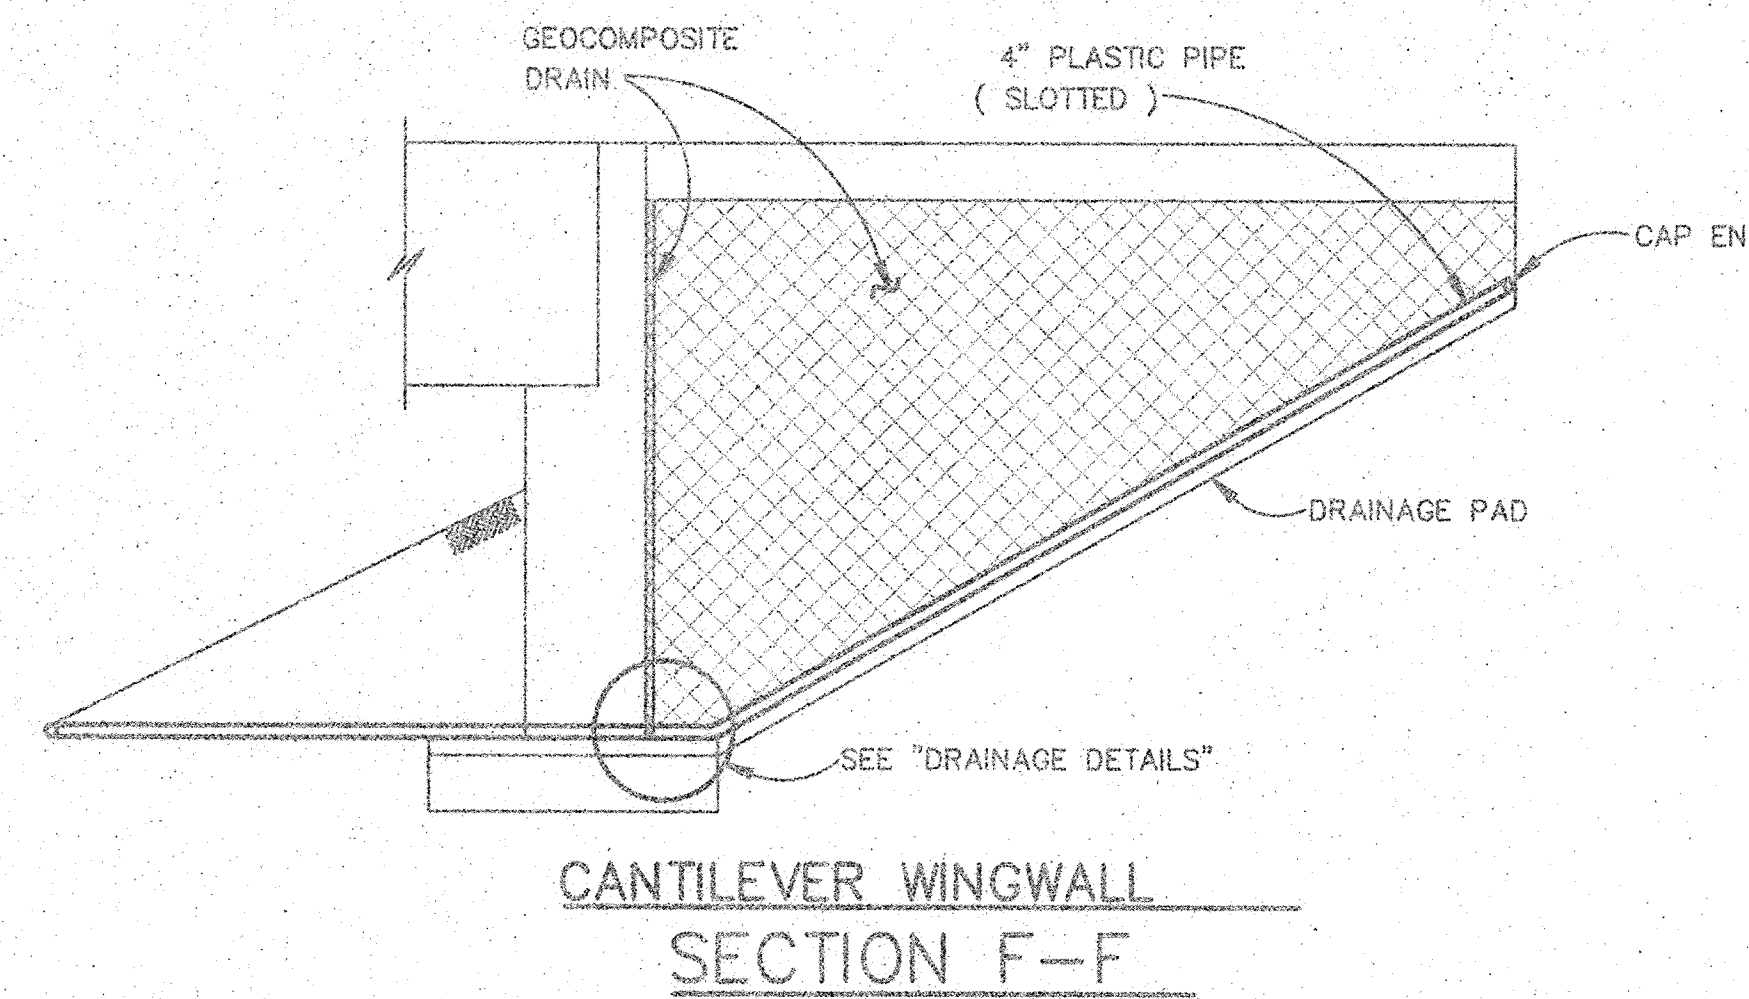

NOTE: BENDS AND JUNCTIONS IN 4" PLASTIC PIPE ARE 30" RADIUS MIN.

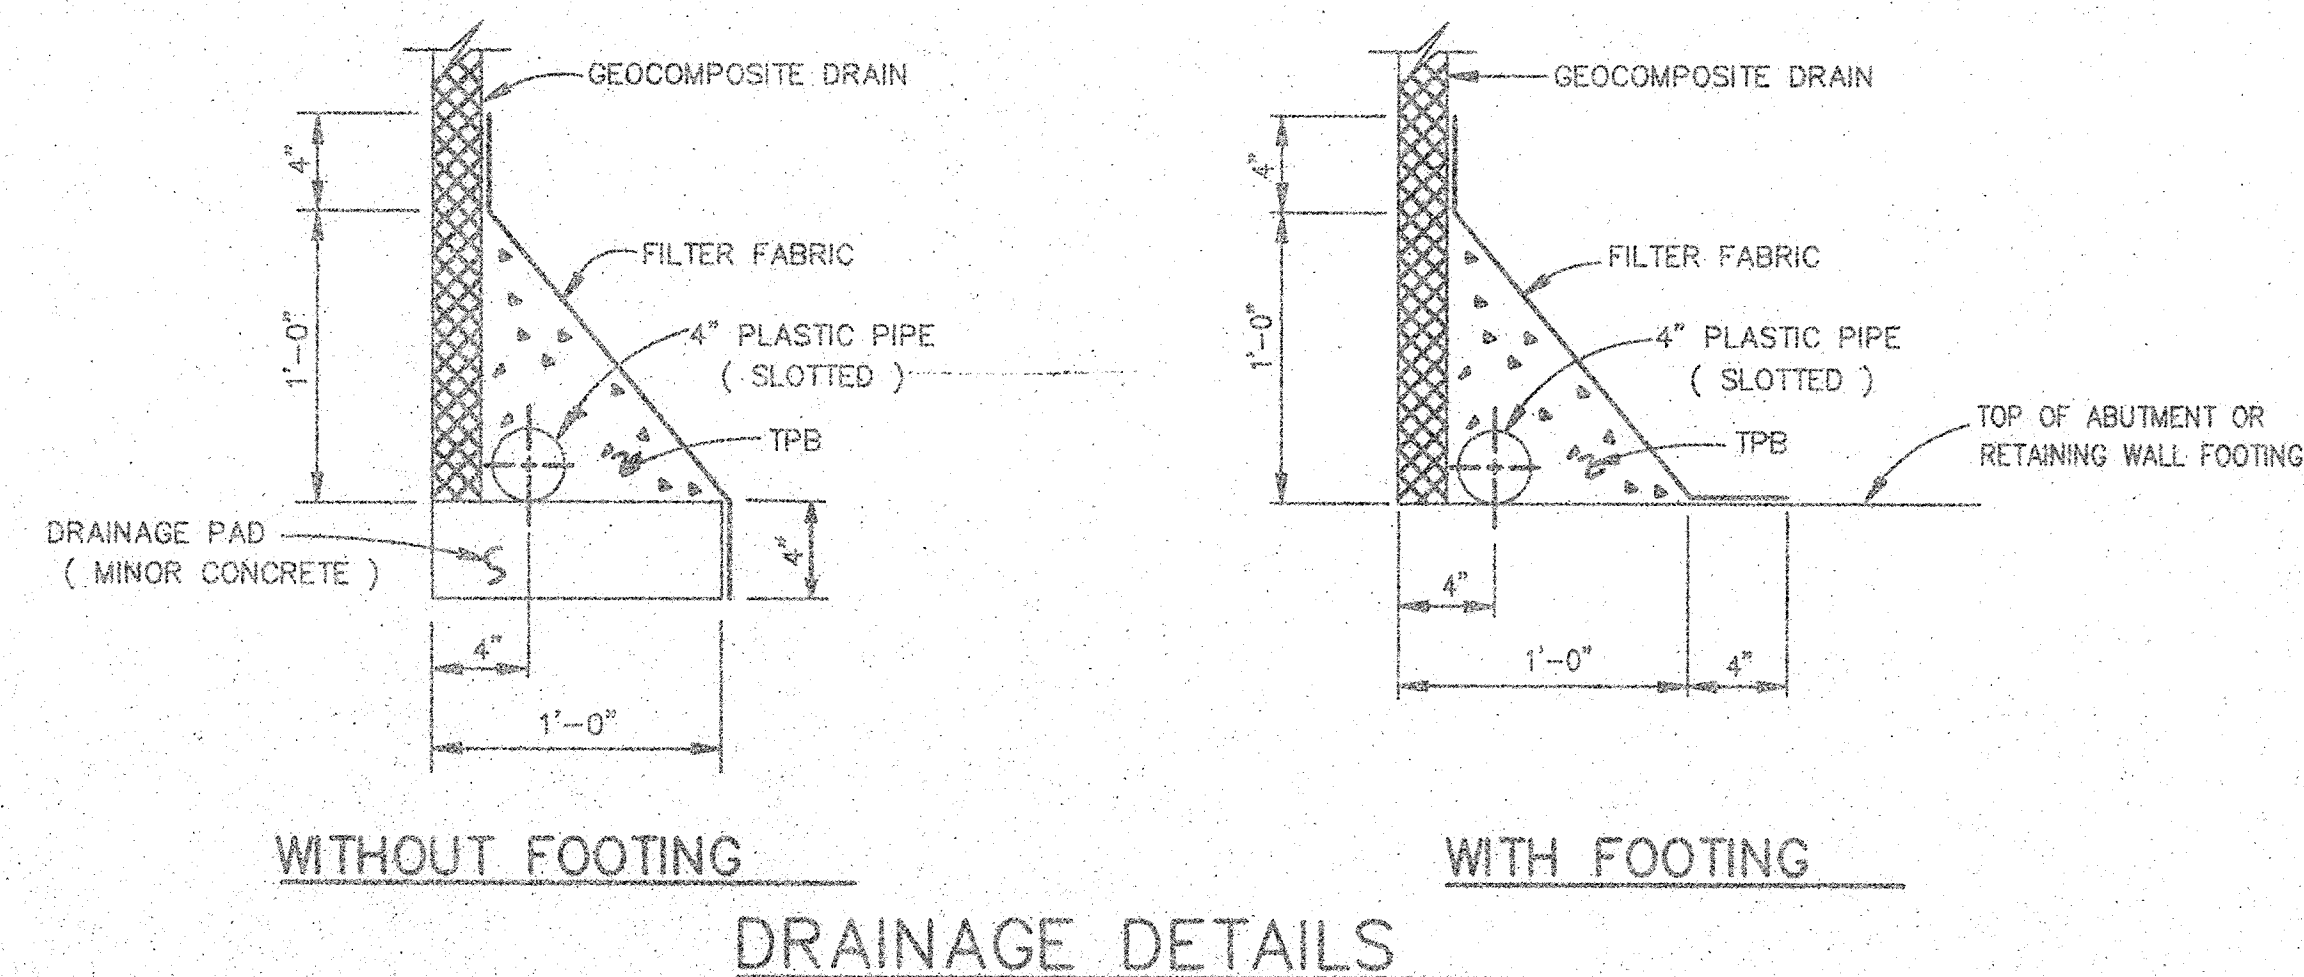

				HUITT-ZOLIARS Huitt-Zoliars, Inc. 1901 Red Hill Avenue, Tustin, CA 92780 (714) 258-7500 PREPARED UNDER THE SUPERVISION OF <i>William R. Earl</i> WILLIAM R. EARL	DESIGNED BY: WRE DRAWN BY: MMF CHECKED BY: RJM FIELD BOOK:	ABUTMENT DRAINAGE DETAILS OSO PARKWAY PEDESTRIAN BRIDGE LAS FLORES	SHEET 6 OF 10 SHEETS
NO.	DESCRIPTION	BY/DATE	APPROVED/DATE	DATE	DATE	DATE	DATE
				12-21-99	1-29-00		

DR 14 CUG 22323