




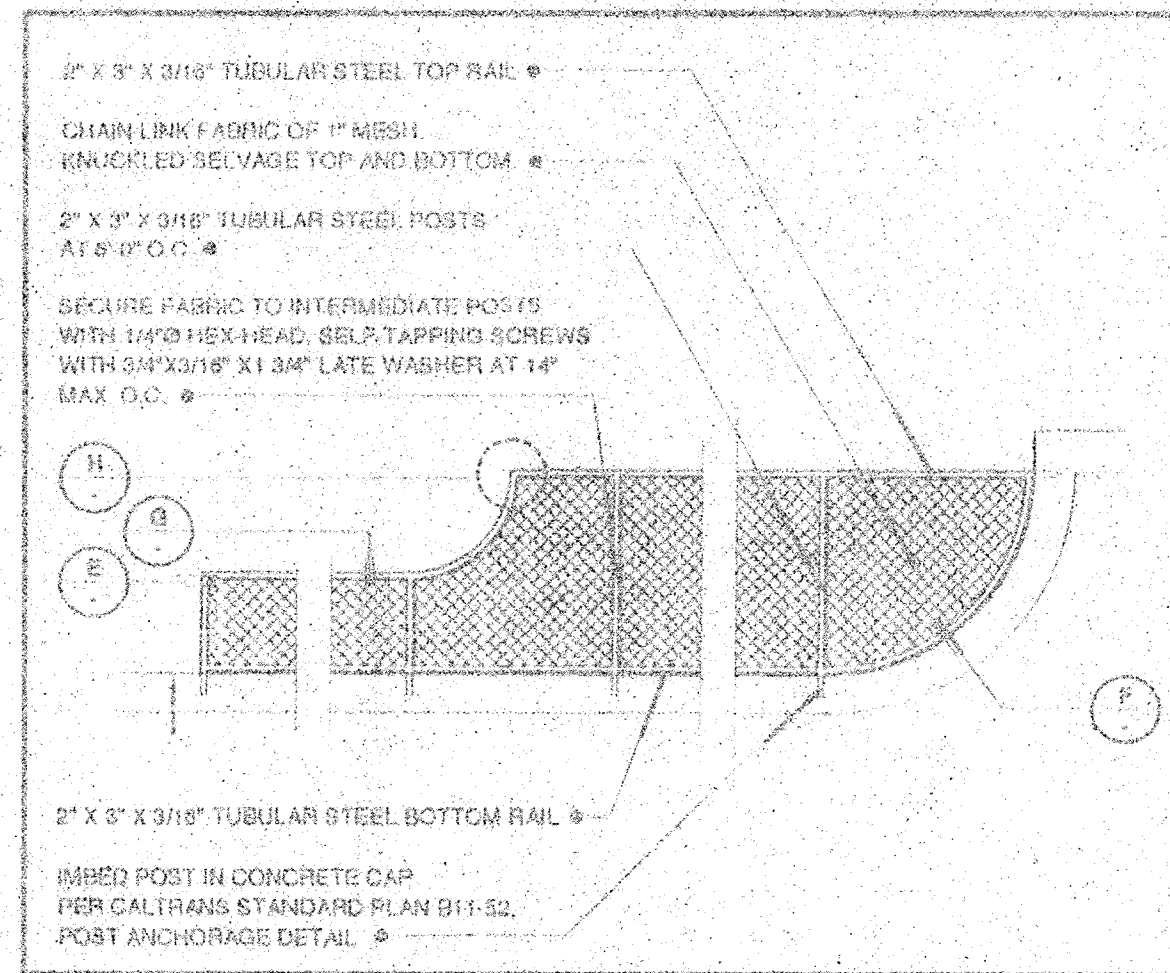


**PARTIAL FENCE ELEVATION**  
NO SCALE

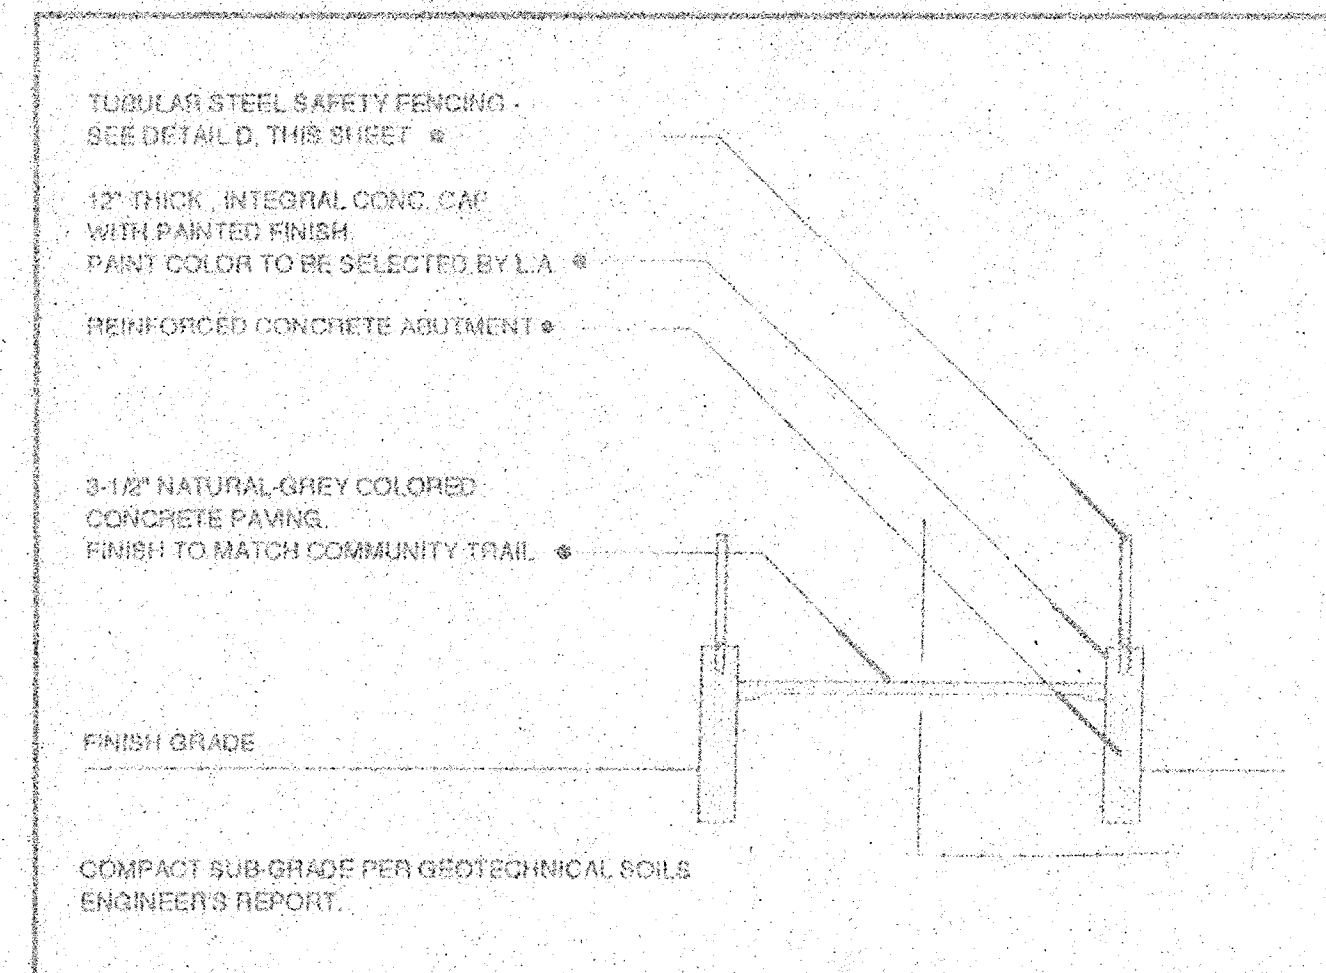


**TYPICAL SECTION @ ABUTMENTS A-A**  
NO SCALE

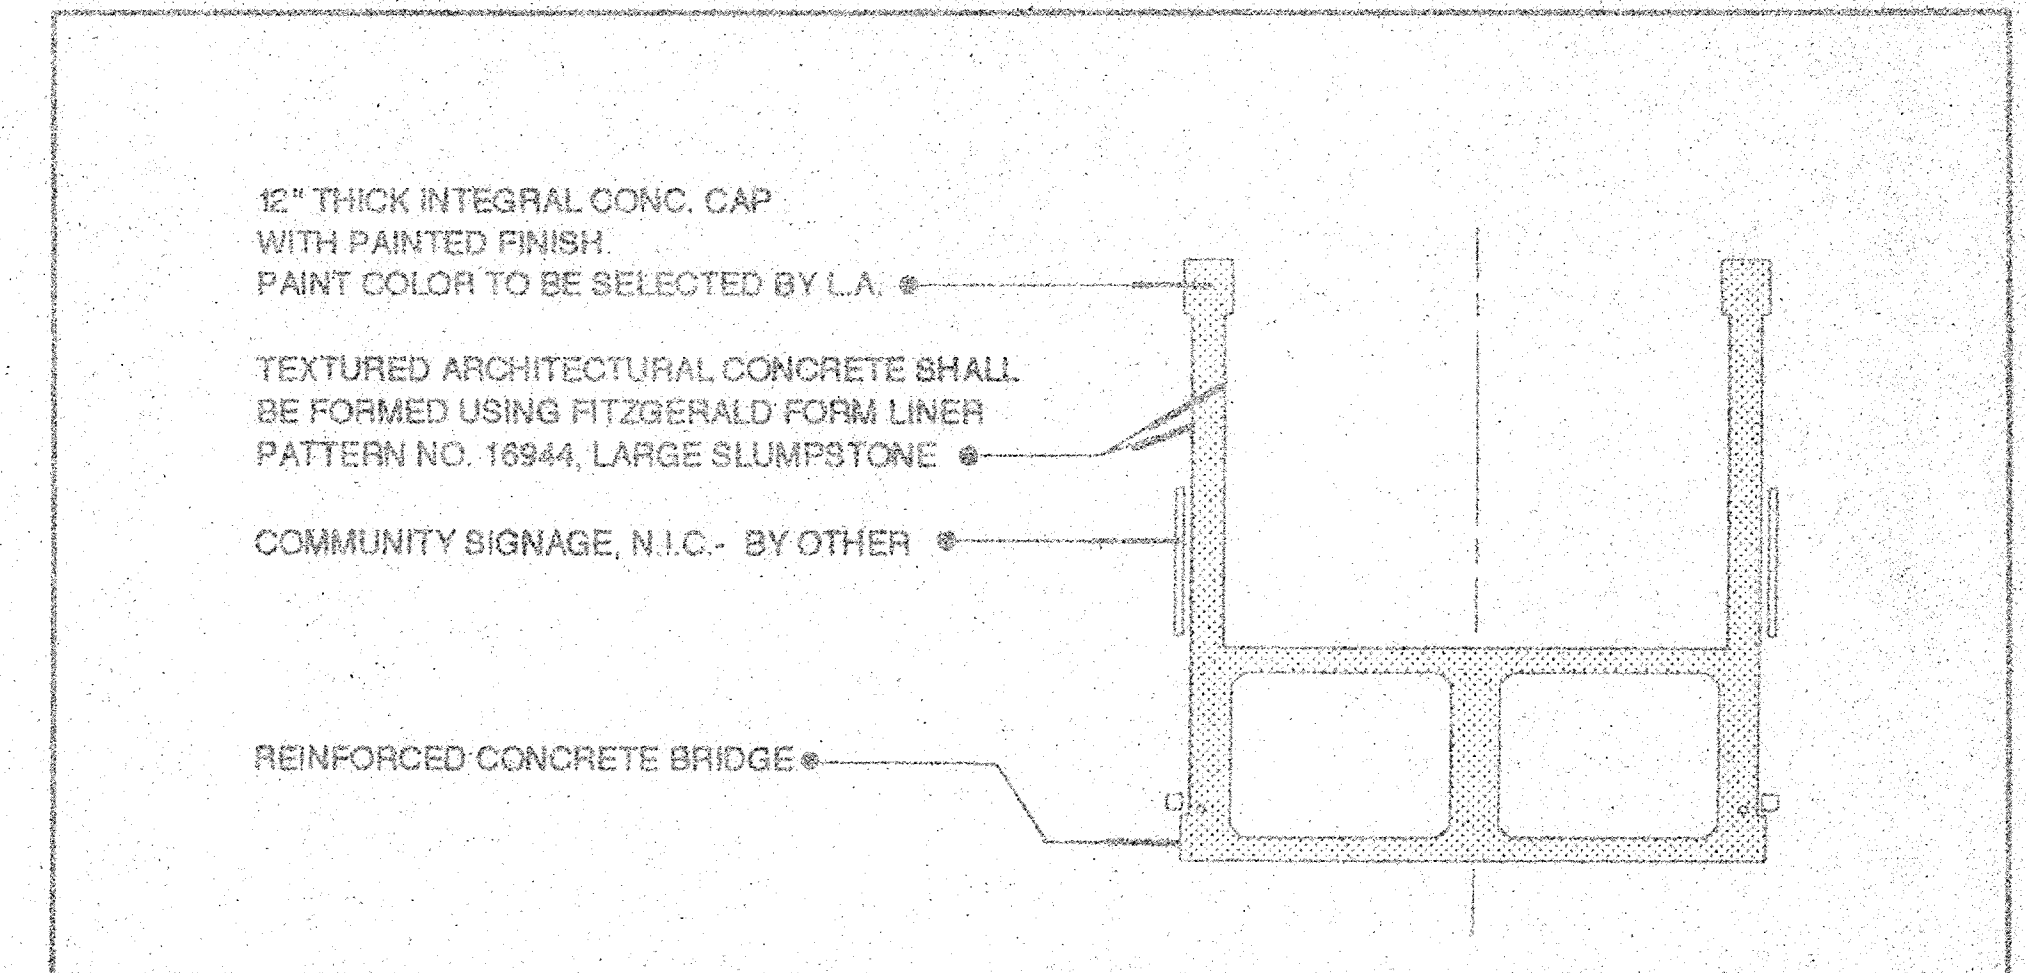


**TYPICAL SECTION @ SIGNAGE B-B**  
NO SCALE

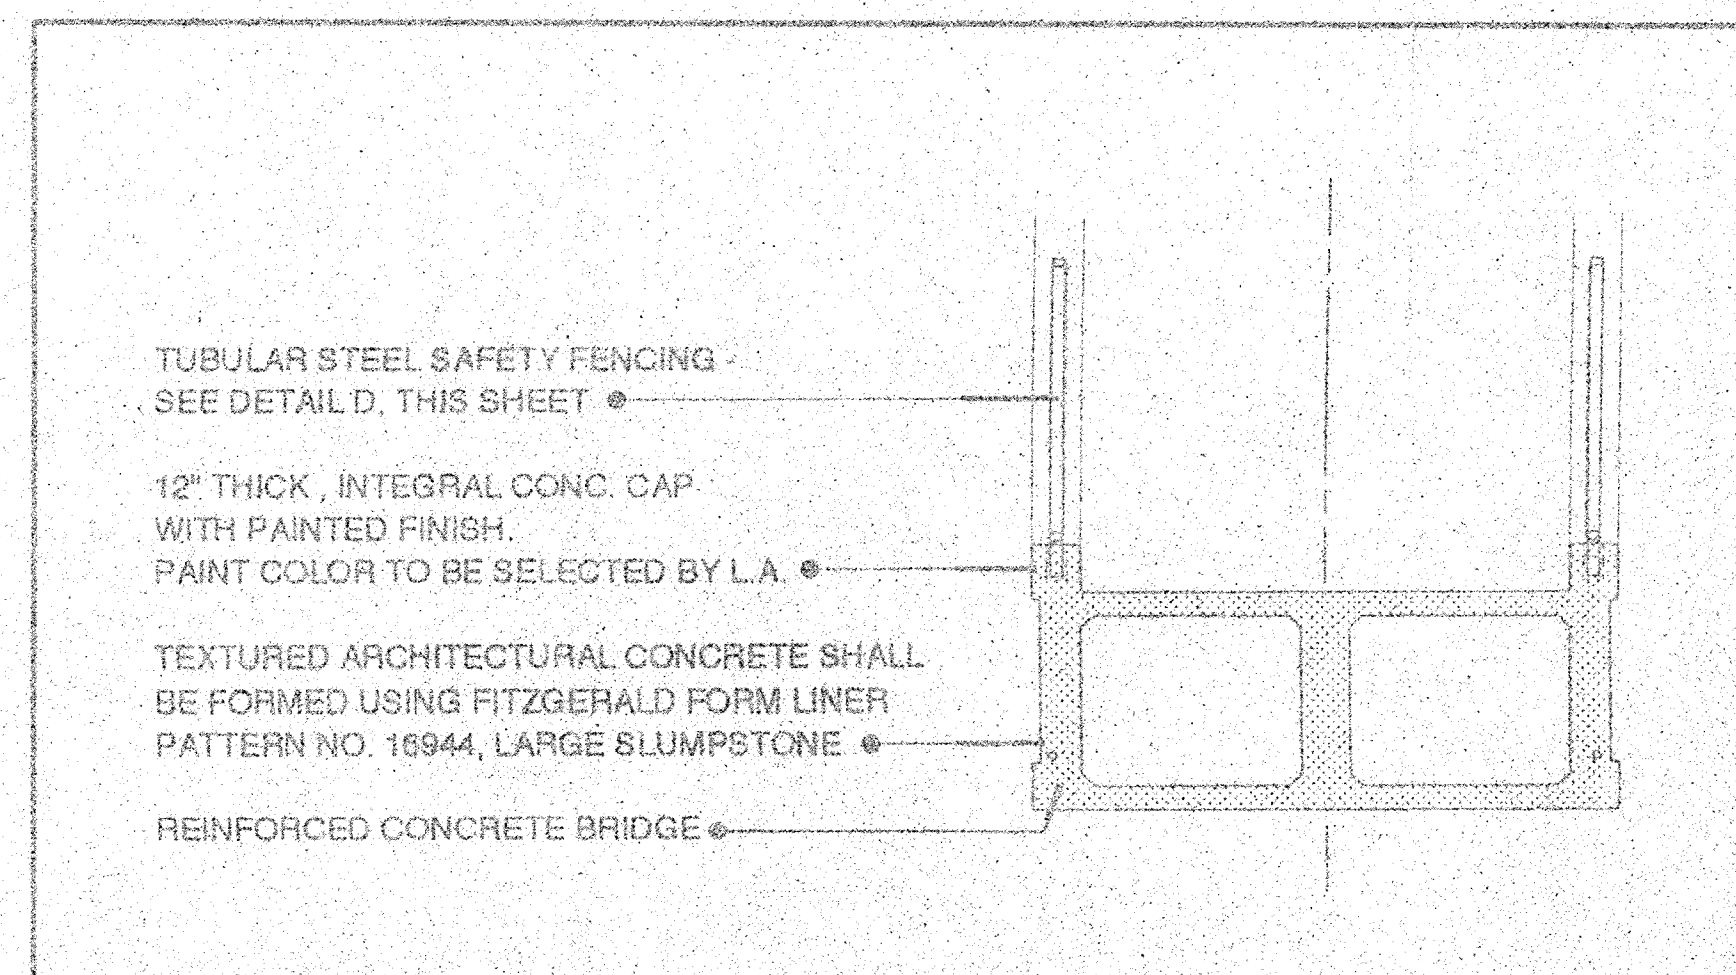


**TYPICAL SECTION THRU STRUCTURE C-C**  
NO SCALE

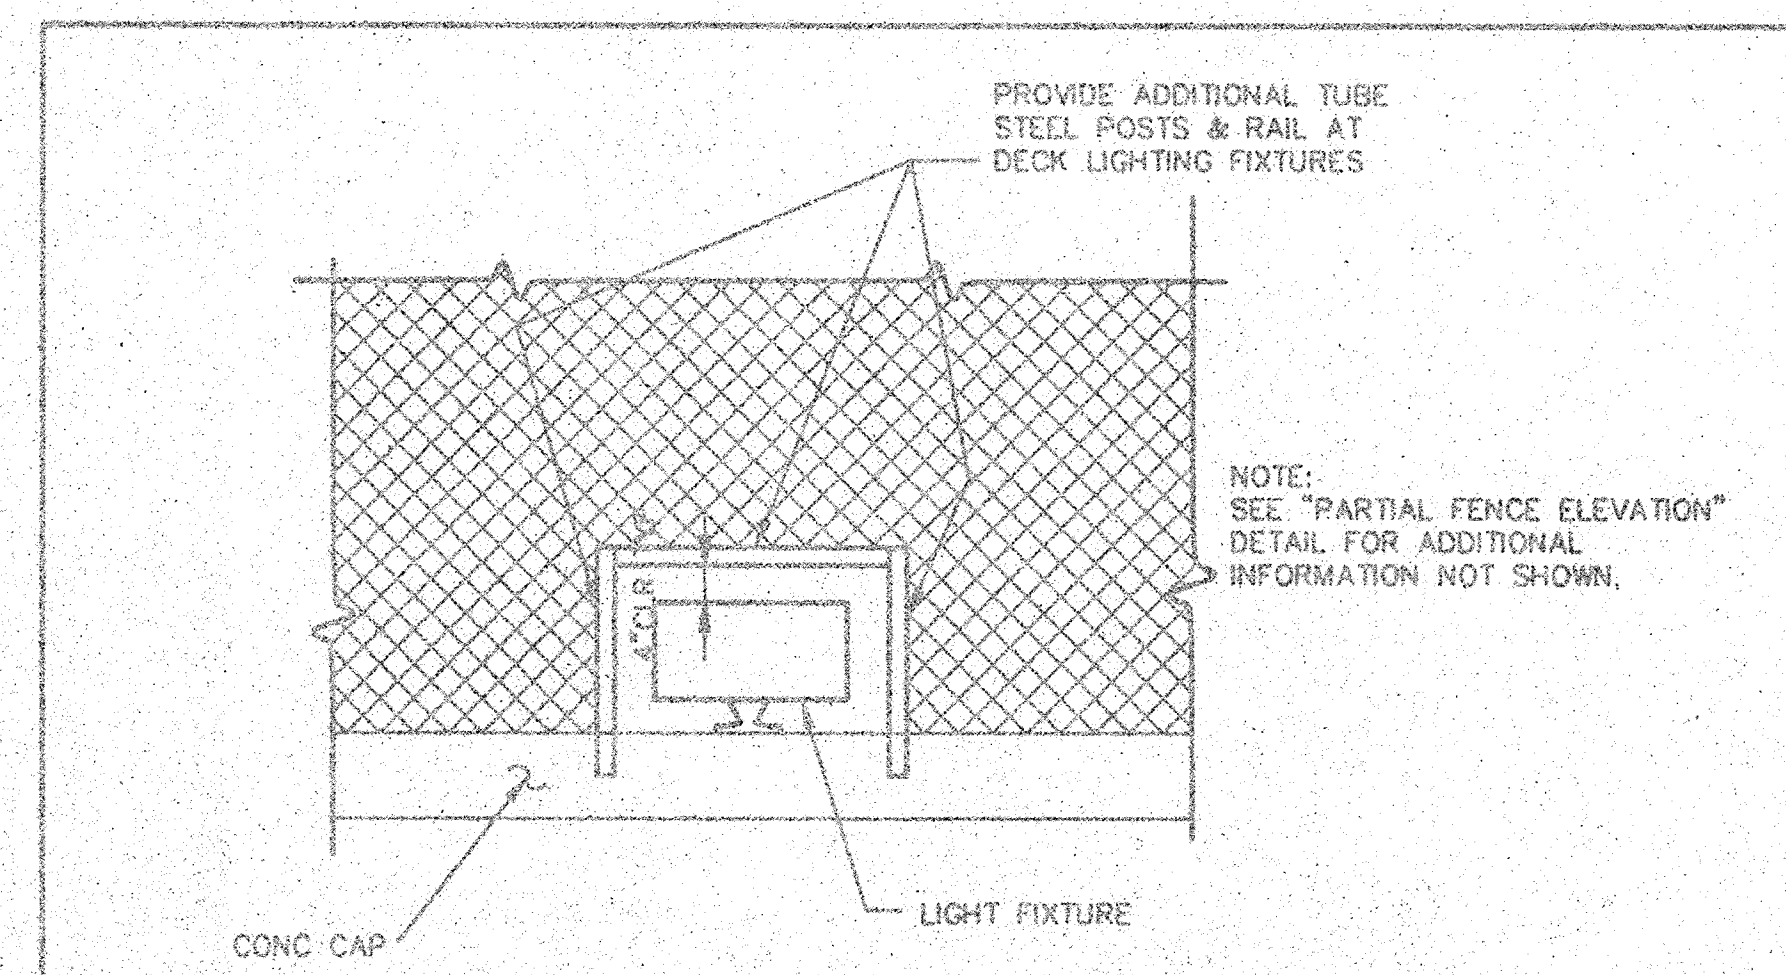


**PARTIAL FENCE ELEVATION D-D (MODIFIED)**  
NO SCALE

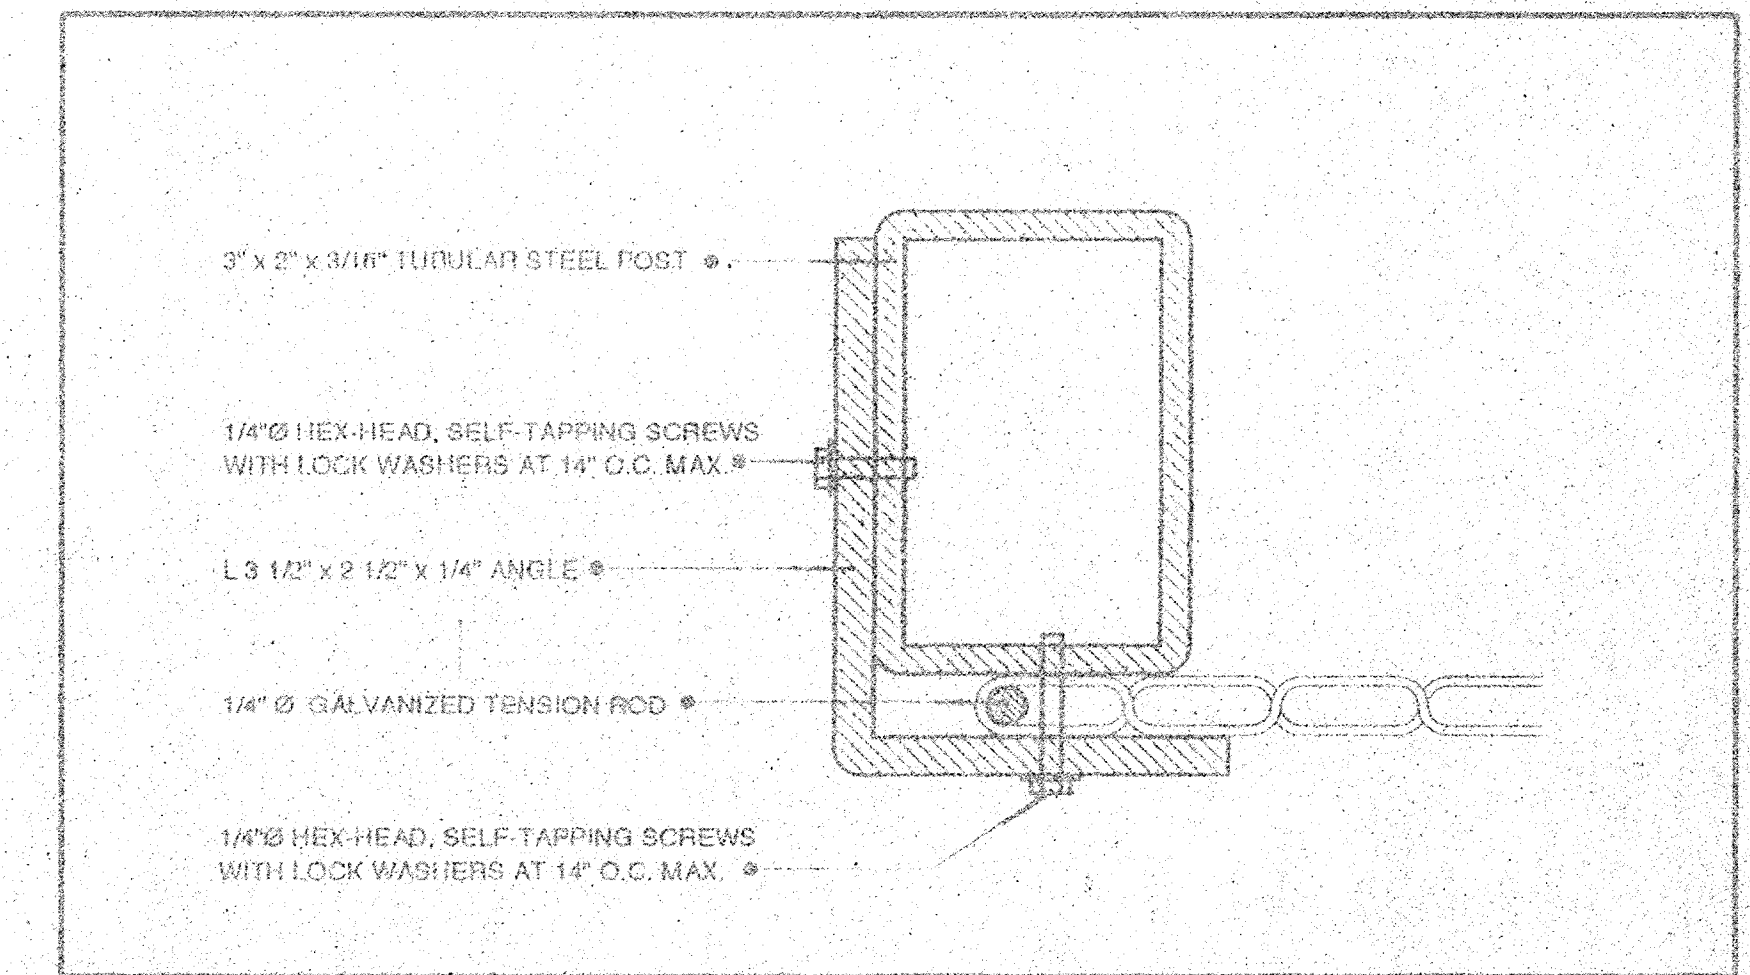


**FENCE DETAIL E-E**  
NO SCALE

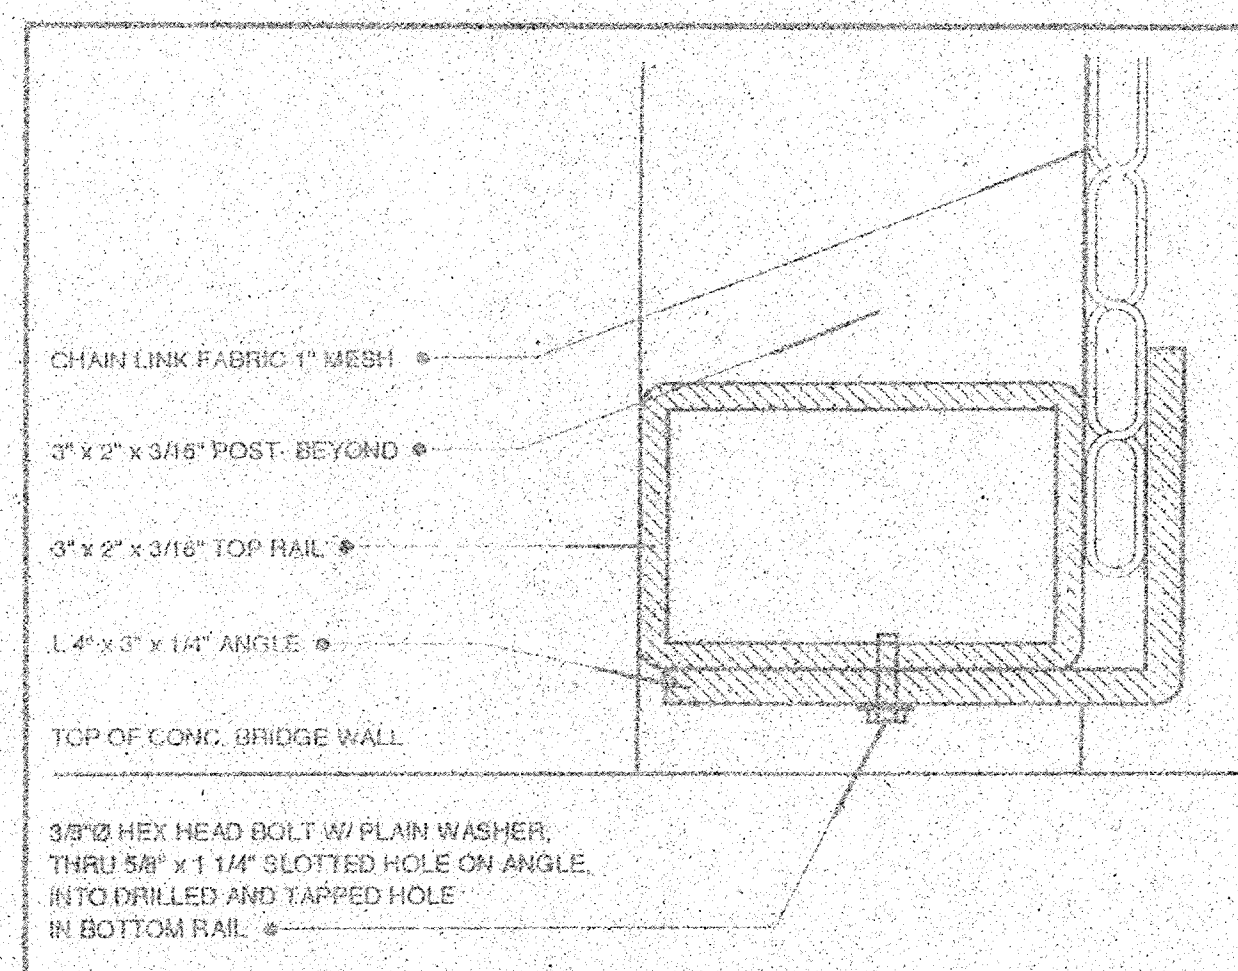

**FENCE DETAIL F-F**  
NO SCALE

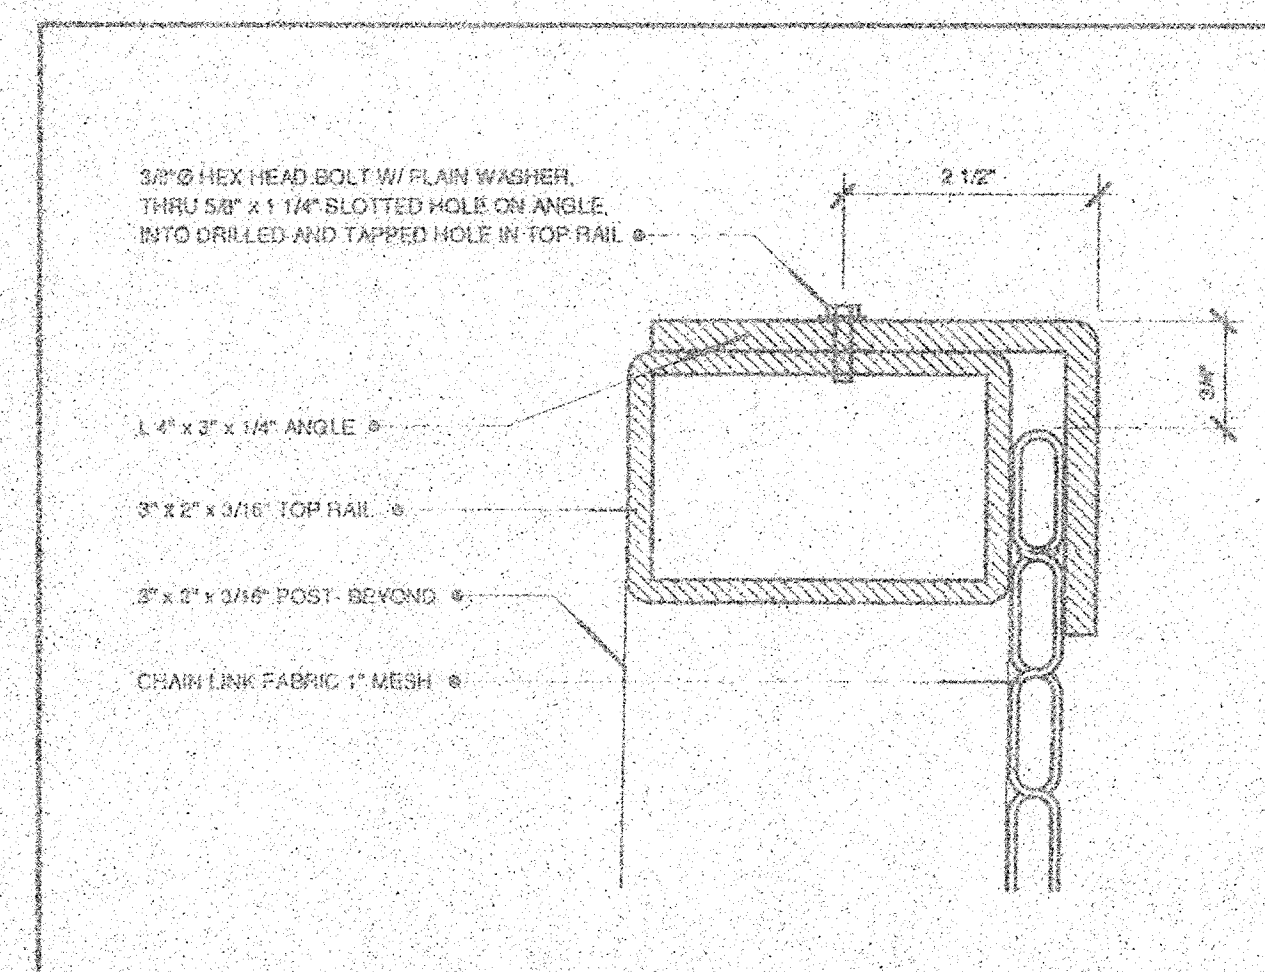


**FENCE DETAIL G-G**  
NO SCALE

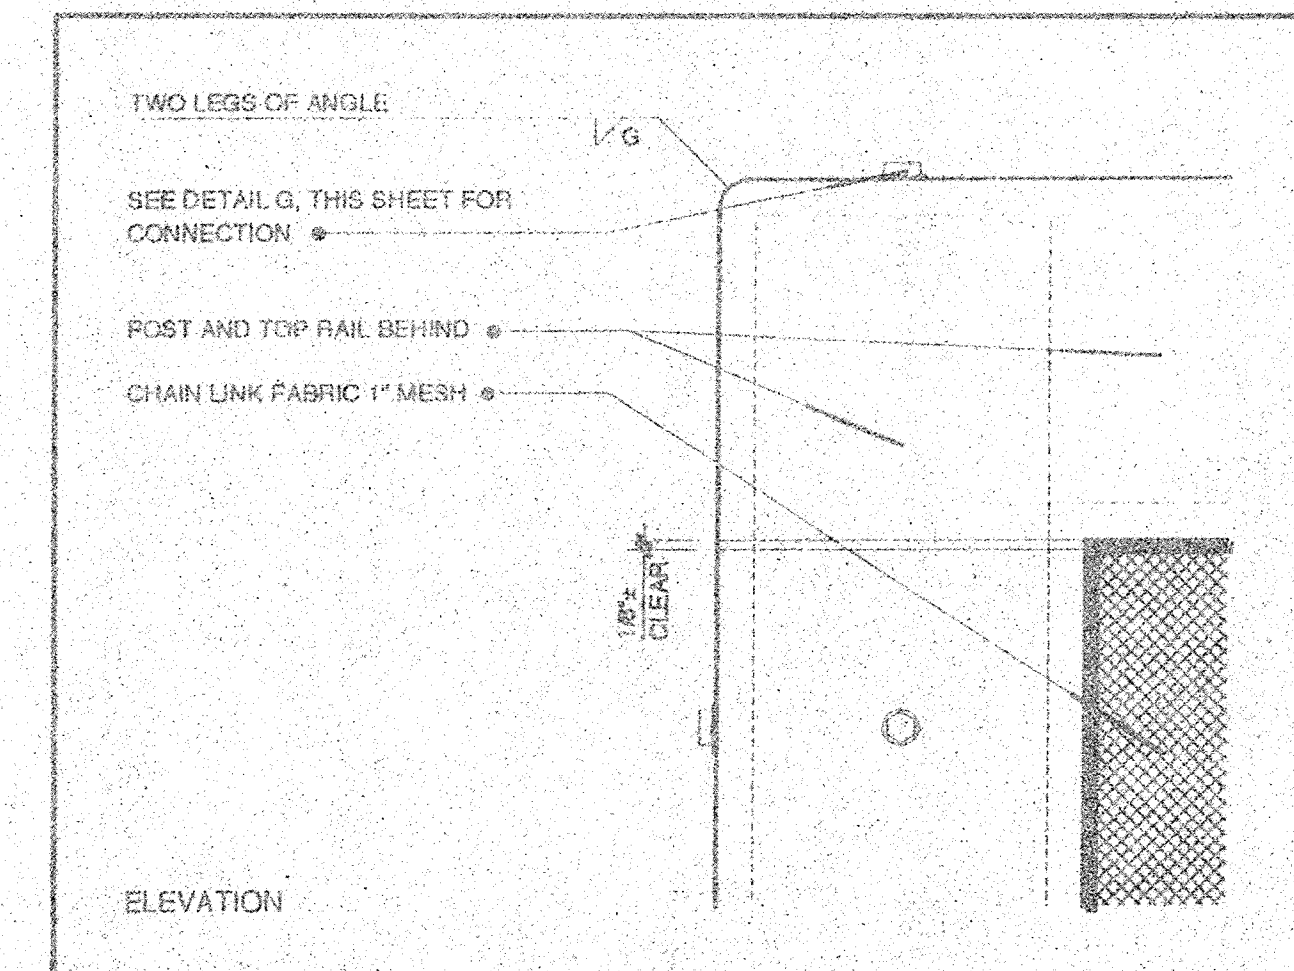

**FENCE DETAIL H-H**  
NO SCALE

|     |             |         |               |                                                                                                                                                                                                                                               |  |  |  |                                                                                          |  |                                                                                       |  |                                                 |  |
|-----|-------------|---------|---------------|-----------------------------------------------------------------------------------------------------------------------------------------------------------------------------------------------------------------------------------------------|--|--|--|------------------------------------------------------------------------------------------|--|---------------------------------------------------------------------------------------|--|-------------------------------------------------|--|
|     |             |         |               | <div>HUNT-ZOLIARS<br/>Hunt-Zoliars, Inc.<br/>15801 Red Hill Avenue, Tustin, CA 92780 (714) 255-7500</div> <div>PROPOSED UNDER THE SUPERVISION OF<br/><i>William Earl</i><br/>WILLIAM R. EARL, CIVIL ENGINEER, No. C45522, Exp. 12-31-99</div> |  |  |  | <div>DESIGNED BY<br/>WRE<br/>DRAWN BY<br/>LL<br/>CHECKED BY<br/>WRE<br/>FIELD BOOK</div> |  | <div>ARCHITECTURAL DETAILS<br/>OSO PARKWAY<br/>PEDESTRIAN BRIDGE<br/>LAS FLORES</div> |  | <div>SHEET<br/>9<br/>OF<br/>10<br/>SHEETS</div> |  |
|     |             |         |               | <div>PROFESSIONAL<br/>SEAL<br/>W.R. Earl<br/>No. C45522<br/>Exp. 12-31-99<br/>CIVIL<br/>STATE OF CALIFORNIA</div>                                                                                                                             |  |  |  |                                                                                          |  | <div>10-3402-01</div>                                                                 |  |                                                 |  |
| NO. | DESCRIPTION | BY/DATE | APPROVED/DATE |                                                                                                                                                                                                                                               |  |  |  |                                                                                          |  |                                                                                       |  |                                                 |  |

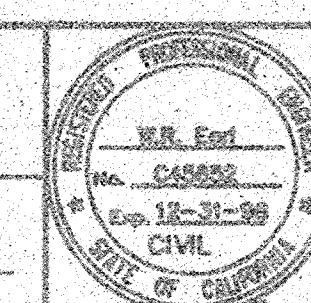

*DR. H. H. G. 12/3/99*