

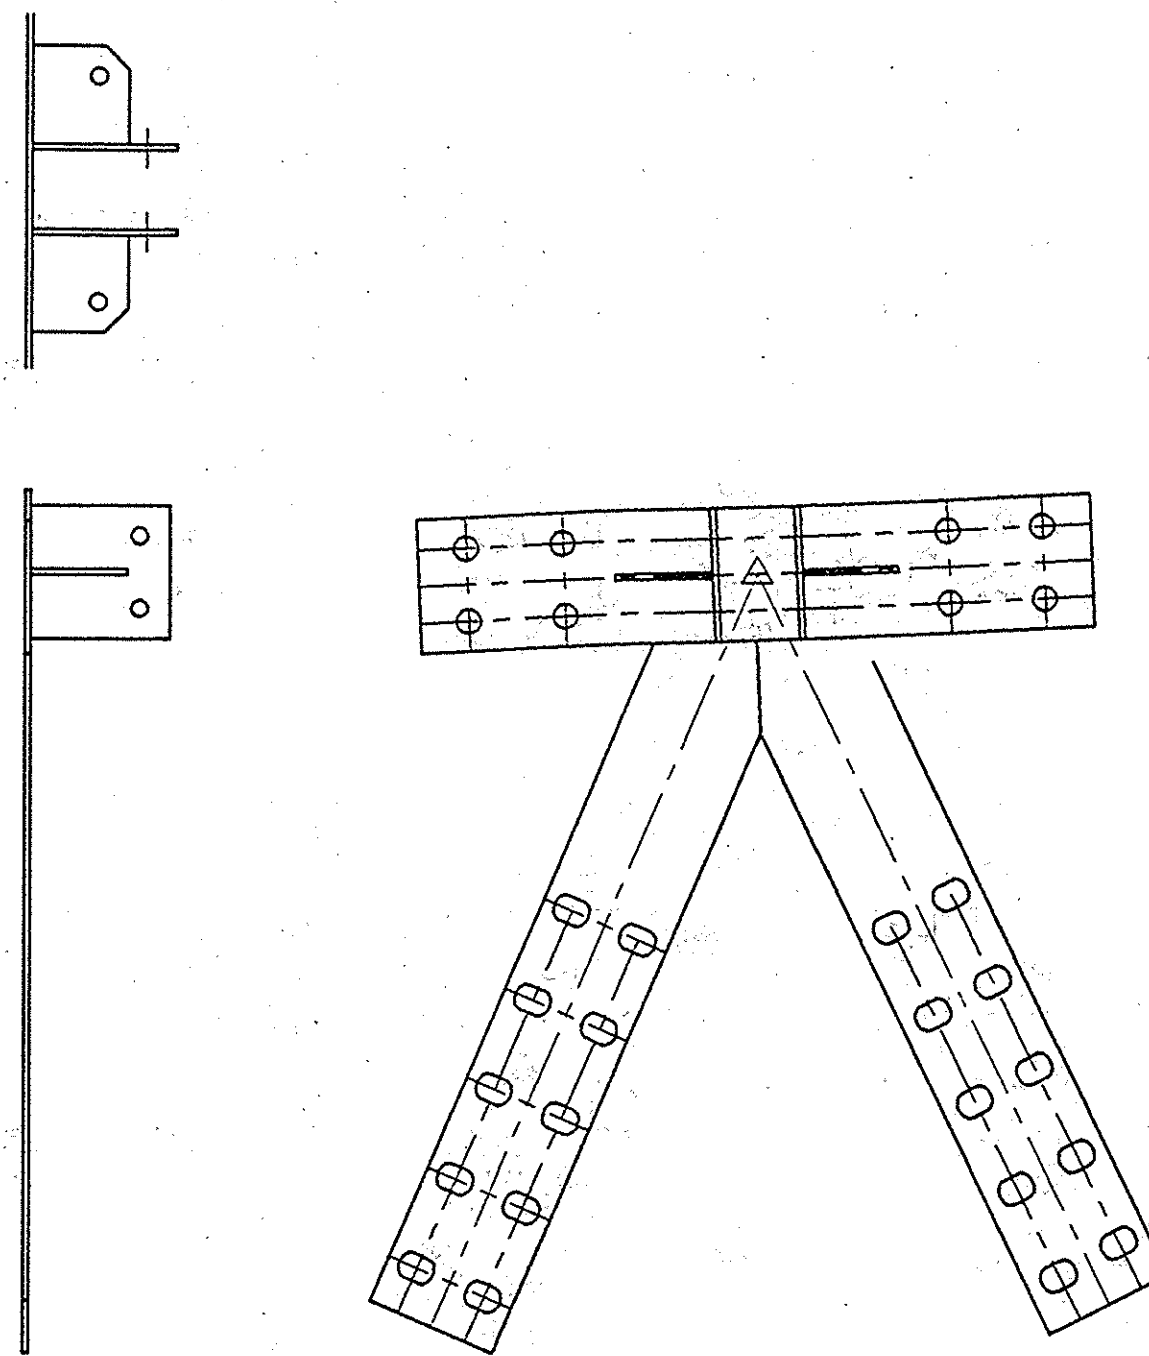


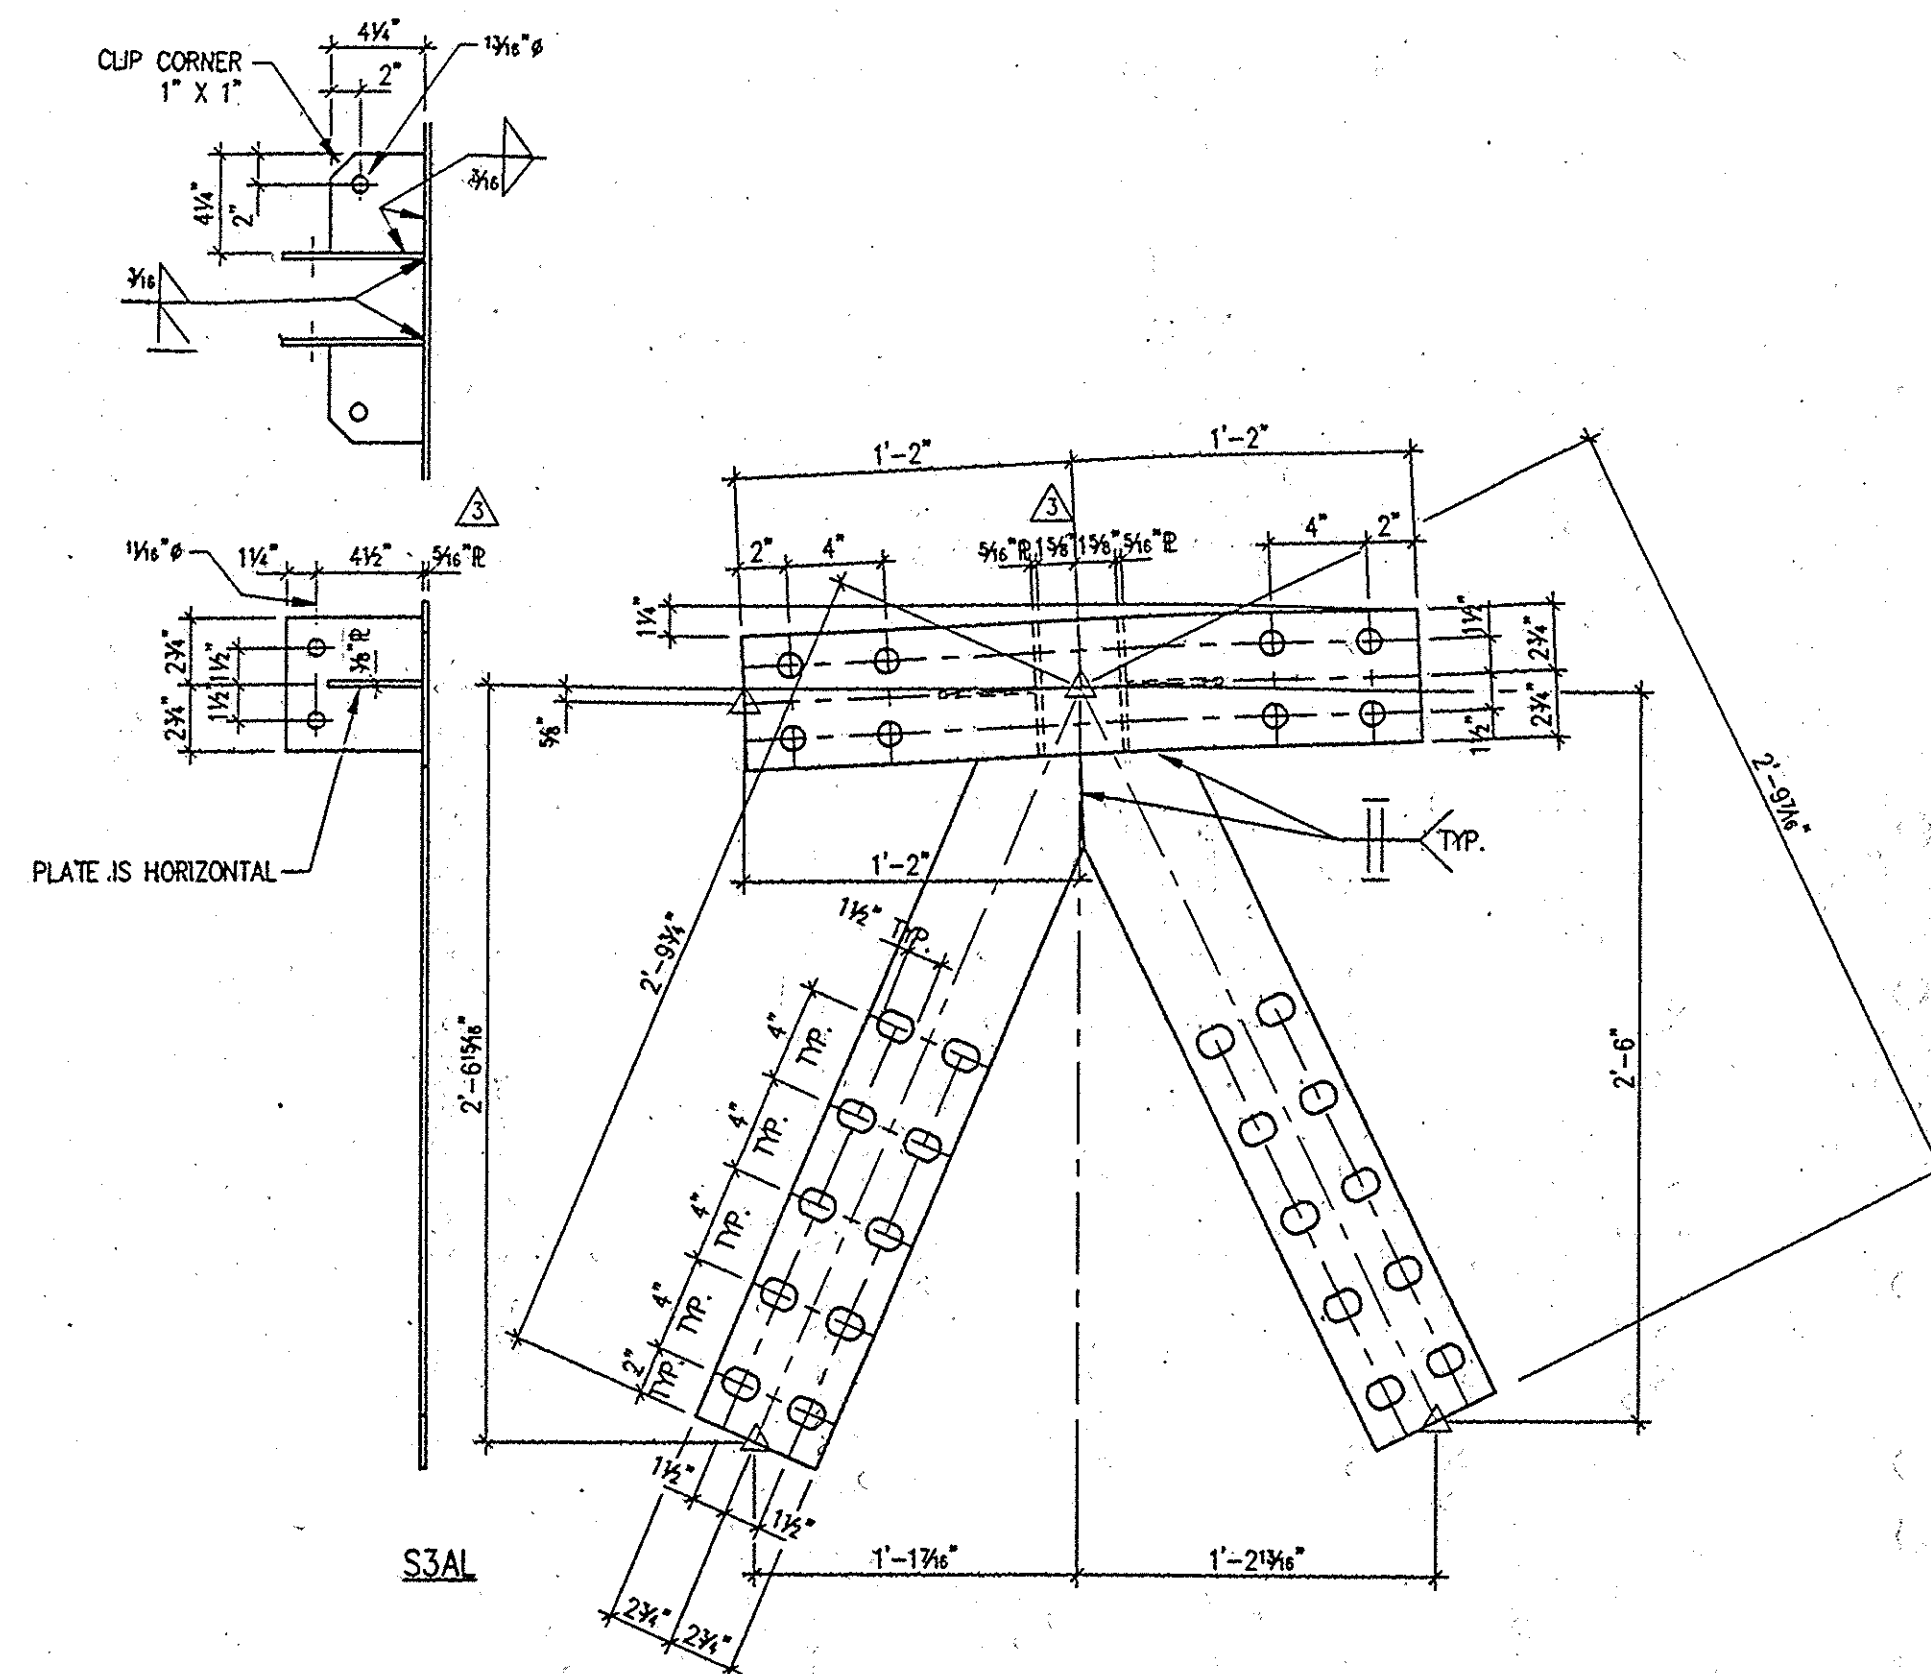



ALL SLOTTED HOLES 1 1/2" x 1 1/2" EXC. AS NOTED
ALL HOLES 1 1/2" x 1 1/2" EXC. AS NOTED

WELDED STEEL ASS'Y. - S3AL & S3AR
S3AL - 2 REQ'D
S3AR - 2 REQ'D

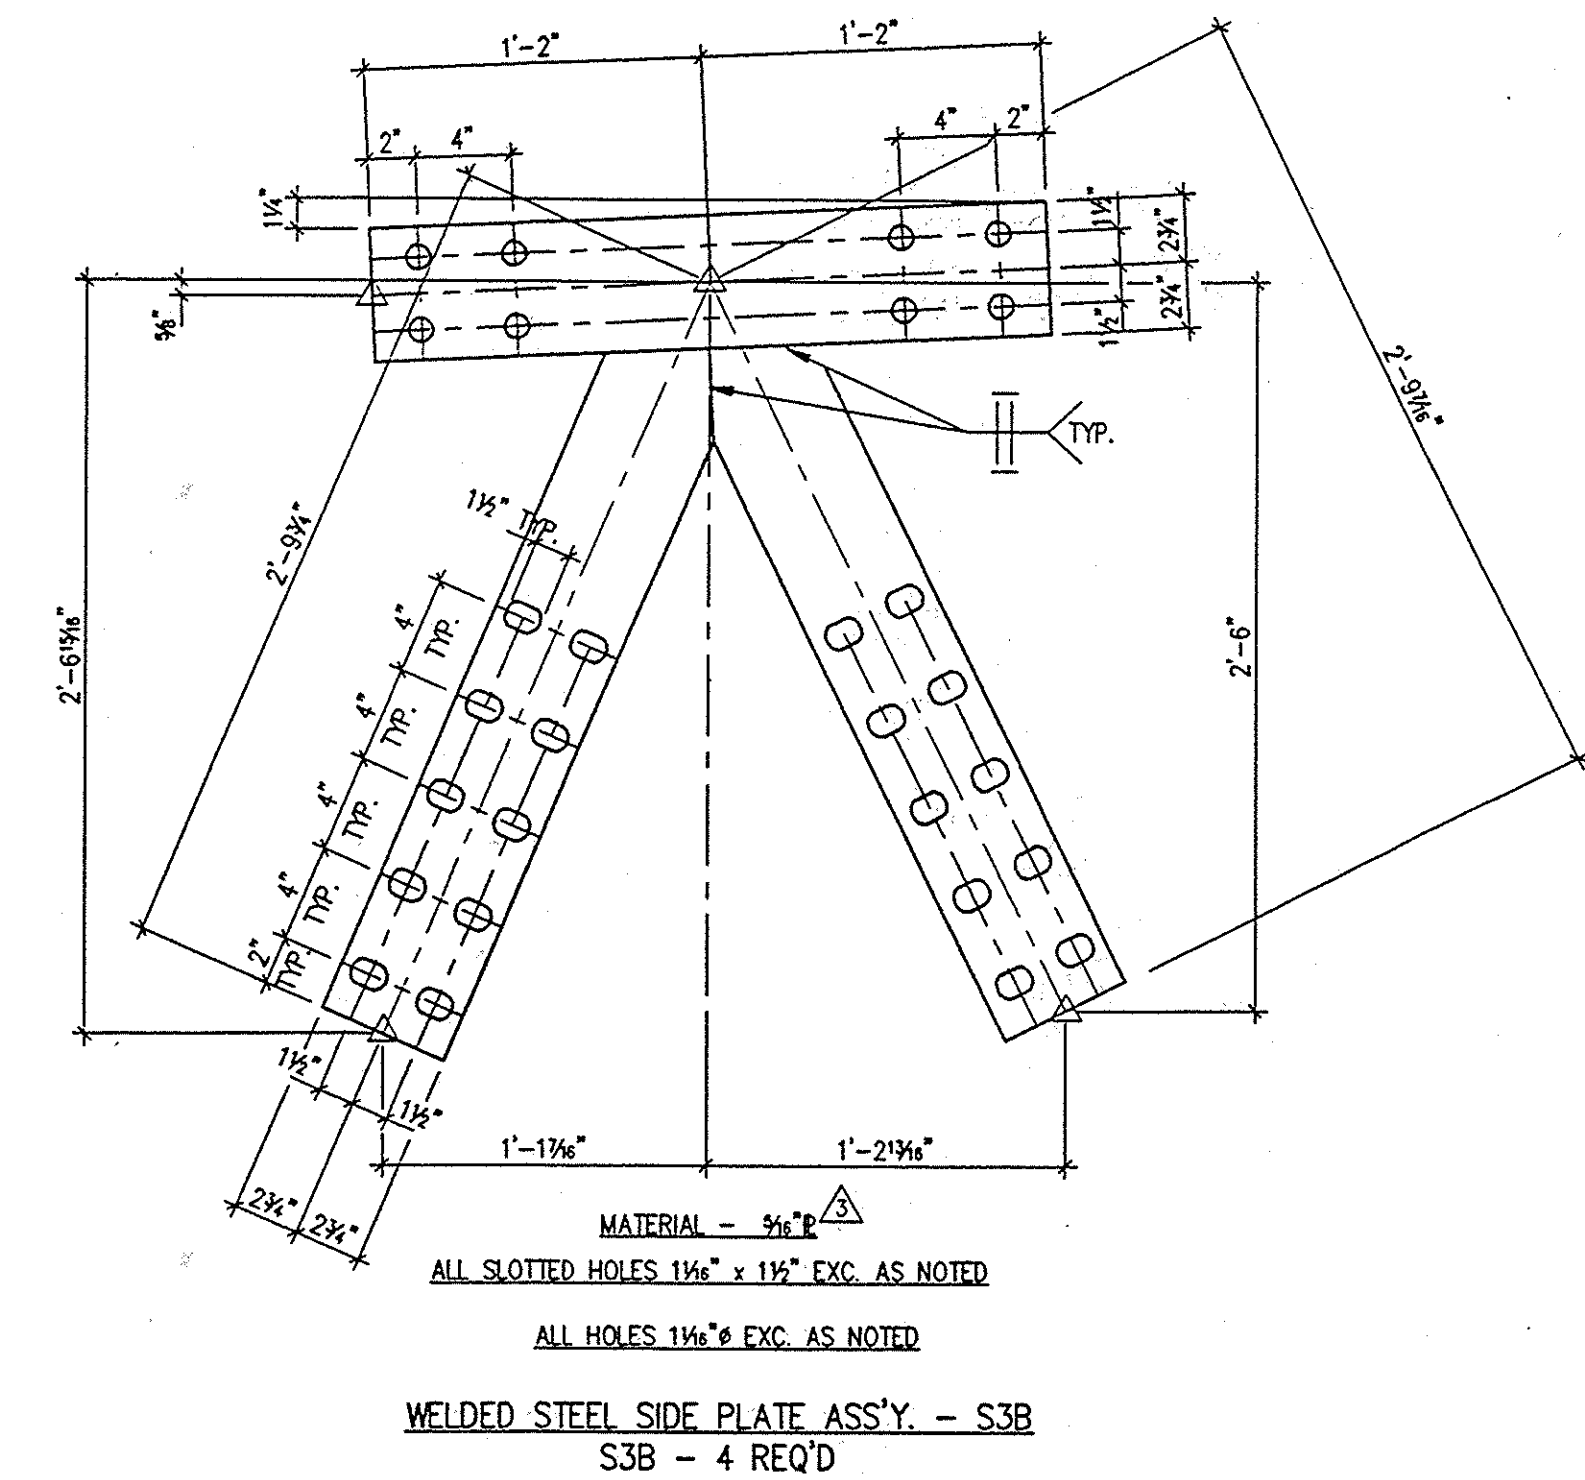


MATERIAL - 3/8" PL
ALL SLOTTED HOLES 1 1/2" x 1 1/2" EXC. AS NOTED
ALL HOLES 1 1/2" x 1 1/2" EXC. AS NOTED

WELDED STEEL SIDE PLATE ASS'Y. - S3B
S3B - 4 REQ'D

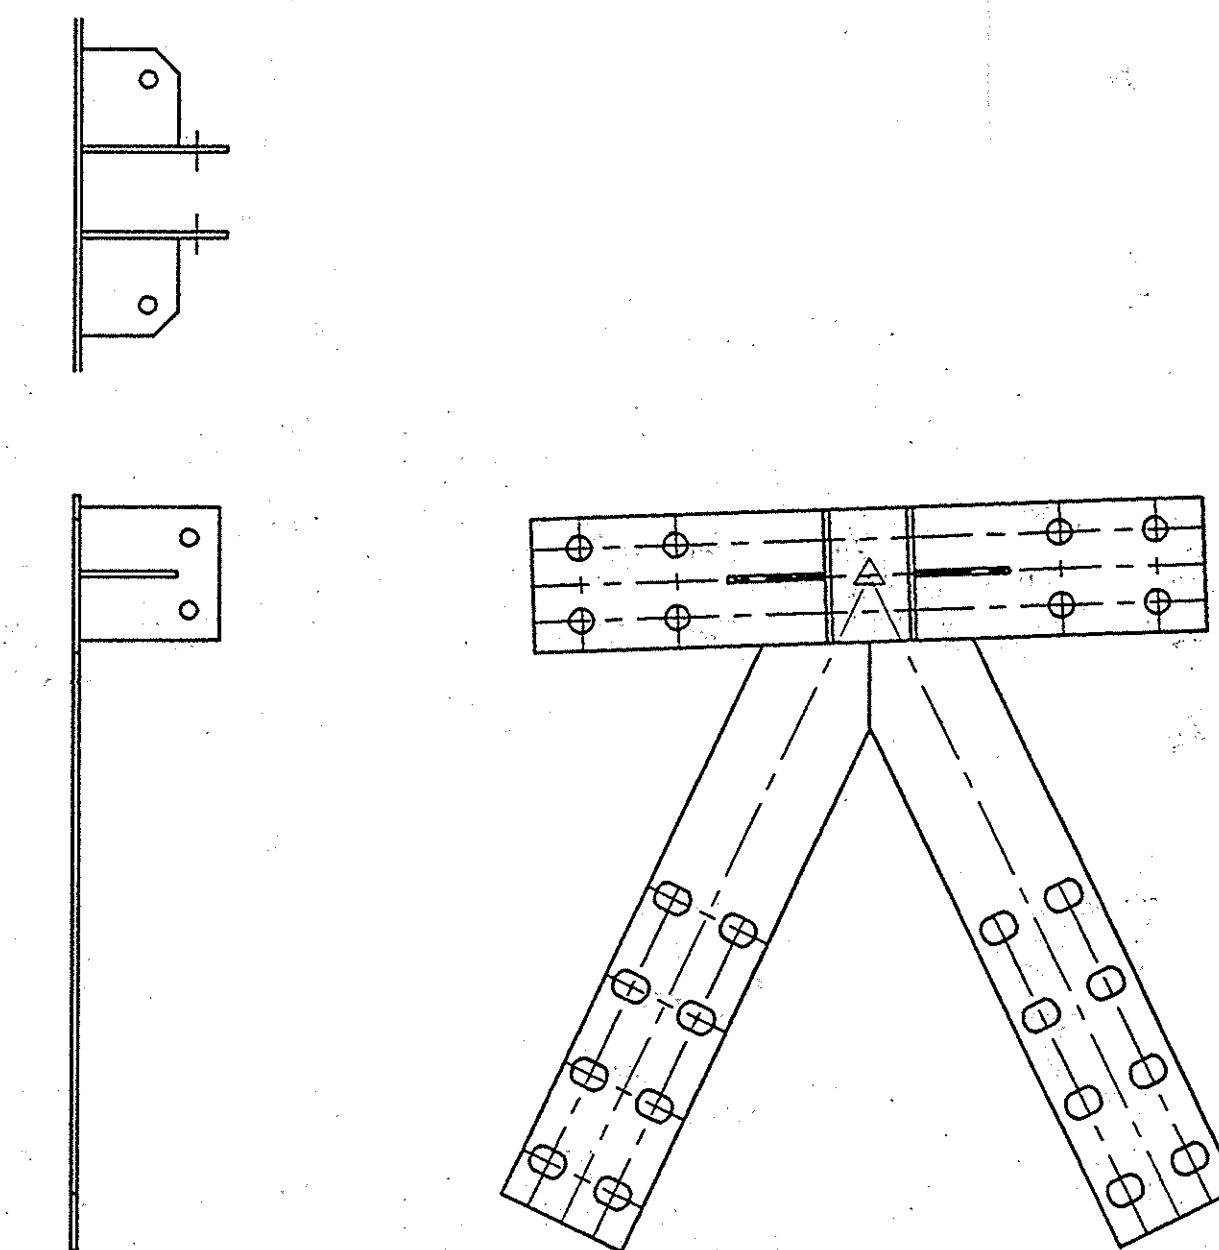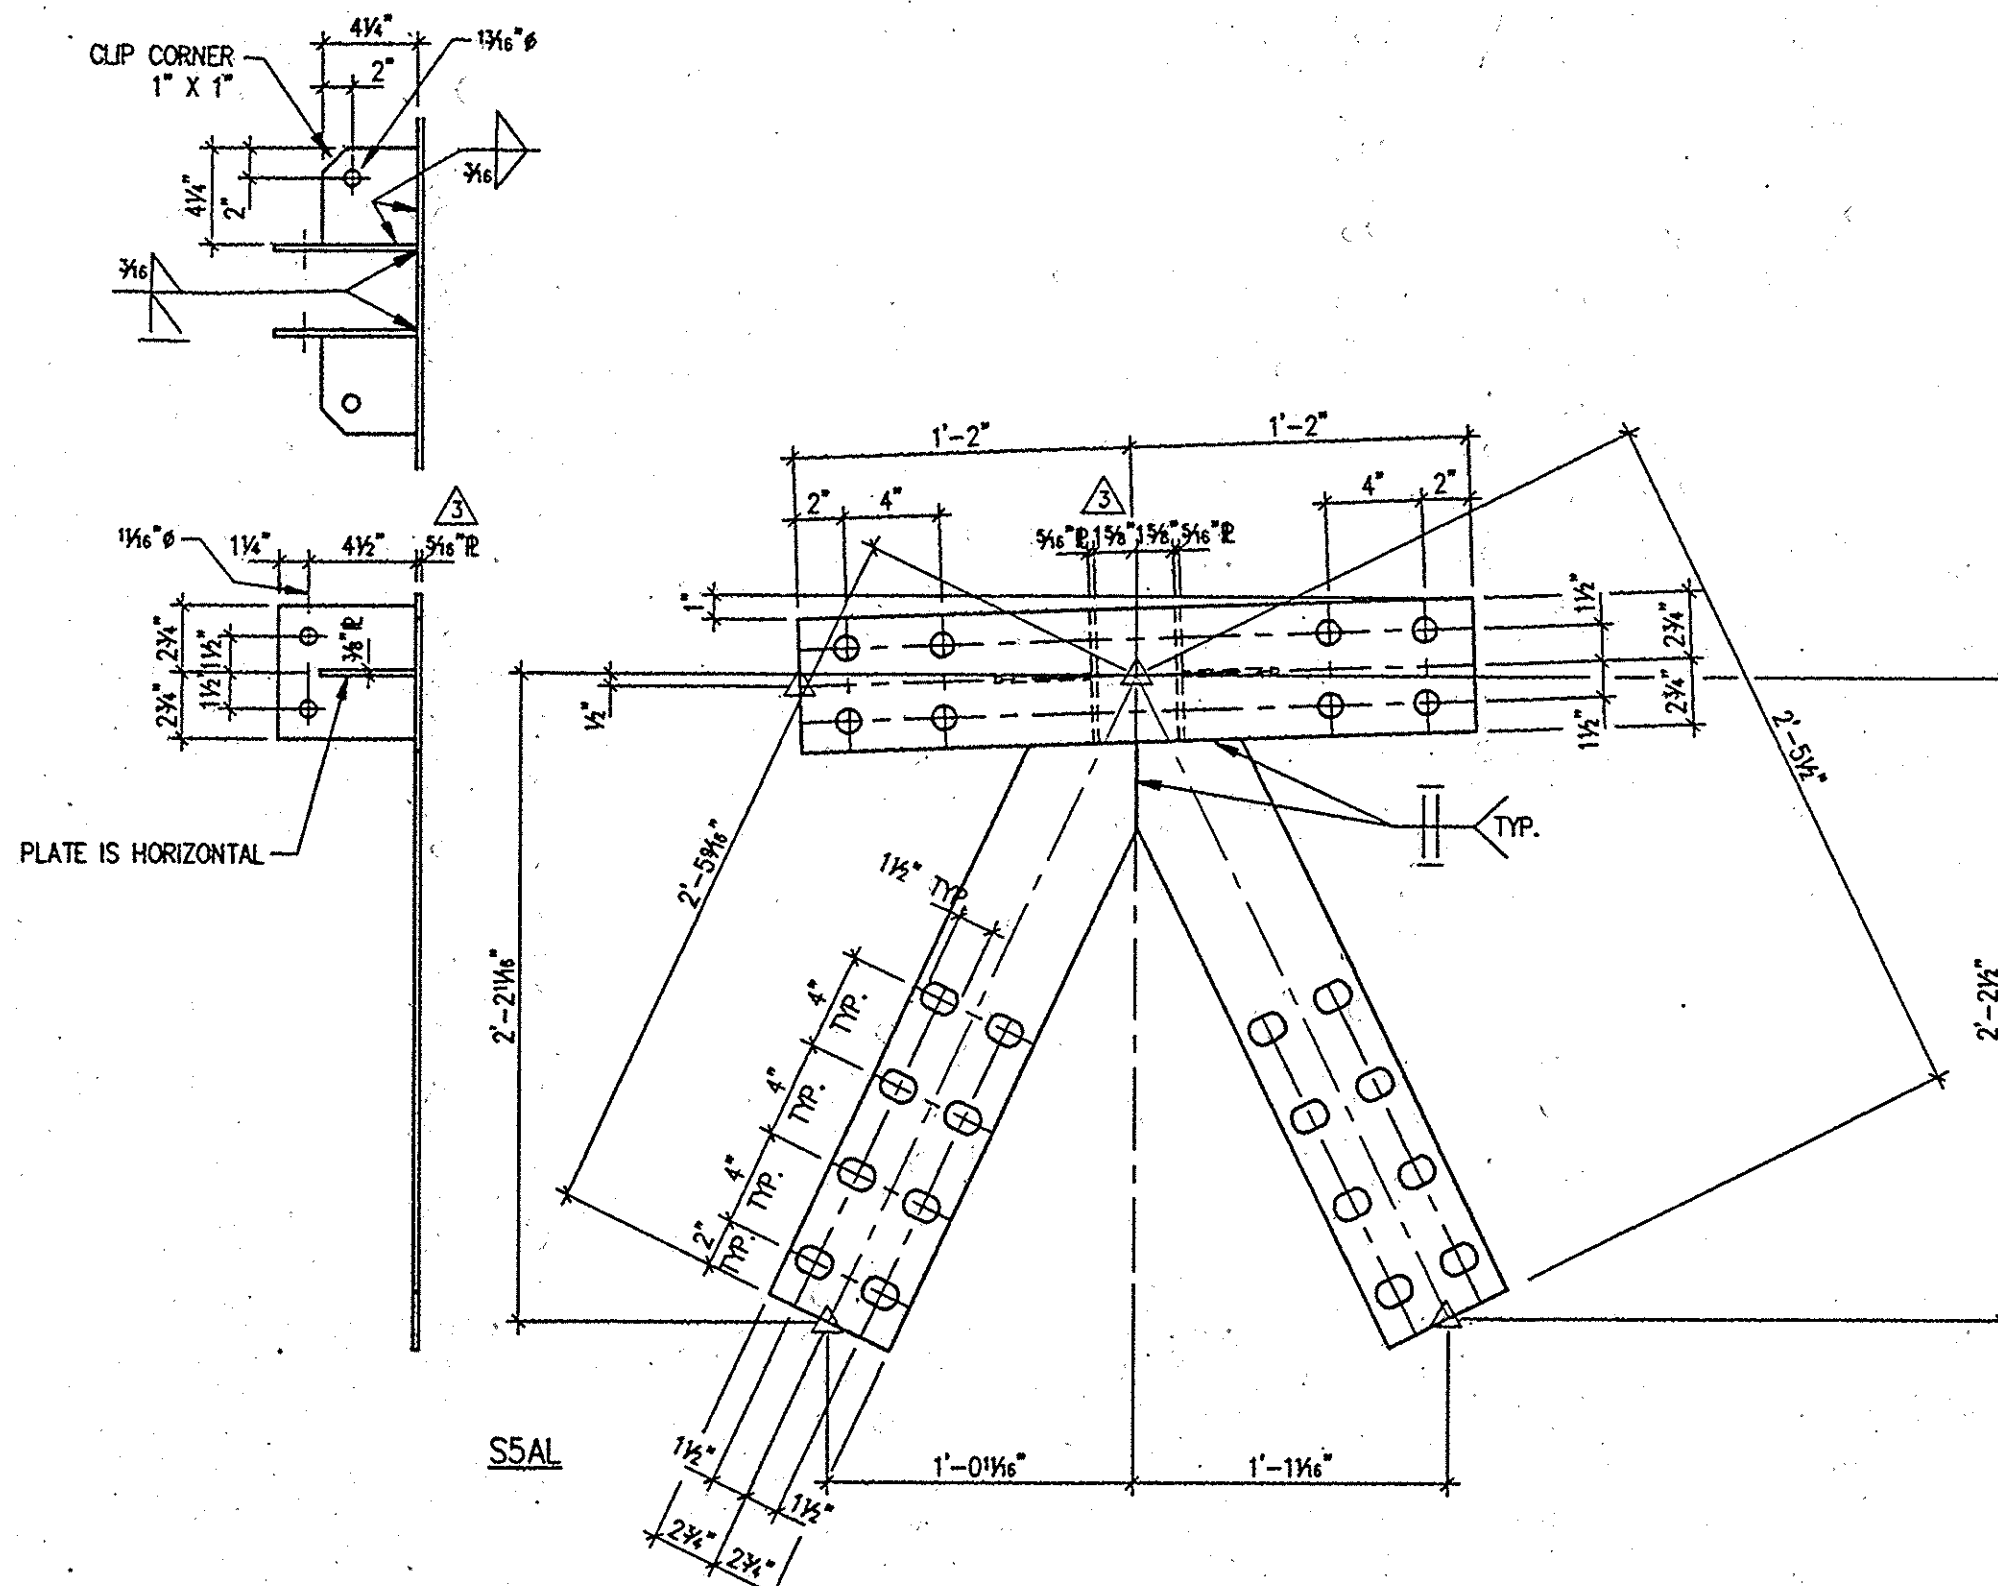


ALL SLOTTED HOLES 1 1/2" x 1 1/2" EXC. AS NOTED
ALL HOLES 1 1/2" x 1 1/2" EXC. AS NOTED

WELDED STEEL ASS'Y. - S5AL & S5AR
S5AL - 2 REQ'D
S5AR - 2 REQ'D

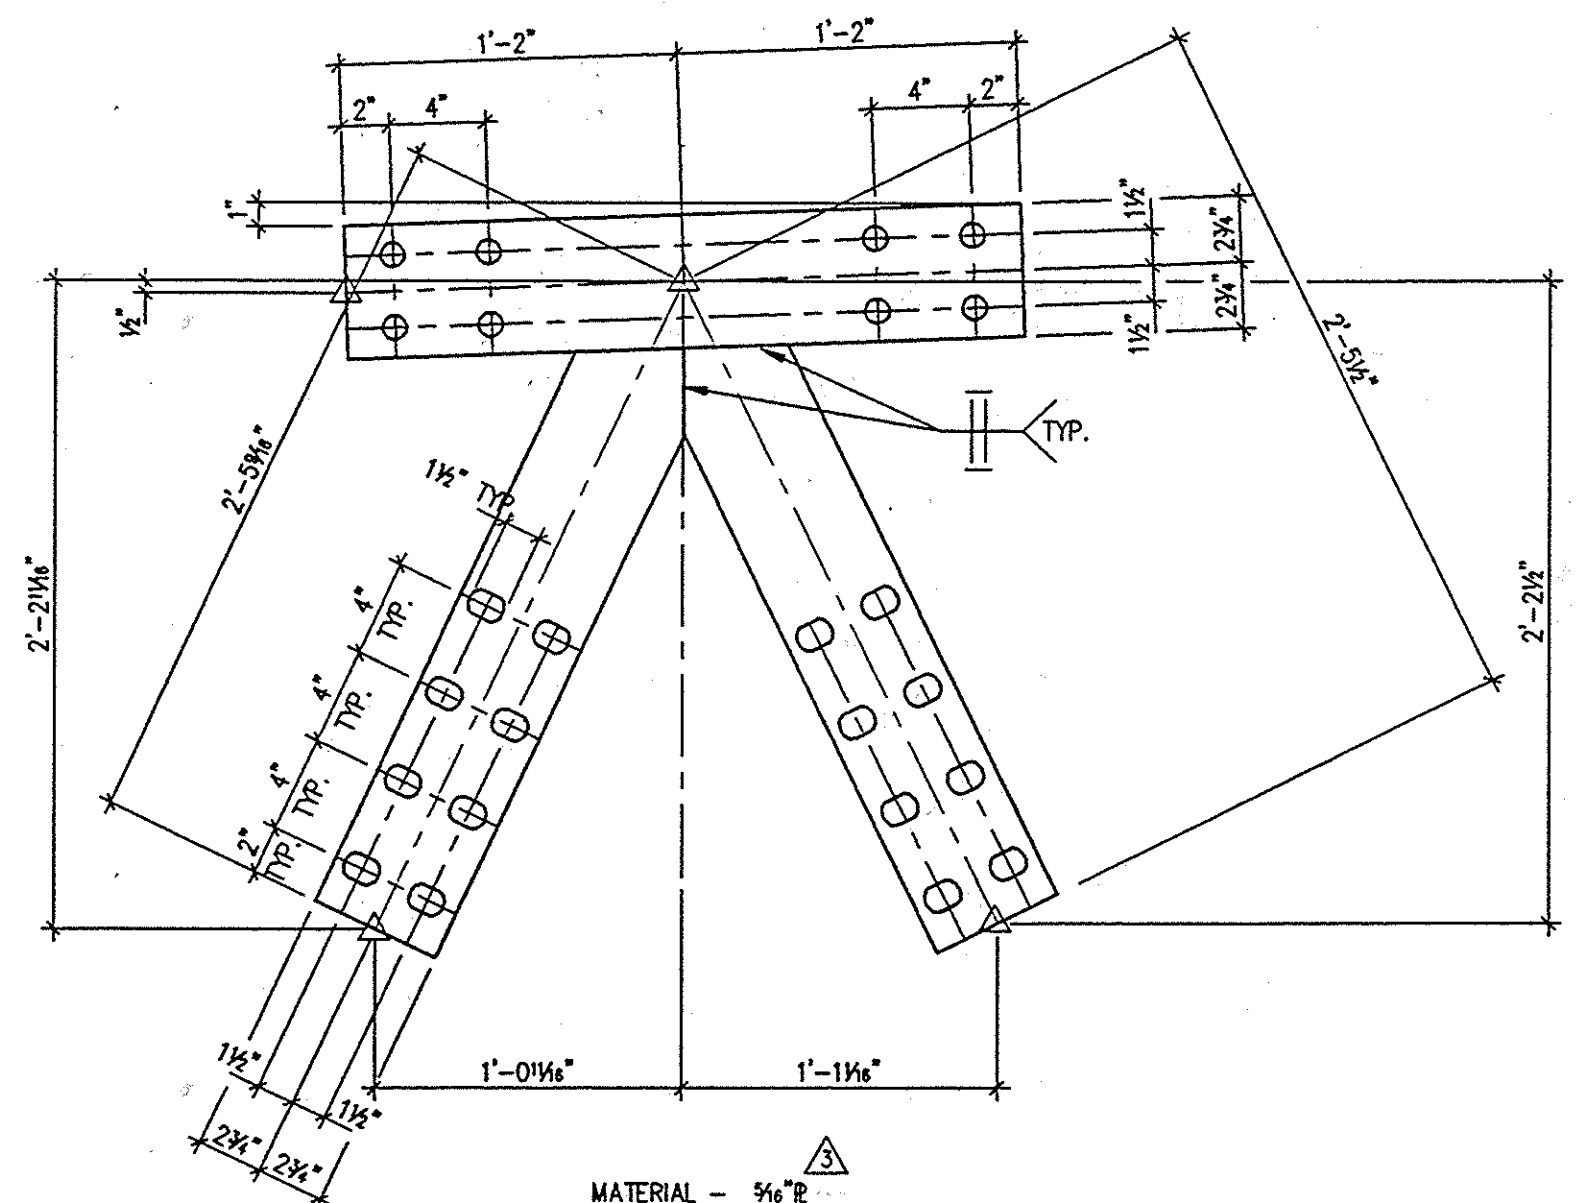


MATERIAL - 3/8" PL
ALL SLOTTED HOLES 1 1/2" x 1 1/2" EXC. AS NOTED
ALL HOLES 1 1/2" x 1 1/2" EXC. AS NOTED

WELDED STEEL SIDE PLATE ASS'Y. - S5B
S5B - 4 REQ'D

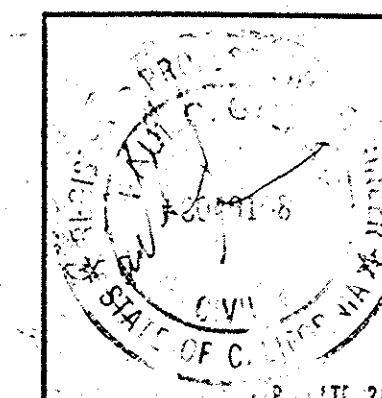

NO.	DATE	REVISIONS	BY
1	5-3-96	PER APPROVAL	BD
2	2-14-96	PER APPROVAL	BD

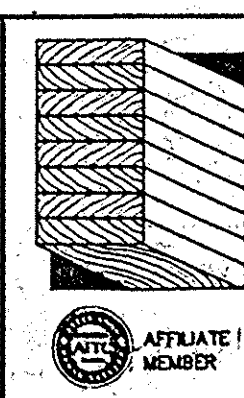

WESTERN WOOD STRUCTURES, INC.
P.O. BOX 130 TUALATIN, OREGON 97062
503/692-6900 FAX 503/692-6434
FROM: AZ, CA, ID, MT, NV, UT, WA, WY 800/547-5411

PROJECT: TALBERT CHANNEL BRIDGE
LOCATION: SANTA ANA, CALIFORNIA
ARCHITECT:
ENGINEER:
CONTRACTOR: ADVANCO CONTRACTORS
DRAWN BY: BD DATE 11-20-95 JOB NO. 954056
CHECKED BY: KPH DATE 11-28-95
DATE PRINTED: 2-18-96 SHEET 3 OF 8