

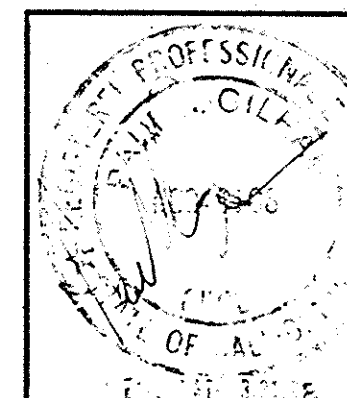
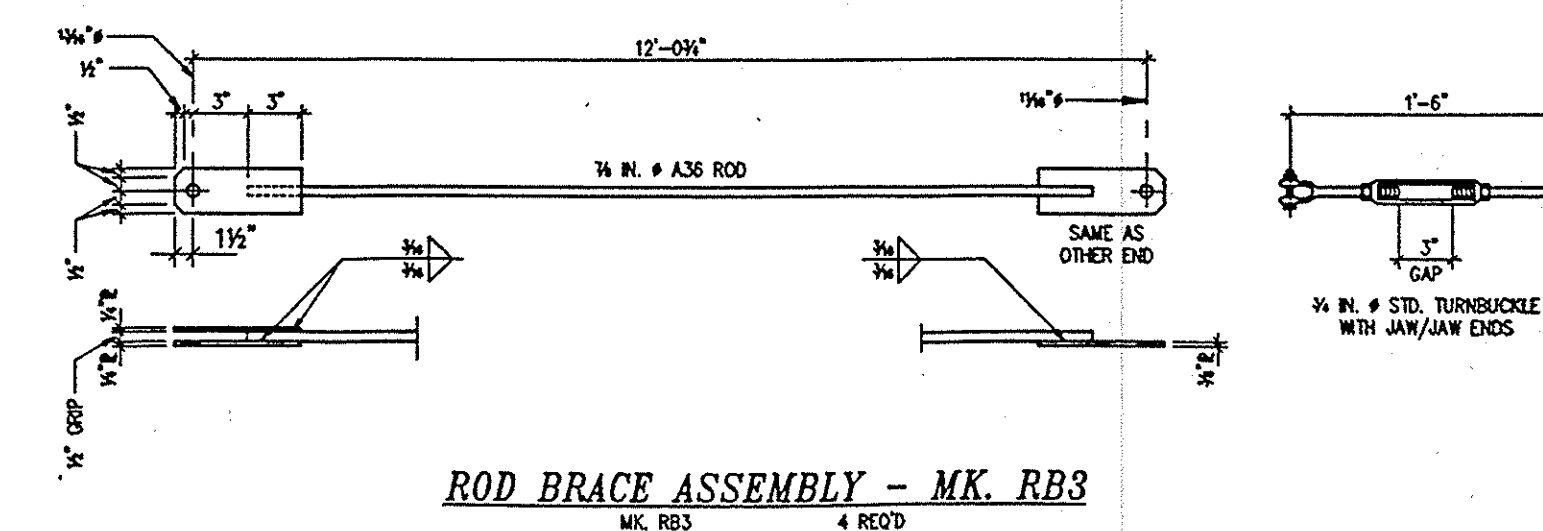
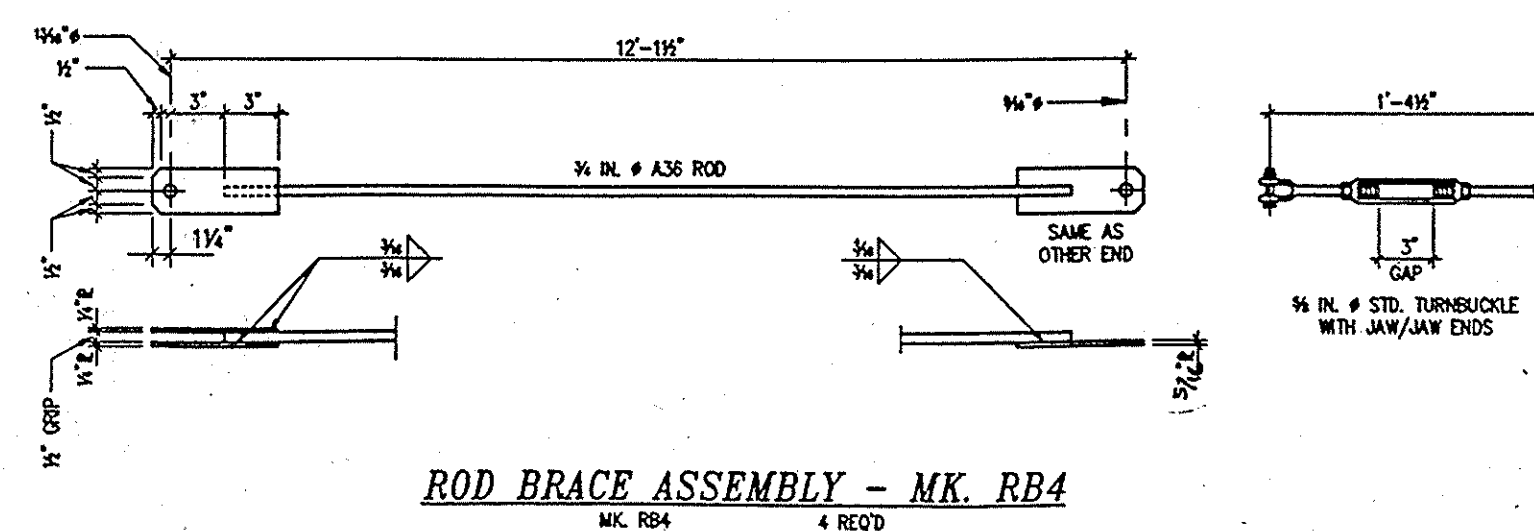
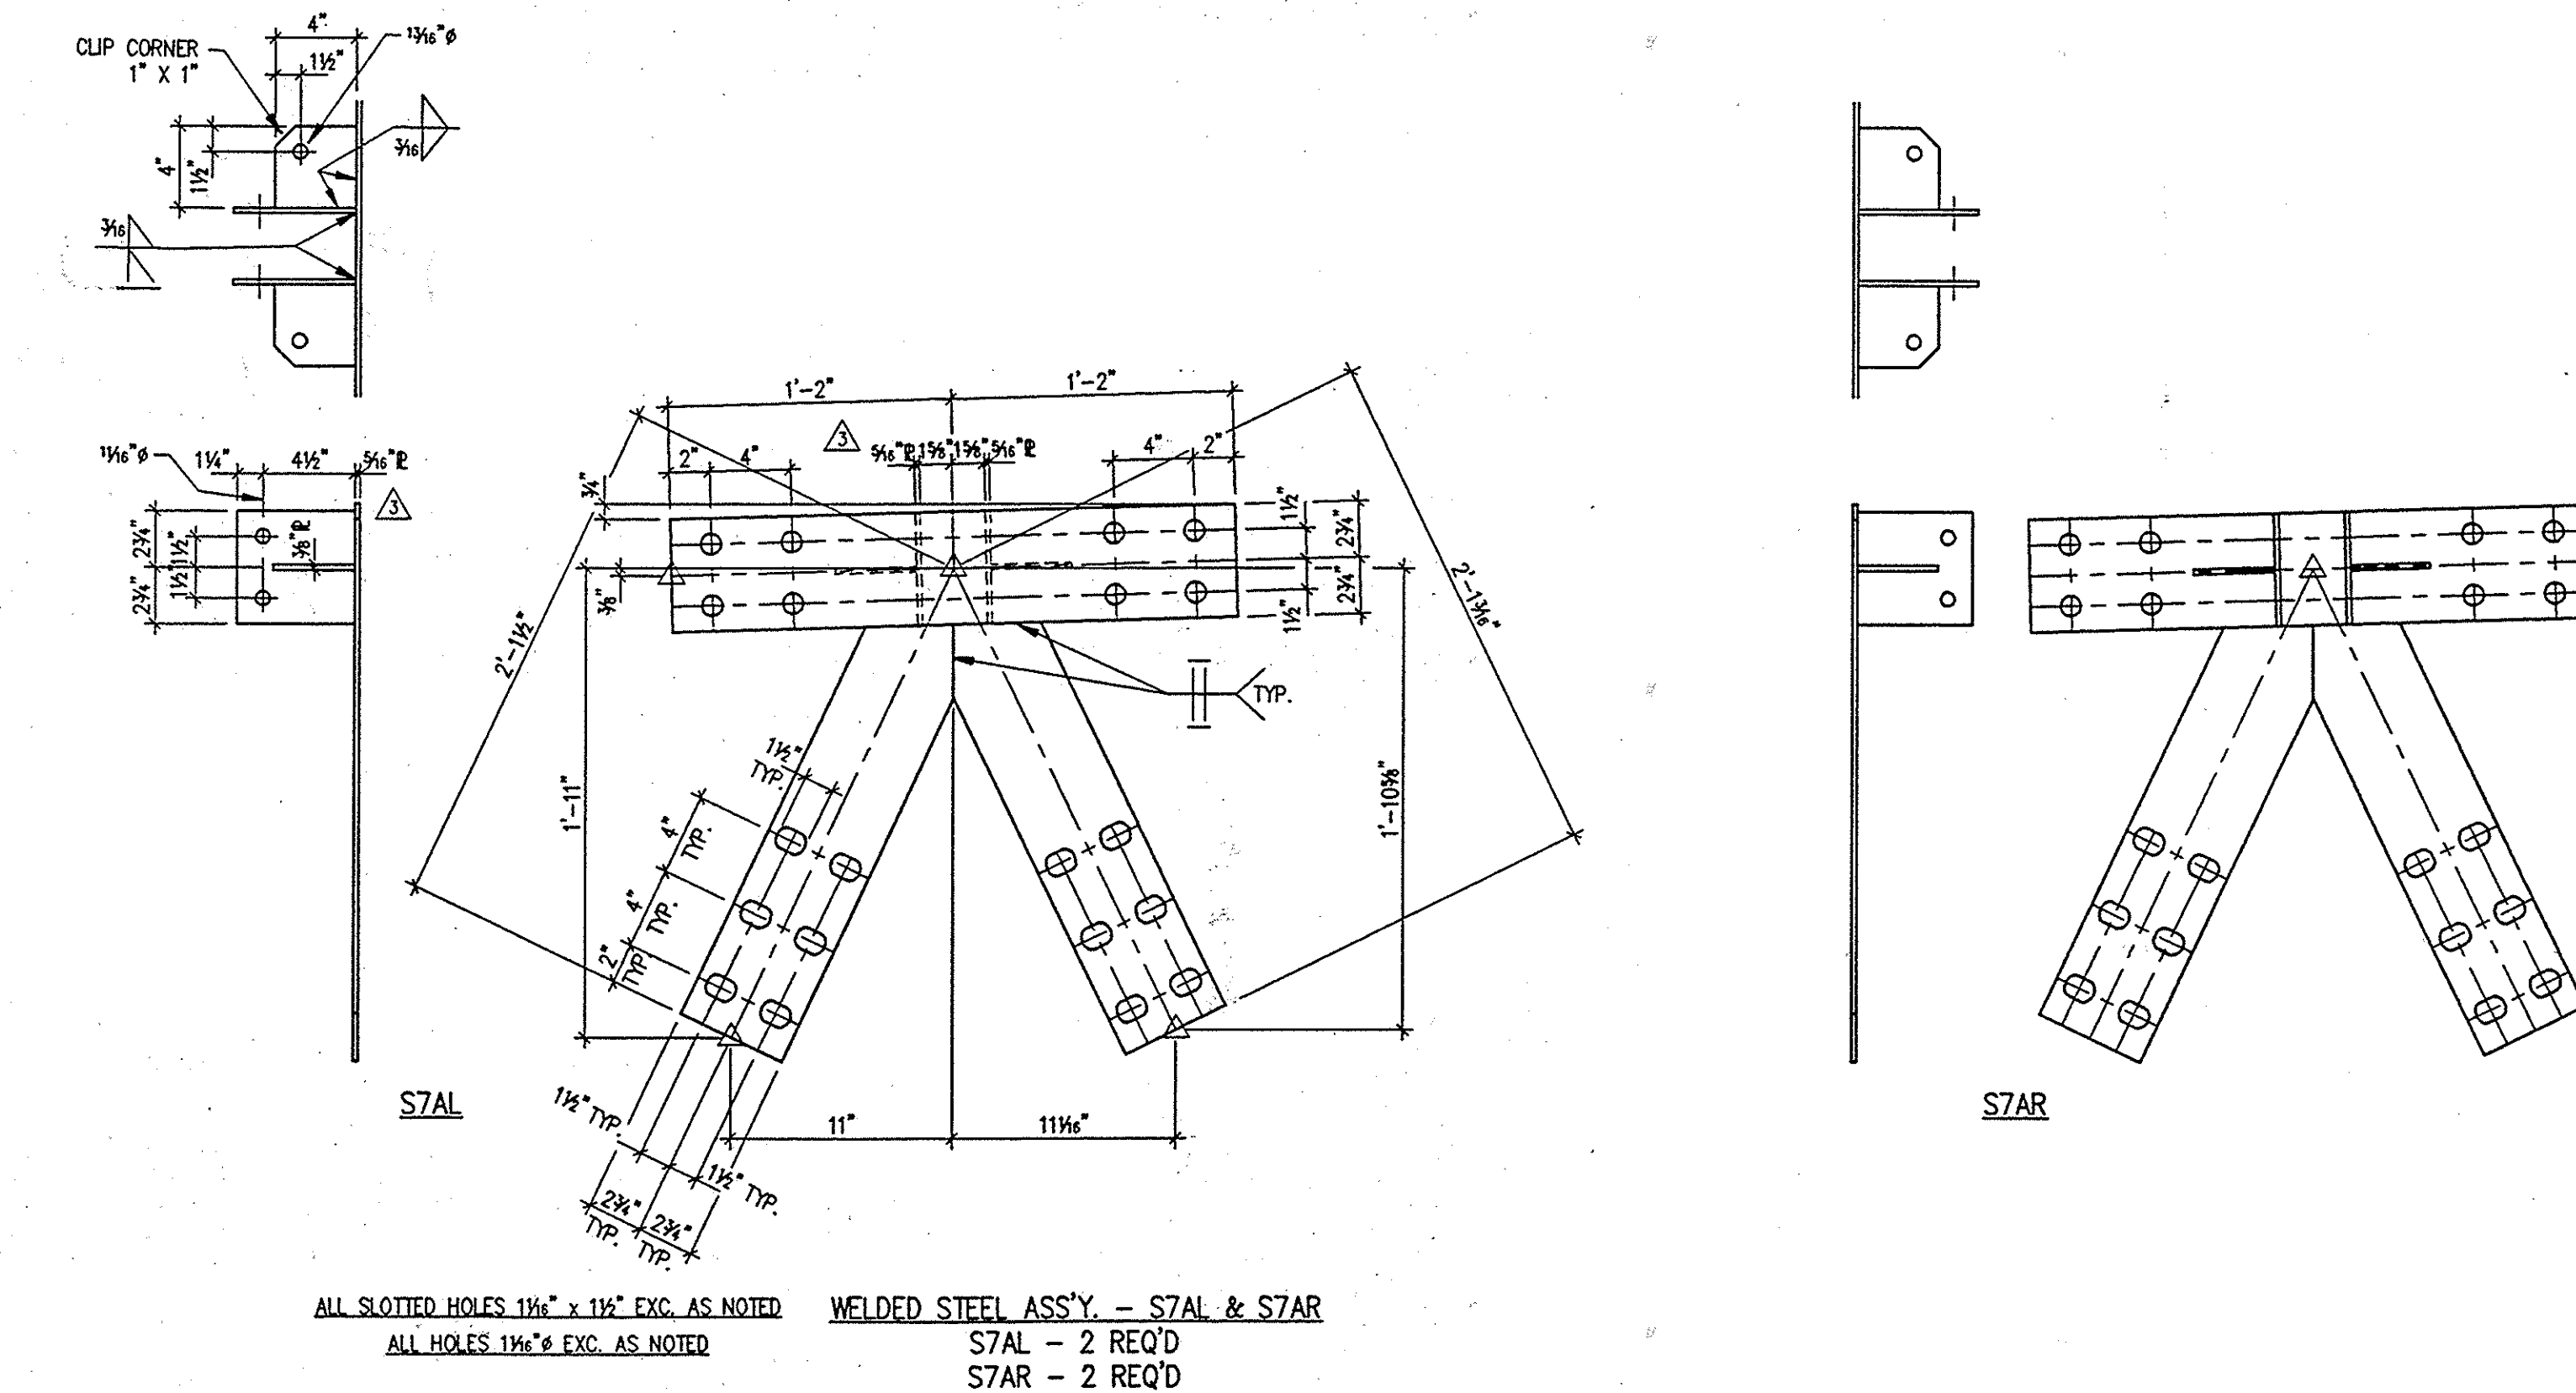
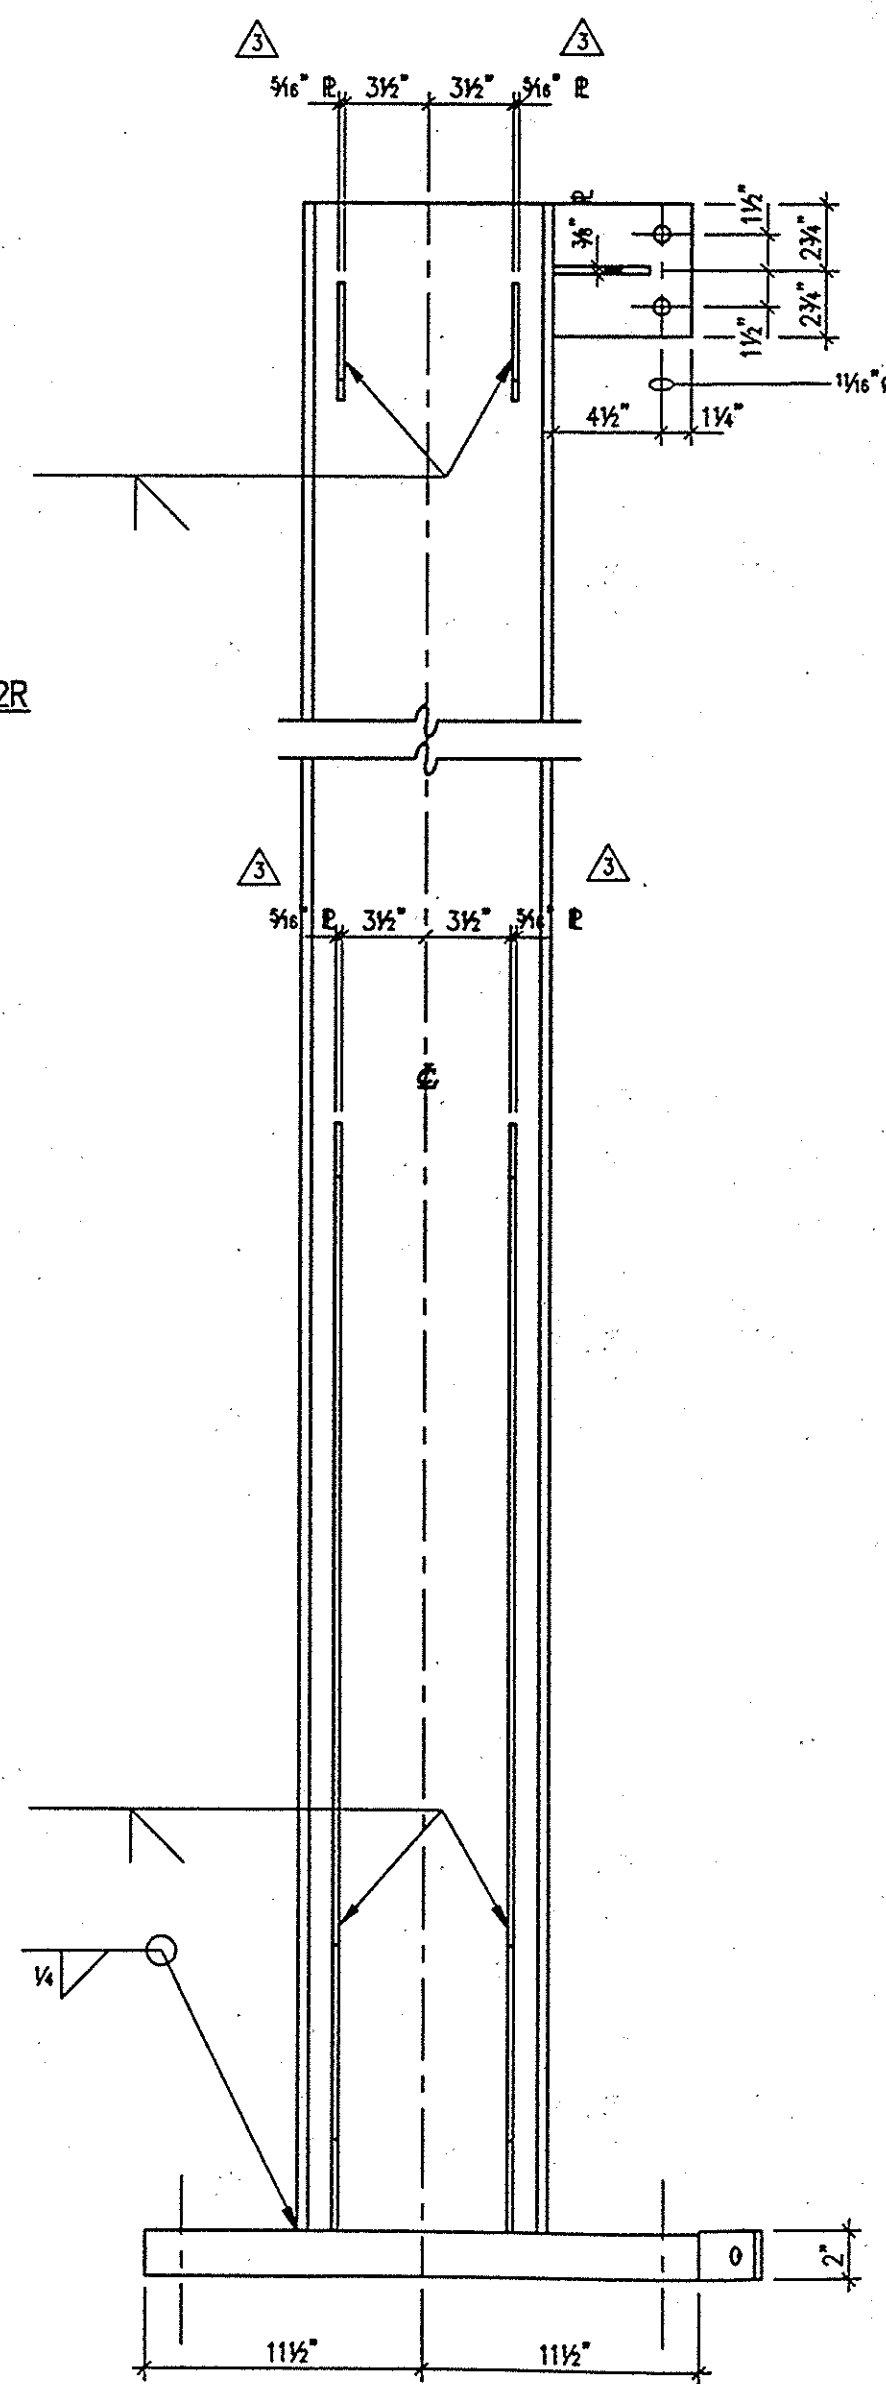
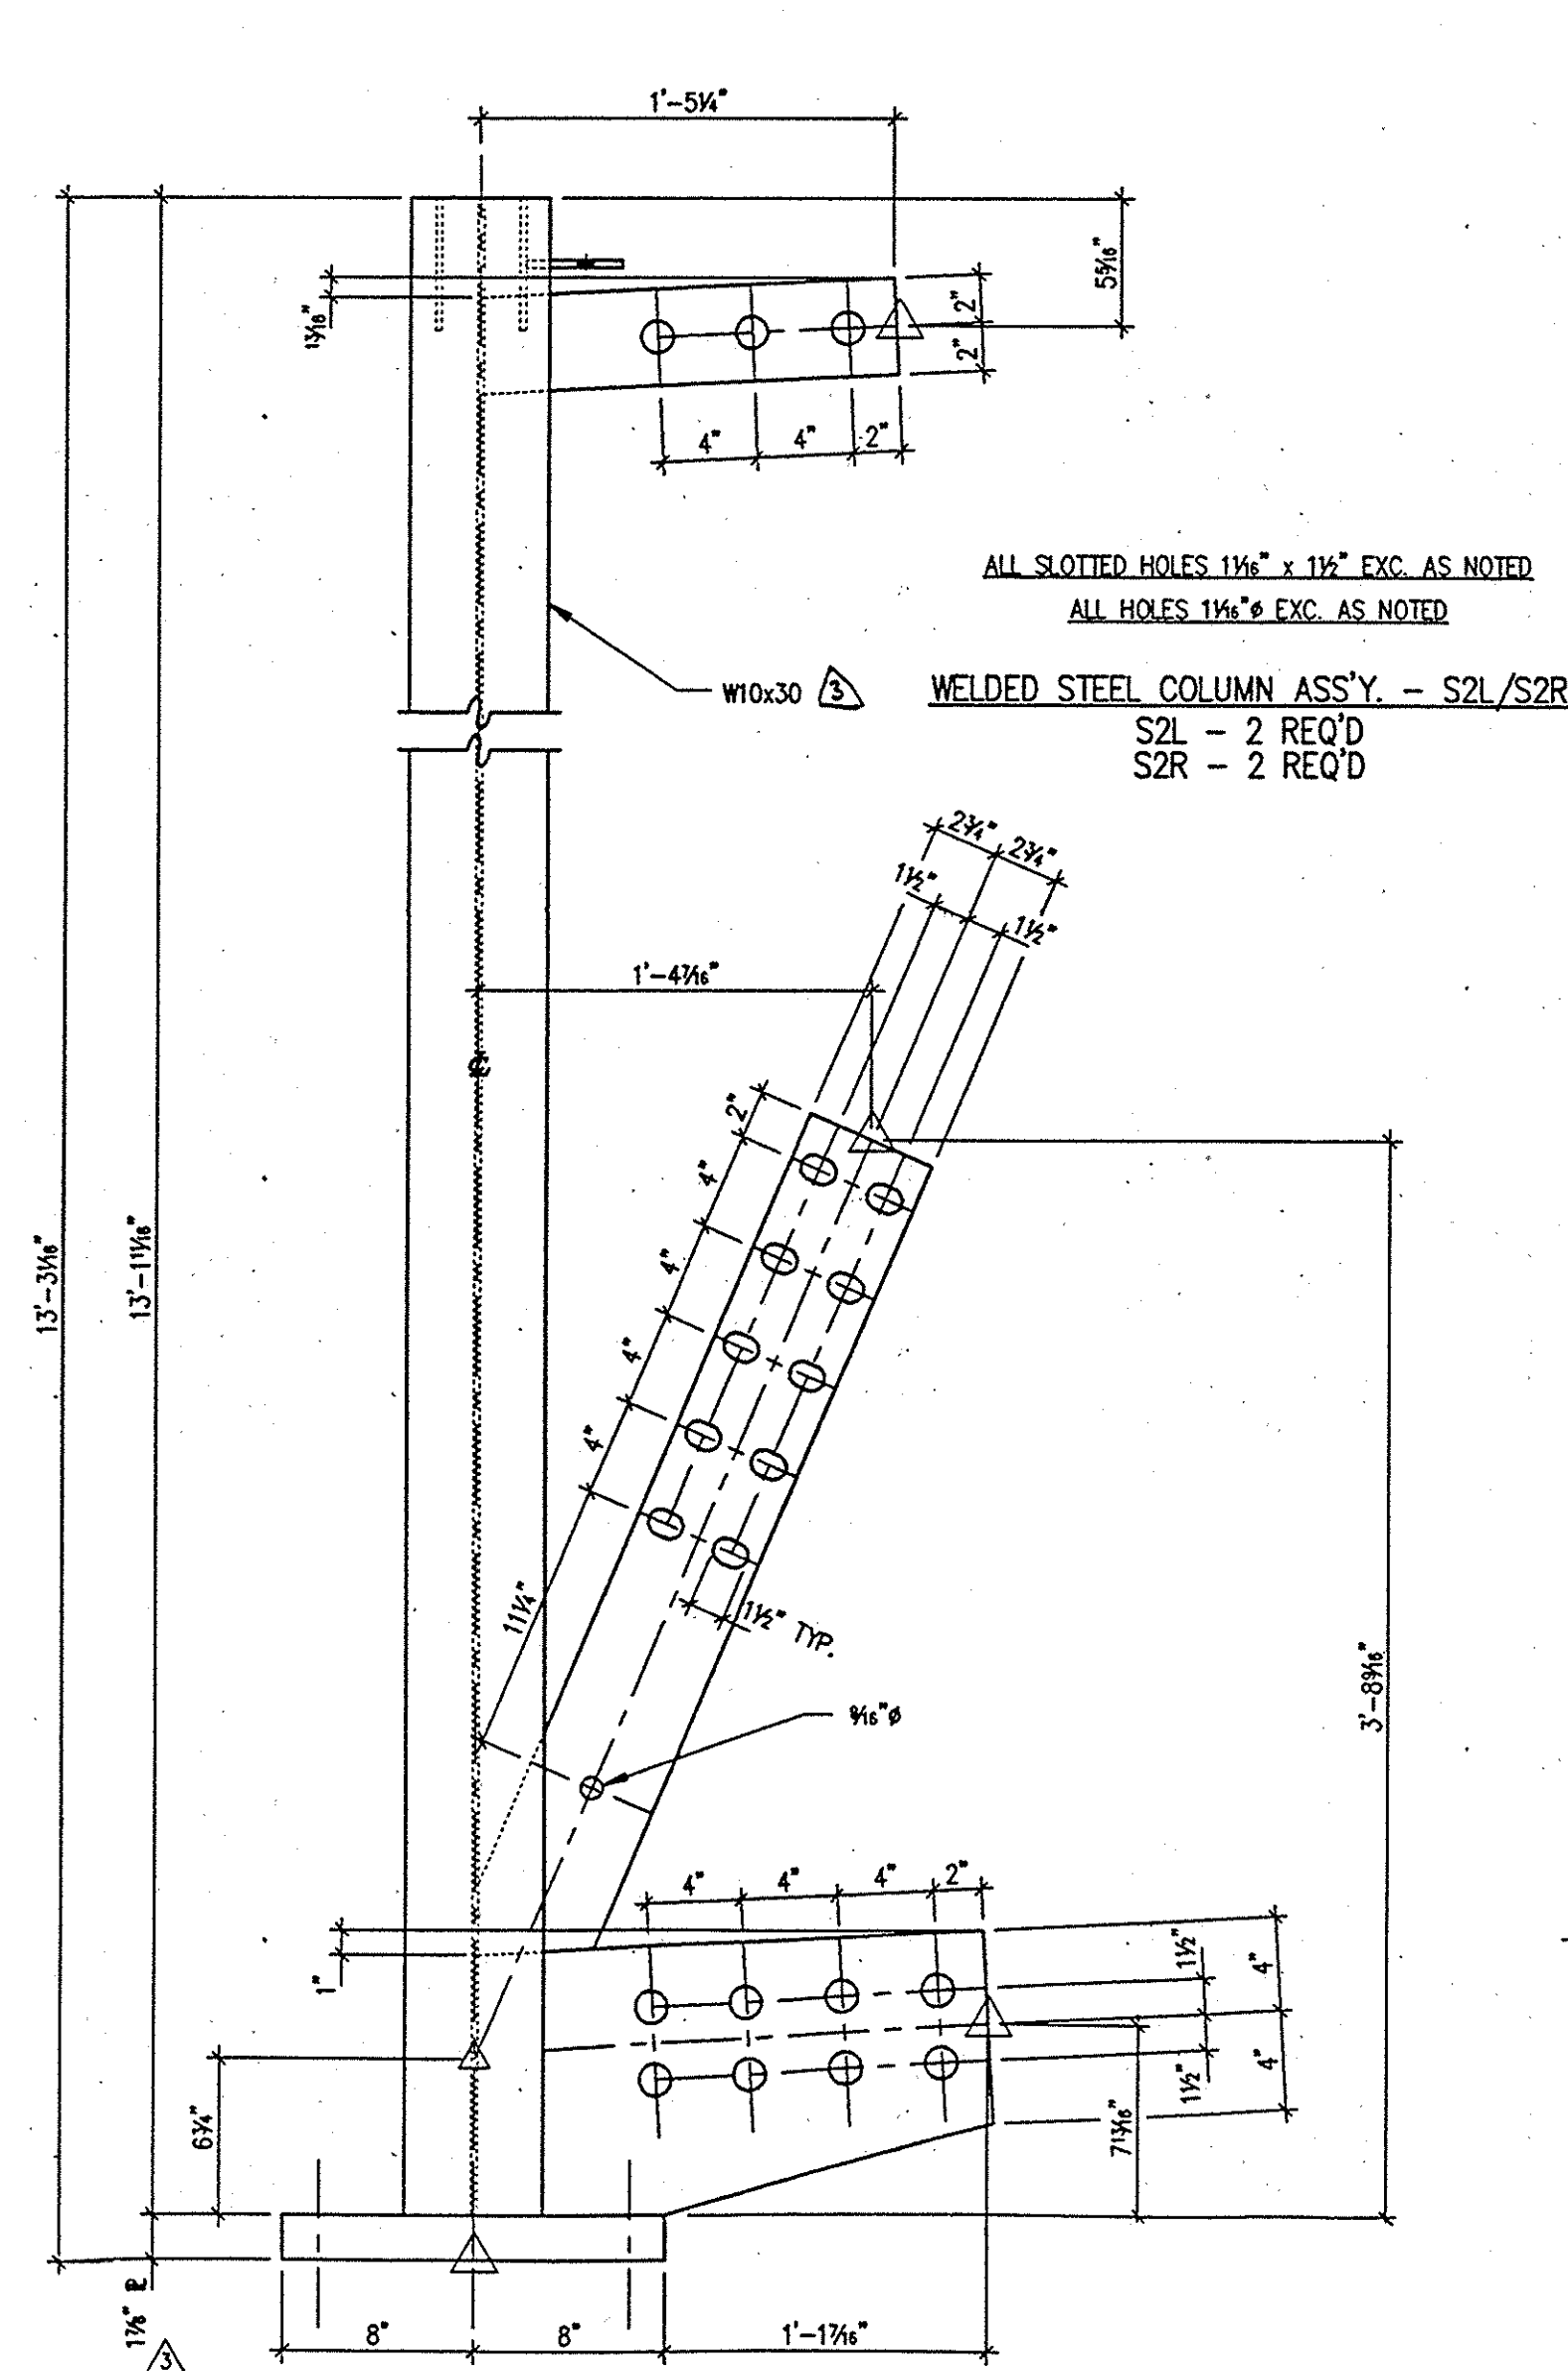
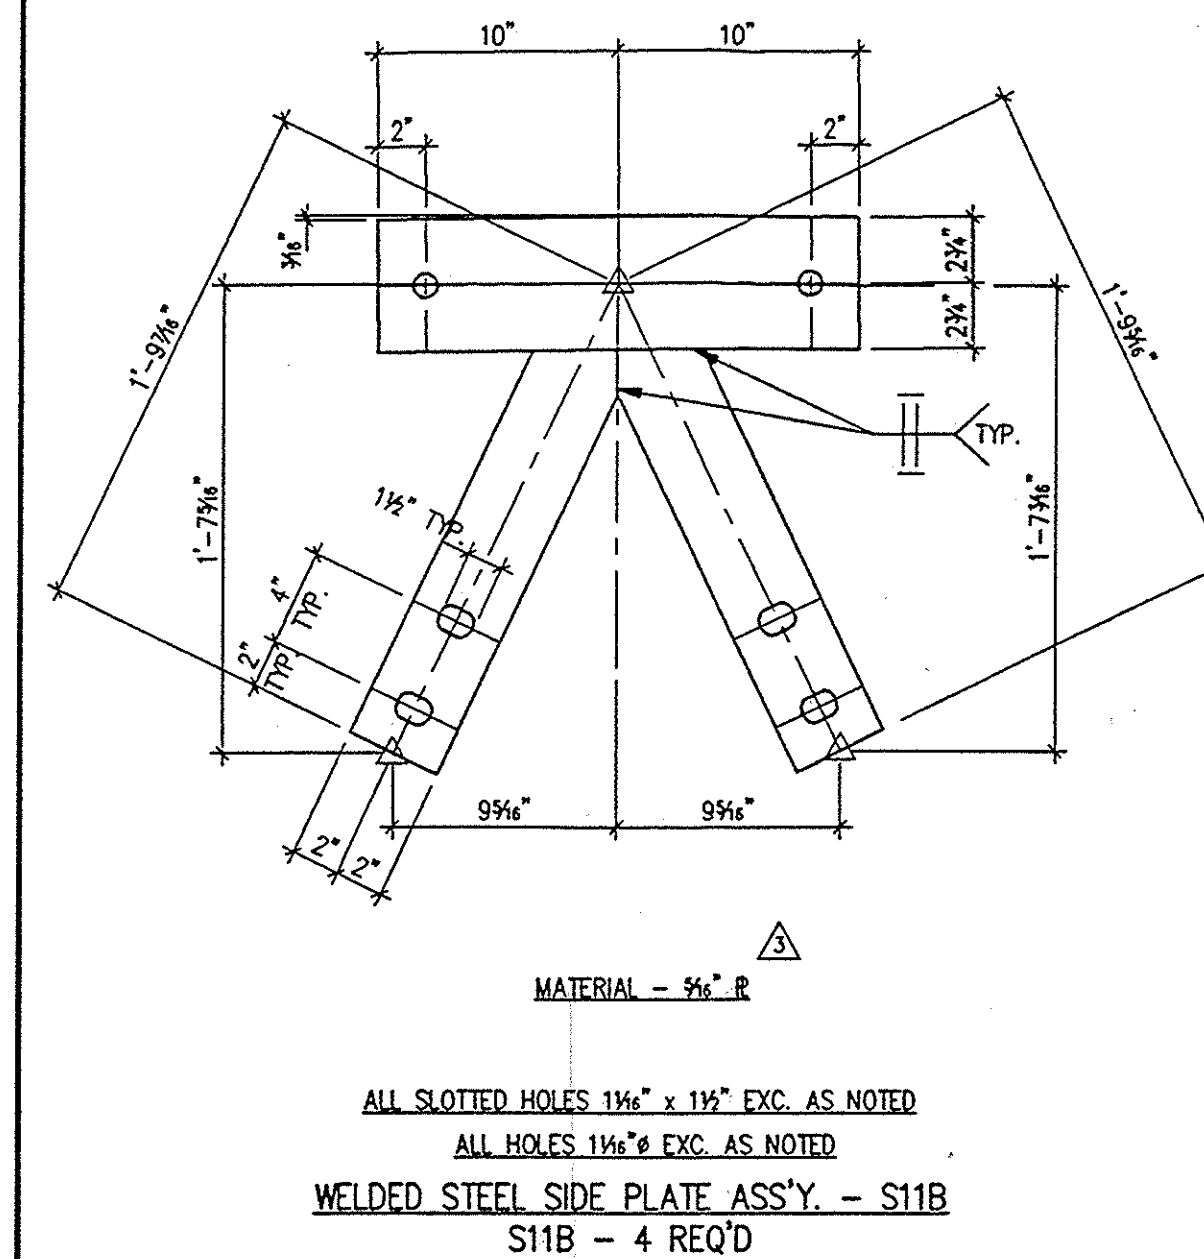
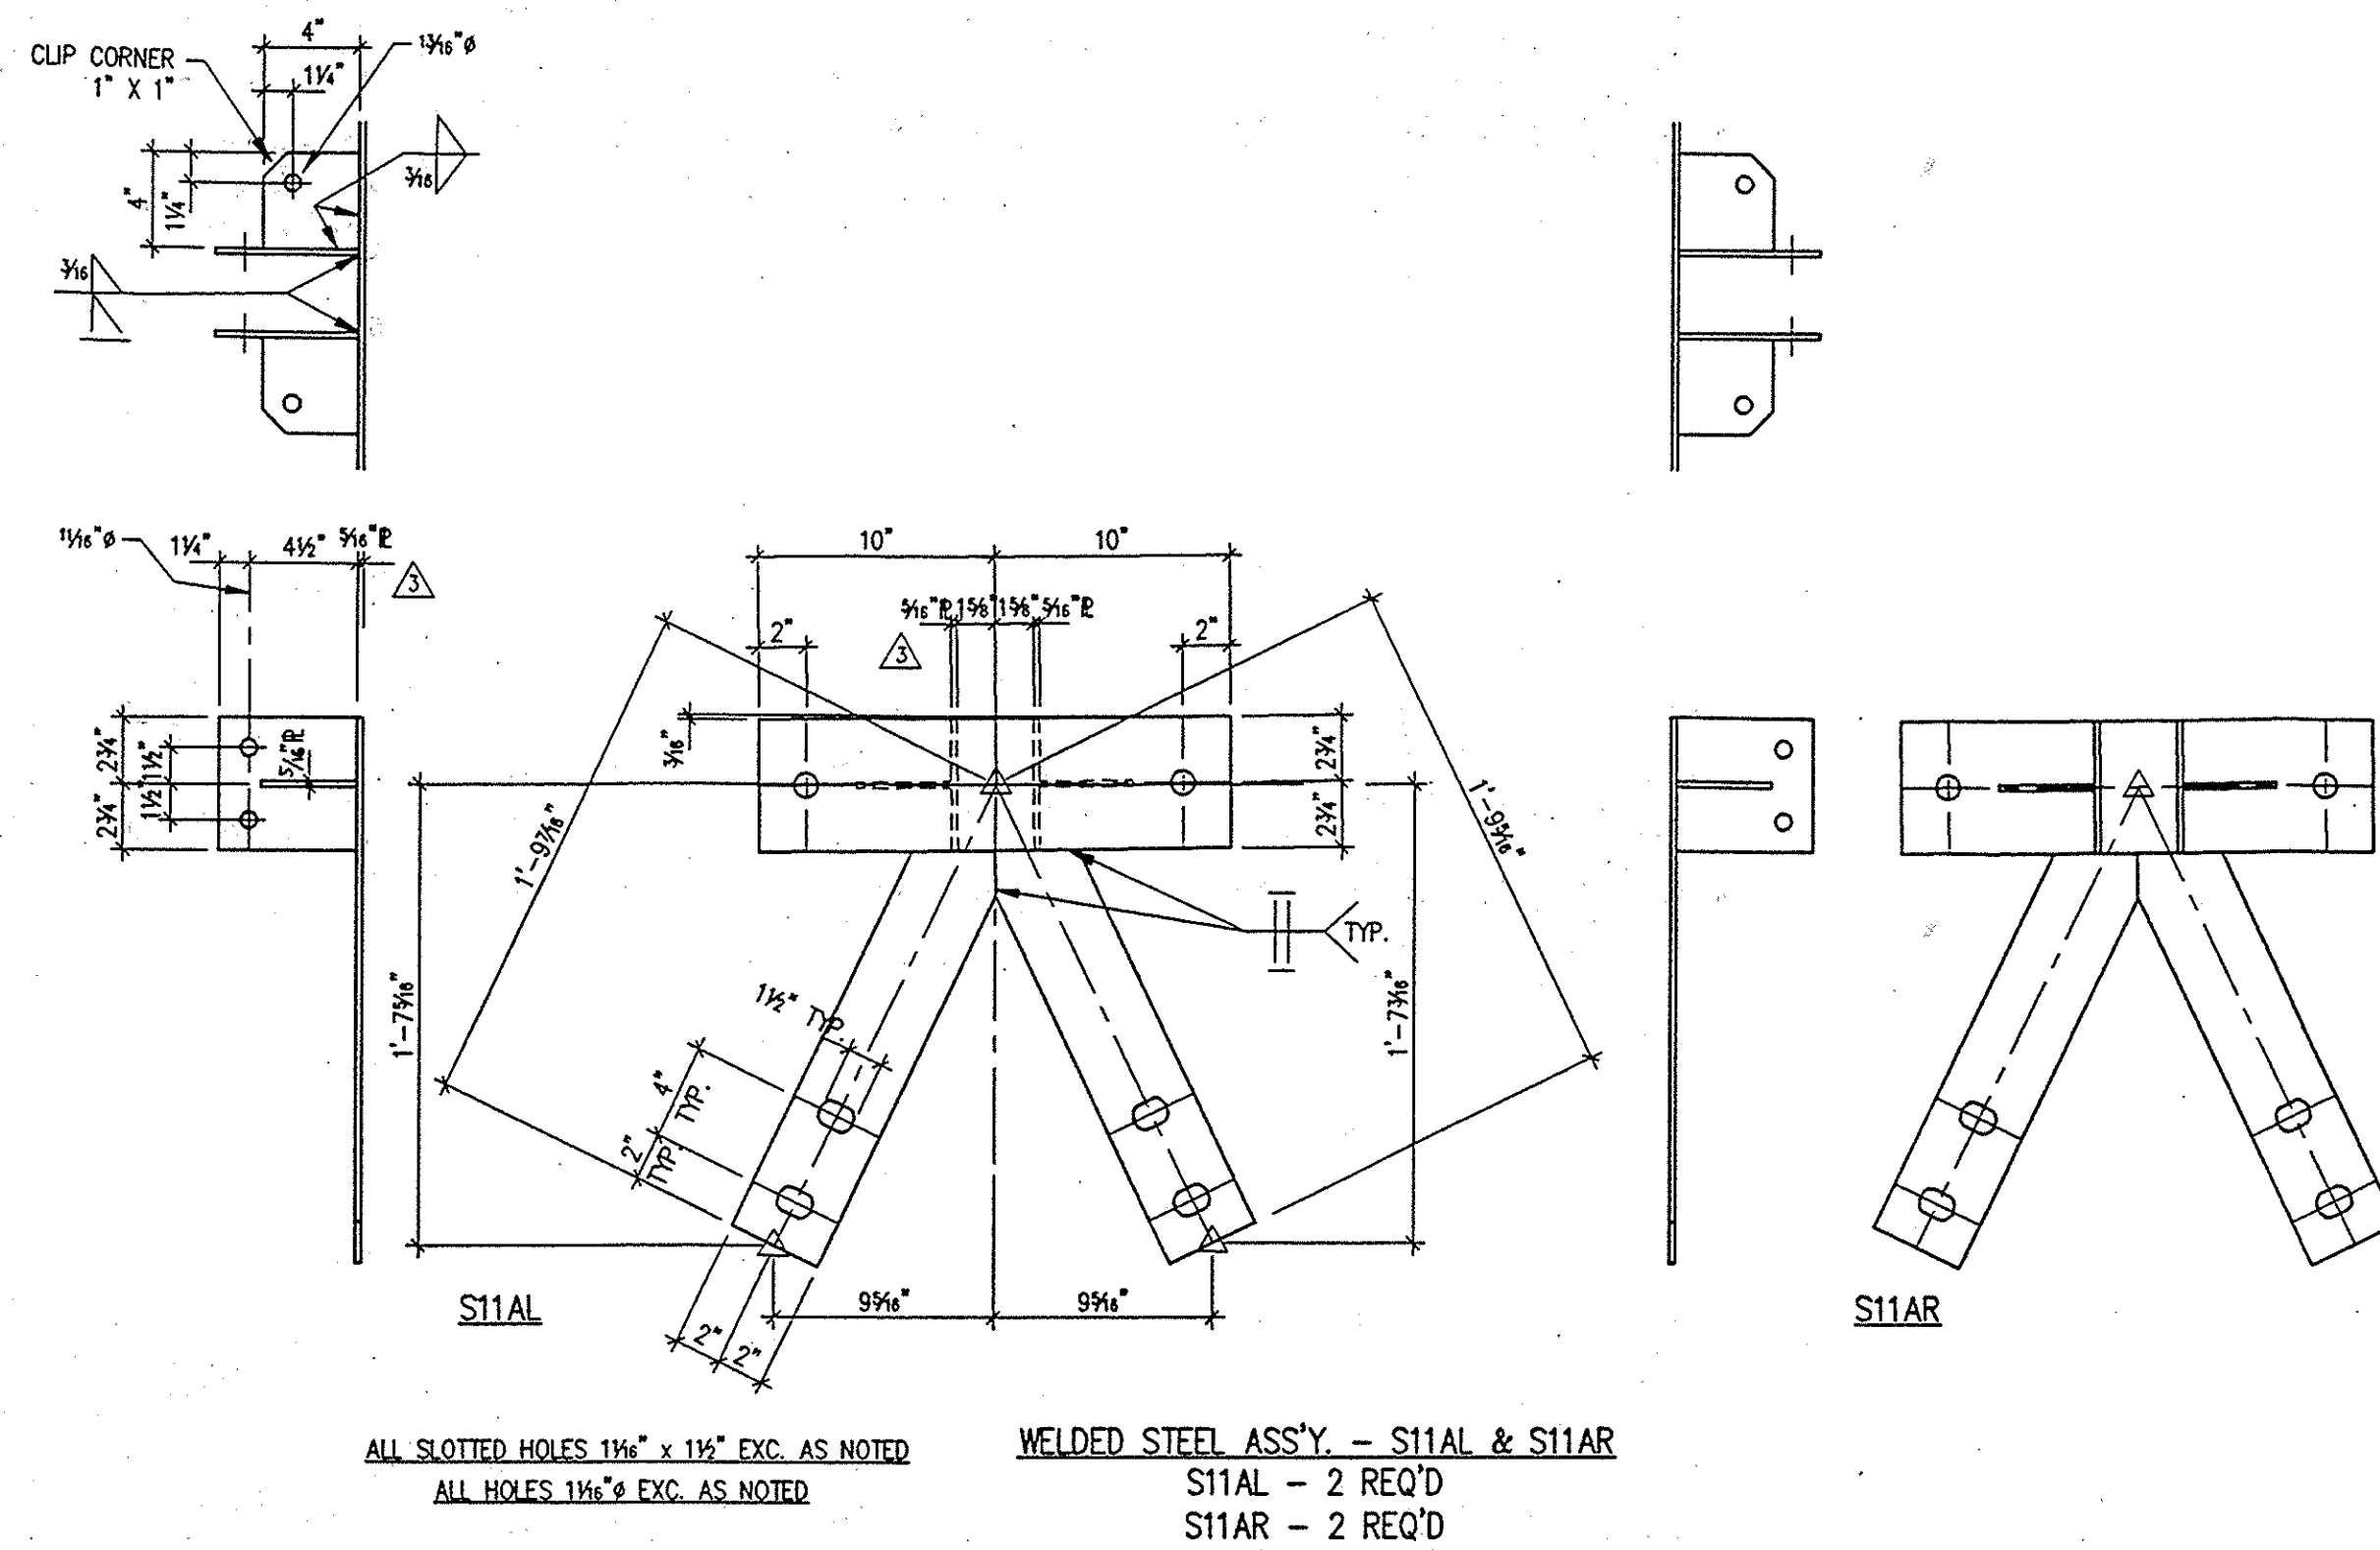


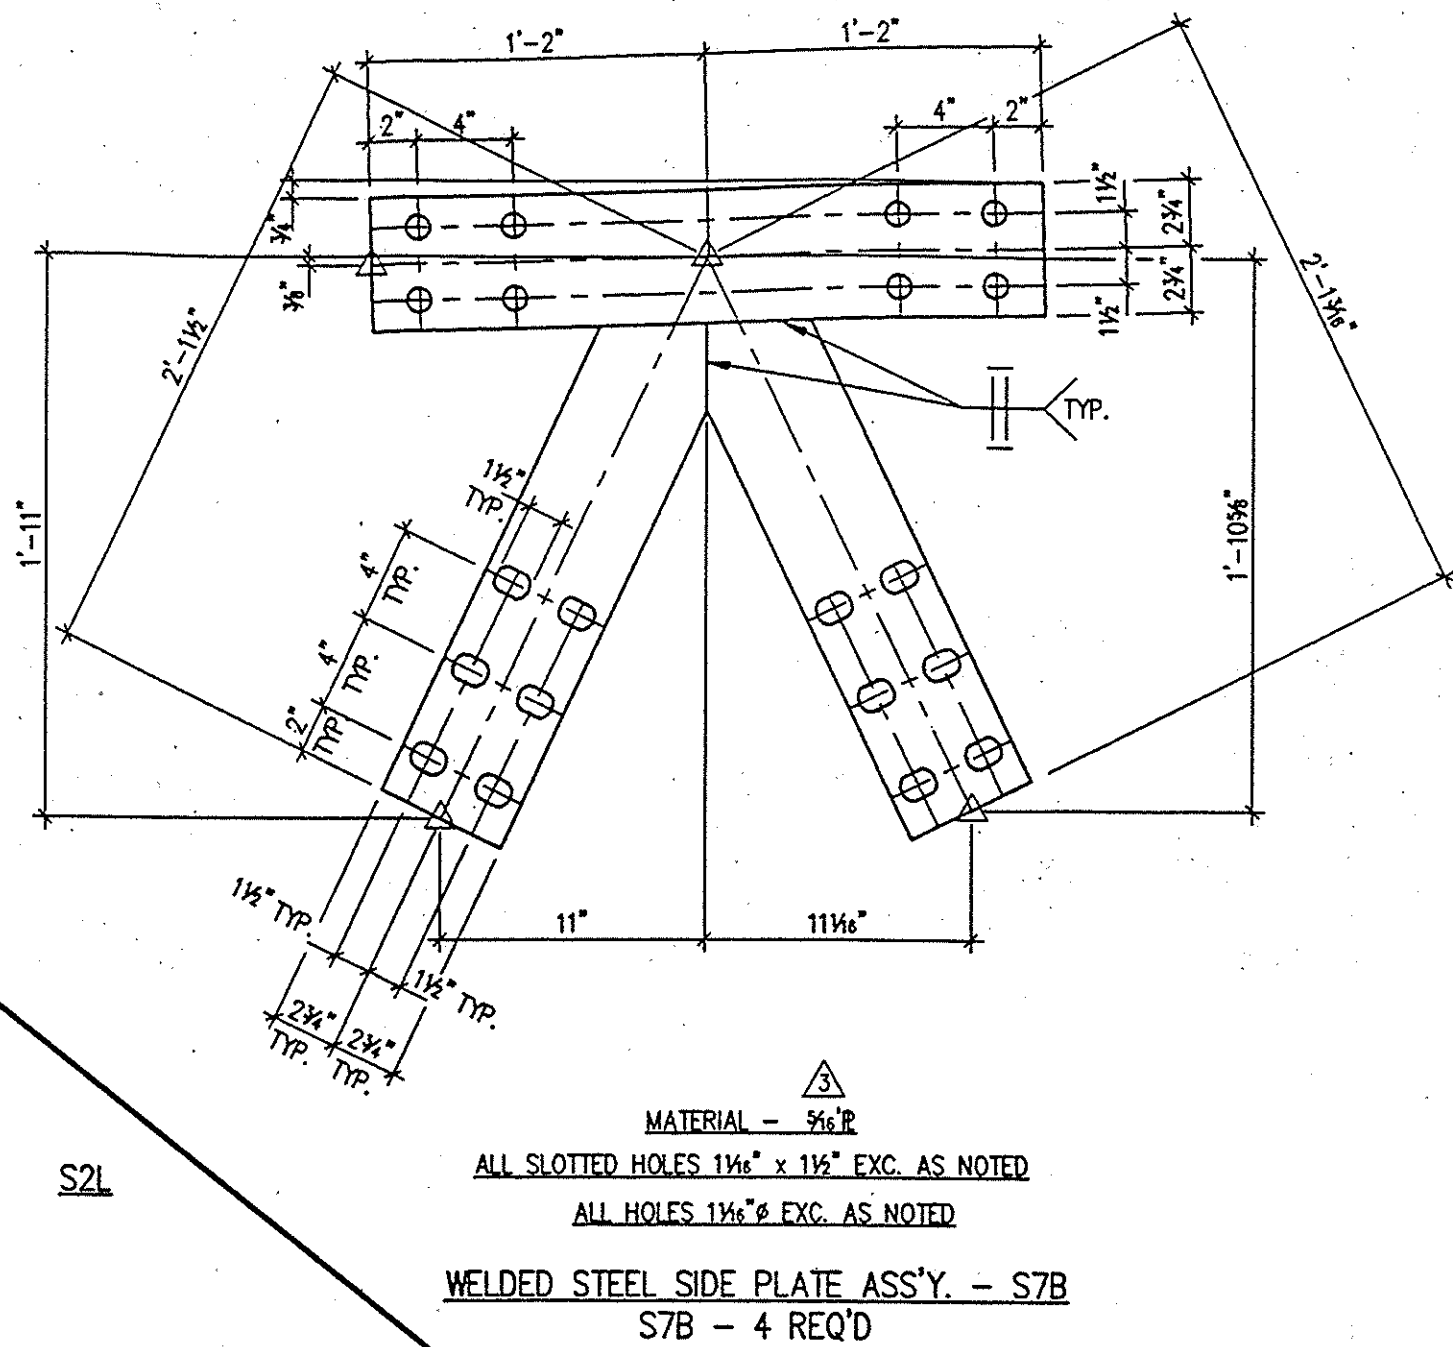

|     |          |                    |  |    |
|-----|----------|--------------------|--|----|
|     |          |                    |  |    |
|     |          |                    |  |    |
| A   | 5-3-96   | PER APPROVAL       |  | BD |
| A   | 2-14-96  | PER APPROVAL       |  | BD |
| A   | 11-29-95 | PER IN-HOUSE CHECK |  | BD |
| NO. | DATE     | REVISIONS          |  | BY |

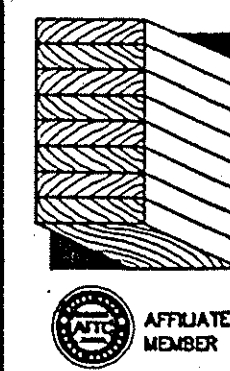

**WESTERN WOOD  
STRUCTURES, INC.**  
P.O. BOX 130 TUALATIN, OREGON 97062  
503/692-6900 FAX 503/692-6434  
FROM: AZ CA ID MT  
NV UT WA WY 800/547-5411

PROJECT: TALBERT CHANNEL BRIDGE  
LOCATION: SANTA ANA, CALIFORNIA

ARCHITECT: \_\_\_\_\_  
ENGINEER: \_\_\_\_\_  
CONTRACTOR: ADVANCO CONTRACTORS

DRAWN BY: BD DATE 11-20-95  
CHECKED BY: KPH DATE 11-29-95

DATE PRINTED: \_\_\_\_\_

JOB NO. 954056  
PLOT DATE 5-6-96  
SHEET 4 of 8