
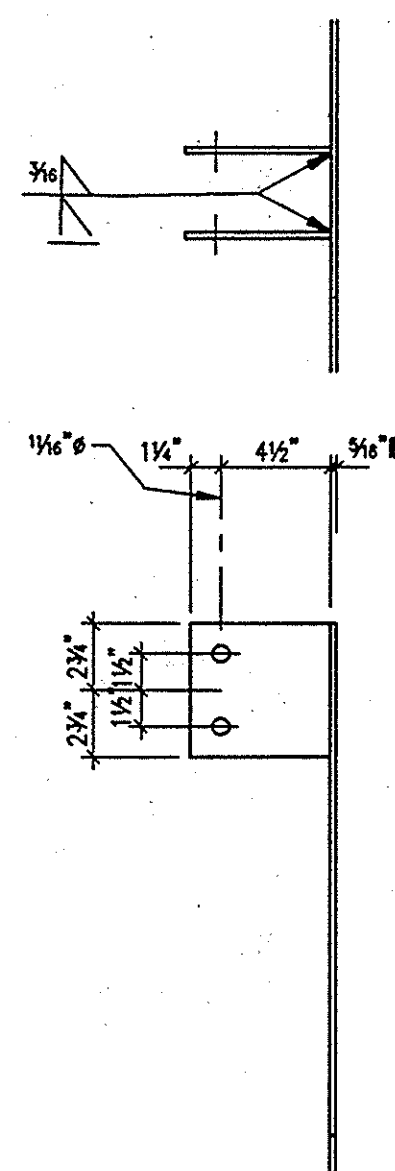
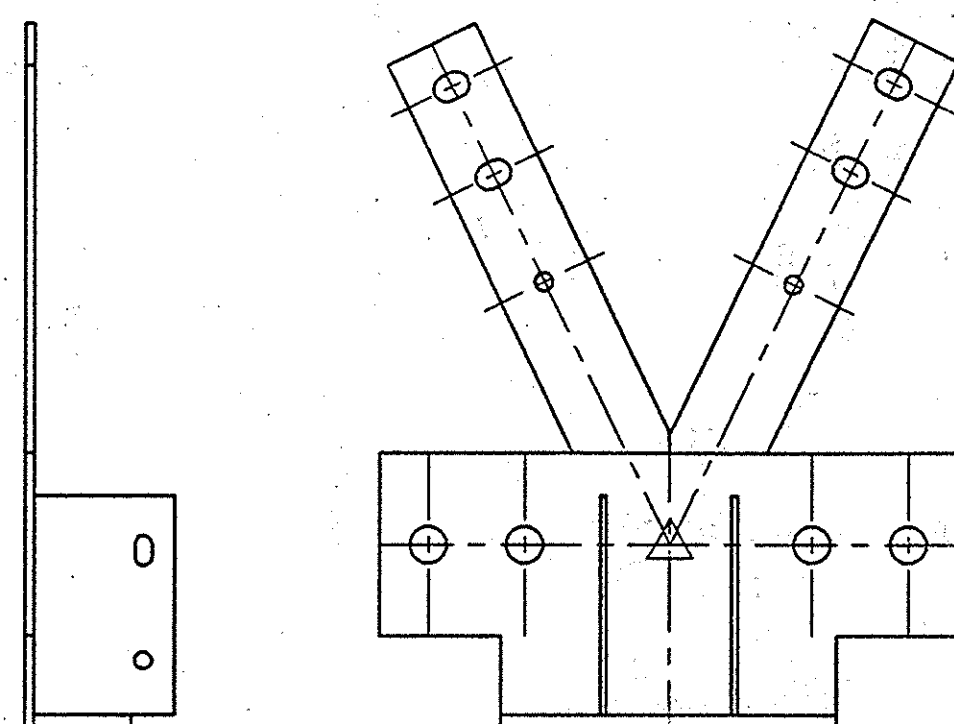
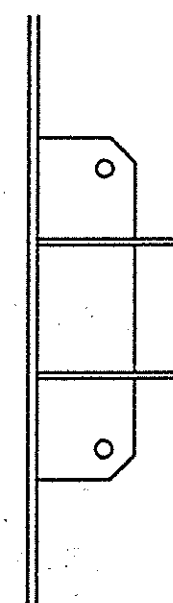


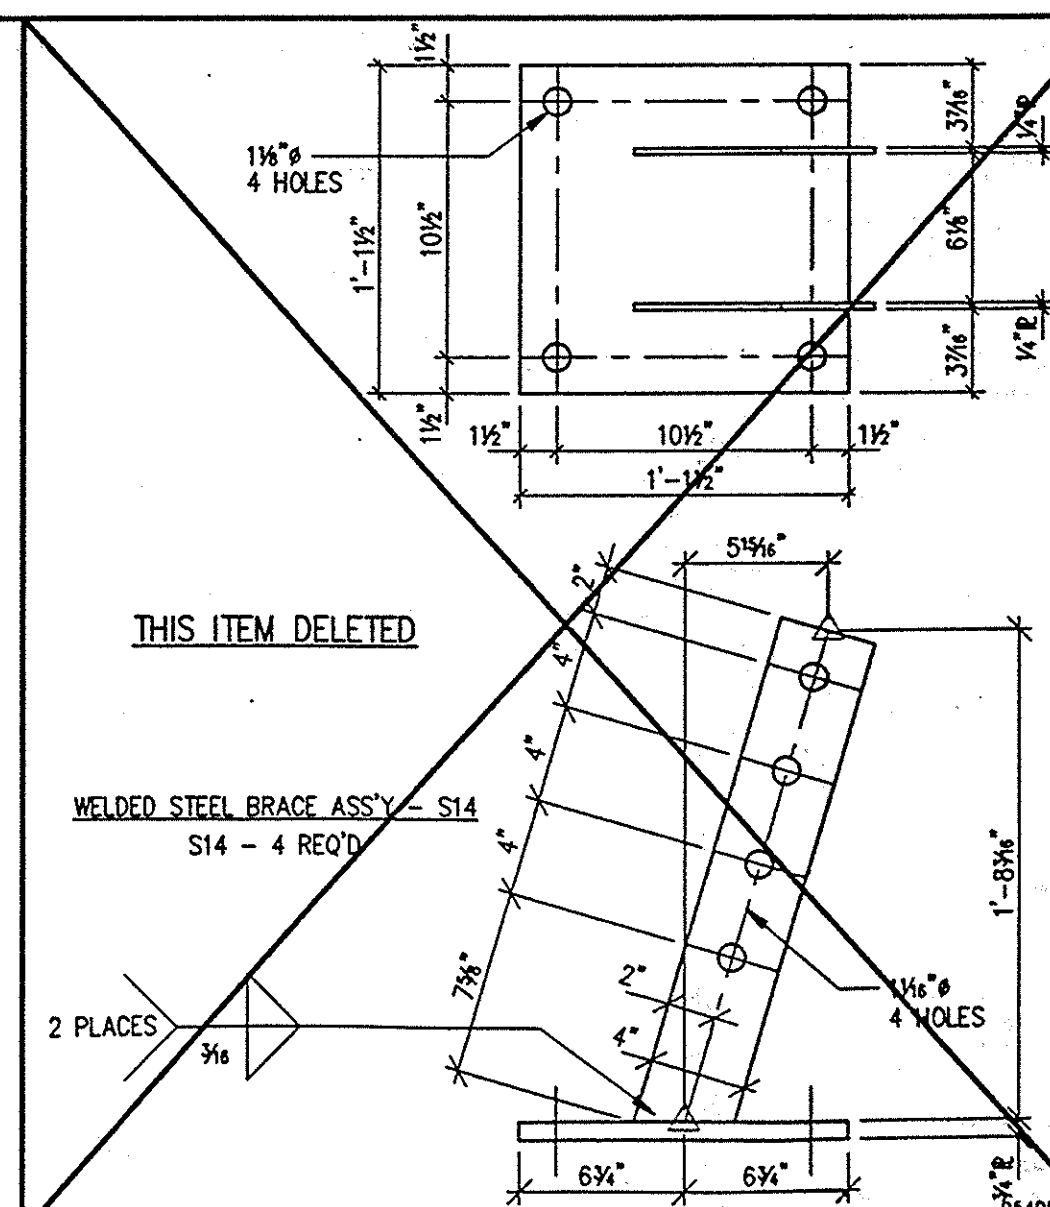

AS NOTED

[illegible]

THIS ITEM DELETED

~~WELDED STEEL BRACE ASS'Y - S14~~
~~S14 - 4 REQ'D~~

2 PLACES



AFTC
AFFILIATE
MEMBER

PROJECT: TALBERT CHANNEL BRIDGE					
LOCATION: SANTA ANA, CALIFORNIA					
ARCHITECT: _____					
ENGINEER: _____					
CONTRACTOR: ADVANCO CONTRACTORS					
DRAWN BY: BD DATE 11-20-95					
JOB NO. 954056					
CHECKED BY: KPH DATE 11-28-95					
DATE PRINTED:	<table border="1"> <tr> <td>PLOT DATE</td> <td>SHT.</td> </tr> <tr> <td>5-6-96</td> <td>8 OF</td> </tr> </table>	PLOT DATE	SHT.	5-6-96	8 OF
PLOT DATE	SHT.				
5-6-96	8 OF				