

ORANGE COUNTY
PUBLIC FACILITIES & RESOURCES DEPARTMENT
SANTA ANA, CALIFORNIA
JOHN W. SIBLEY, DIRECTOR
PLANS FOR CONSTRUCTION OF
BICYCLE/MAINTENANCE VEHICLE
BRIDGE OVER GREENVILLE-BANNING CHANNEL (D03)

AT WESTERLY END OF GISLER AVENUE

FUNDED BY: CITY OF COSTA MESA
COUNTY OF ORANGE

CITY OF COSTA MESA

APPROVED FOR WORK WITHIN CITY
LIMITS :


ERNEST MUNGAI
ASSISTANT CITY ENGINEER

OWNERSHIP & MAINTENANCE

PER COOPERATIVE AGREEMENT D96-015, THE CITY
OF COSTA MESA & THE COUNTY OF ORANGE HAVE
AGREED :

THE CITY OF COSTA MESA WILL BE RESPONSIBLE FOR OWNERSHIP AND MAINTENANCE FOR THOSE PORTIONS OF THE BRIDGE APPROACH RAMP AND BIKE TRAIL WITHIN GISLER AVENUE ROAD RIGHT OF WAY.

THE COUNTY WILL BE RESPONSIBLE FOR OWNERSHIP AND MAINTENANCE FOR THE BRIDGE AND RAMPS WITHIN OCFCO RIGHT OF WAY .

BASIS OF BEARINGS:

THE BASIS OF BEARING SHOWN
HEREON IS BASED ON THE
GRID BEARING BETWEEN O.C.S.
HORIZONTAL CONTROL STA-
TIONS GPS 6122 AND GPS 6121,
BEING $N88^{\circ}53'01''W$.

BENCH MARK:

O.C.S., BM. # CM-34-81
ELEV. 34.008



O.C.S., BM. # IL-98-91
ELEV. 31.581

NGVD 1929 (1976 O.C.S.
ADJUSTMENT)

[illegible]

W. O. NO. EF03454
DWG. NO.

SHEET 1 OF 7

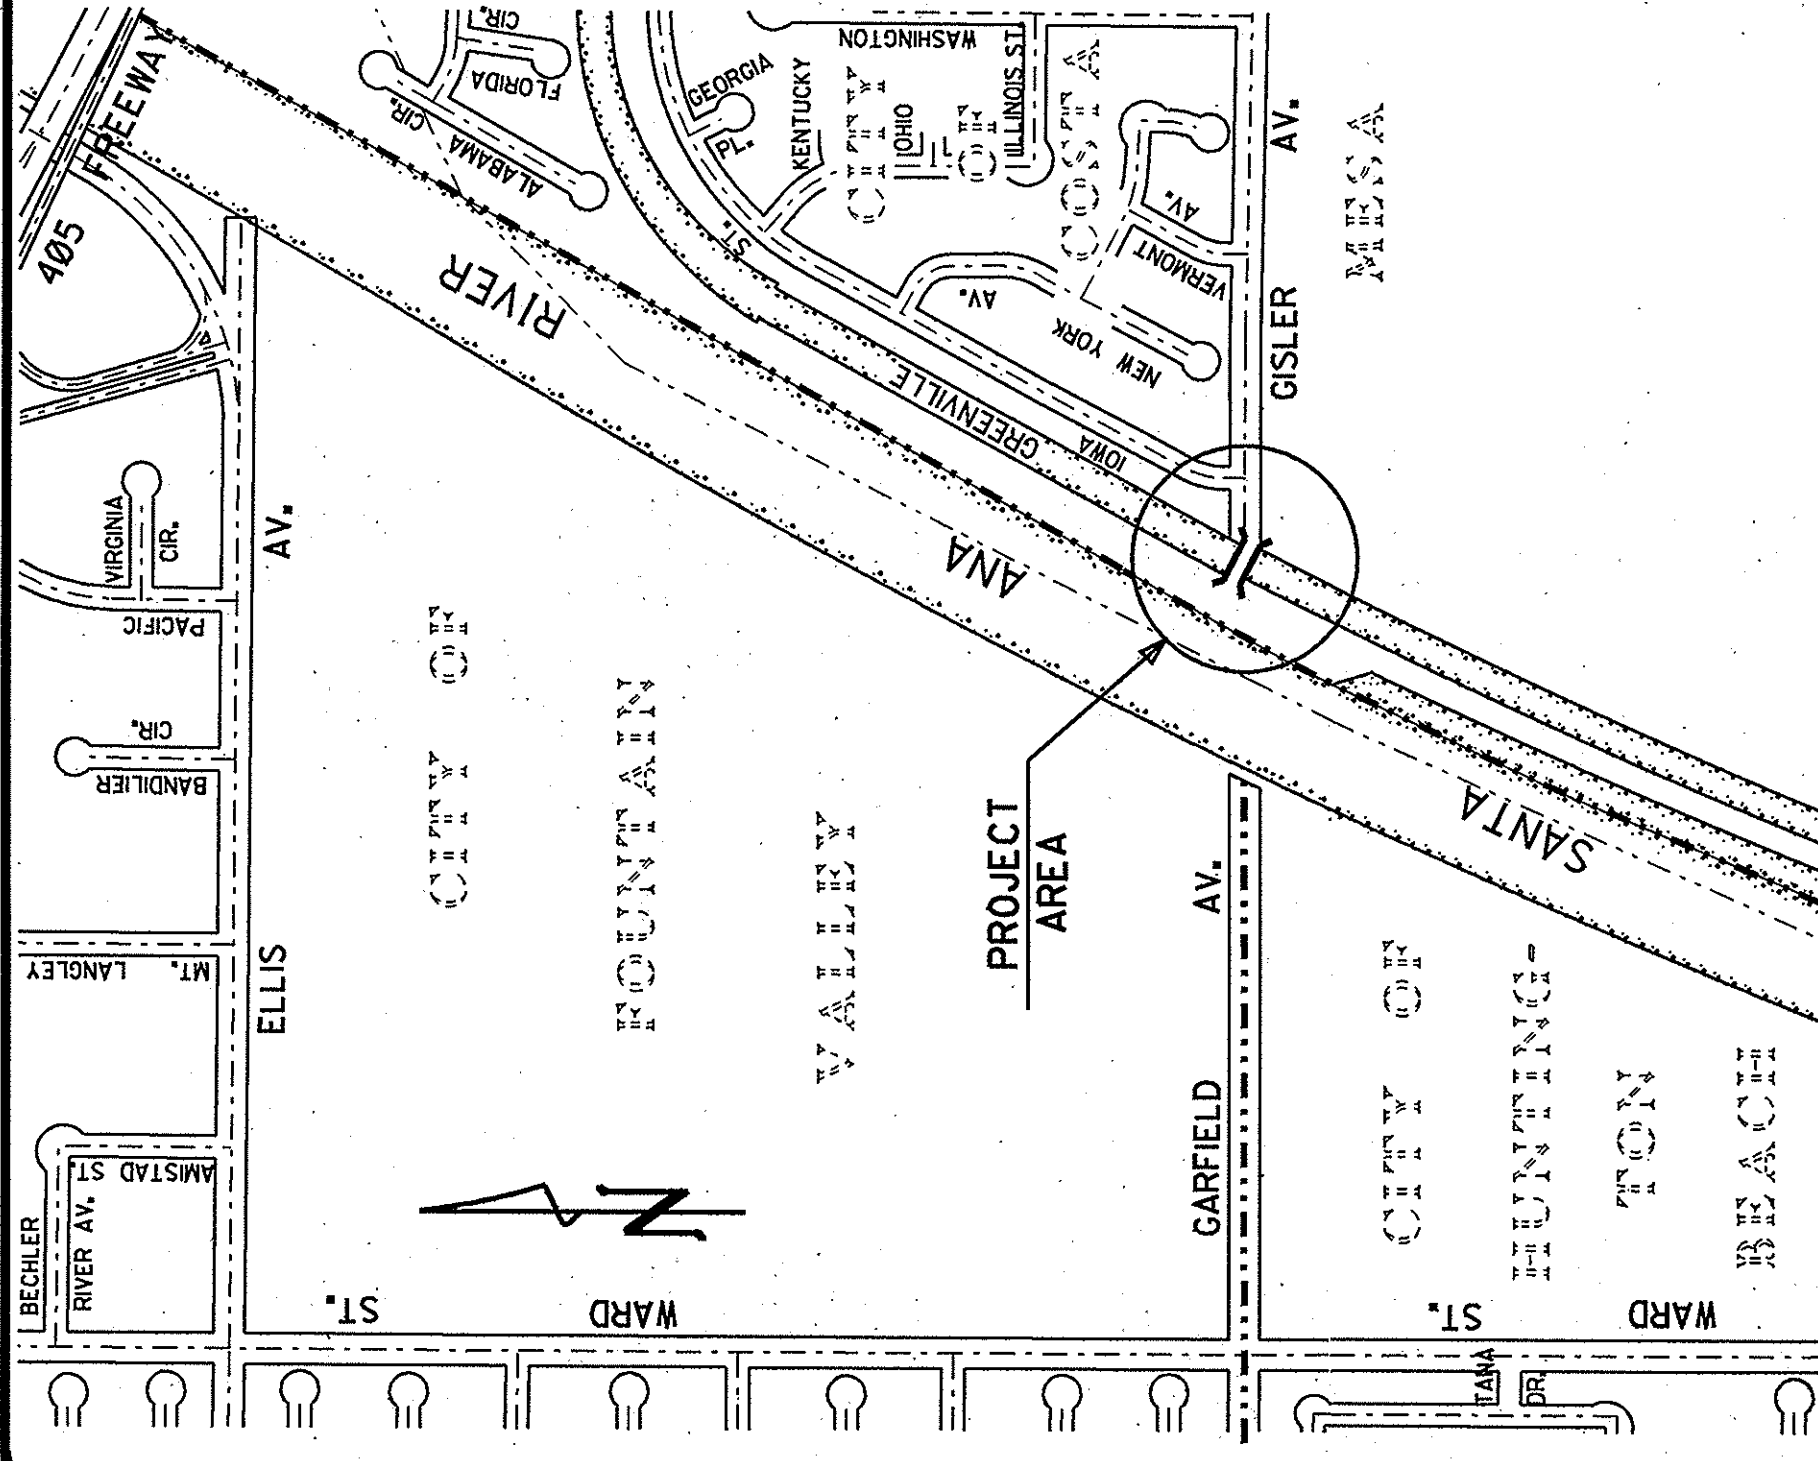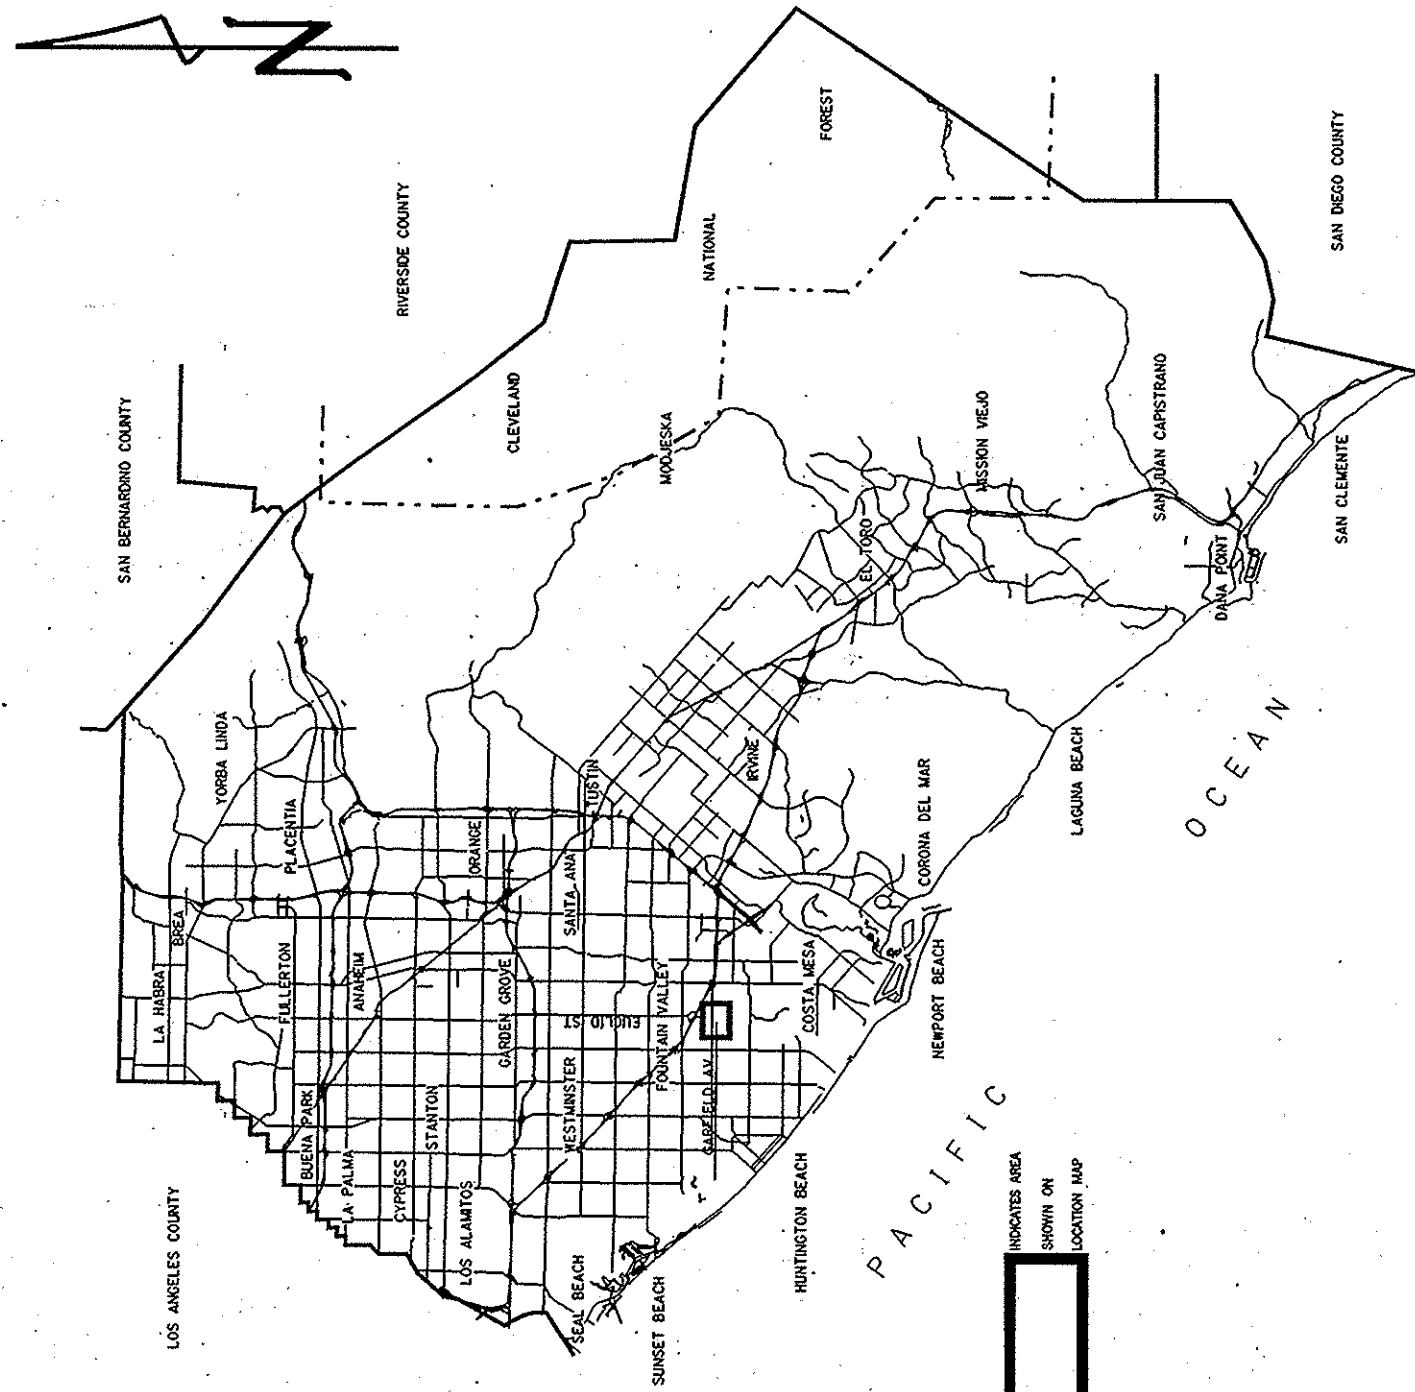

UTILITY	OWNER	PHONE NO.	CONTACT
CONTINENTAL CABLEVISION	COUNTY SANITATION DISTRICTS OF ORANGE COUNTY	(909)270-3300 962-241x5713	GENE WUCHNER SID KIRK
MESA CONSOLIDATED WATER DISTRICT	ORANGE COUNTY WATER DISTRICT	631-1291 378-3211	RAY BARELA STEVE CONKLIN
PACIFIC BELL		666-5704	DALE KOLBE
THE GAS COMPANY		634-3124	ERNIE MELENOREZ
GENERAL TELEPHONE (AKA GTE CALIF., INC.)		375-6721	ROB STEWART
SOUTHERN CALIFORNIA EDISON CO.		895-0363	JIM CHARLESWORTH
NUVIS ENGINEERING		754-731x2229	TOMAS MUNOZ
UNDERGROUND SERVICE ALERT		(800)422-4133	

SHEET	DESCRIPTION
-------	-------------

1	TITLE SHEET
2	BRIDGE GENERAL PLAN
3	ABUTMENT DETAILS
4	APPROACH RAMP DETAILS
5	MISCELLANEOUS DETAILS
6	MISCELLANEOUS DETAILS
7	LOG OF SOIL BORINGS