

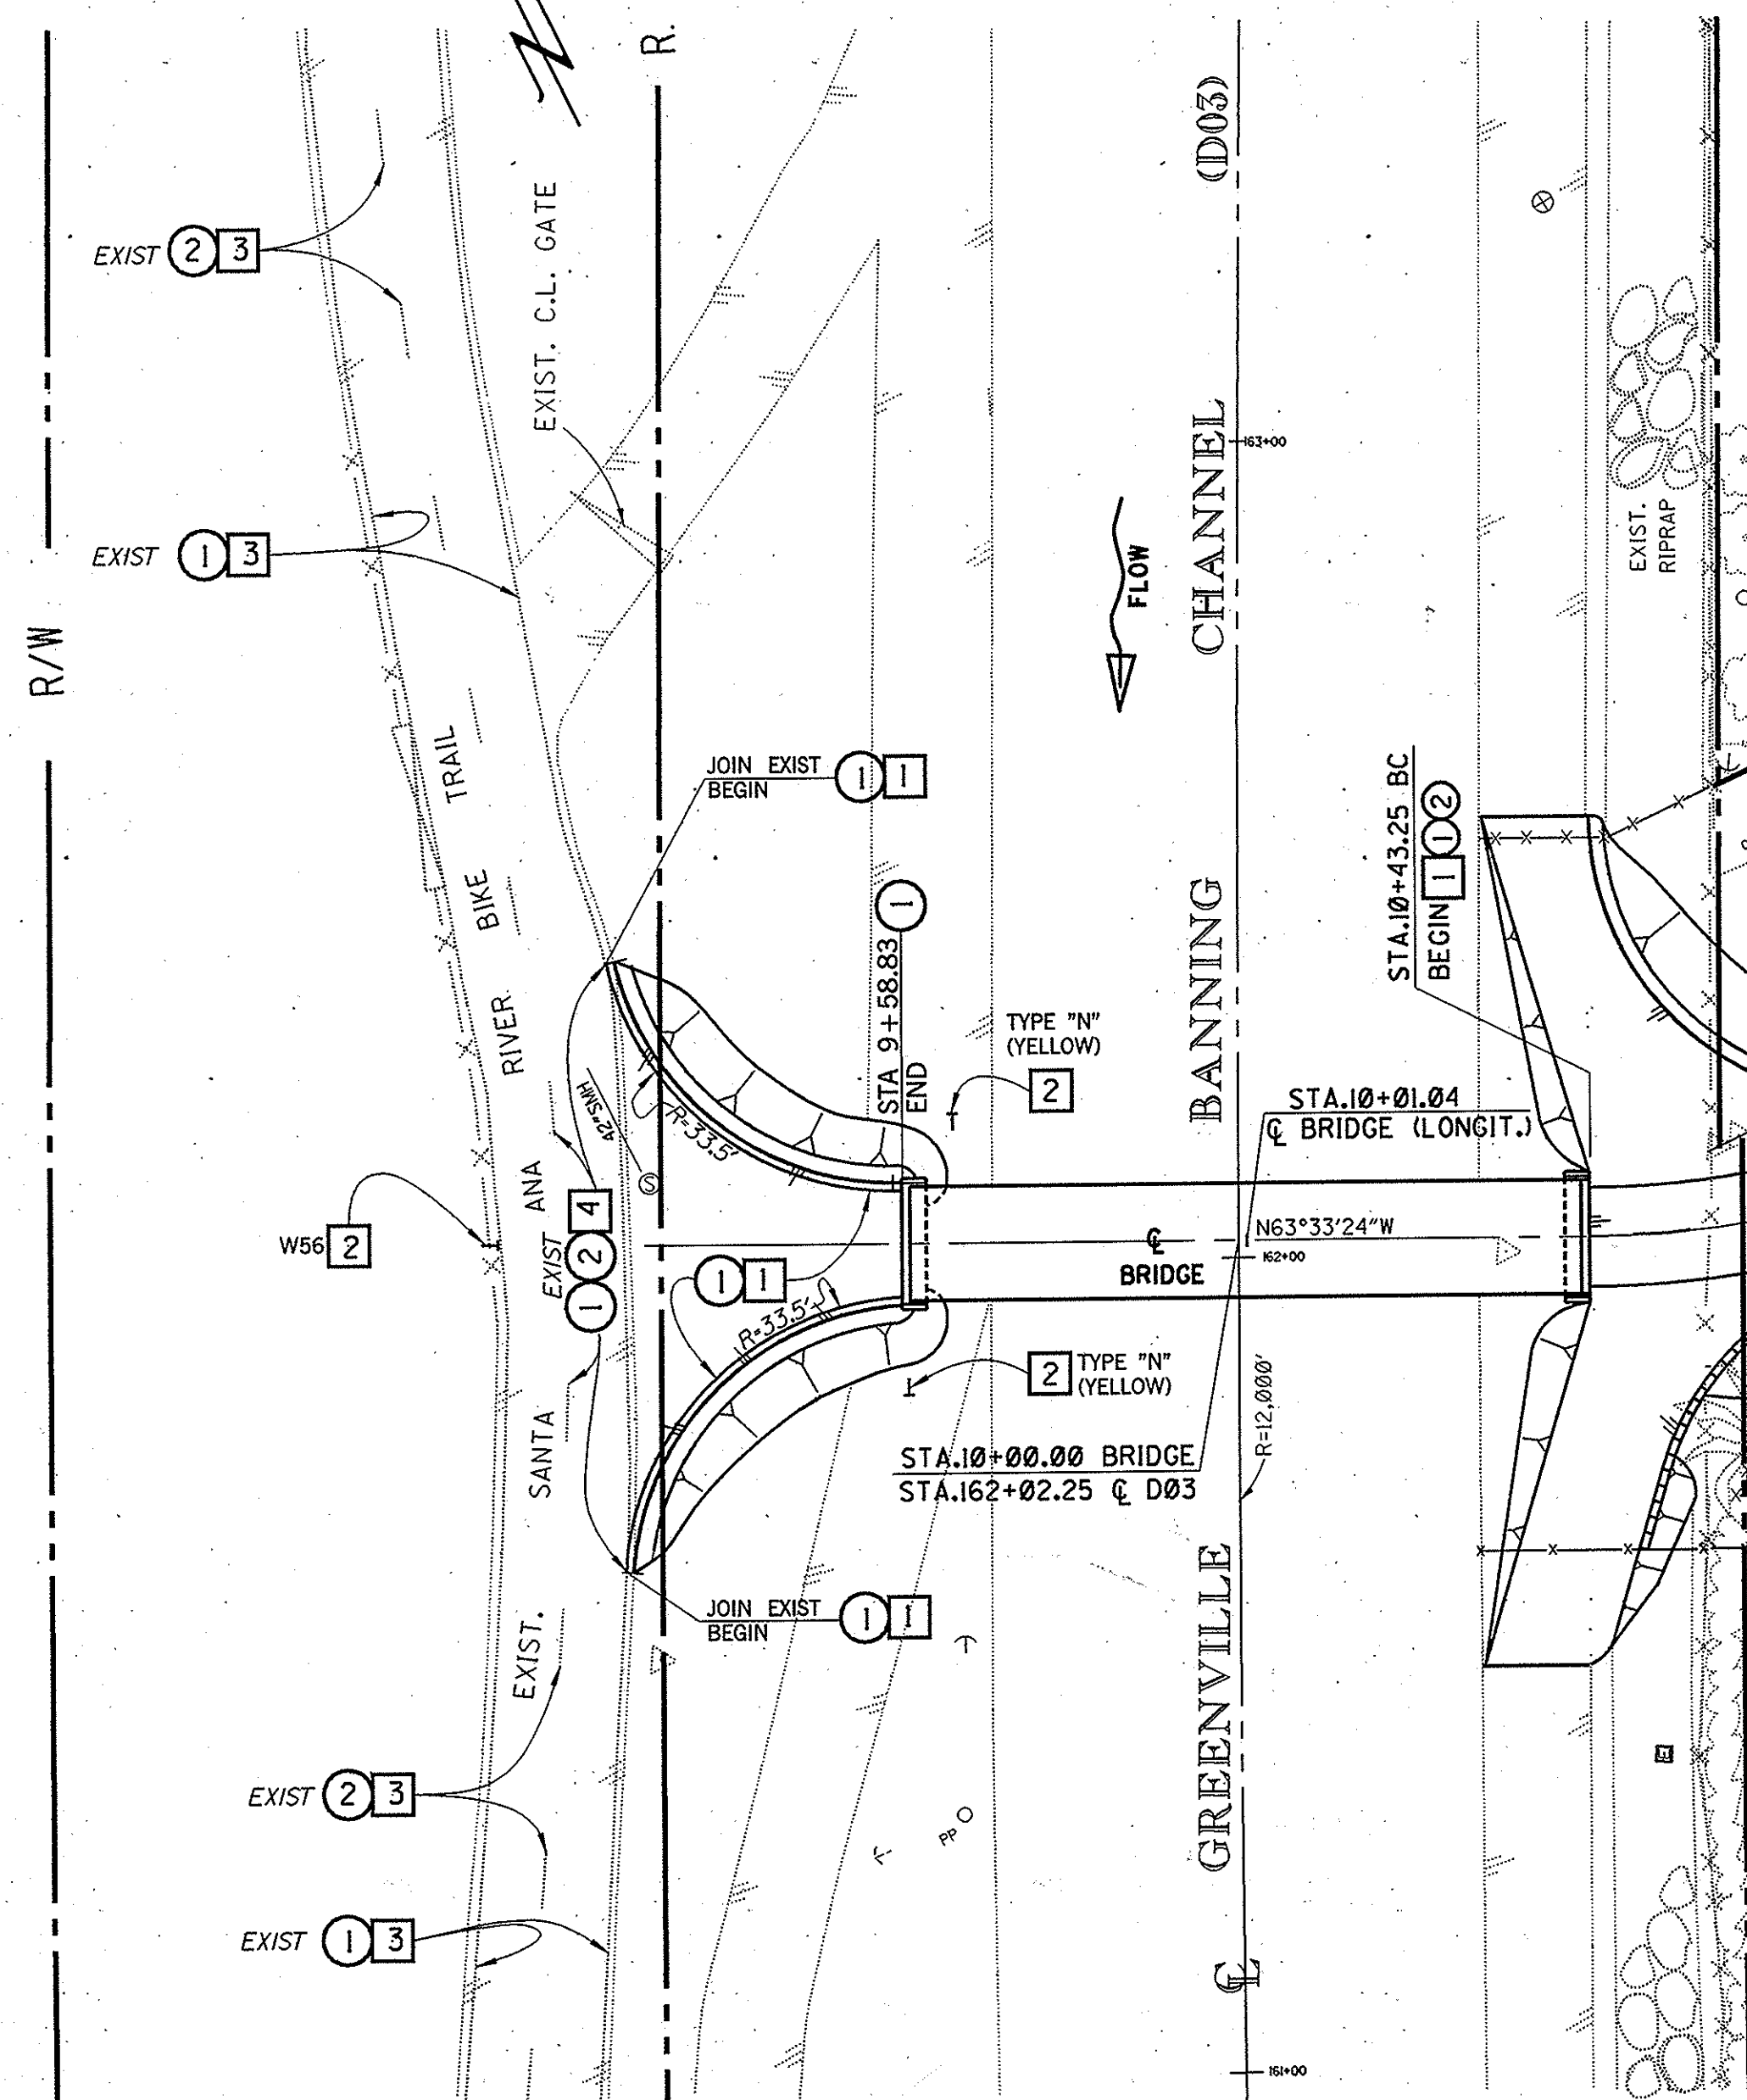
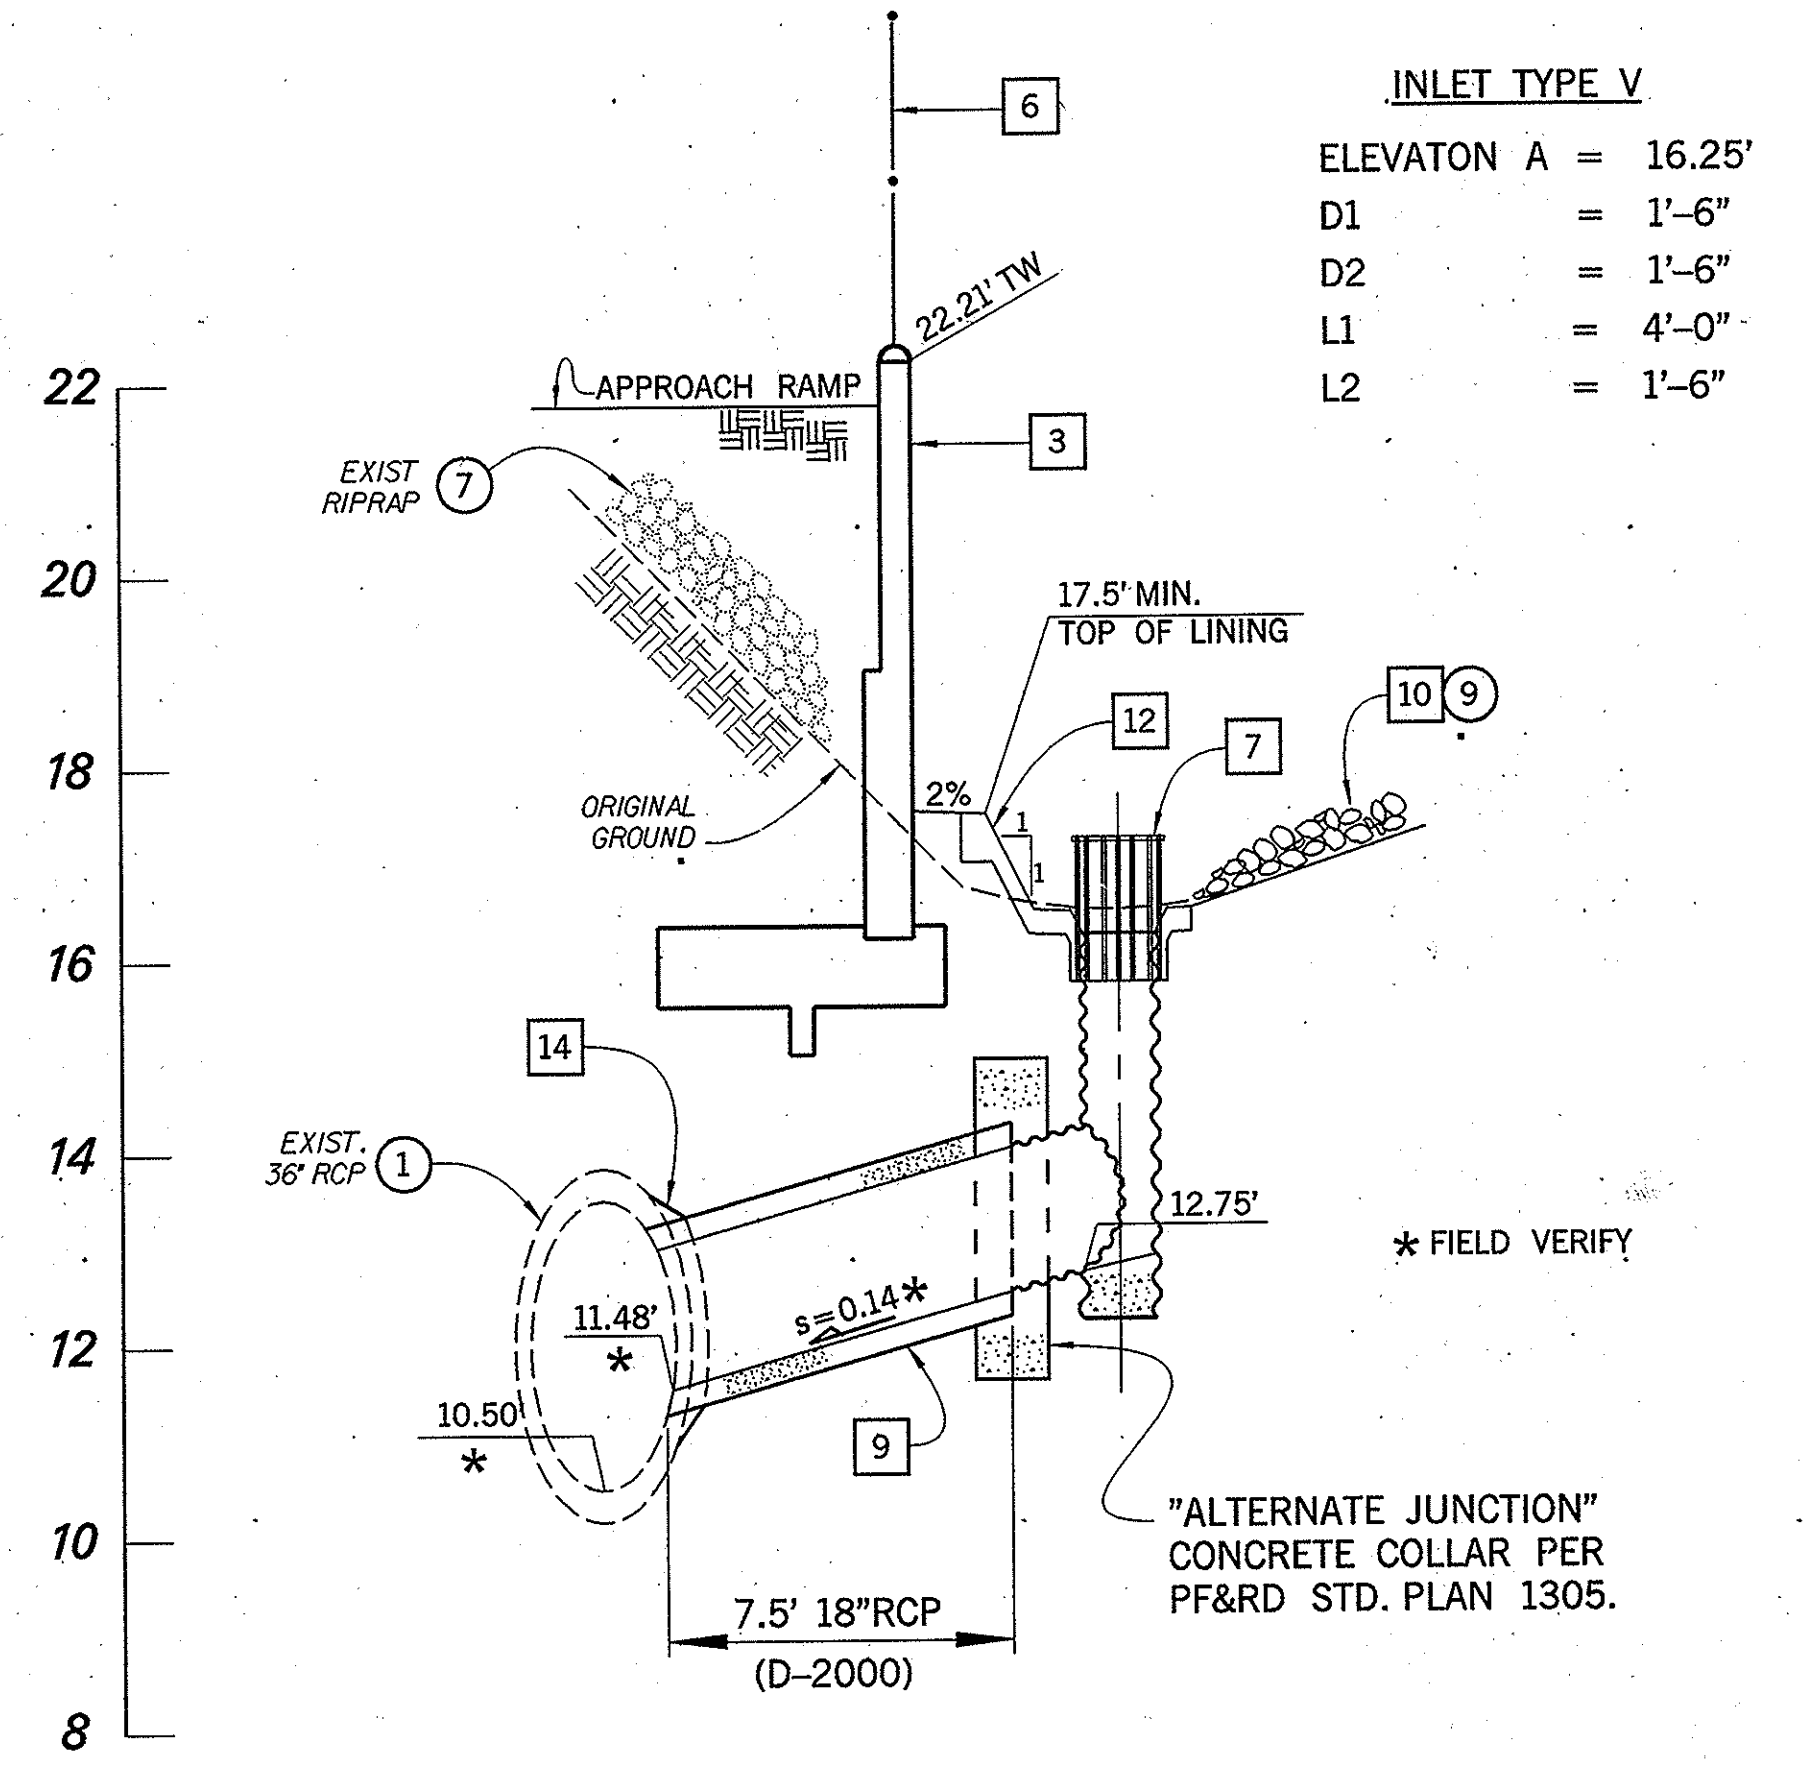
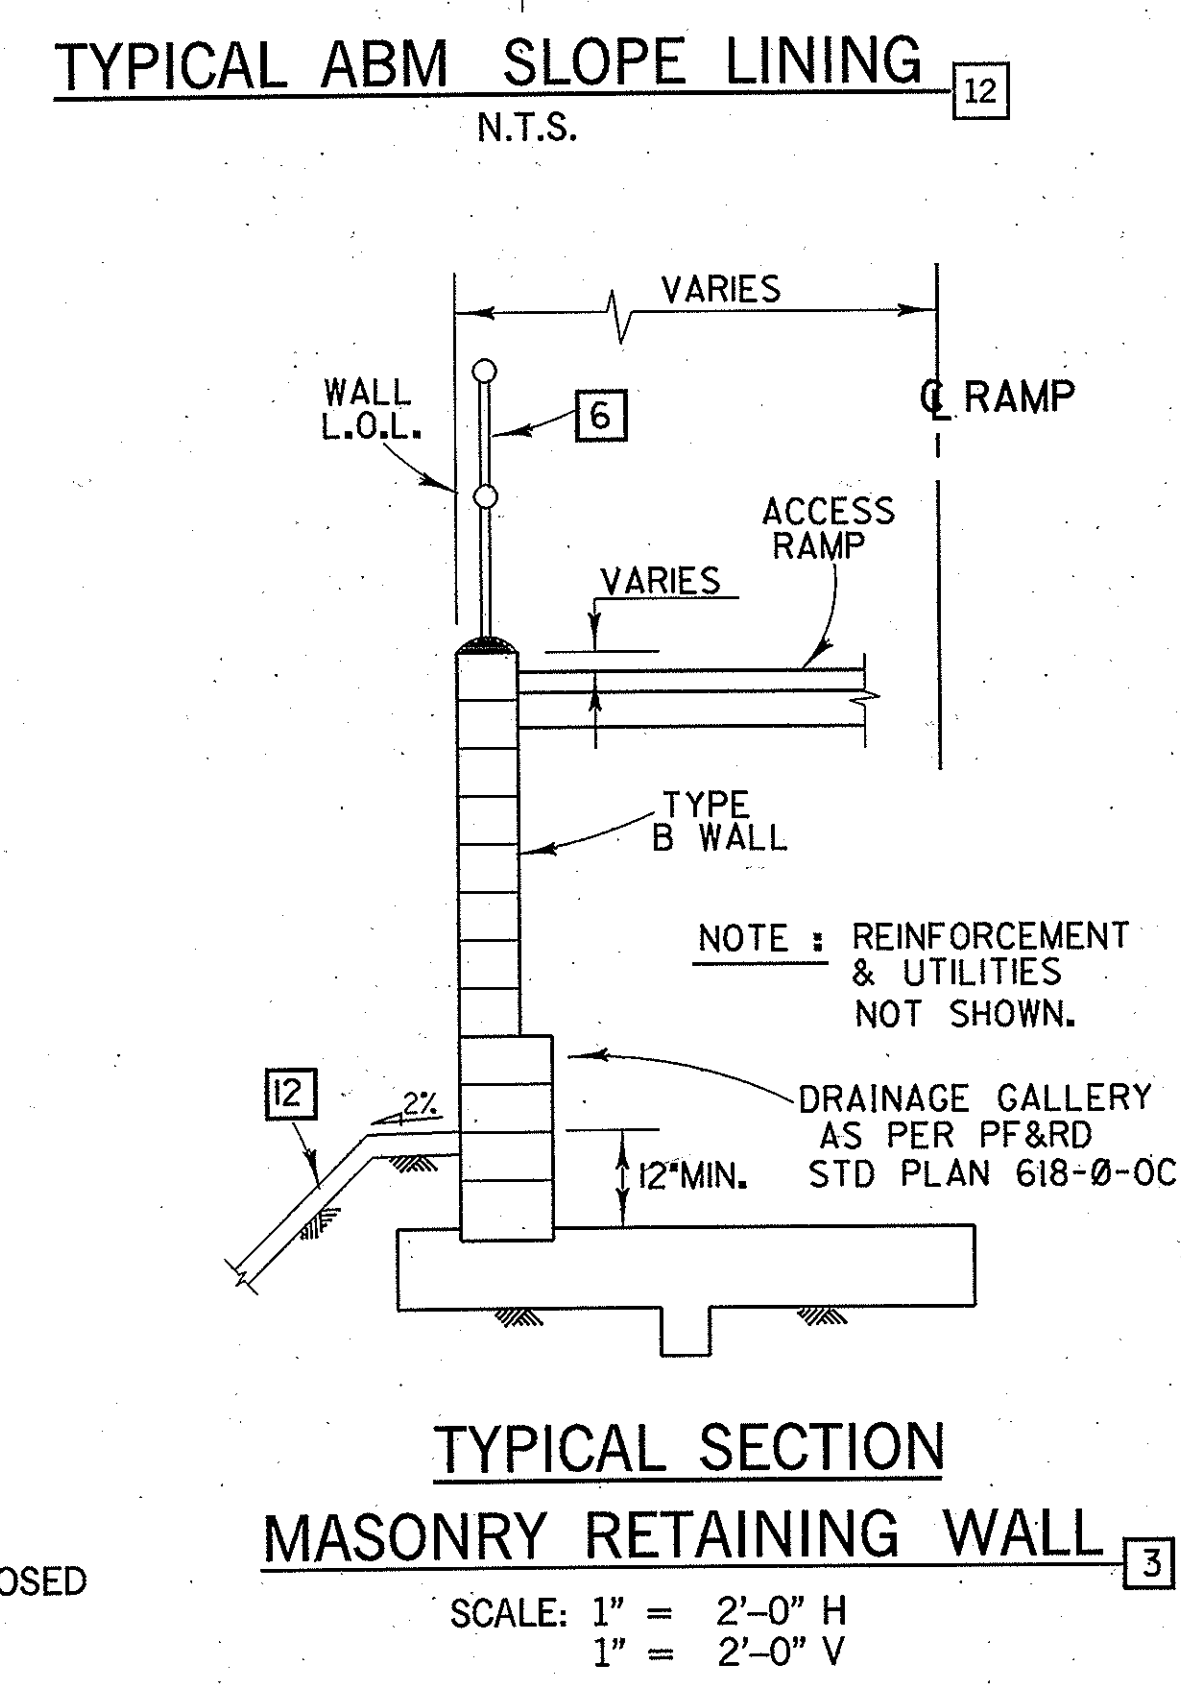


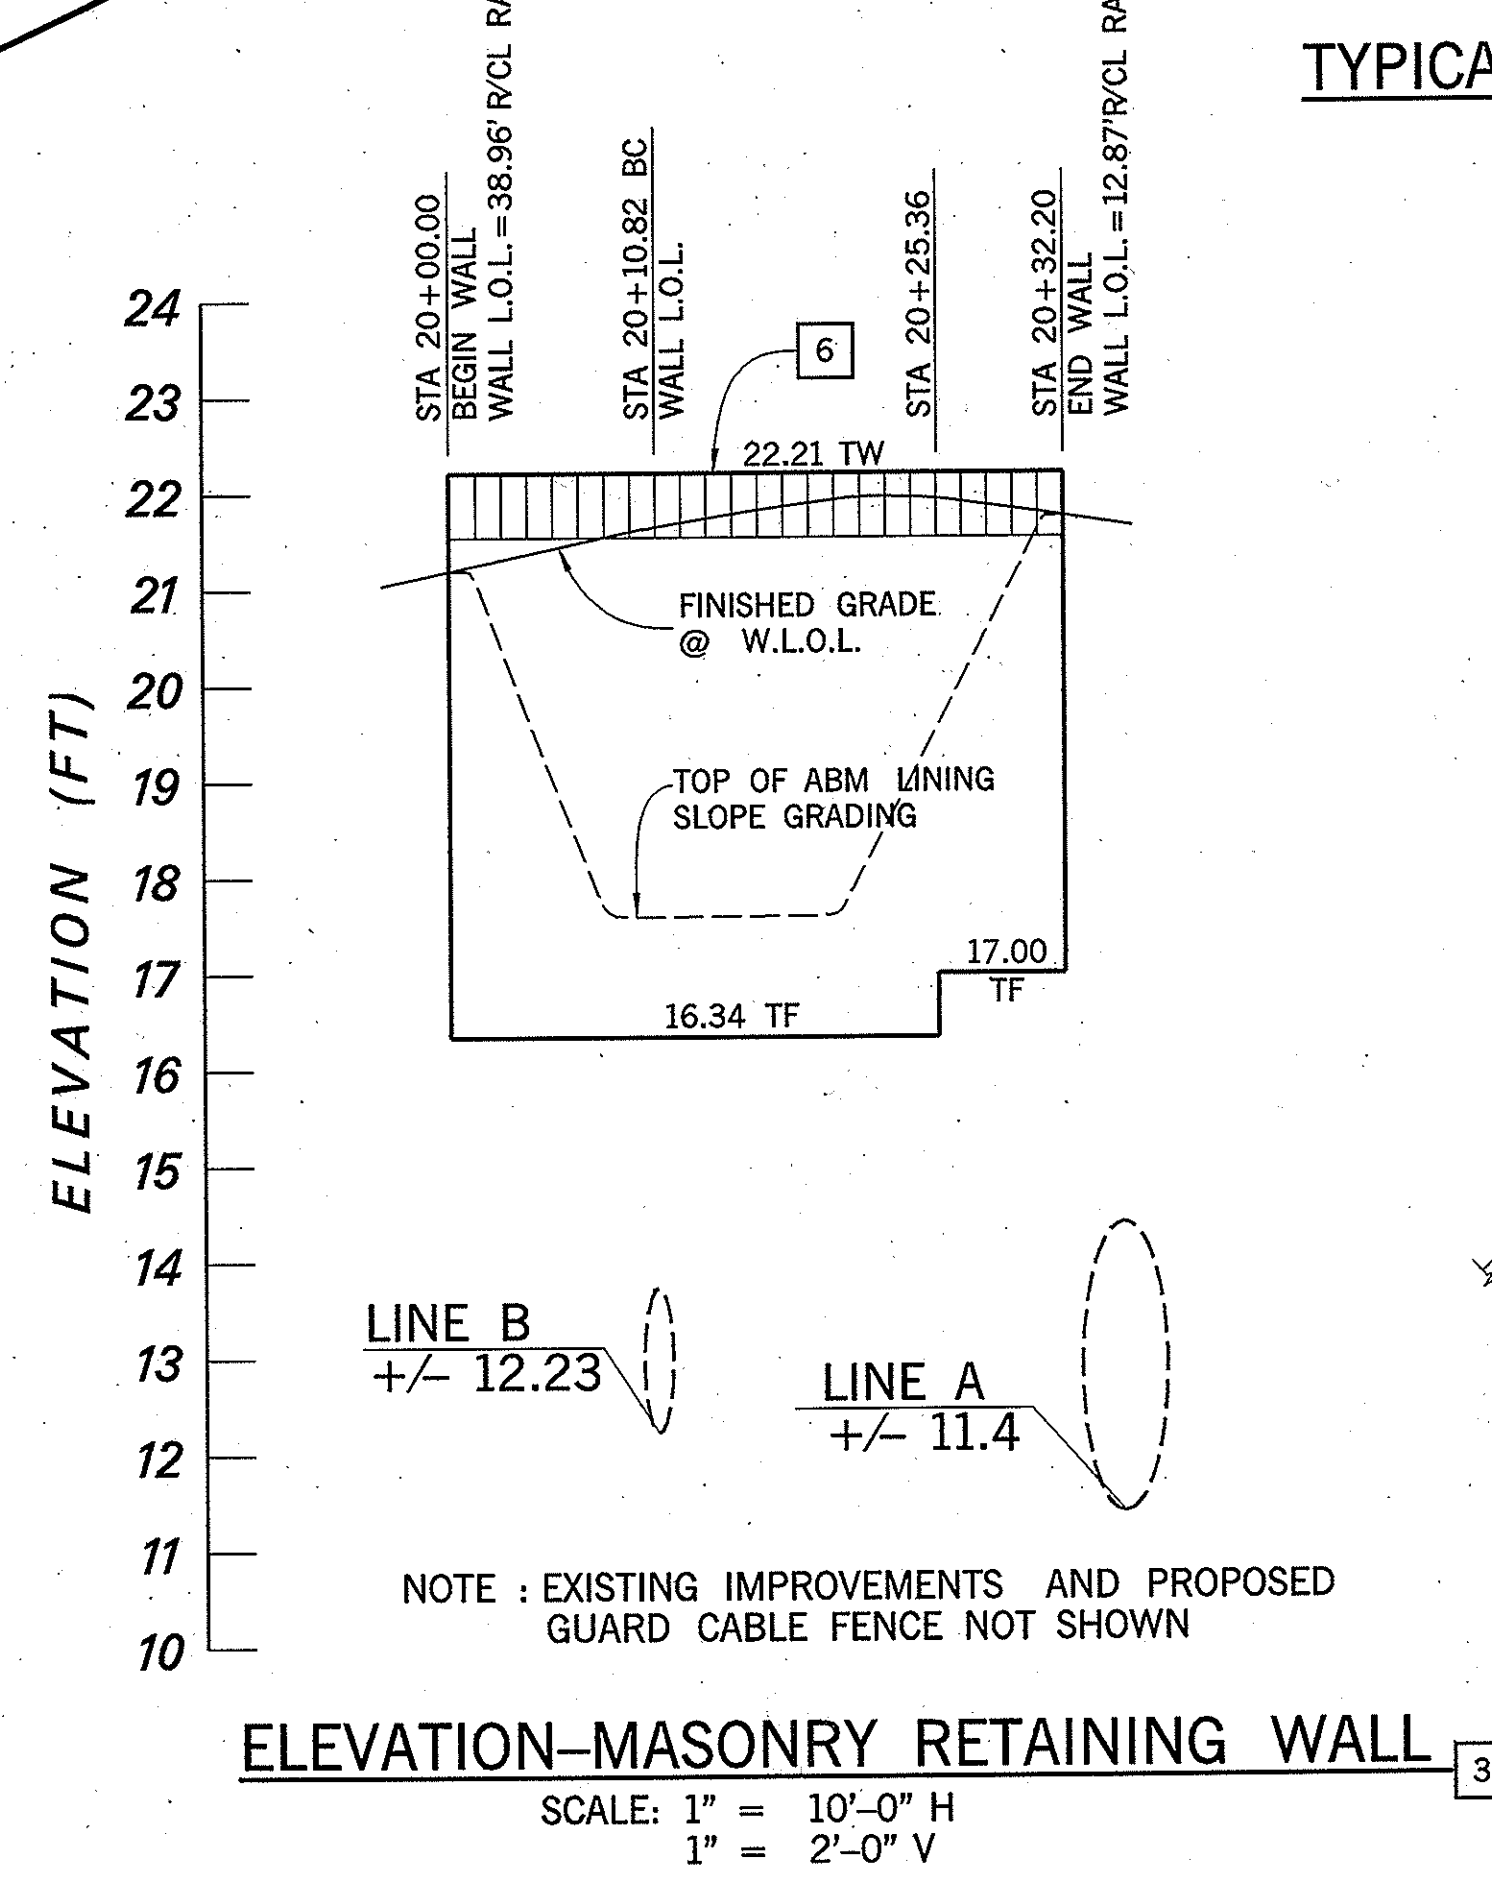

**APPROACH RAMP
SIGNING & STRIPING DETAILS**
SCALE: 1"=20'-0"

- STRIPING NOTES**
(THIS DETAIL ONLY)
- 1 PAINT
 - 2 INSTALL
 - 3 PROTECT IN PLACE
 - 4 REMOVE
 - 1 4" SOLID WHITE
 - 2 4" DASHED YELLOW

NOTE:
PROTECT IN PLACE ALL
EXISTING IMPROVEMENT
AND NEW CONSTRUCTION
ELSEWHERE PER THESE
PLANS. UNDERGROUND
UTILITIES NOT SHOWN.

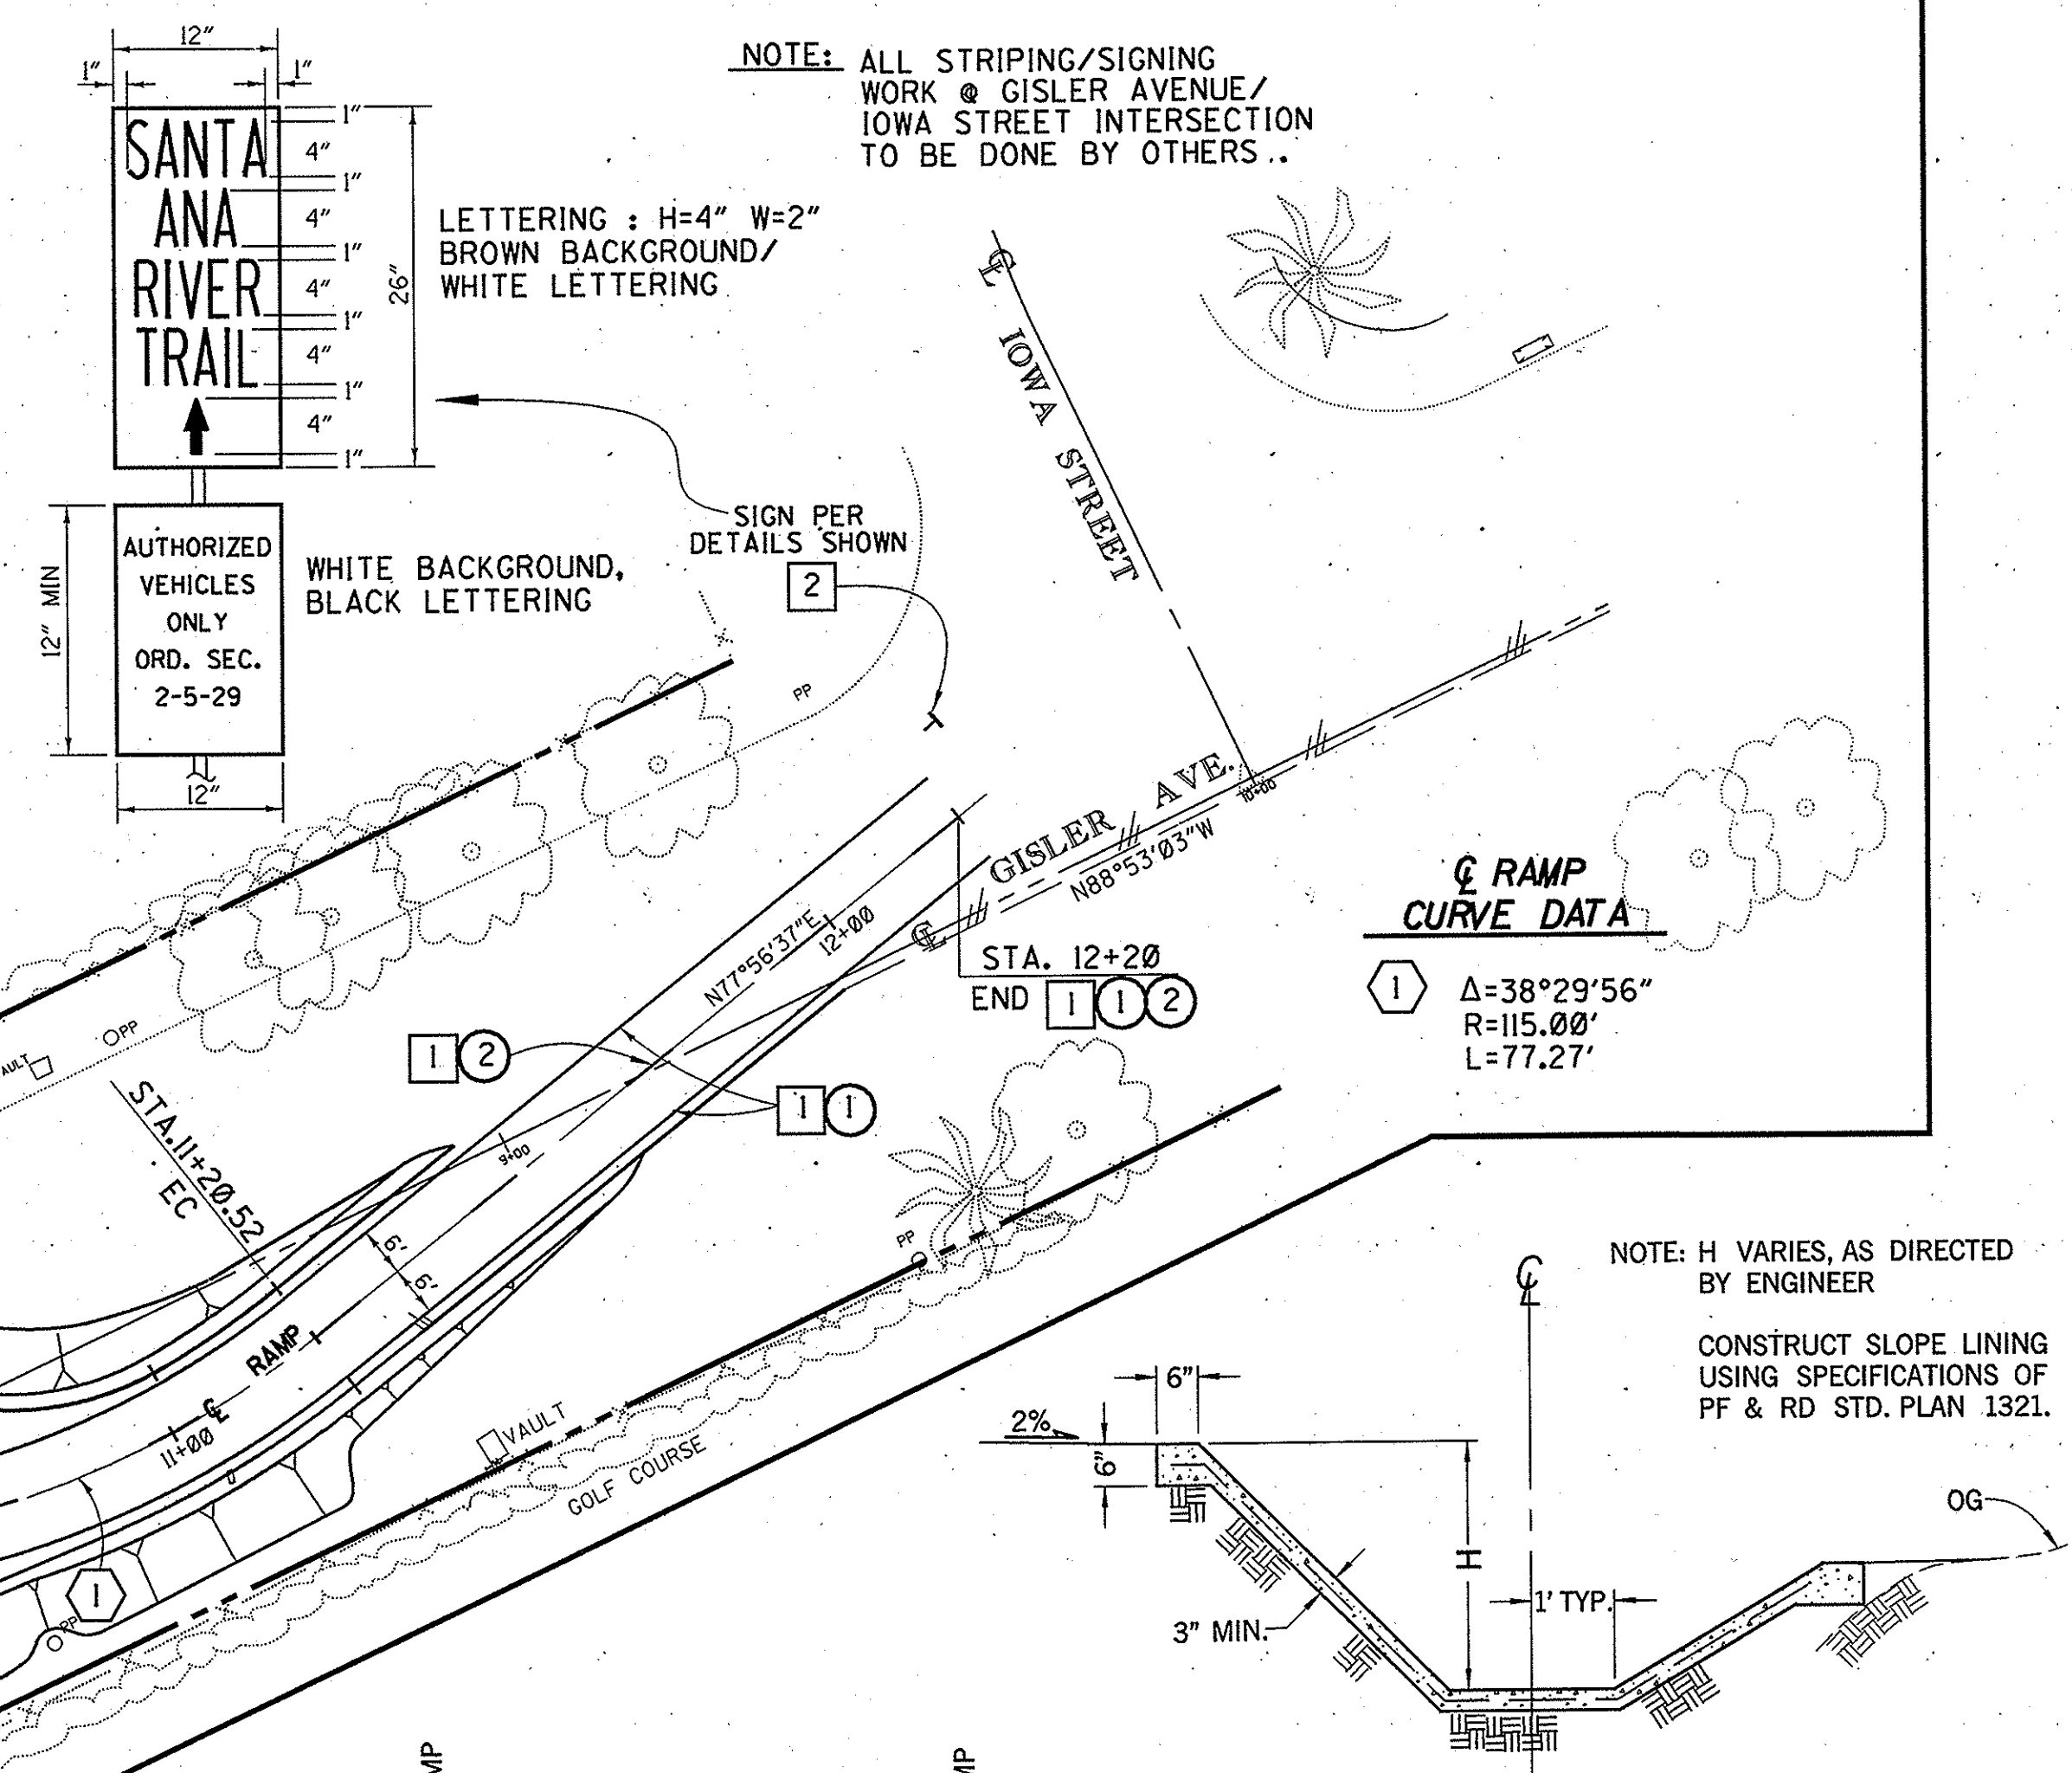

CONSTRUCTION NOTES:

- 3 CONSTRUCT MASONRY BLOCK RETAINING WALL PER PF&RD STANDARD PLAN 618-0-OC, PLAN, PROFILE & DETAILS SHEETS 5 & 6 AND AS DIRECTED BY ENGINEER.
- 6 INSTALL GUARD CABLE FENCE PER PF&RD STANDARD PLAN 1413 AND PLAN.
- 7 CONSTRUCT INLET TYPE V PER PF&RD STANDARD PLAN 1305, PLAN AND DETAILS.
- 8 CONSTRUCT REINFORCED CONCRETE COLLAR PER PF&RD STANDARD PLAN 1317, PLAN AND DETAILS.
- 9 INSTALL RCP PER PLAN AND DETAILS SHEET 5.
- 12 CONSTRUCT ABM SLOPE LINING PER PLAN AND DETAILS.
- 14 CONSTRUCT JUNCTION STRUCTURE TYPE VI PER PF&RD STANDARD PLAN 1315, DETAILS, AND AS DIRECTED BY THE ENGINEER.

- LEGEND**
- 1 PROTECT IN PLACE
 - 2 REMOVE
 - 7 REMOVE INTERFERING PORTIONS.

ORANGE COUNTY PUBLIC FACILITIES & RESOURCES DEPARTMENT		BRIDGE OVER GREENVILLE-BANNING CHANNEL @ WESTERLY END OF GISLER AVENUE	
DESIGNED: TR		CHECKED: EK	
DRAWN: HP/ML		DATE: 6/1/97	
SCALE: AS SHOWN		DRAWING NO. 6	
SHEET 6		OF 7	

FILE NAME: /gisler/gisstrip.dgn