
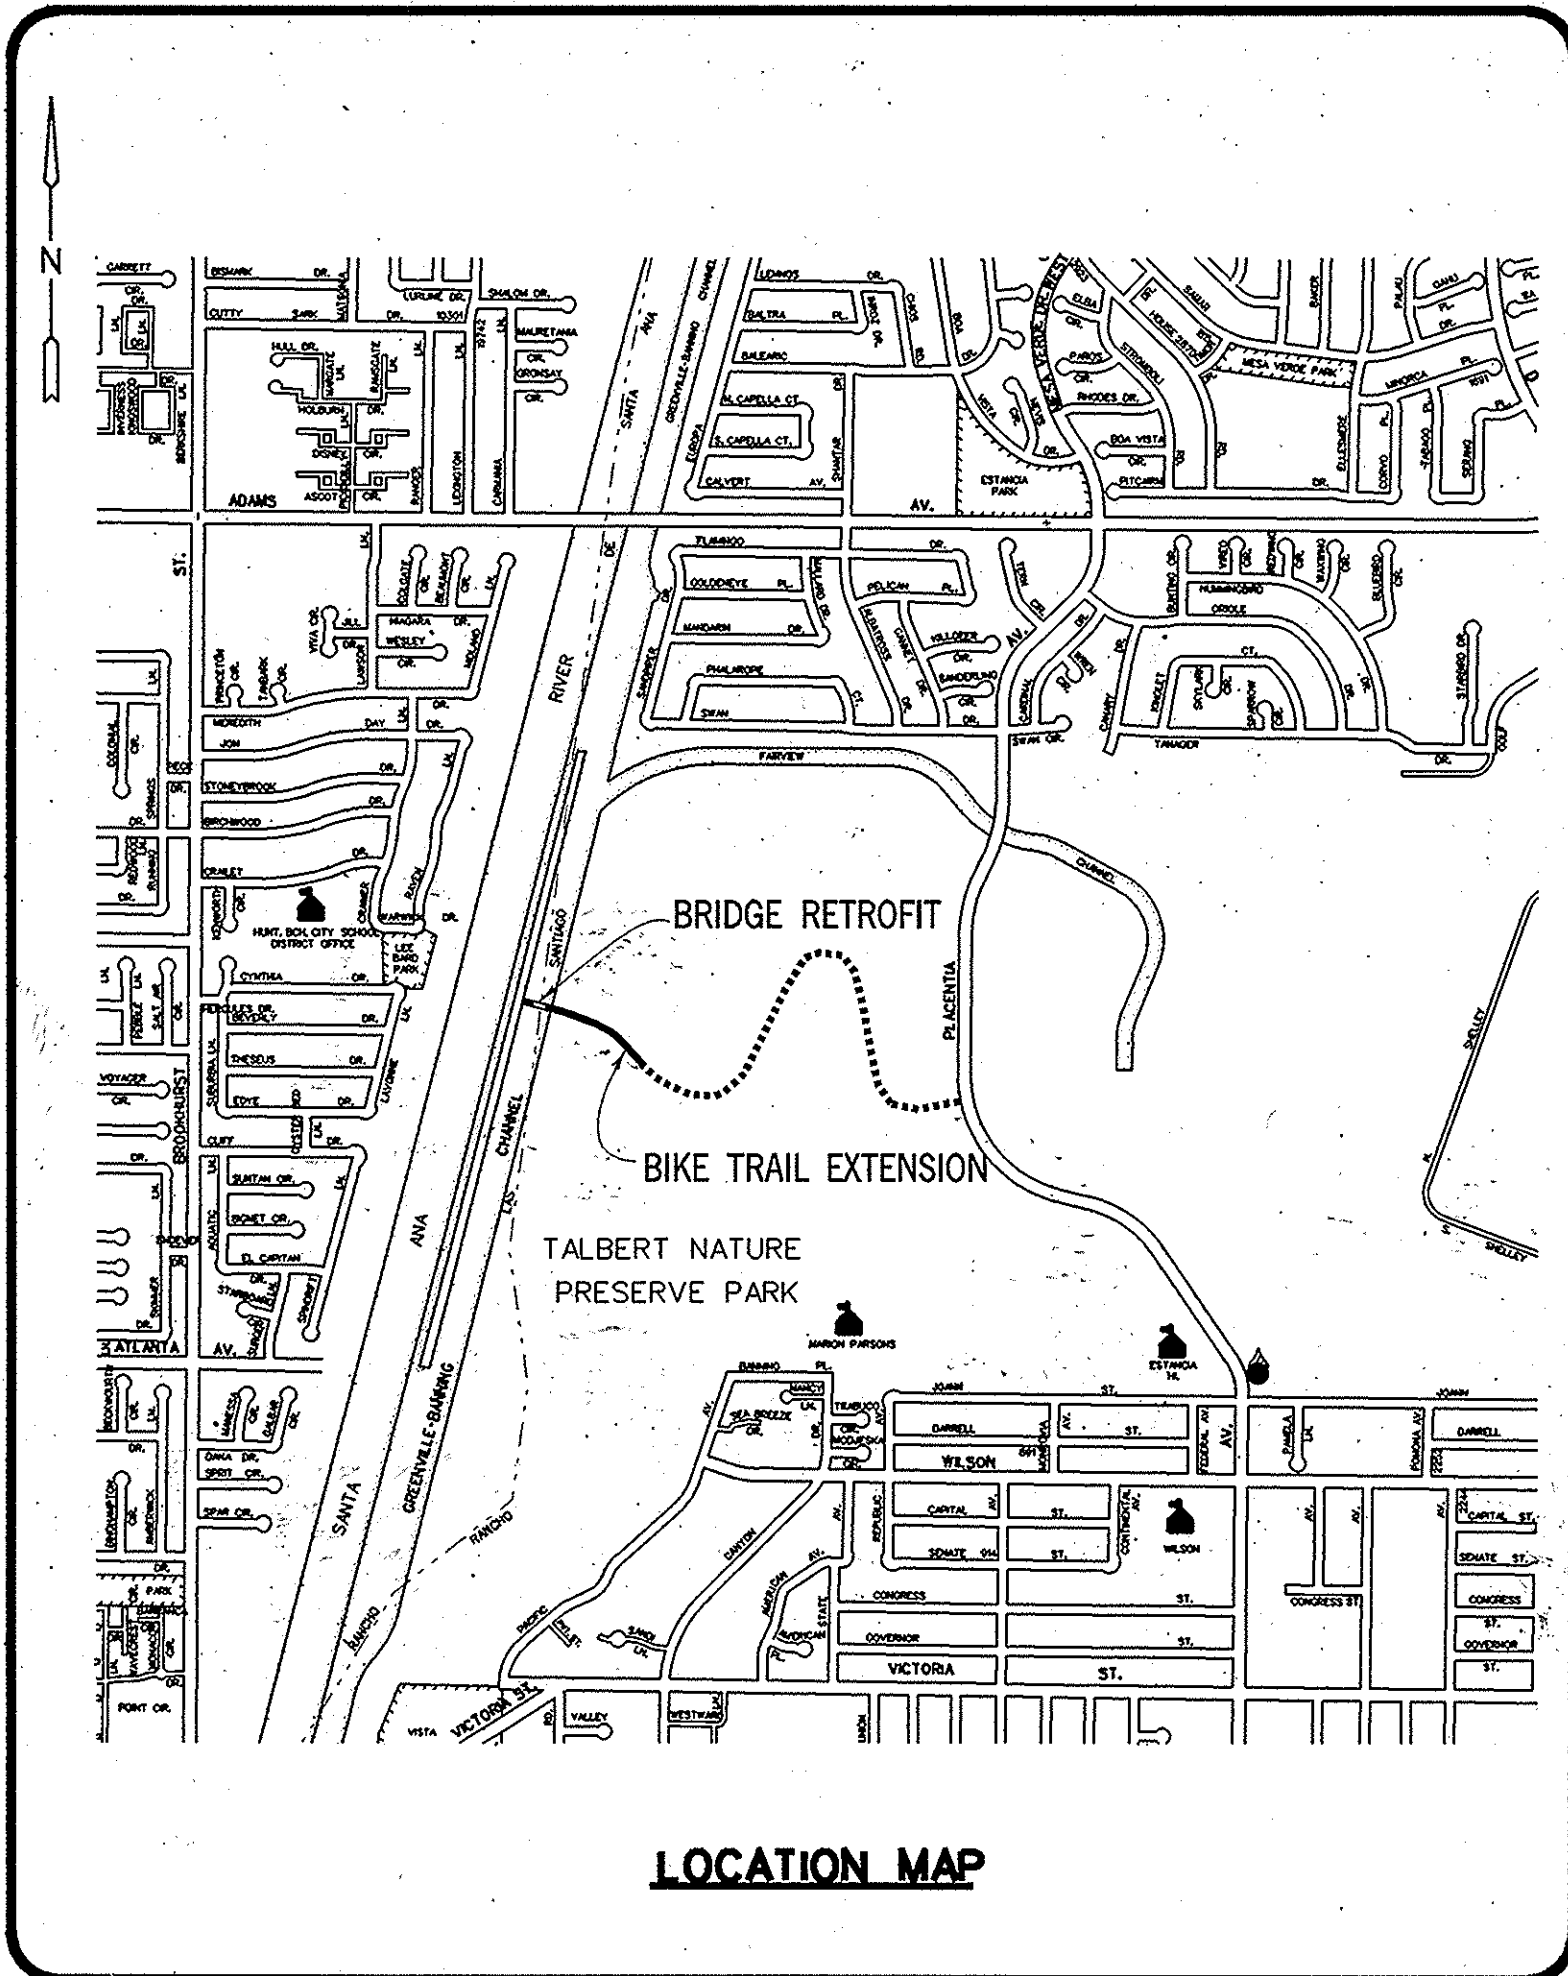


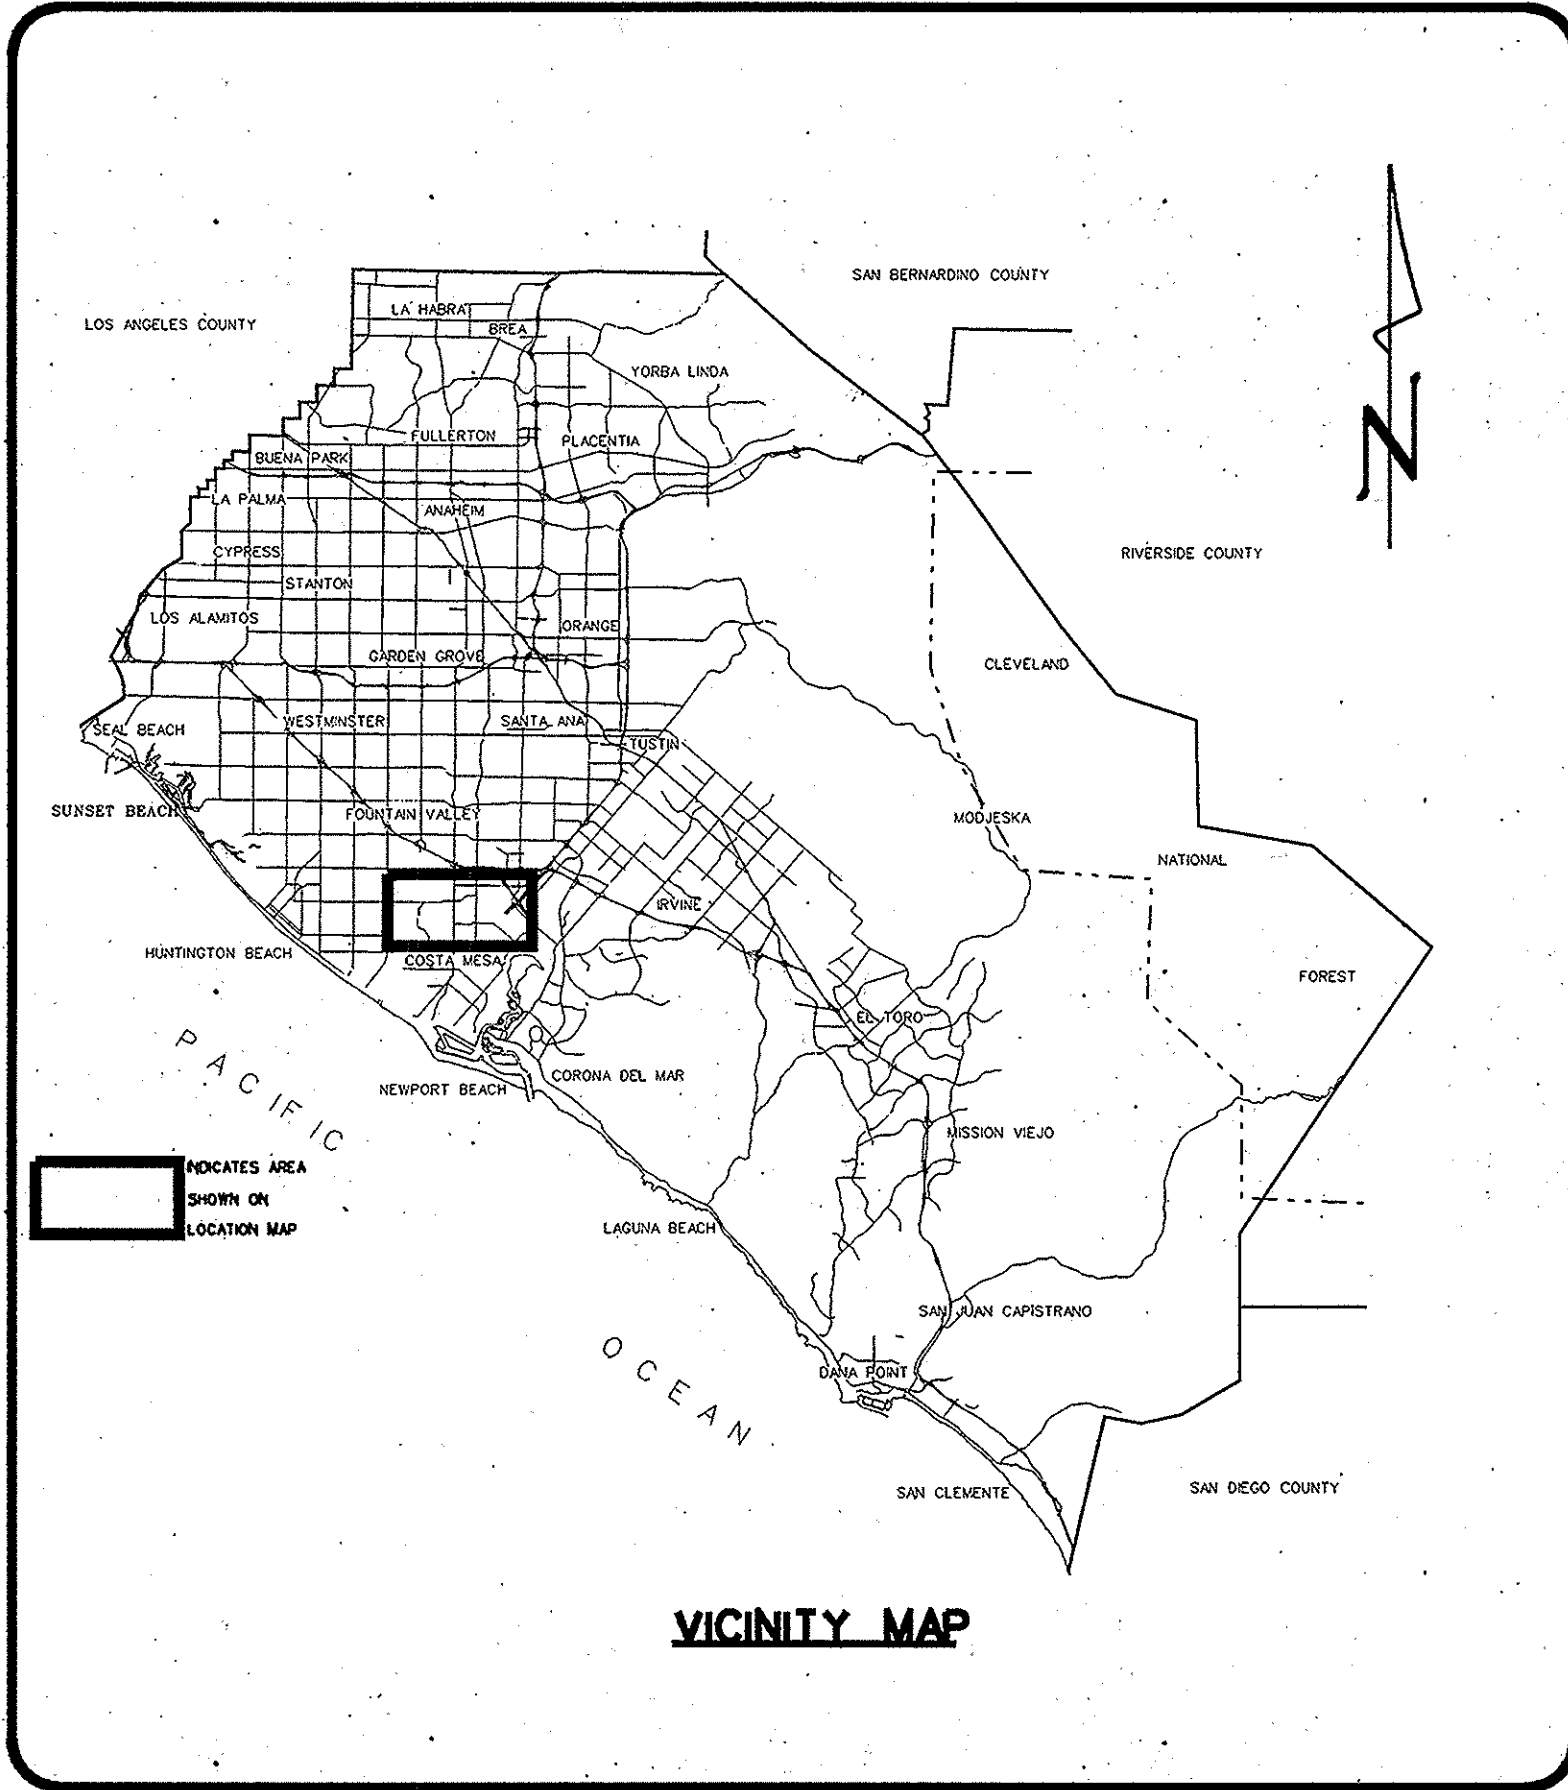

ORANGE COUNTY
ENVIRONMENTAL MANAGEMENT AGENCY
SANTA ANA, CALIFORNIA
M. RUANE, DIRECTOR

PLANS FOR CONSTRUCTION OF
GREENVILLE / BANNING CHANNEL
BRIDGE RETROFIT &
BIKE TRAIL EXTENSION

COSTA MESA, CALIFORNIA

JUNE, 1995

FUNDED BY:

SB 821

RECORD DRAWINGS

CONTRACTOR : COORG CORP.
INSPECTOR : JOE PARCO
DATE COMPLETED : AUGUST 9, 1996
RESIDENT ENGINEER : STAN VANDER MEY

EMA / PUBLIC WORKS

RECOMMENDED: *Vicent Kordell* 7-13-95
SECTION CHIEF ROAD DESIGN
RCE 30829

APPROVED: *William L. Farn* 7-13-95
DESIGN DIVISION MANAGER
RCE 13154

APPROVED: *William L. Farn* 7-13-95
DIRECTOR, PUBLIC WORKS

INDEX OF SHEETS	
SHEET	DESCRIPTION
1	TITLE PAGE
2	BIKE TRAIL EXTENSION PLAN
3	BIKE TRAIL DETAILS
4	BRIDGE RETROFIT PLAN & DETAILS
5	BRIDGE RETROFIT DETAILS
A 1/3, E1/3, 2/2 SHOP DRAWINGS FOR BRIDGE PREPARED BY COORG CONTRACTORS & ENGINEERS	

UTILITY OWNER	PHONE NO.	CONTACT
SOUTHERN CALIFORNIA GAS COMPANY	213/689-7263	AL STONE
	714/634-3262	JESSE SALAZAR
SOUTHERN CALIFORNIA EDISON CO.	714/895-0246	CHRIS CARTWRIGHT
CITY OF HUNTINGTON BEACH	714/536-5500	JOHN VONHOLLE
GENERAL TELEPHONE	714/373-2624	DONALD SMITH
COPLEY CONLEY CABLEVISION	714/549-3500	SEAN FLYNN
COSTA MESA SANITARY DISTRICT	714/548-1192	ROB HAMERS
UNDERGROUND SERVICE ALERT	800-422-4133	

BENCH MARK:	BASIS OF BEARINGS:
(O.C.S.) 1976	The Basis of bearing hereon is the
CM 3681 54.52	Grid inverse between O.C.S.
CM 3781 76.95	control stations 4034 & 4036 being
	N14-17-07.9E, 1990 O.C.S. GPS
	adjustment, 1983 N.A.D.

NO.	DESCRIPTION	SHT.	APPROVED	DATE
A	AS SHOWN, INC SHOP DRAWINGS 2&4			
REVISIONS				