

CONSTRUCTION NOTES

- 1- CONSTRUCT 15 FOOT WIDE BIKE TRAIL, 0.35' AC / NATIVE SOIL, ON 95% RELATIVE COMPACTED SOIL. SEE A.C. PAVING DETAIL # 23 ON SHEET 3. TRAIL ALIGNMENT PER EXISTING GRADED PAD.
- 2- INSTALL TYPICAL TRAIL FENCE AT SOUTH SIDE OF TRAIL. SEE FENCING DETAILS # 1, 2 AND 3 ON SHEET 3. HEIGHT=3.5'.
- 3- REPAIR EROSION TO EXISTING GRADED PAD AND SLOPE.
- 4- INSTALL DOUBLE TRASH CAN HOLDER, WITH TWO (2) TRASH CANS, IN WIDENED TRAIL AREA. SEE TRASH CAN FOUNDATION DETAIL # 16 AND WIDENED TRAIL DETAIL # 16A ON SHEET 3.
- 5- INSTALL PARK ENTRY SIGN, VERIFY LOCATION WITH ENGINEER. SEE SIGNAGE DETAIL # 18 ON SHEET 3.
- 6- INSTALL 6" PVC PIPES (LENGTH=45') AT APPROXIMATE LOCATIONS SHOWN, AS SLEEVING FOR FUTURE IRRIGATION SYSTEM. TRENCH DEPTH TO BE 12" UNLESS OTHERWISE SHOWN. BACKFILL WITH APPROVED EXCAVATED MATERIALS PER SPECIFICATIONS. PIPE ENDS SHALL BE CAPPED. (ADDITIVE BID ITEM)

R13 ATTACH EXIST. CHANNEL WALL FENCE TO BRIDGE FENCE FABRIC.

LEGEND


R14 CONSTRUCT FENCE PANEL CONNECTIONS FROM EXISTING CHANNEL WALL FENCE TO FENCE ON CONCRETE RAMPS

1- PROTECT IN PLACE.


R2 JOIN

GENERAL NOTES

- 1. PAD SHALL BE GRADED BEFORE TRAIL CONSTRUCTION BEGINS. LOCALIZED GROUND DEPRESSIONS THAT ARE MORE THAN 3 INCHES DEEP SHALL BE ELIMINATED BY PROPERLY PLACING COMPACTED FILL.
- 2. ACCESS TO THE SITE MAY BE AVAILABLE FROM THE GREENVILLE/BANNING CHANNEL ACCESS ROAD. OBTAIN AUTHORIZATION TO USE THIS ROUTE FROM ORANGE COUNTY FLOOD CONTROL DISTRICT - GENE HOLUM (714) 576-6243.

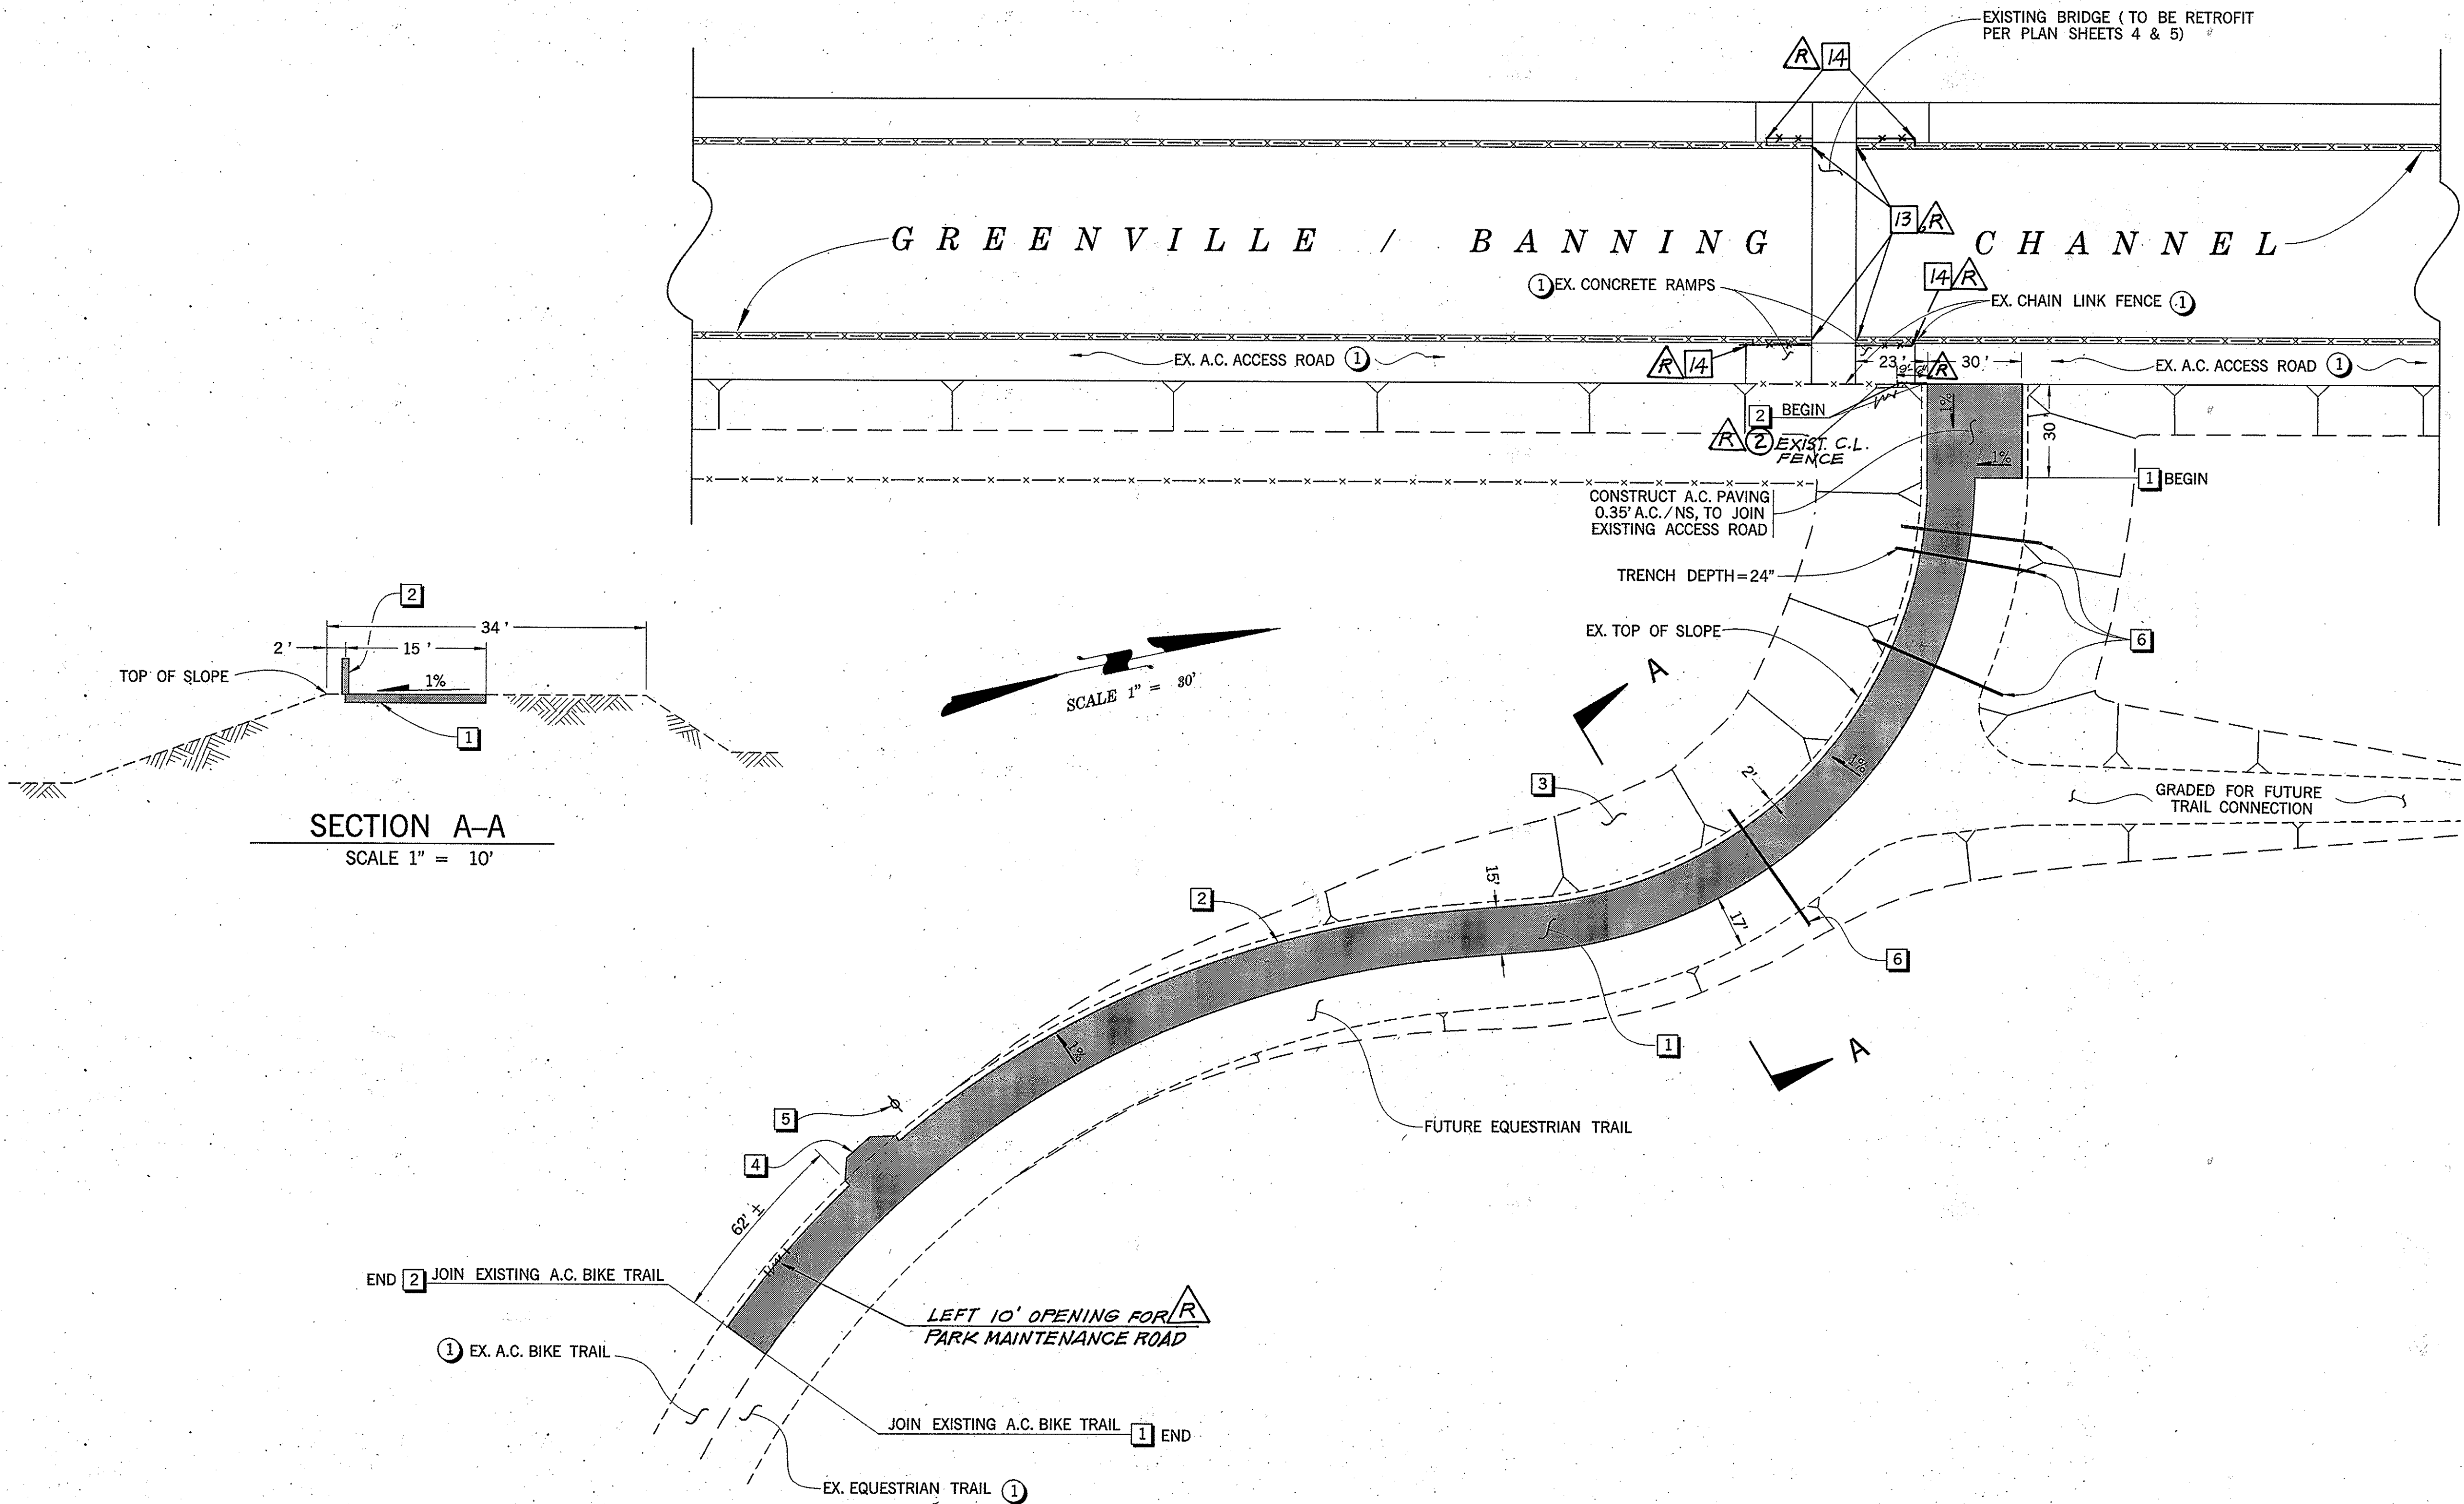

SECTION A-A  
SCALE 1\"/>

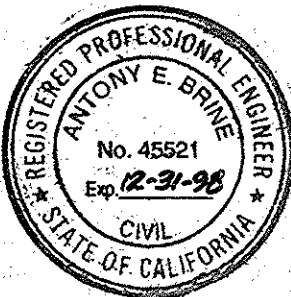

1/98 AS SHOWN		ORANGE COUNTY ENVIRONMENTAL MANAGEMENT AGENCY	
		GREENVILLE / BANNING CHANNEL BIKE TRAIL EXTENSION PLAN	
MARK	DATE	DESCRIPTION	PREPARED UNDER SUPERVISION OF
REVISIONS		RCE 45521 7-12-95	
DESIGNED	DATE	DRAWING NO.	SHEET
EMIL	JUN 95	ER 50472	2
CHECKED	DATE	DRAWING NO.	OF
A. BRINE			5