


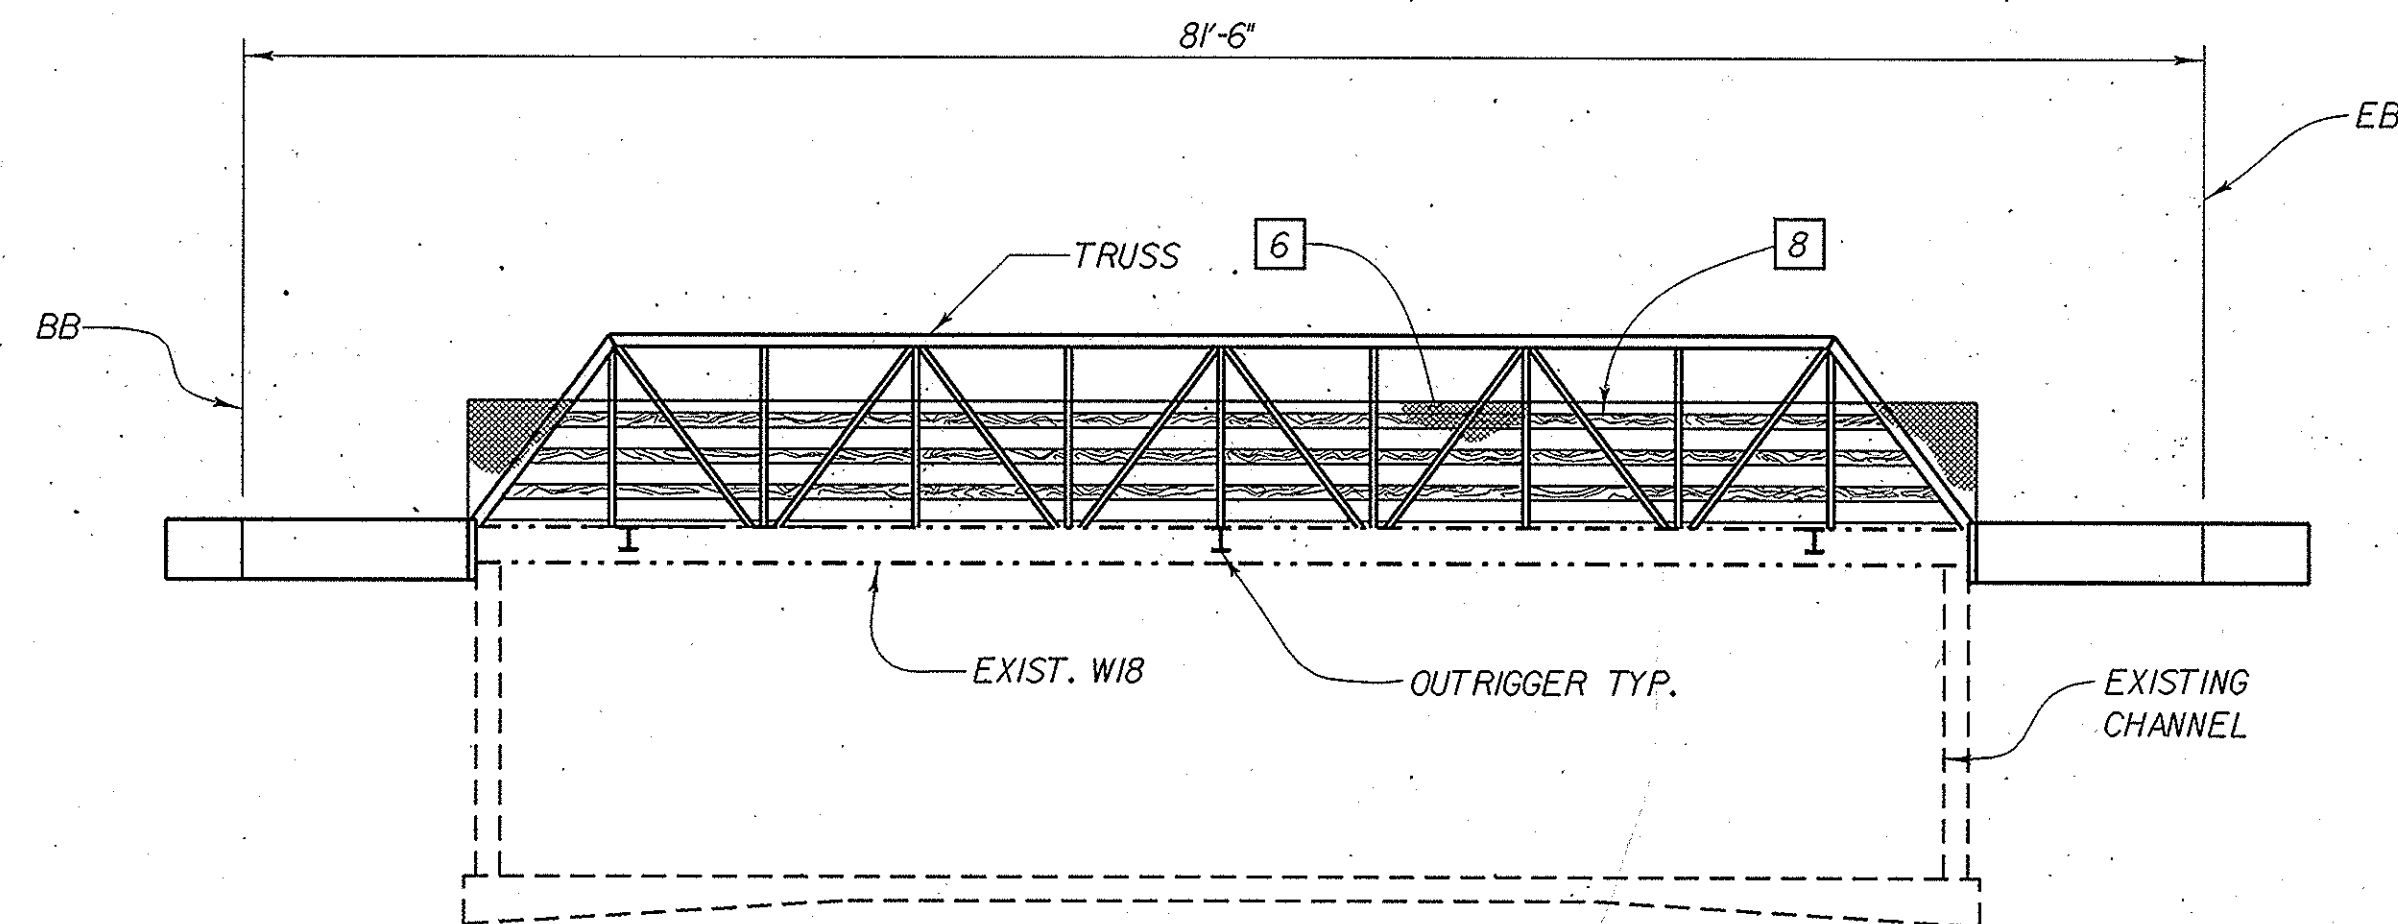


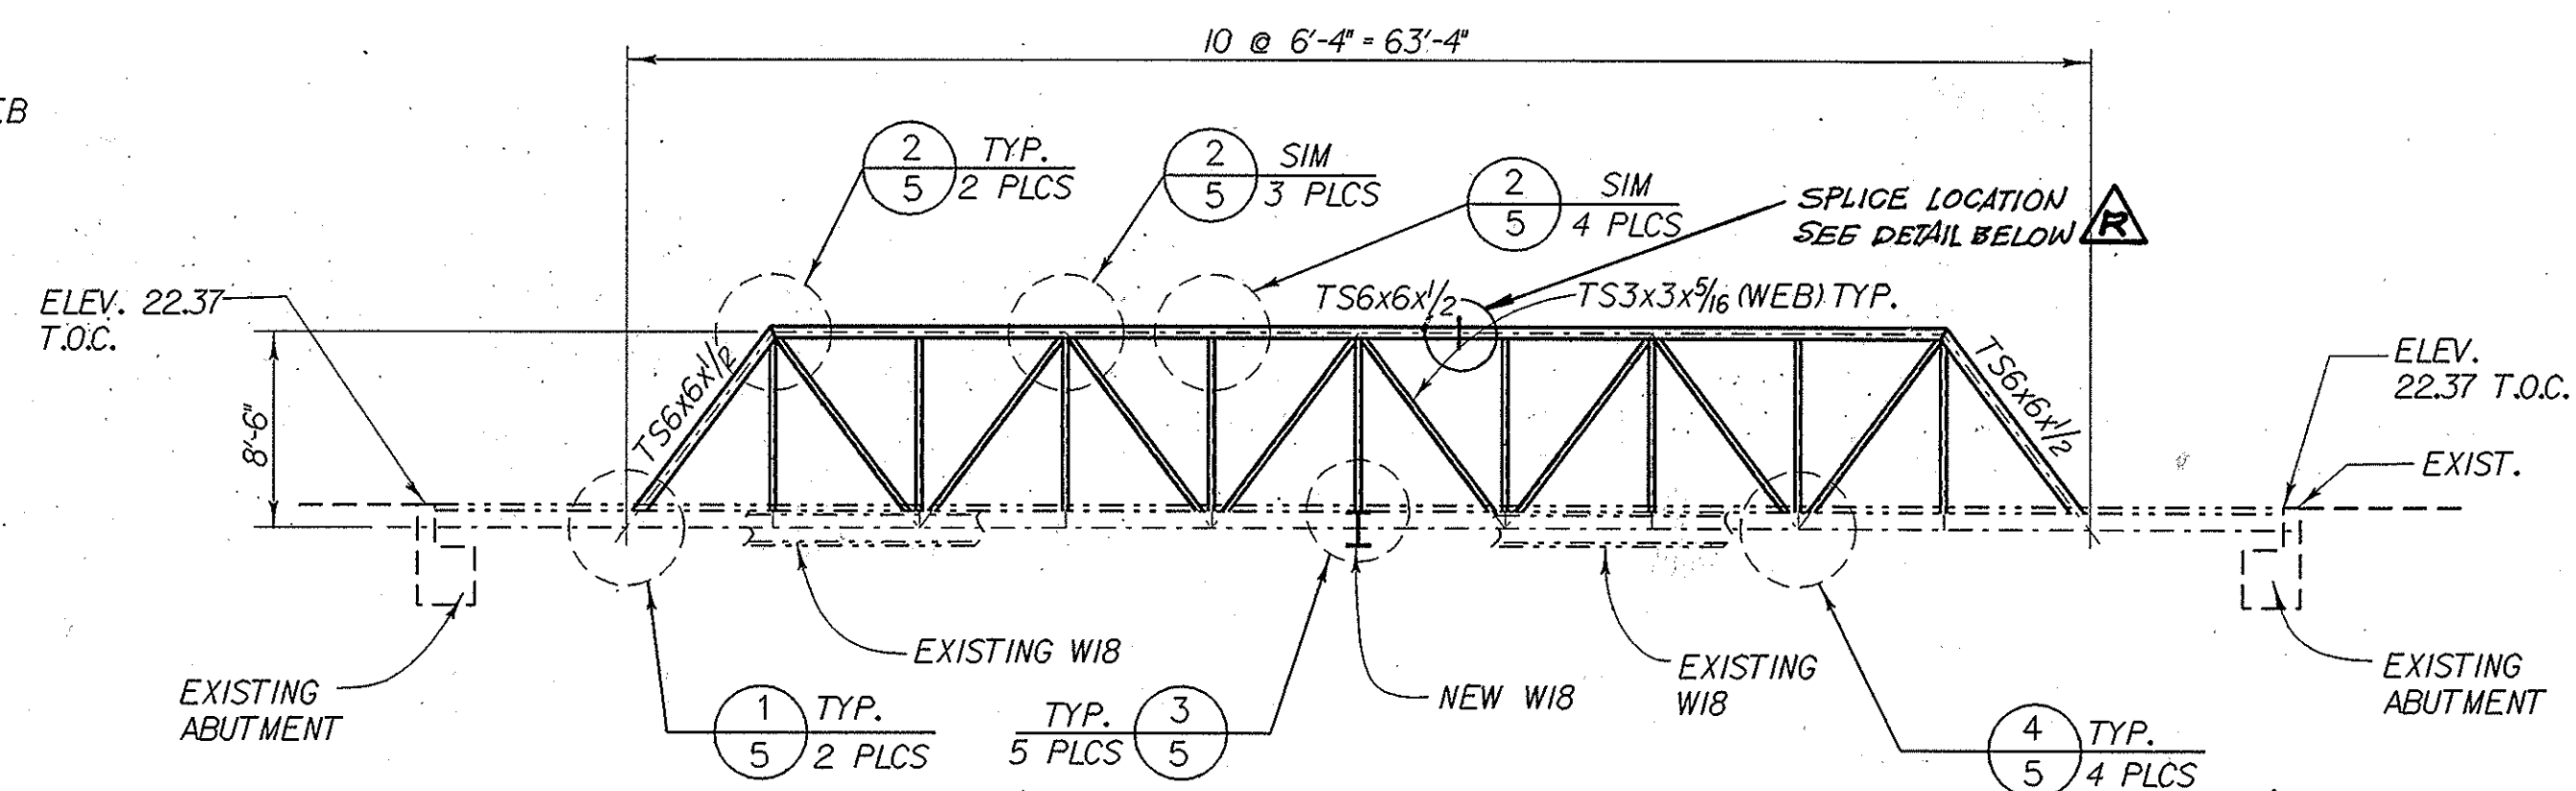

ELEVATION
SCALE: 1/8"=1'-0"

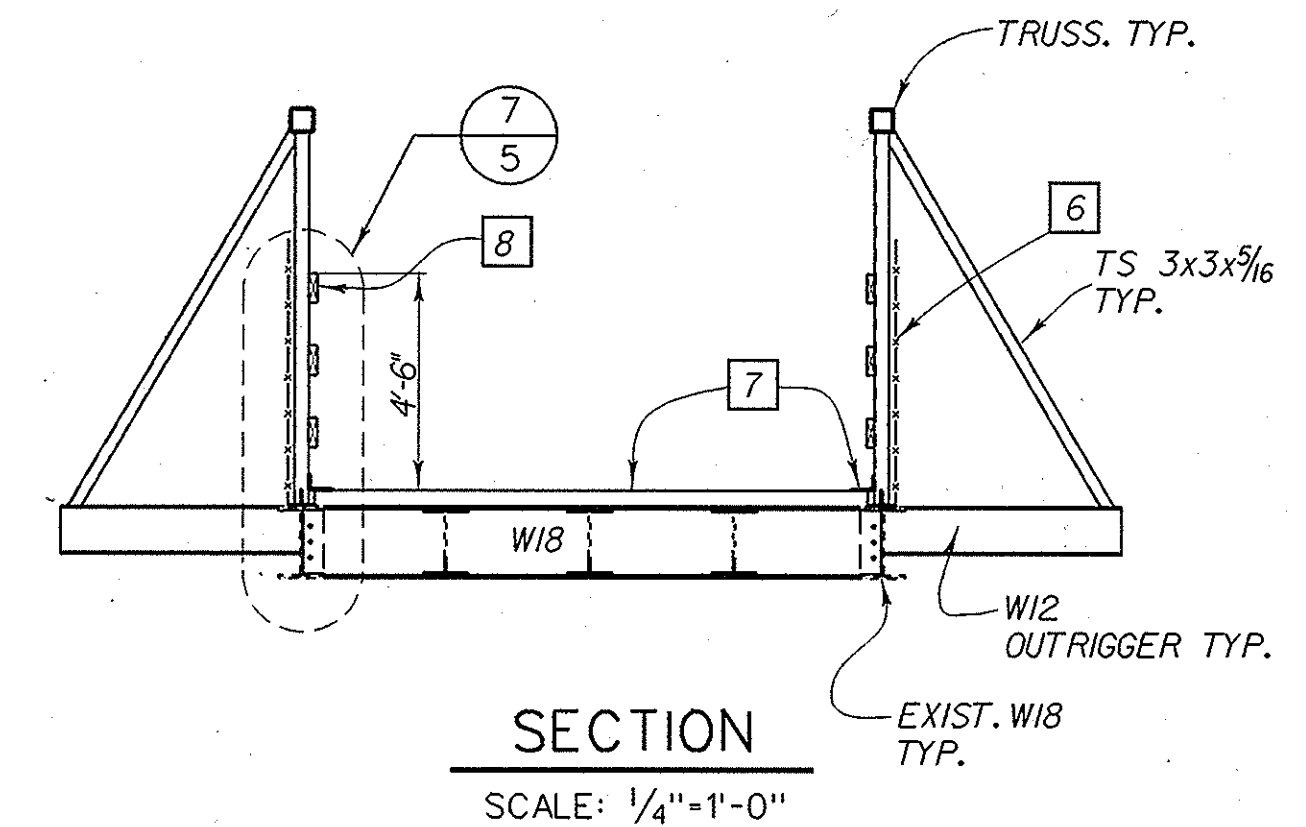

TRUSS ELEVATION
SCALE: 1/8"=1'-0"

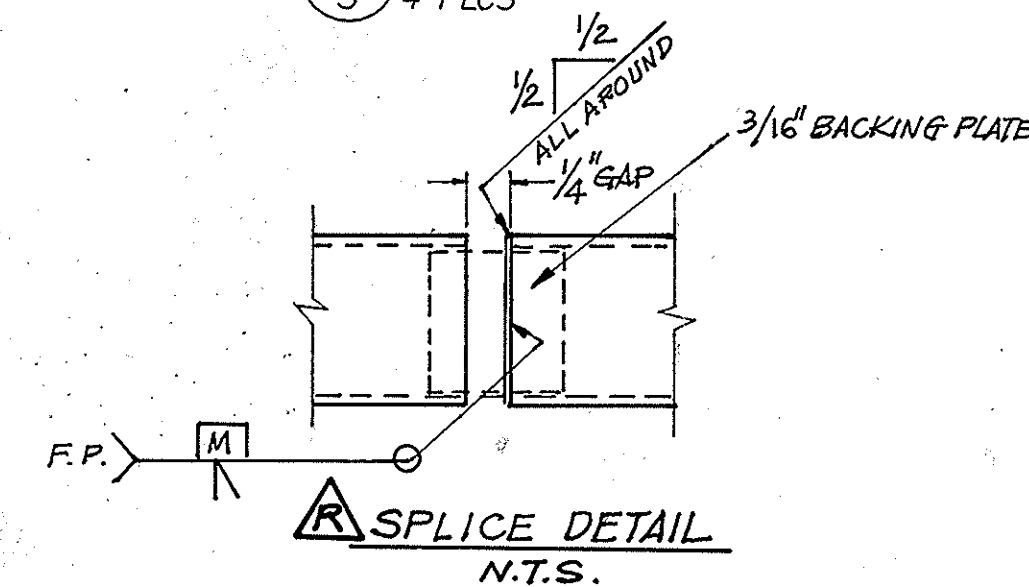



GENERAL NOTES

SERVICE LOAD DESIGN

- DESIGN: BRIDGE DESIGN SPECIFICATIONS (1992 AASHTO AS MODIFIED BY CALTRANS)
- DEAD LOAD: NO ADDITIONAL LOAD INCLUDED FOR FUTURE LOADING.
- LIVE LOADING: 85 P.S.F. PEDESTRIAN LOADING
- STRUCTURAL STEEL: STRUCTURAL STEEL - ASTM A36
STRUCTURAL TUBING - ASTM A501
- BOLTS: ASTM A325SC, CLASS B U.N.O.
- TACK WELD THE NUT TO THE BOLT AFTER INSTALLATION.
- CENTERLINE OF THE ANGLES AS SHOWN ON THE PLAN SHALL BE THE GAGE LINE OF THE ANGLE.

CONSTRUCTION NOTES


- REMOVE EXISTING CHAIN LINK FENCE ALONG BRIDGE AND REINSTALL AFTER COMPLETION OF THE TRUSS. SEE DETAIL 7/5
- REMOVE EXISTING 4X FLOOR PLANKS AND L6 EDGE ANGLE CLAMP. MODIFY AND REINSTALL PER DETAIL 7/5
- WOOD HANDRAIL. SEE DETAIL 7/5 & 8/5
- PROTECT EXISTING FENCE POSTS IN PLACE.
- PROTECT EXISTING ABUTMENT IN PLACE.
- PROTECT EXISTING ABUTMENT ANCHOR BOLTS DURING CONSTRUCTION.
- PROTECT EXISTING CHAIN LINK FENCE IN PLACE.
- ATTACH EXIST. CHANNEL WALL FENCE TO REPLACED BRIDGE FENCE FABRIC.
- CONSTRUCT FENCE PANEL CONNECTIONS FROM EXIST. CHANNEL WALL FENCE TO FENCE ON CONCRETE RAMPS. SAWCUT AND REMOVE

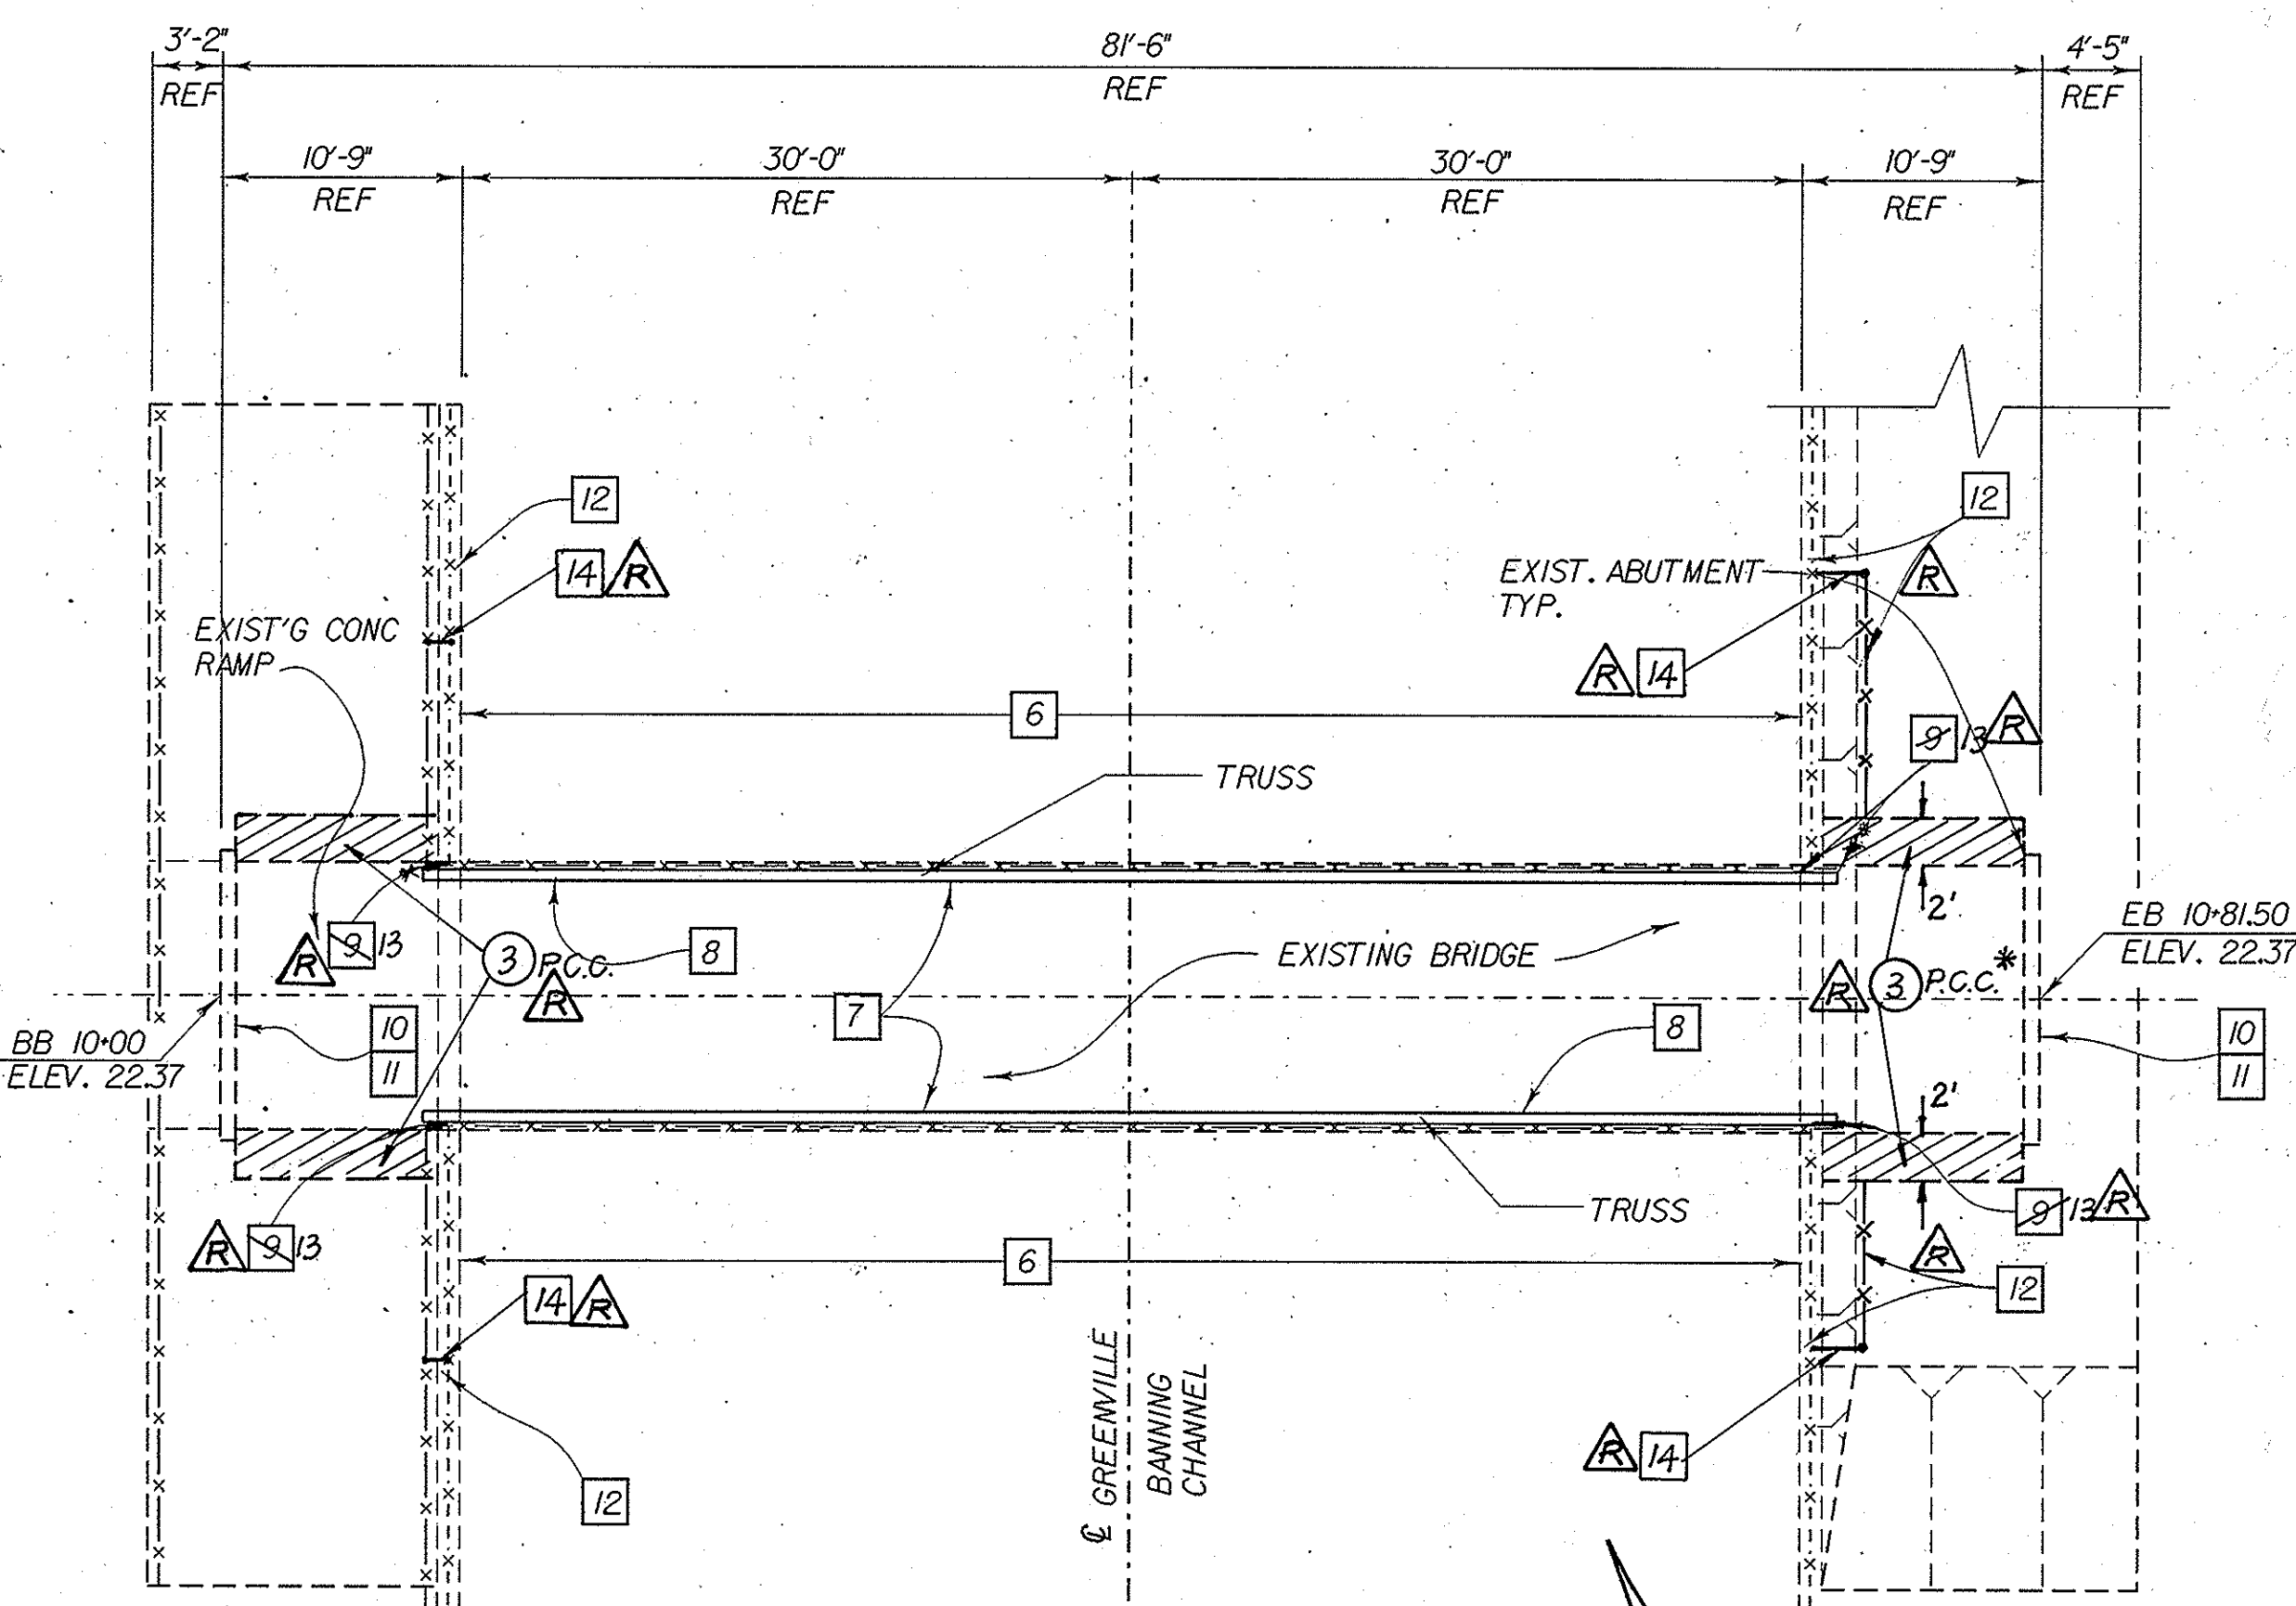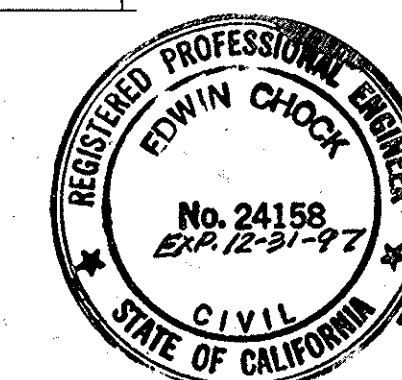

PLAN
SCALE: 1/8"=1'-0"
EXISTING BICYCLE BRIDGE @ GREENVILLE/BANNING CHANNEL

R* REMOVED EXISTING PORTIONS OF P.C.C. APPROACH ADJACENT TO EXISTING W18'S IN ORDER TO REMOVE BRIDGE STRUCTURE.

NOTE:
THE CONTRACTOR SHALL VERIFY ALL CONTROLLING FIELD DIMENSIONS & CONDITIONS PRIOR TO START THE WORK.

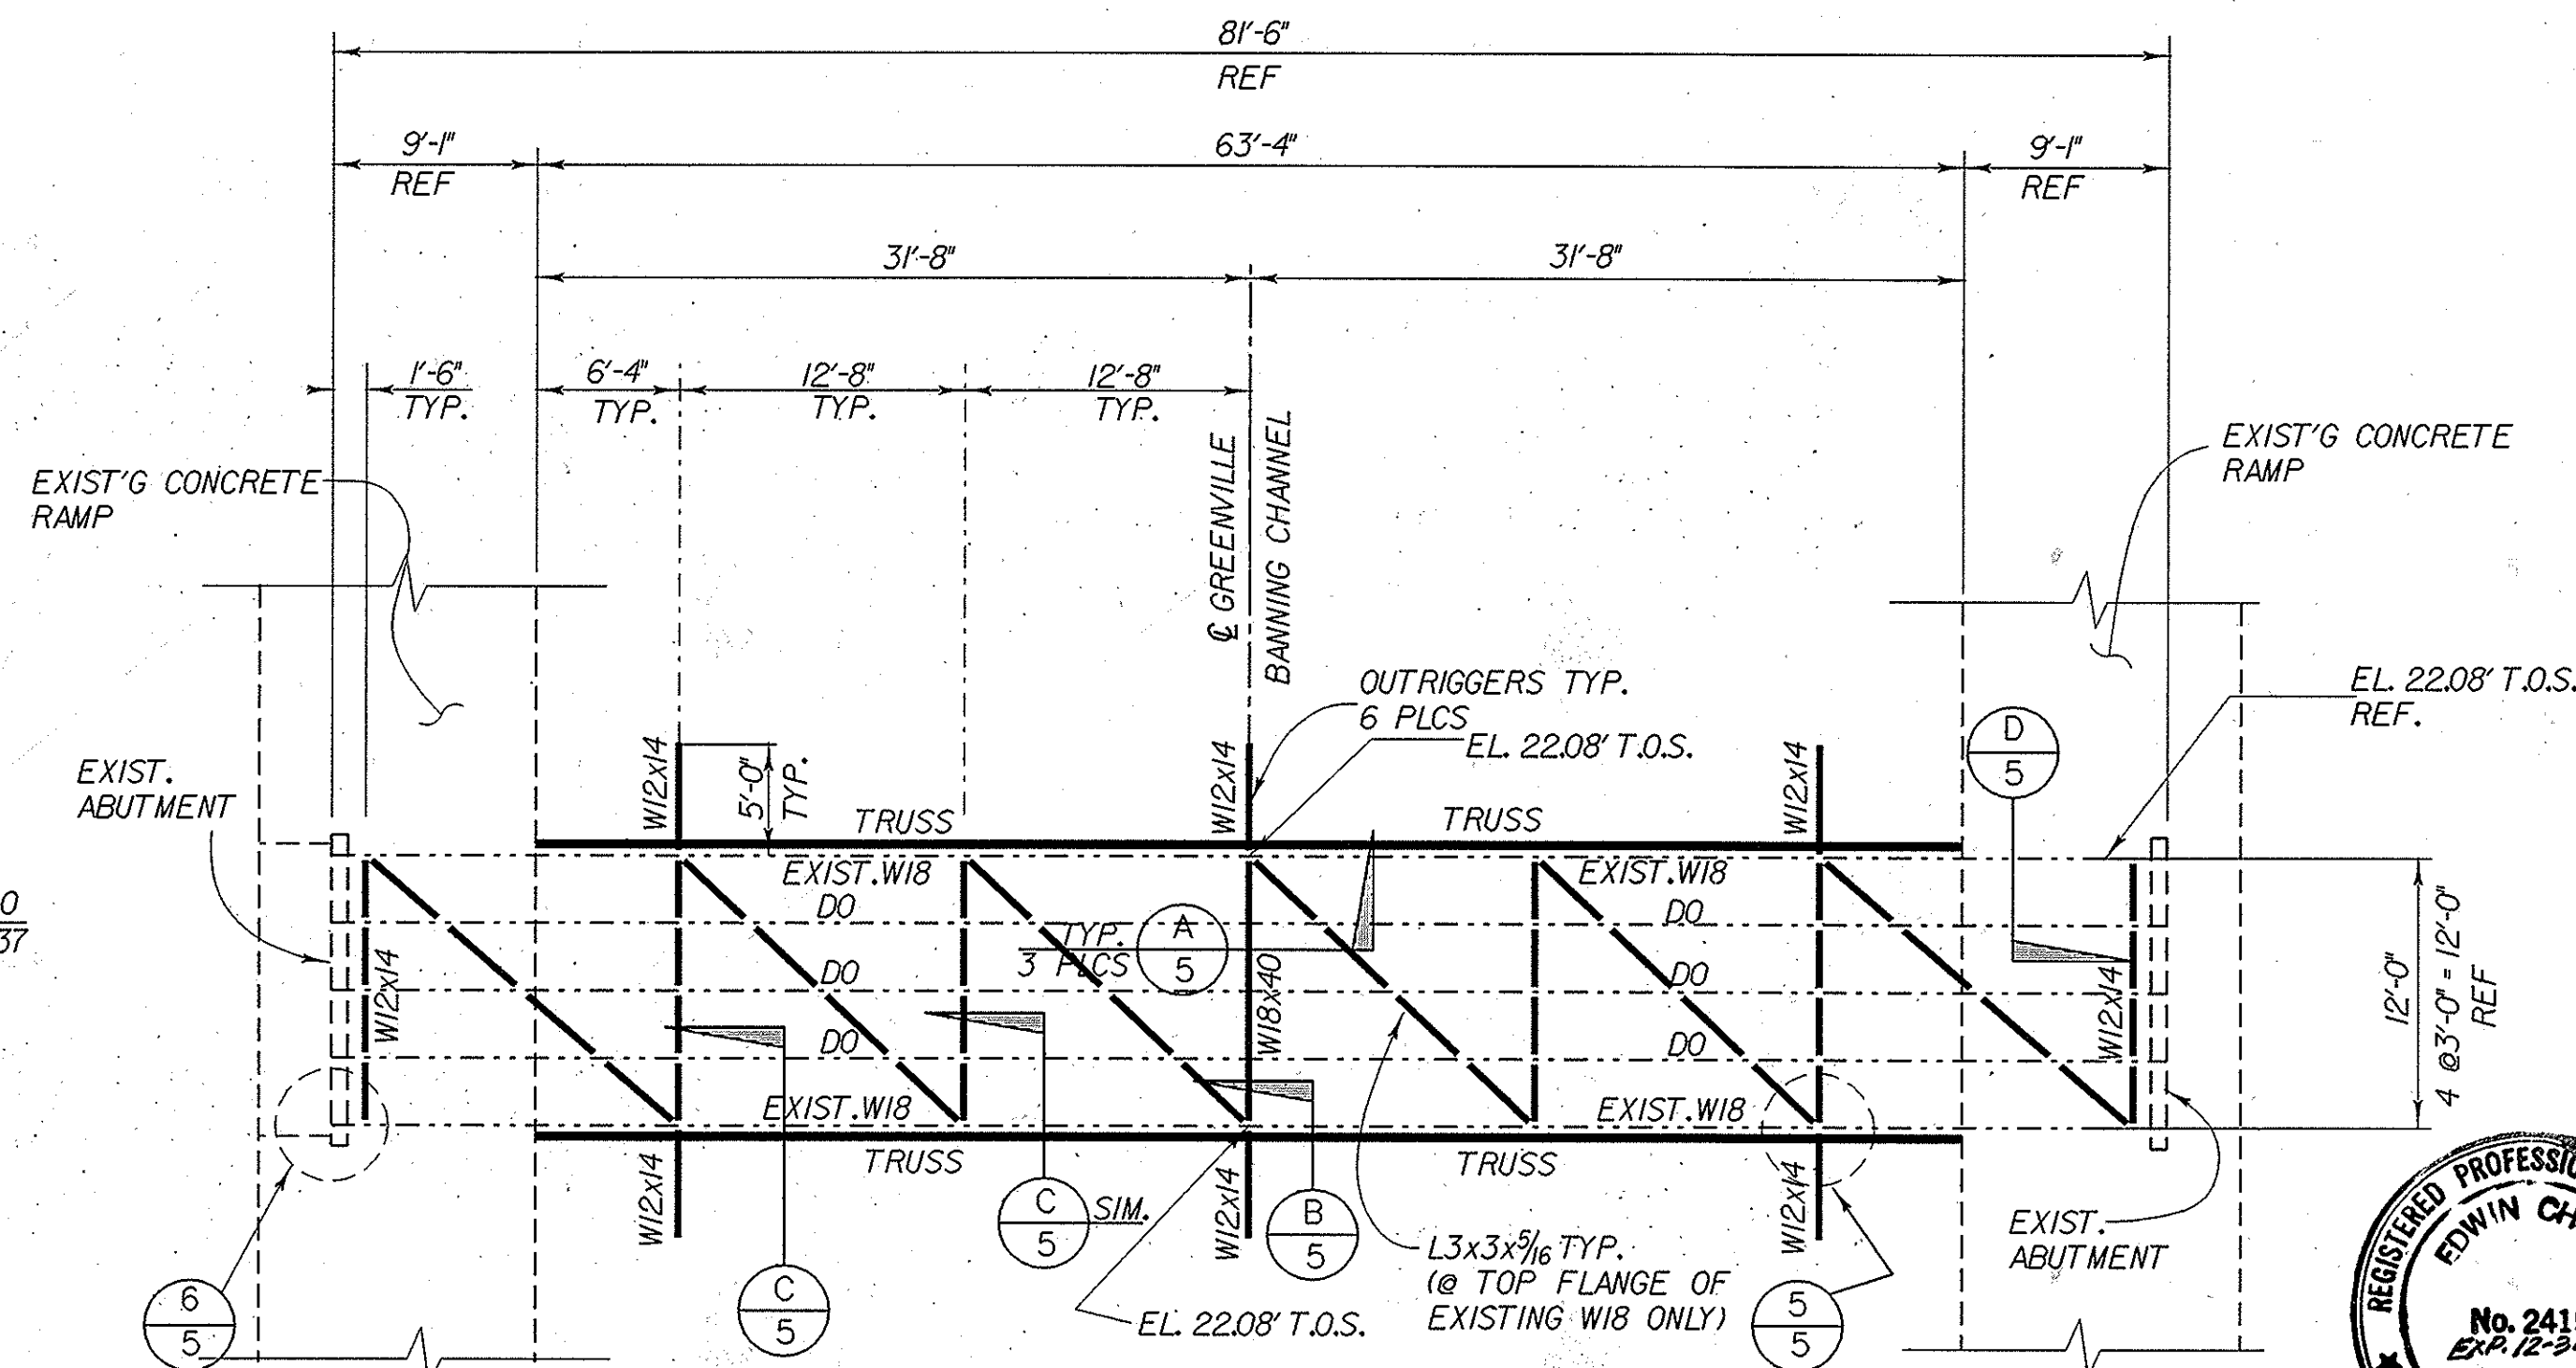

GIRDER LAYOUT
SCALE: 1/8"=1'-0"

QUANTITIES

- | | |
|---|----------|
| 1. MODIFY EXISTING CHAIN LINK FENCE | 130 LF |
| 2. MODIFY EXISTING WOOD PLANKS | 1 LS |
| 3. CLEANING AND PAINTING STRUCTURAL STEEL | 1 LS |
| 4. FURNISH STRUCTURAL STEEL | 13500 LB |
| 5. ERECTING STRUCTURAL STEEL | 13500 LB |
| 6. MODIFY EXISTING BRIDGE GIRDERS | 1 LS |
| 7. WOOD HANDRAILING | 112 LF |

ORANGE COUNTY ENVIRONMENTAL MANAGEMENT AGENCY			
GREENVILLE / BANNING CHANNEL			
PLANS, ELEVATIONS & CROSS SECTION			
MARK	DATE	DESCRIPTION	PREPARED UNDER SUPERVISION OF
REVISIONS			
DESIGNED	DATE	W. O. NO.	SHEET
A. MACIEL	MAY 95	ER 50472	4 OF 5