




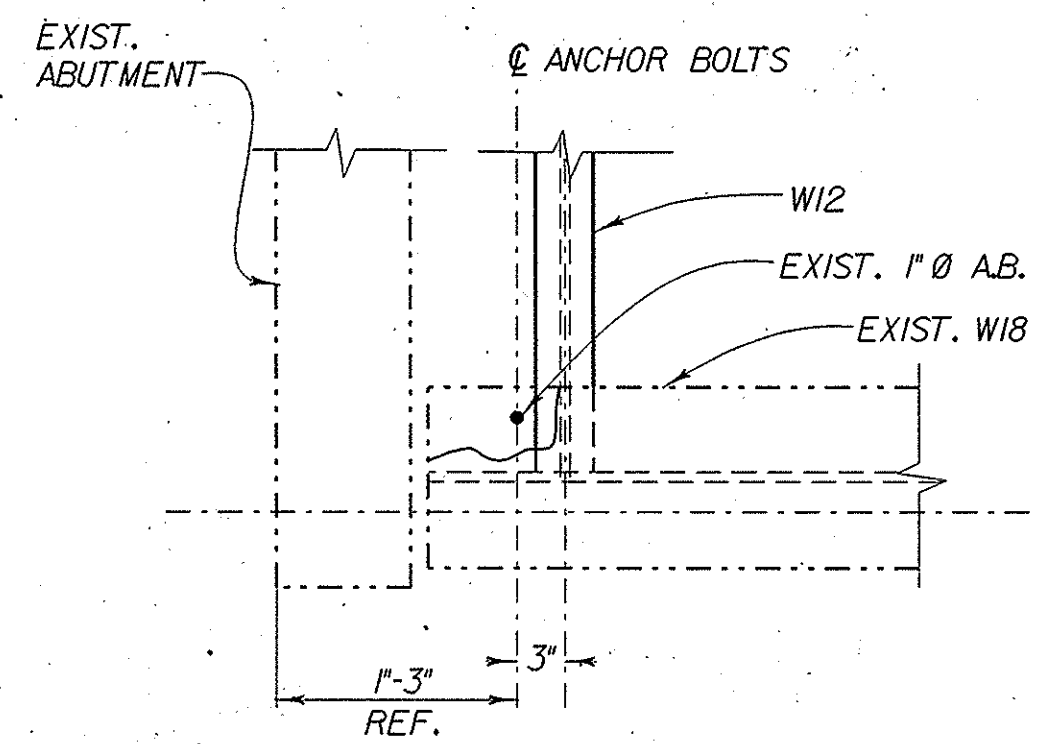


DETAIL 6
SCALE: 1"=1'-0"

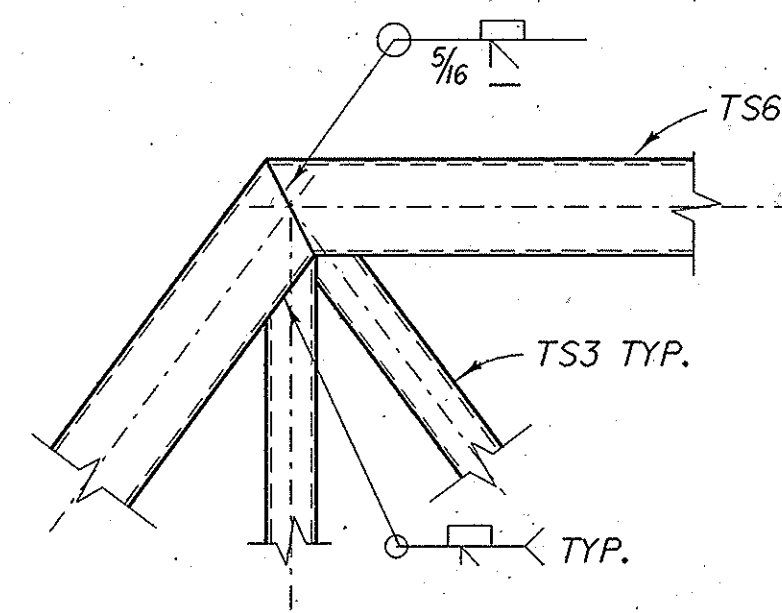


DETAIL 2
SCALE: 1"=1'-0"

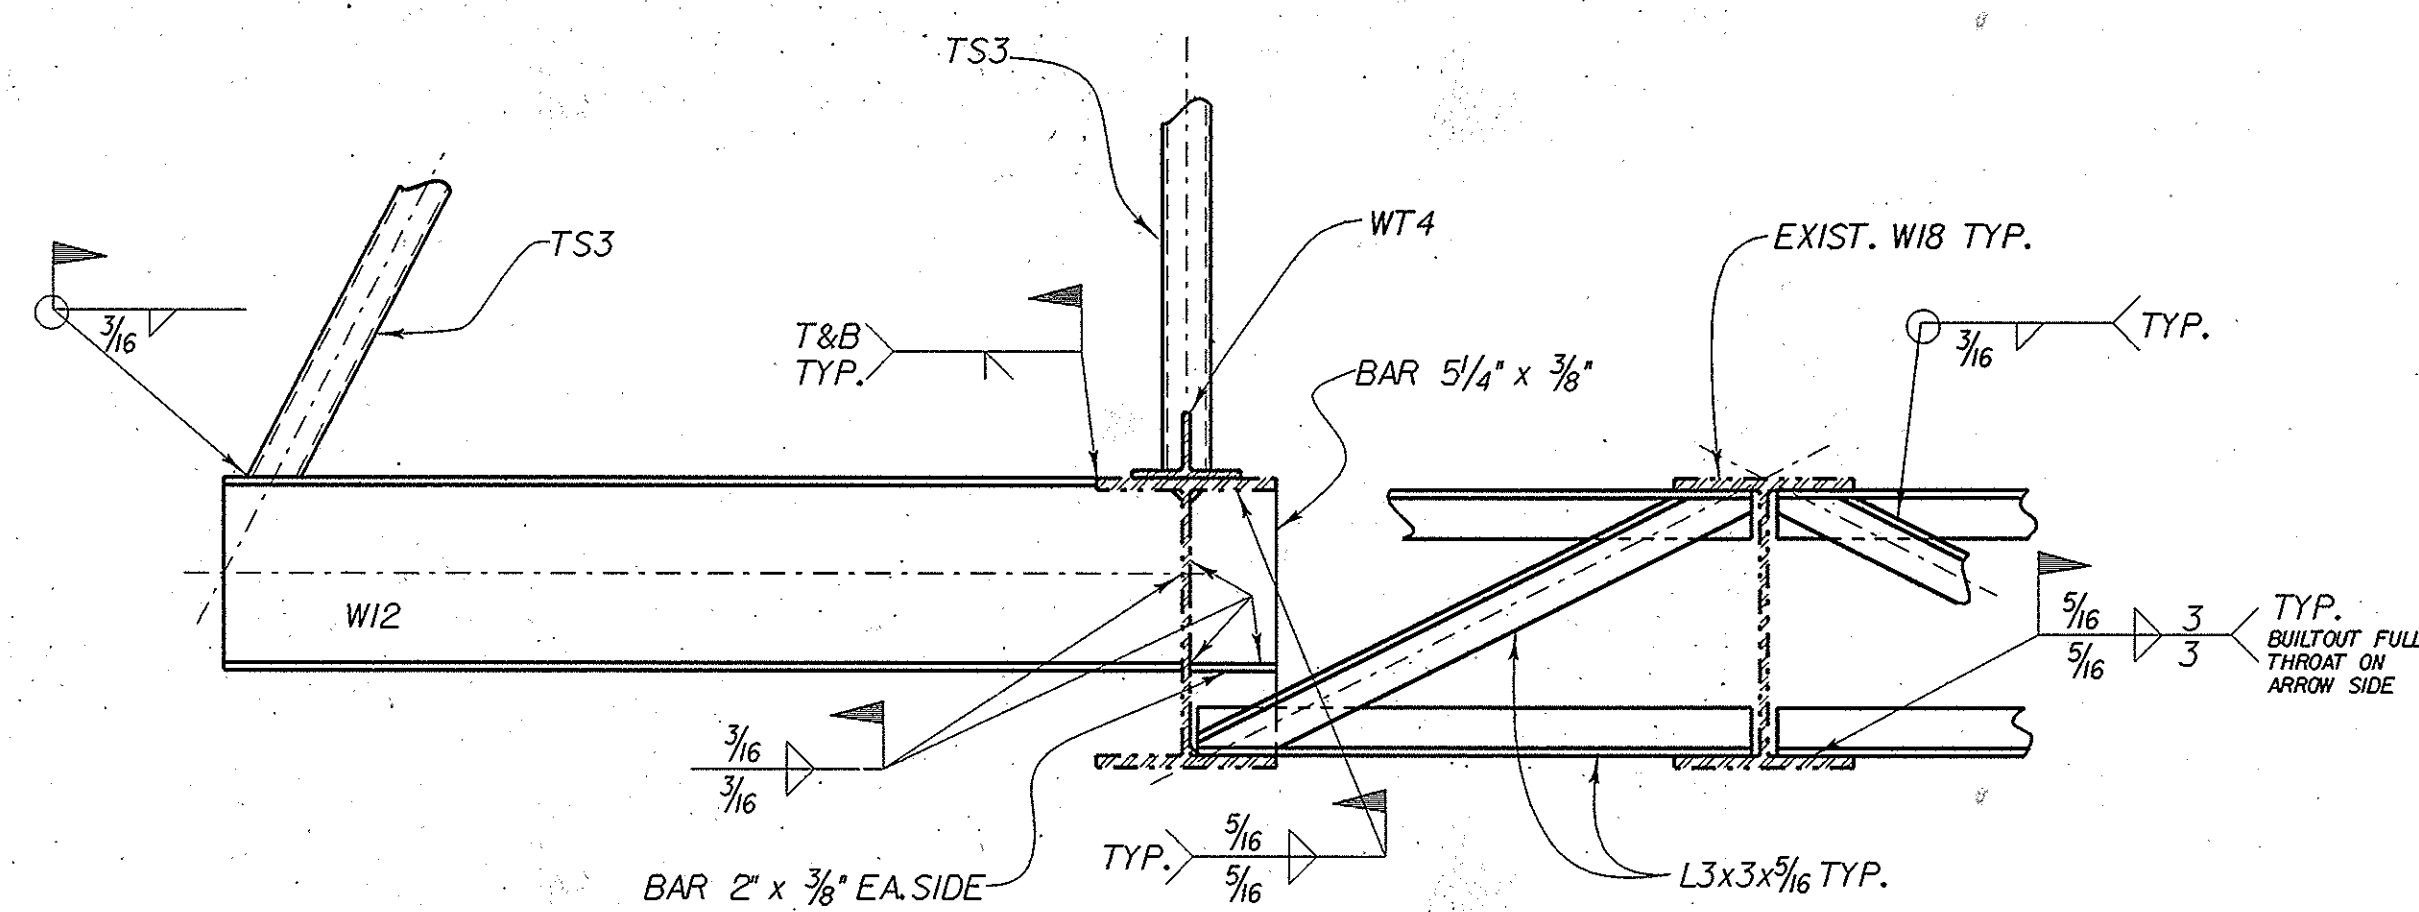


SECTION C
SCALE: 1"=1'-0"

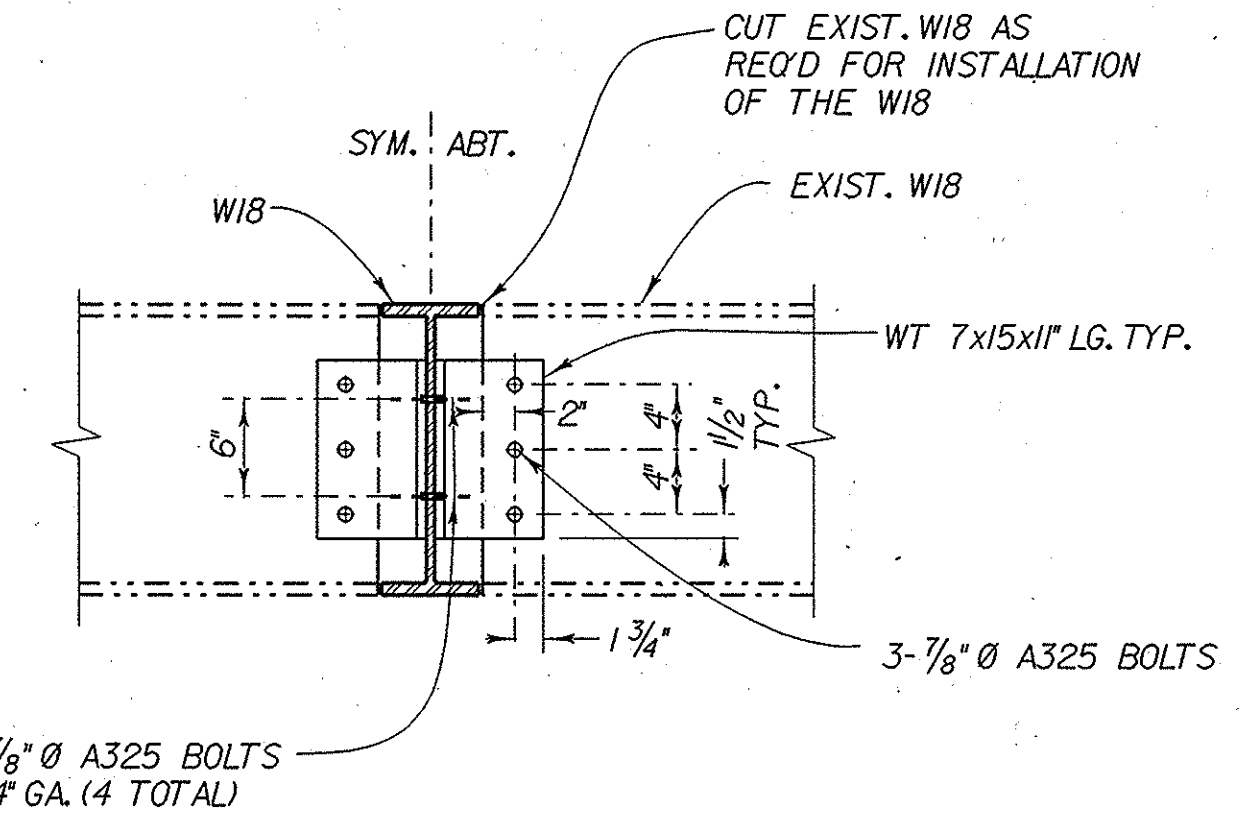


SECTION A
SCALE: 1"=1'-0"

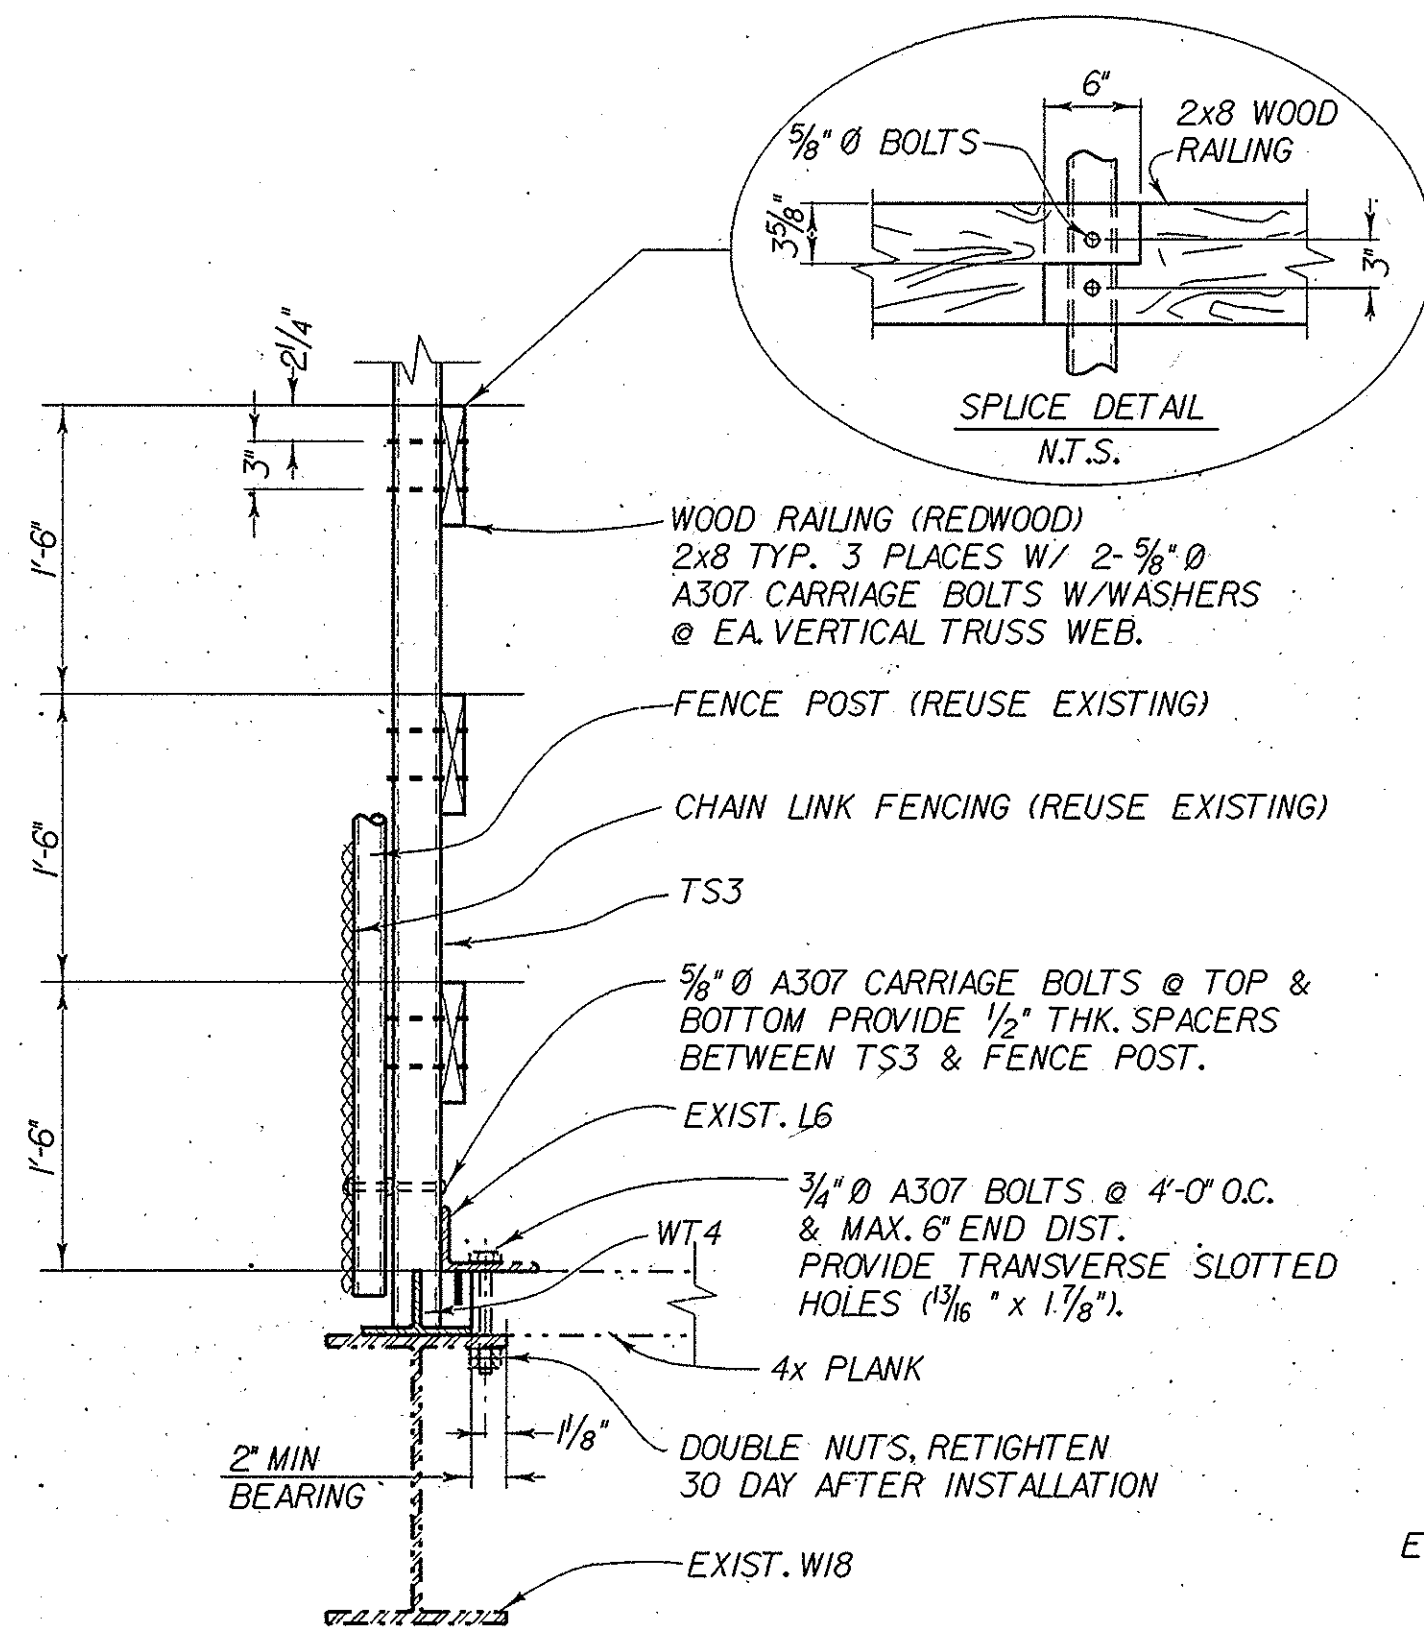


DETAIL 7
SCALE: 1"=1'-0"

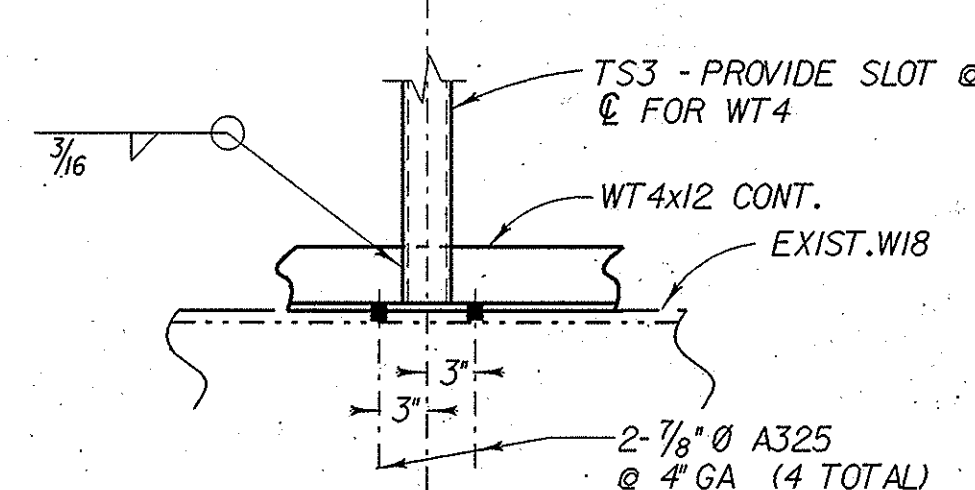


DETAIL 3
SCALE: 1"=1'-0"

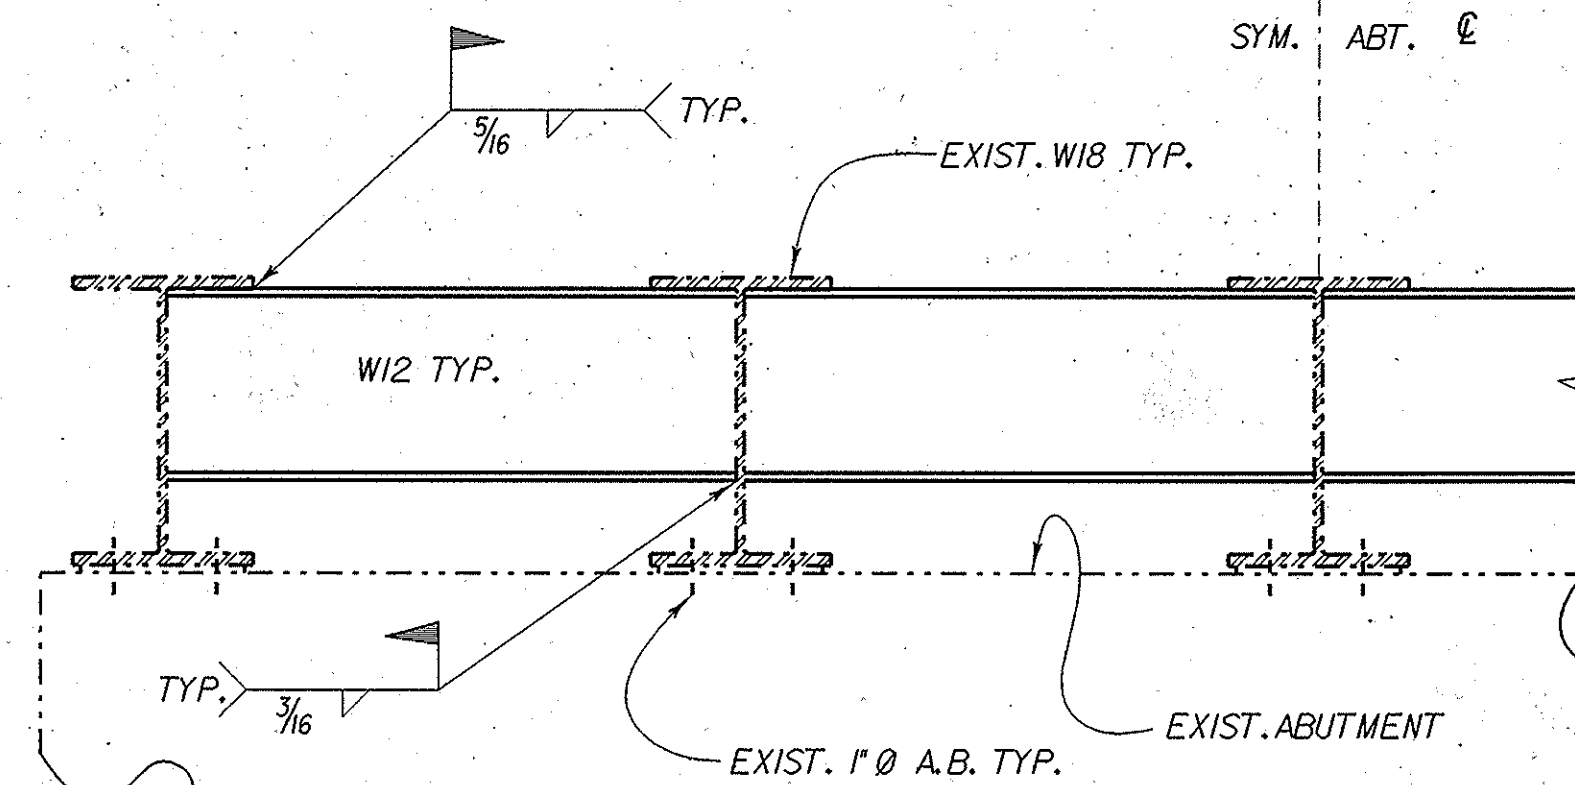


SECTION D
SCALE: 1"=1'-0"

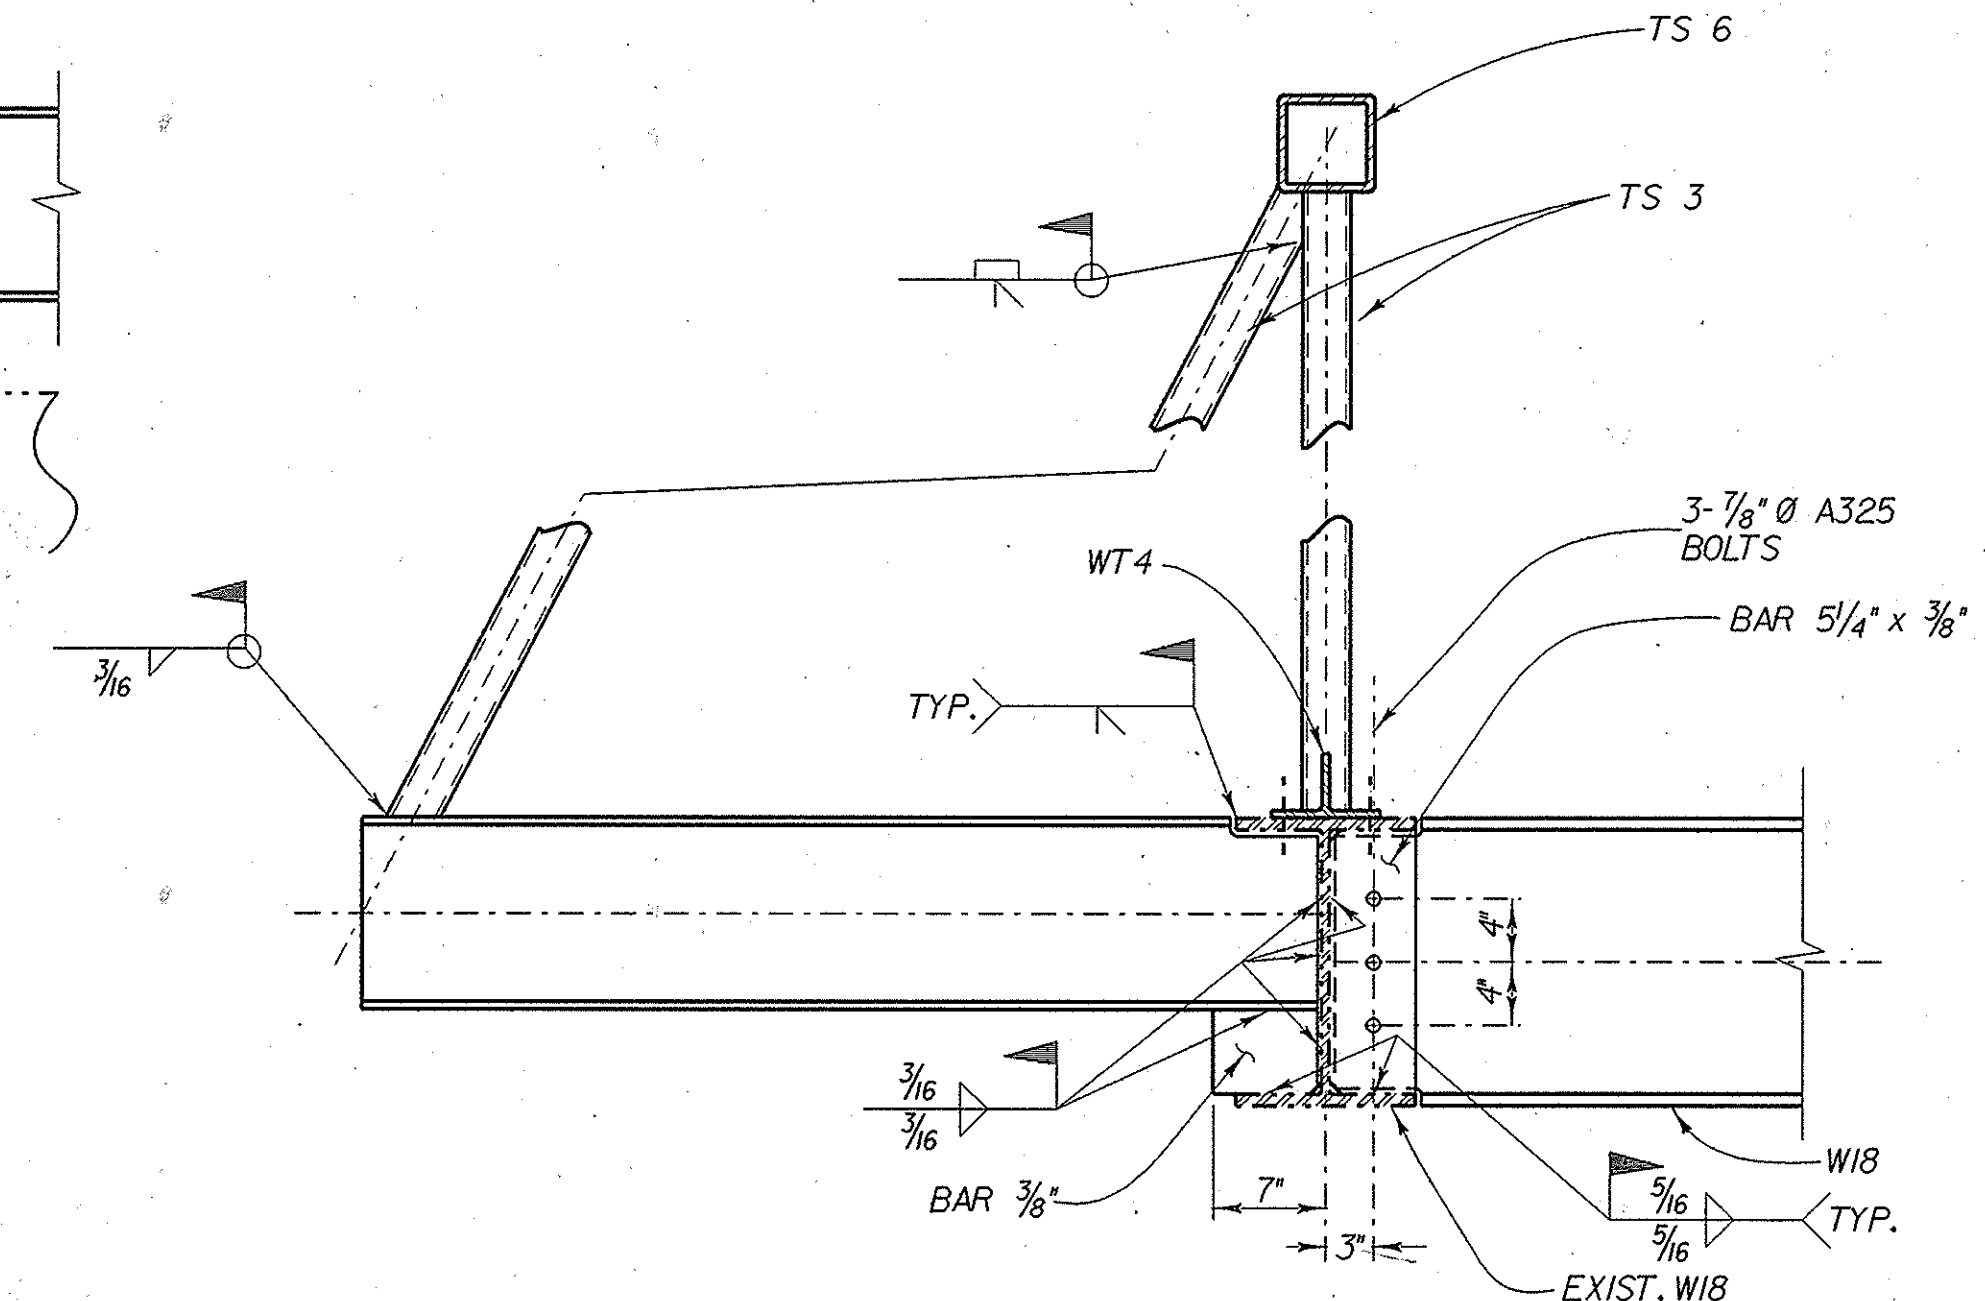


SECTION B
SCALE: 1"=1'-0"

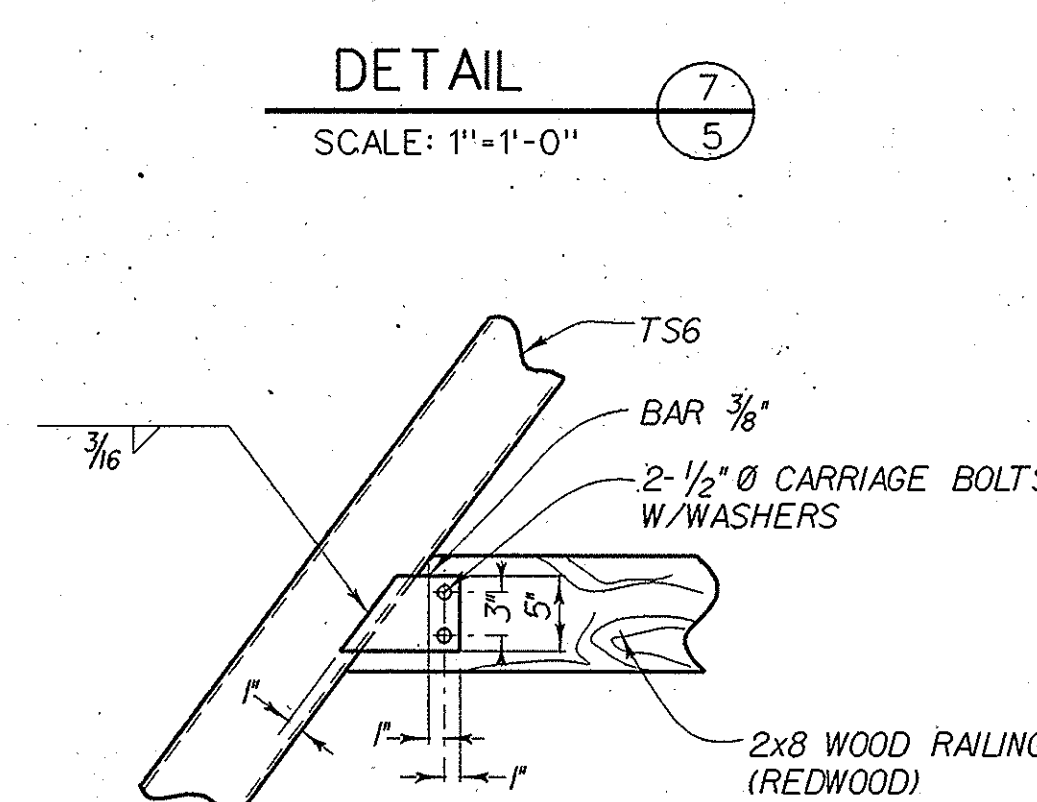


DETAIL 8
SCALE: 1"=1'-0"

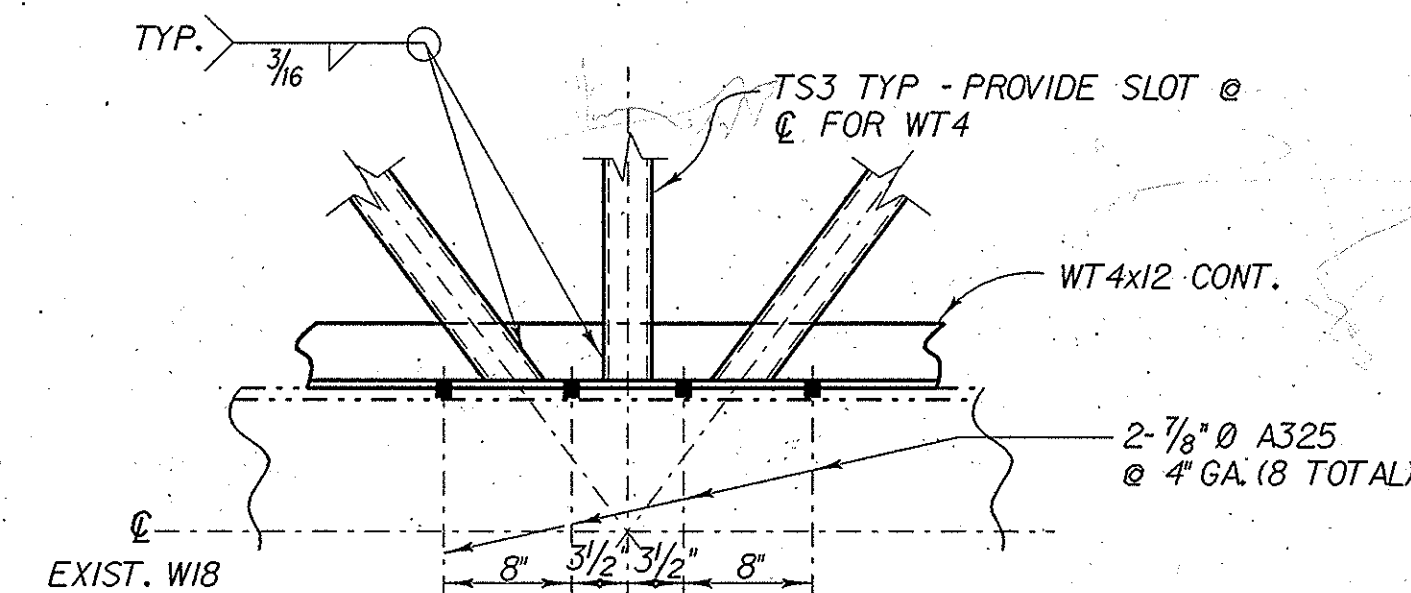


DETAIL 4
SCALE: 1"=1'-0"

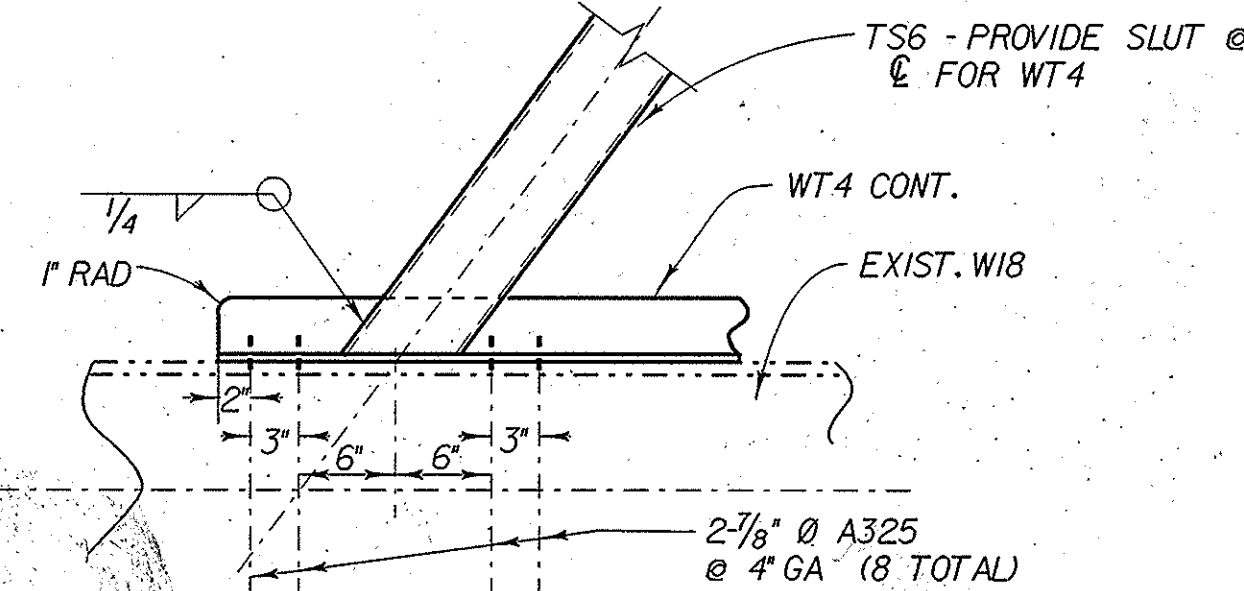

DETAIL 1
SCALE: 1"=1'-0"

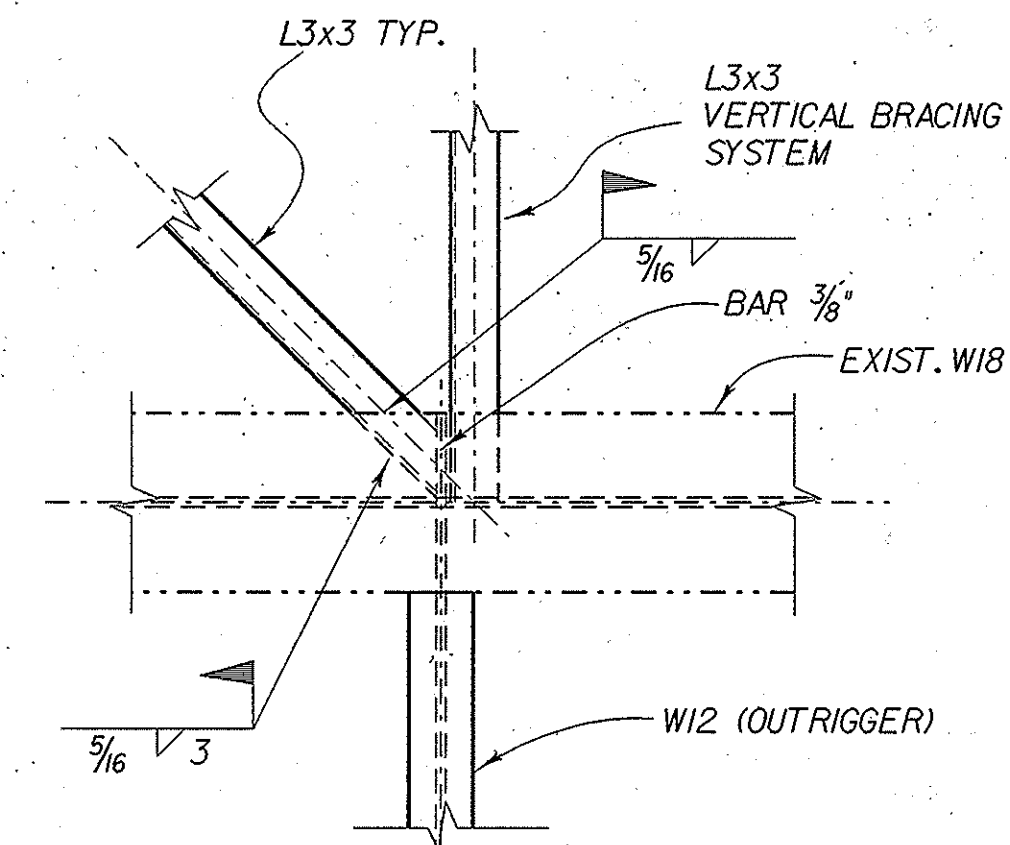

DETAIL 5
SCALE: 1"=1'-0"

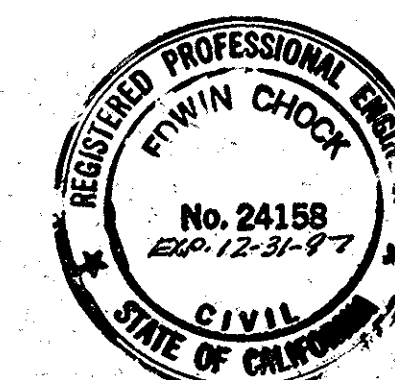

ORANGE COUNTY ENVIRONMENTAL MANAGEMENT AGENCY				GREENVILLE / BANNING CHANNEL	
DETAILS & SECTIONS				SHEET 5 OF 5	
MARK	DATE	DESCRIPTION	PREPARED UNDER	W. O. NO.	DATE
REVISIONS			SUPERVISION OF		
DESIGNED	E. CHOCK	DATE	SCALE	DATE	W. O. NO.
DRAWN	A. MACIEL	CHECKED	AS SHOWN	MAY 95	ER 50472