
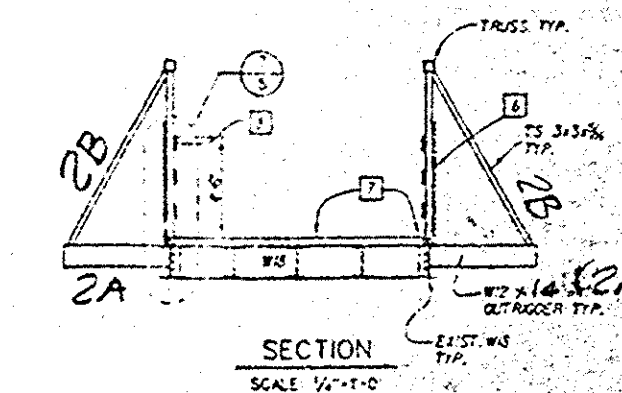


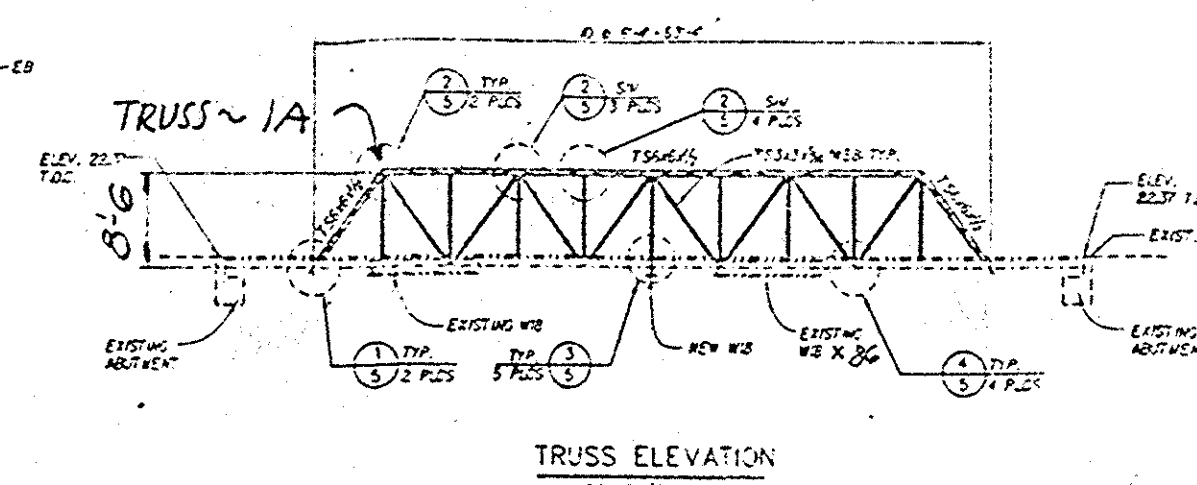



GENERAL NOTES

SERVICE LOAD DESIGN

1. DESIGN BRIDGE DESIGN SPECIFICATIONS
1992 ASDOT AS MODIFIED BY CALTRANS
DEAD LOAD IS AN ADDITIONAL LOAD IMPOSED
FOR FUTURE LOADING
LIVE LOADING IS P.S.F. PEDESTRIAN LOADING
2. STRUCTURAL STEEL STRUCTURAL STEEL - ASTM A50
STRUCTURAL TUBING - ASTM A500
3. BOLTS ASTM A325 - CLASS B UNF
4. TACK WELD THE MIT TO THE BOLT AFTER INSTALLATION
5. CENTERLINE OF THE ANGLES AS SHOWN OF THE PLAN
SHALL BE THE CASE LINE OF THE ANGLE


CONSTRUCTION NOTES

- 6 REMOVE EXISTING CHAIN LINK FENCE ALONG BRIDGE AND
REINSTALL AFTER COMPLETION OF THE TRUSS.
SEE DETAIL: (1)
- 7 REMOVE EXISTING AT FLOOD PLANKS AND FENCE AND
CLAMP, WOODY AND REINSTALL PER DETAIL: (1)
- 8 WOOD HANDRAIL SEE DETAIL: (1) & (2)
- 9 PROTECT EXISTING FENCE POSTS IN PLACE.
- 10 PROTECT EXISTING ABUTMENT IN PLACE.
- 11 PROTECT EXISTING ABUTMENT AND/OR SOILS
DURING CONSTRUCTION.
- 12 PROTECT EXISTING CHAIN LINK FENCE IN PLACE.

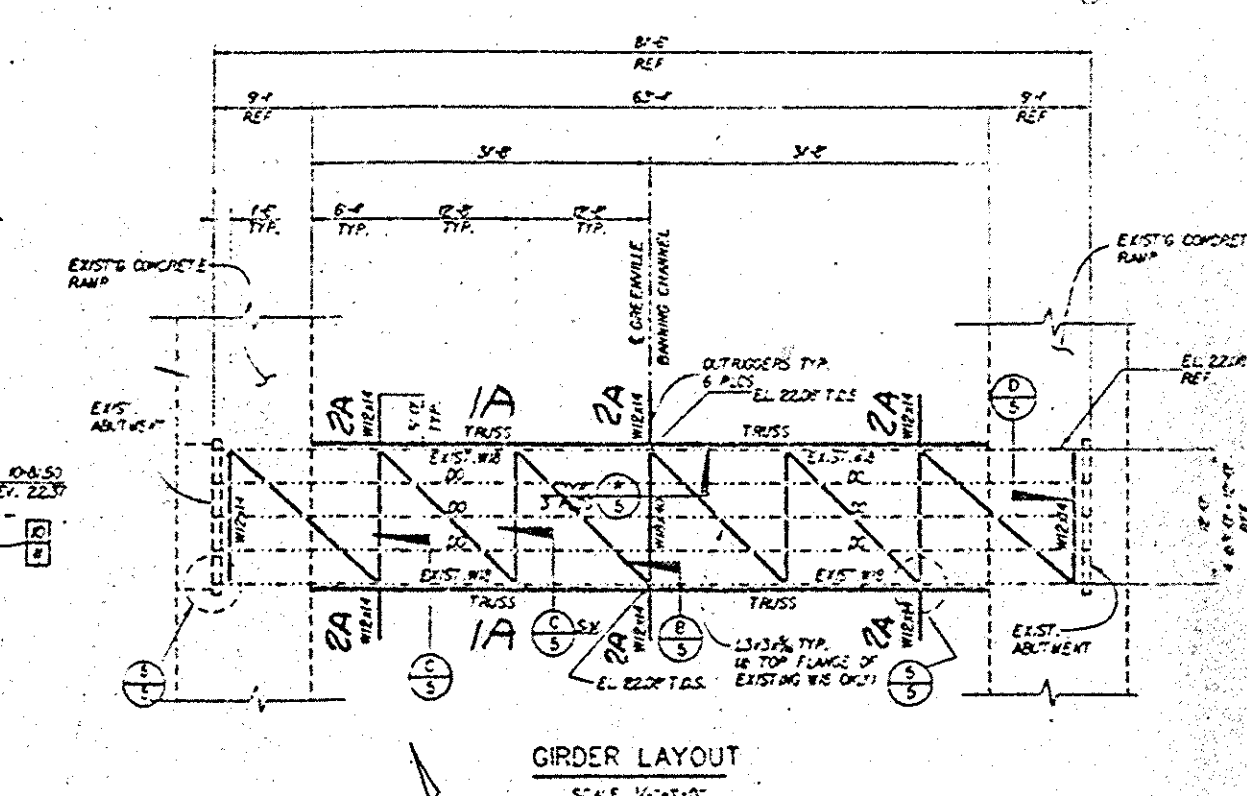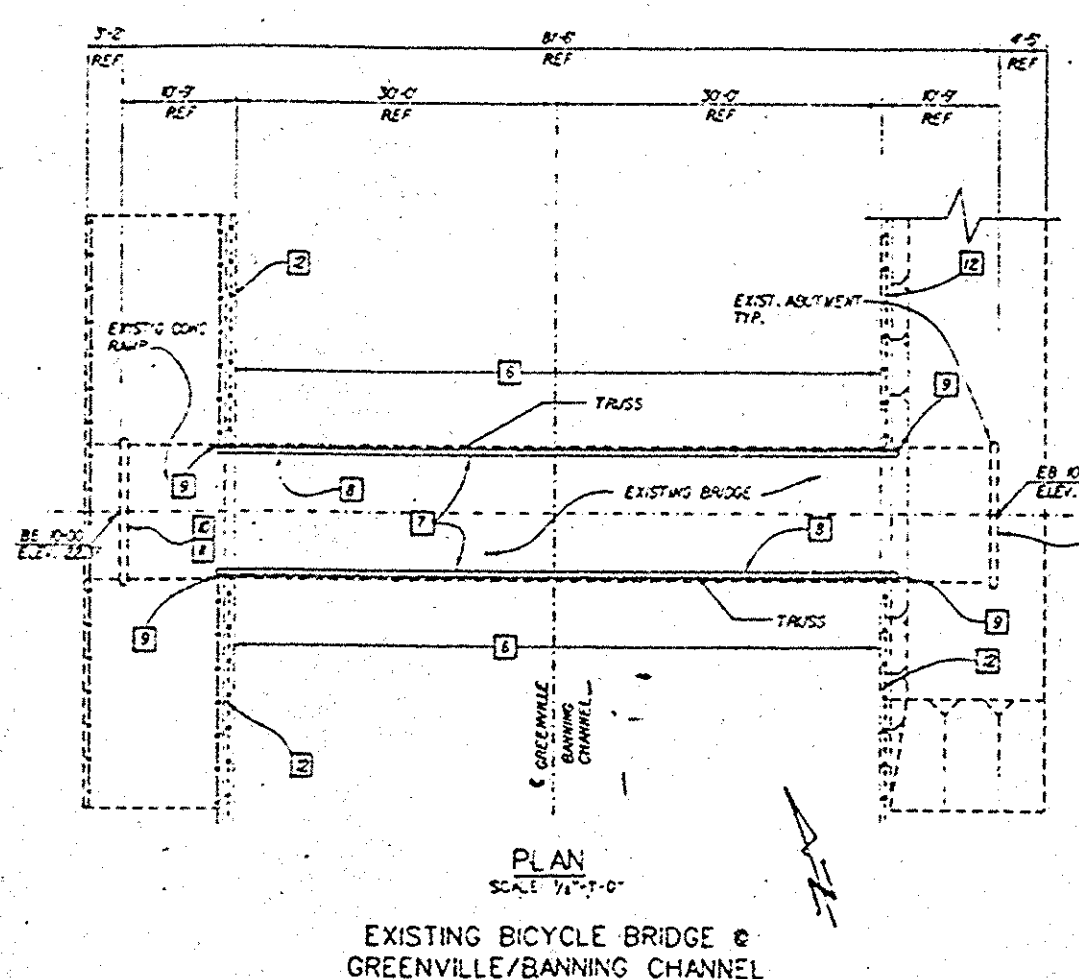

NOTE:
THE CONTRACTOR SHALL VERIFY ALL
CONTROLLING FIELD DIMENSIONS & CONDITIONS
PRIOR TO START THE WORK.

QUANTITIES	
1. WOODY EXISTING CHAIN LINK FENCE	11500
2. WOODY EXISTING WOOD PLANKS	41
3. CLEANING AND PAINTING STRUCTURAL STEEL	1
4. FURNISH STRUCTURAL STEEL	115000
5. ERECTING STRUCTURAL STEEL	115000
6. WOODY EXISTING BRIDGE GULCHES	1
7. WOODY BURNING	80

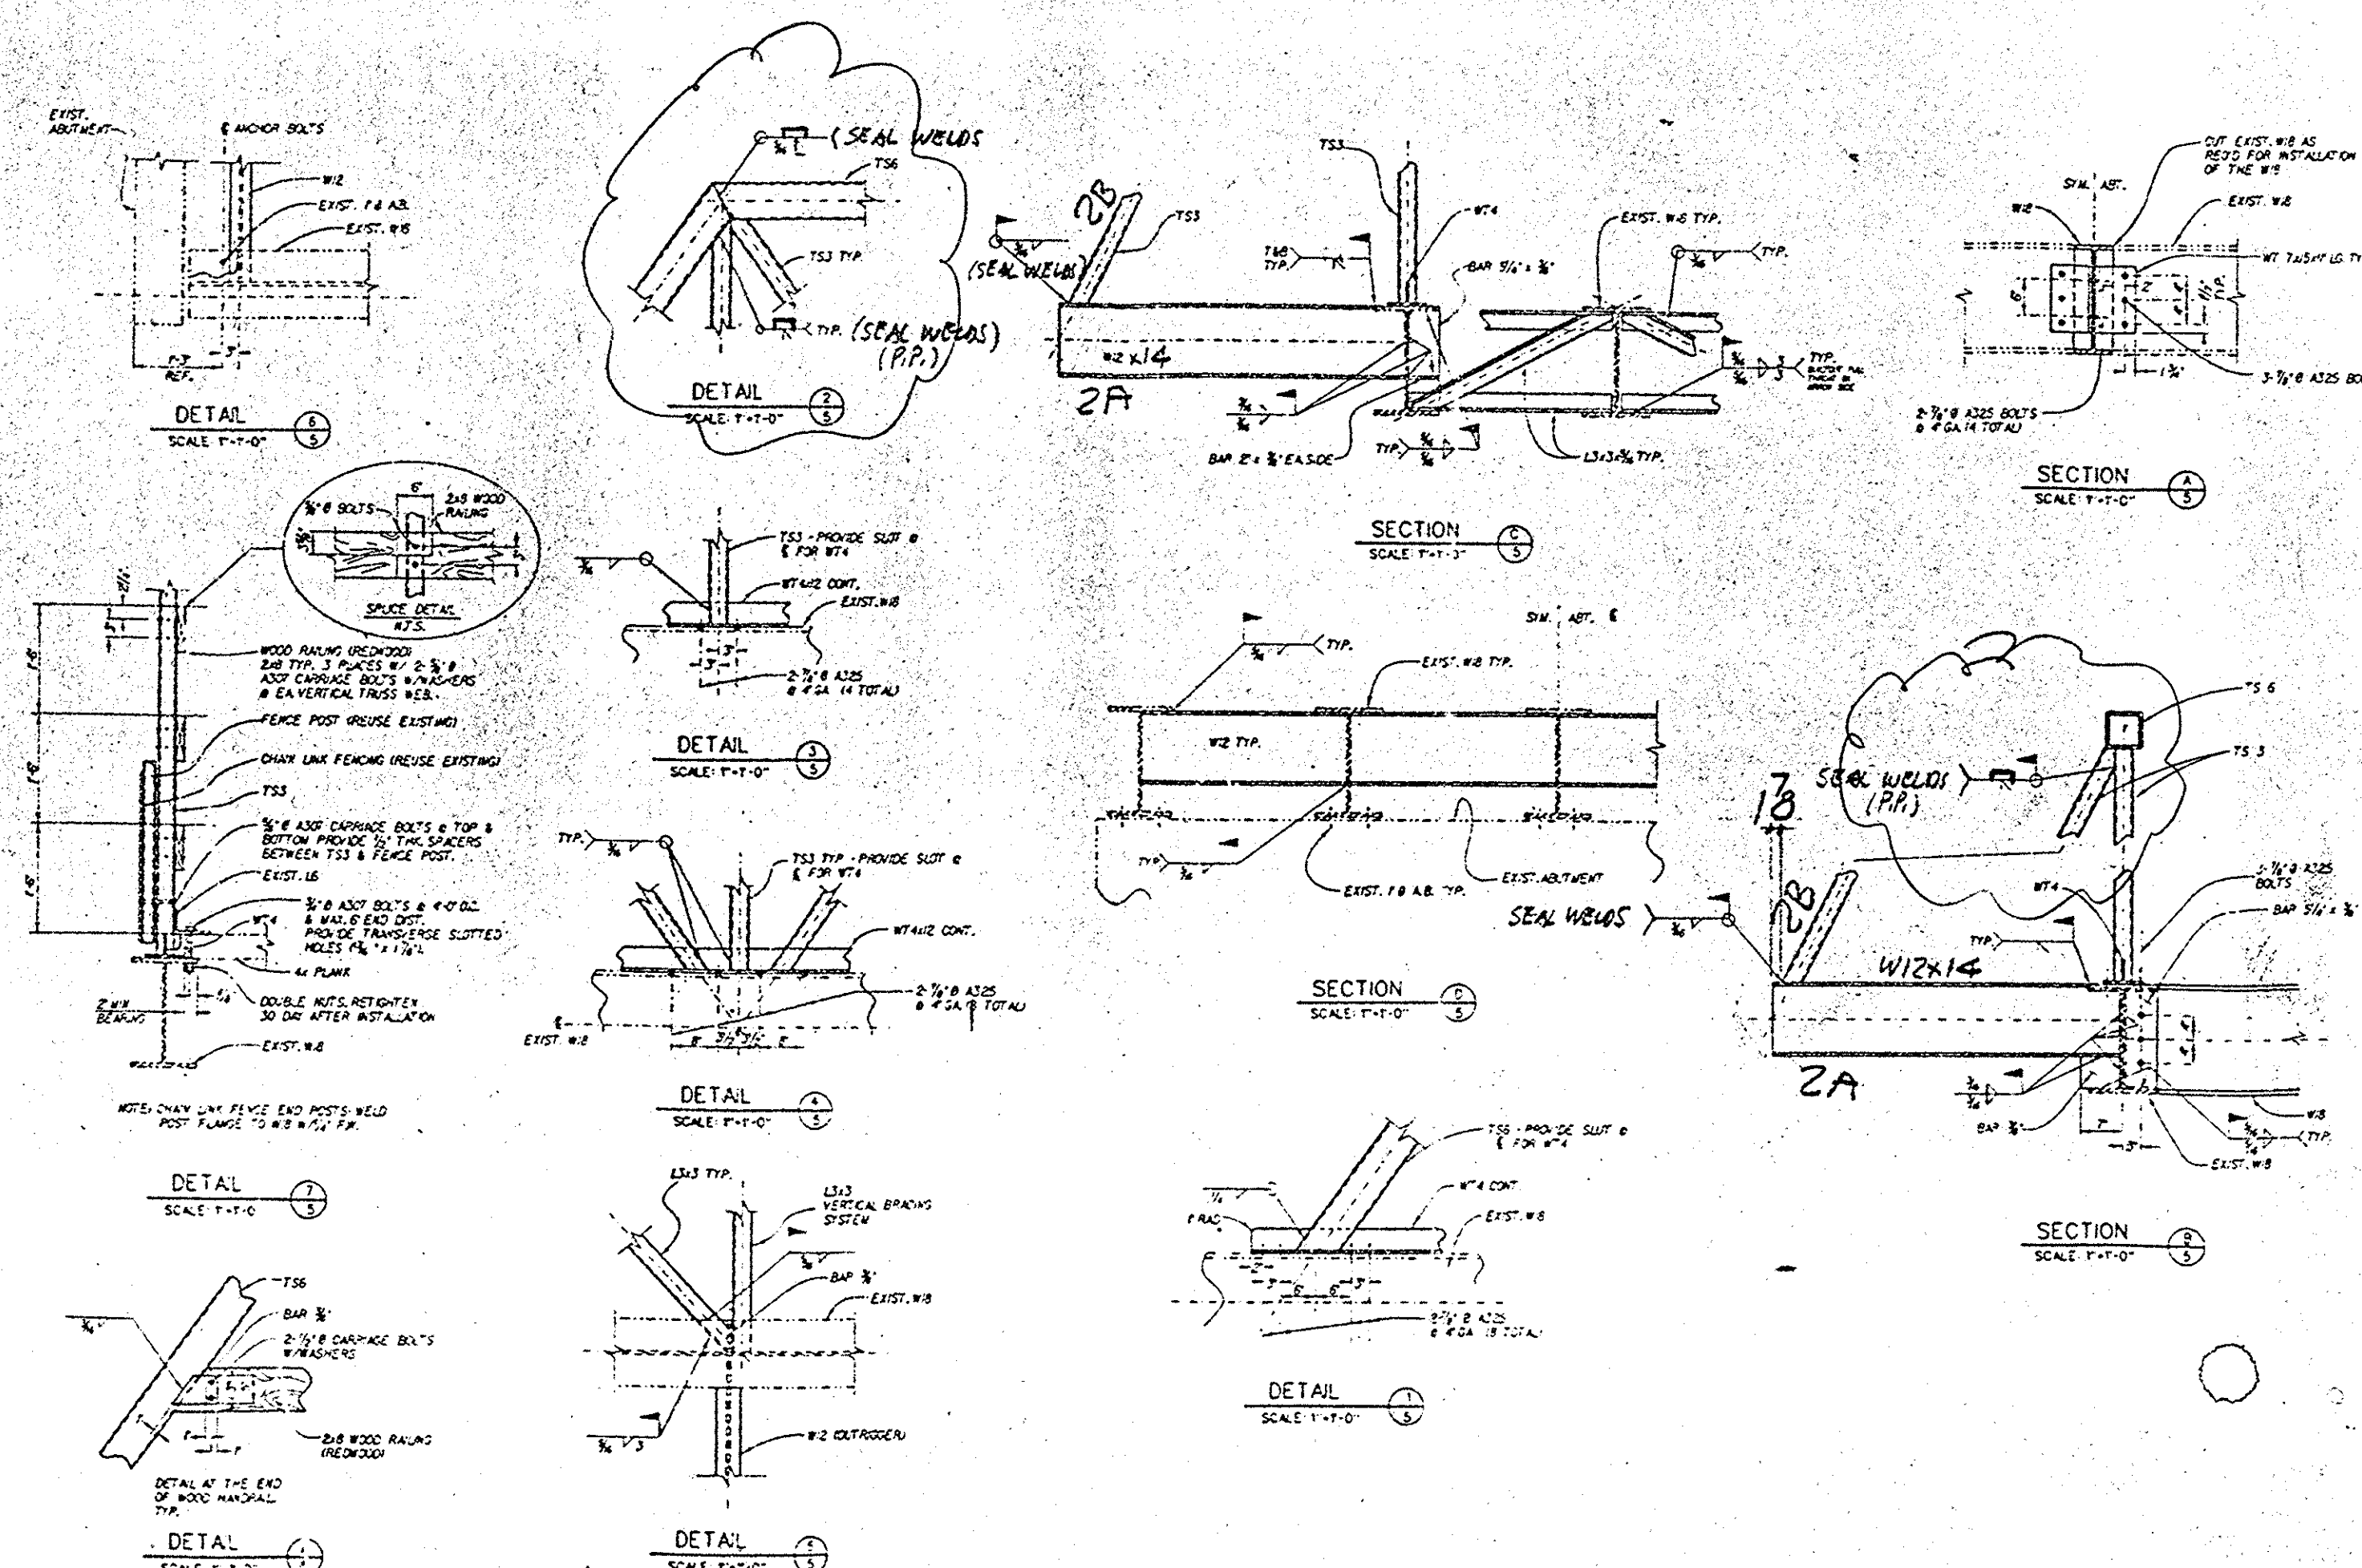

FIELD MEASURE ALL DIMS
1 ELEVS BEFORE FALS

NOTE:

1. FIELD MEASURE, FIELD CUT & FIT
ALL REQUIRED STIFF PIS, & BRACES
W/BACK LATERAL BMS, RAIL HOLES
SHOCK PIS & OTHER MISC PIECES
2. SEE SHT 1 FOR TRUSS DETAILS
3. SEE SHT 2 FOR OUTRIGGER BMS & BRACES

OK w/ NOTED ADDITIONS
SDV 3/13/96
OCENA/PW/CONST.

R SHEET SHOP
DRAWINGS
2/3

		BLUE PRINT RECORD			
		NO.	DATE FOR		
BOLTS		UNLESS NOTED	REVISIONS		
			NO.	DATE DESCRIPTION	
OPEN HOLES			①	11/21	ADD NOTE
EDGE DIST			②	11/3	ADD 30 T
PAINT			③	2/7	REDO J
BRIDGE DETAILS					

COORG CONTRACTORS ENGINEERS		Phone: (310) 598-9121 FAX: (310) 598-5011 P.O. Box 449, Los Alamitos, CA 90720	
PROJECT		BRIDGE RETROFIT GREEN VILLE / BANKING CHANNEL COSTA MESA CALIF	
ARCHT	OCCEMA	CONTRACTOR:	
ENG	EDWIN CHOCK		COORG CORP
DWN BY		SHEET	E/3
CHK BY	OK	DATE	
		DATE	