

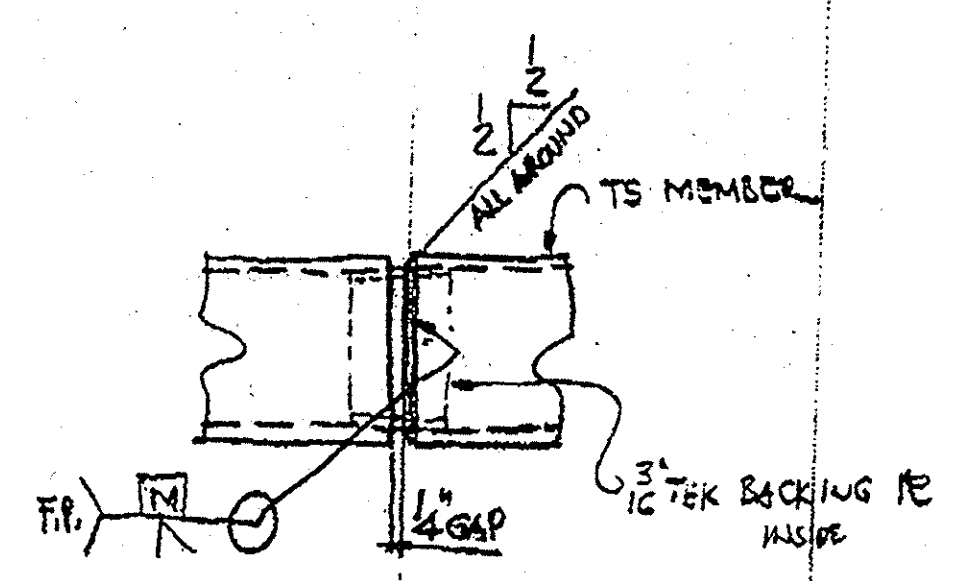


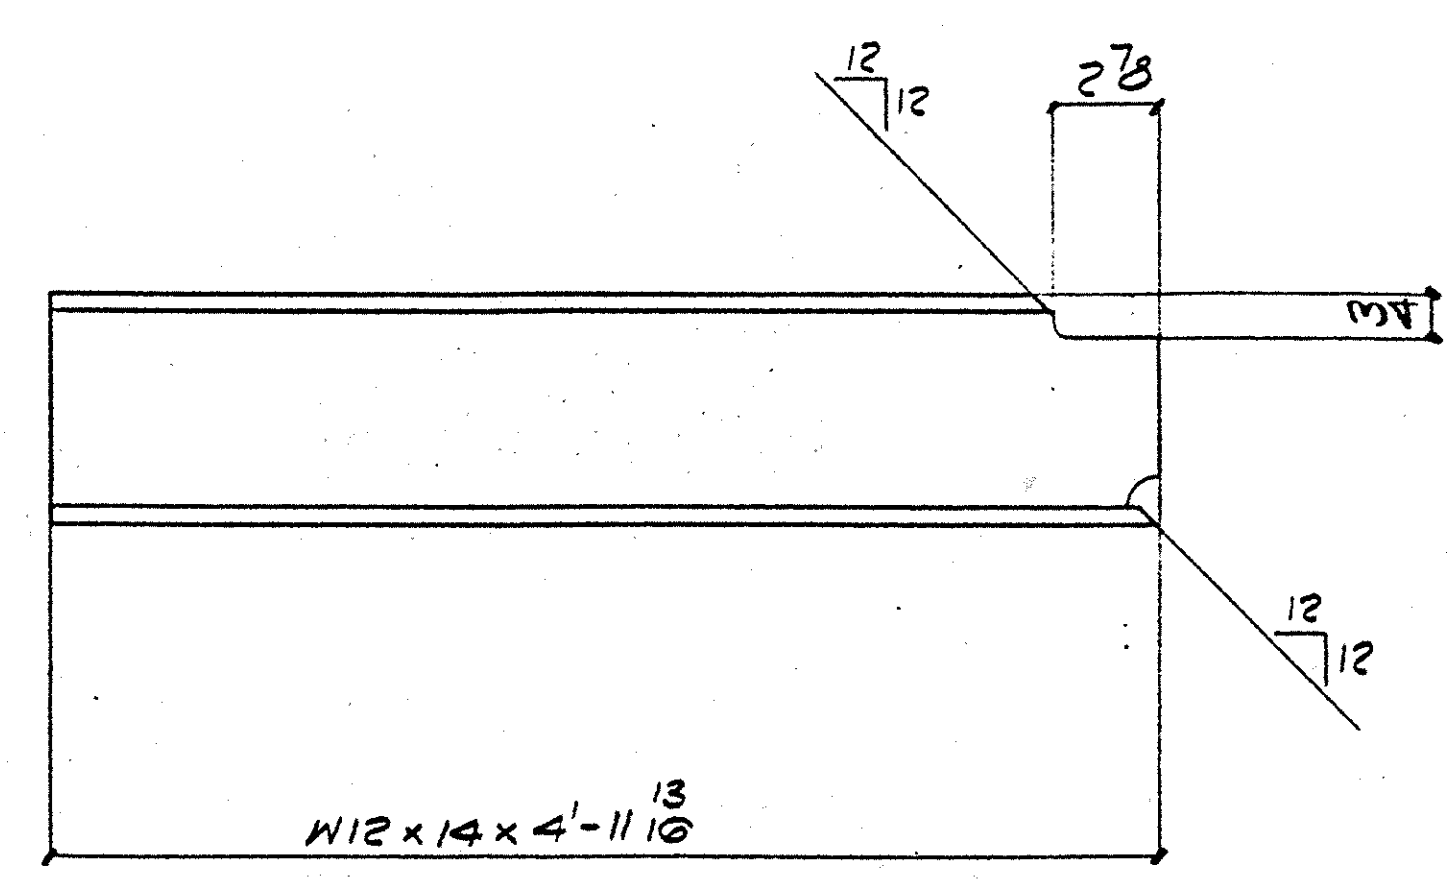


TYPE SPLICE DETAIL

[illegible]

G - OUTRIGGER BEAMS - 2A

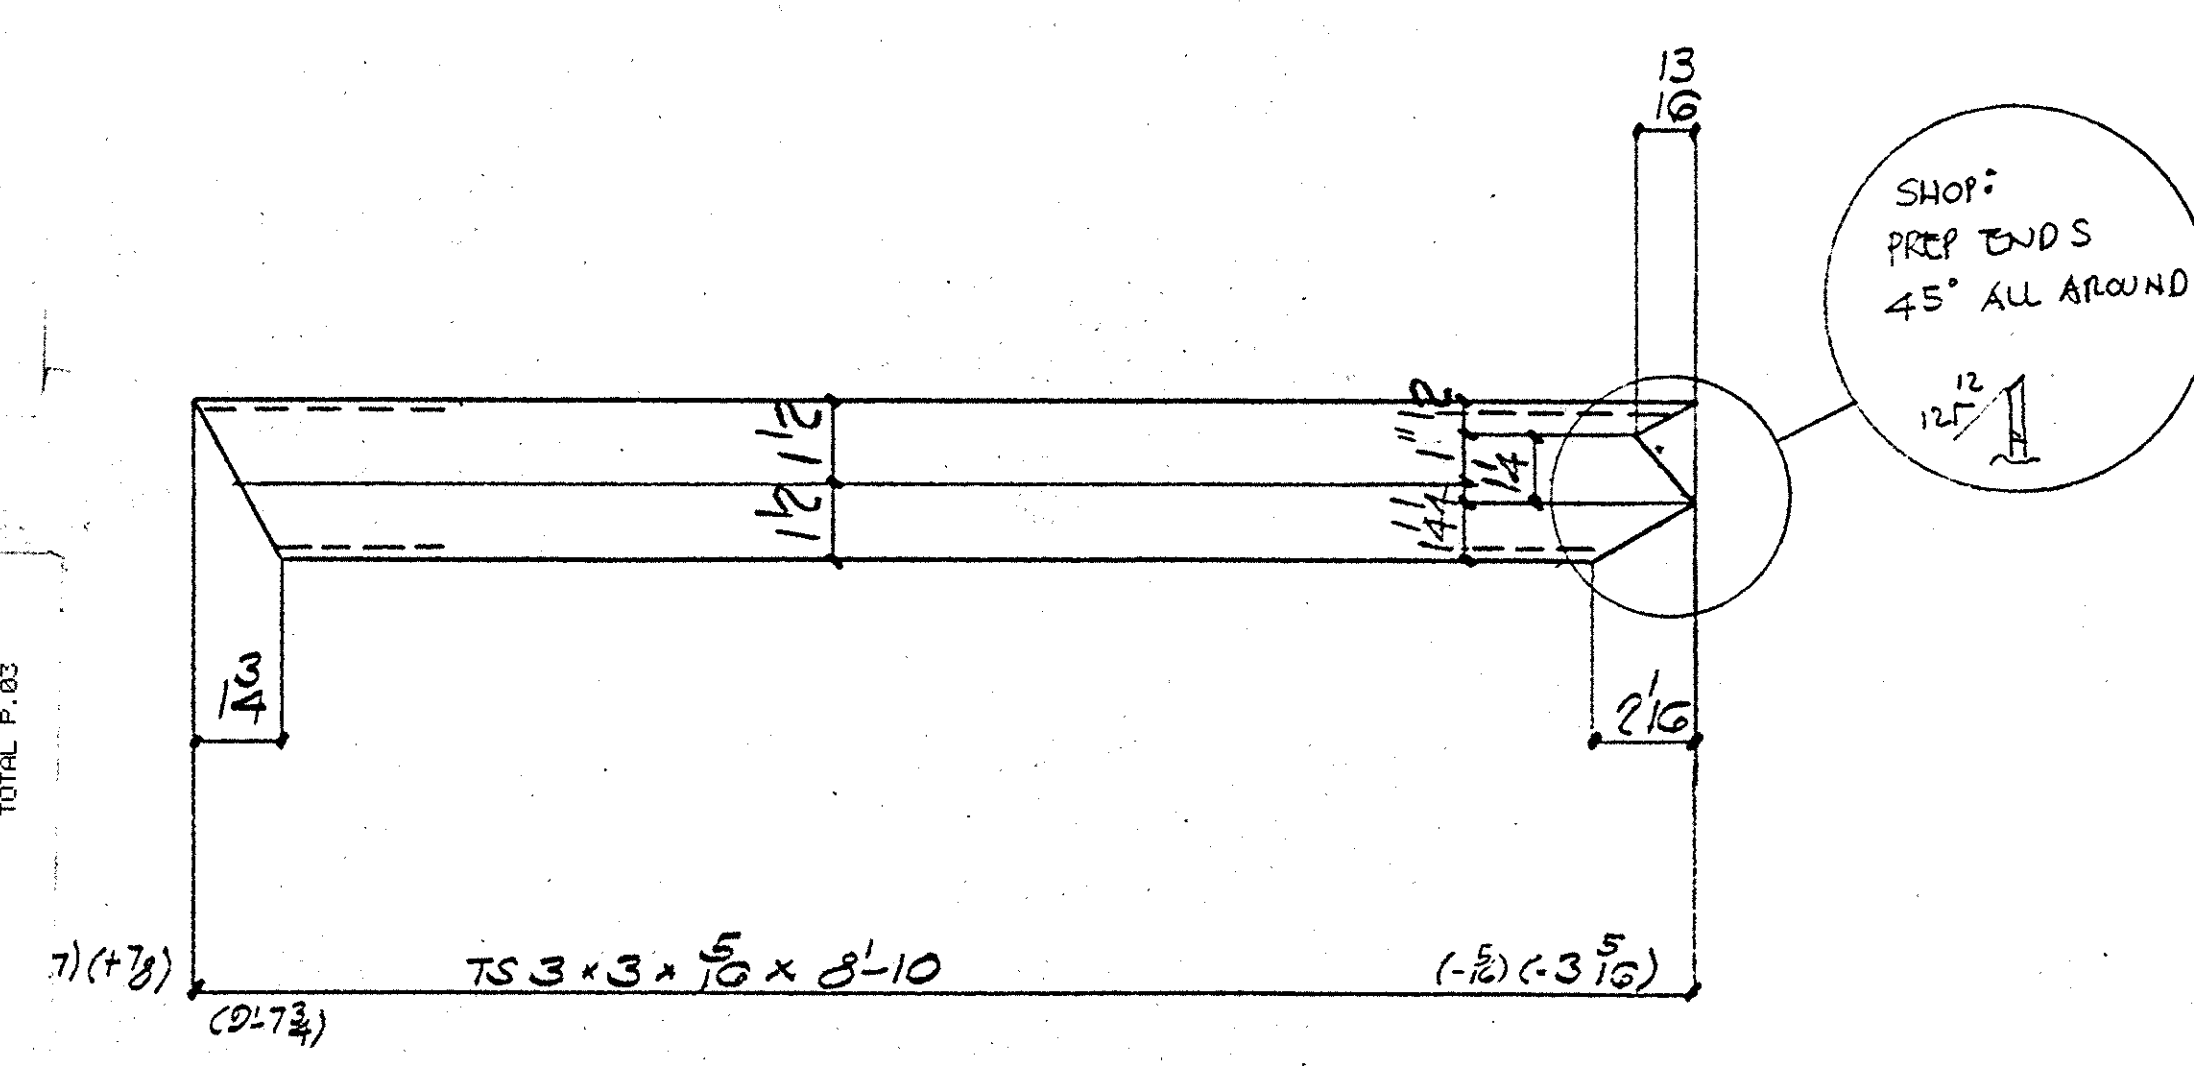

G - BRACES - 2B

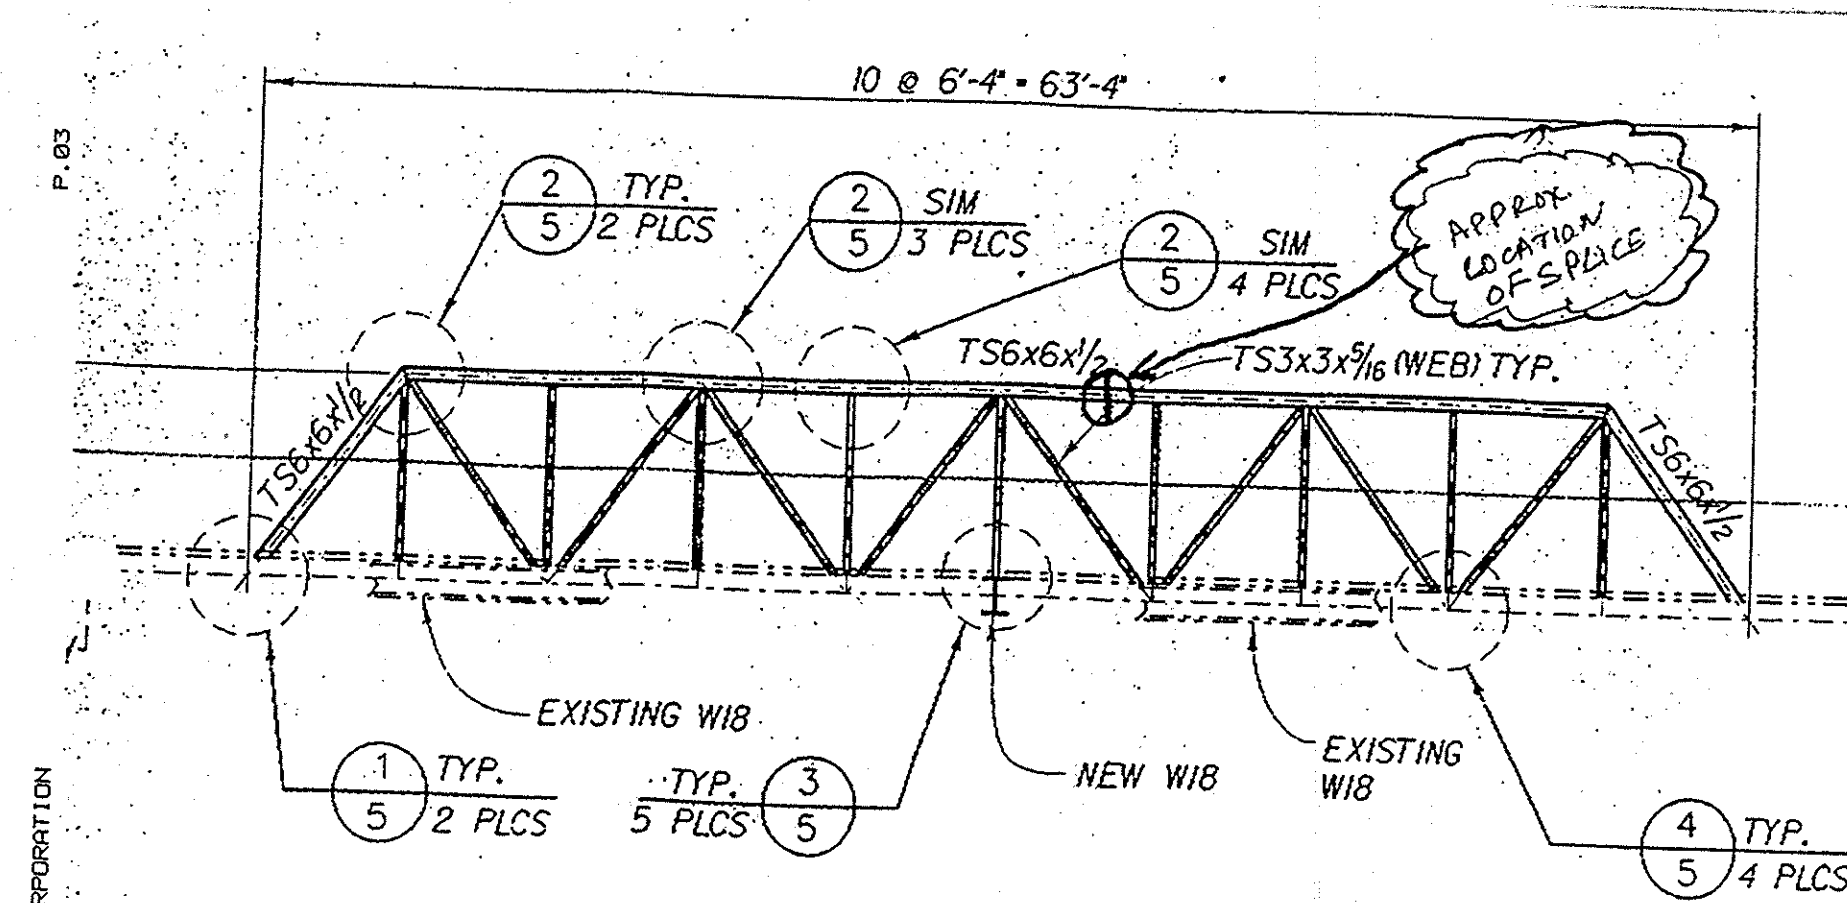

TRUSS ELEVATION

SCALE: 1/8"=1'-0"

[illegible][illegible]

BOLTS	UNLESS NOTED	REVISIONS	
		NO. DATE	DESCRIPTION
OPEN HOLES		1 1/13	APP'D SC7
EDGE DIST		2 2/7	C/
FAINT <i>FANTED PCM STCS</i>			
<i>OUTRIGGER BMS & BRACES</i>			

COORG

Phone: (310) 598-9121

**CONTRACTORS
ENGINEERS** Phone: (310) 598-9121
FAX: (310) 598-5011
P.O. Box 448, Los Alamitos, CA 91750

BRIDGE RETROFIT

PROJECT BRIDGE (BTRUPT)
GREENVILLE / BANNING CHANNEL
COSTA MESA, CALIF

ARCHT OCEMA		CONTRACTOR:	
ENG EDWIN CHOCK		COORG CORP	
DWN BY CSC	DATE 12-95	SMLET 2	JOE 9510
CHK BY OK	DATE	NO. 2	NO.

△ SHOP
DRAWINGS
3/3

(REF: E1)