


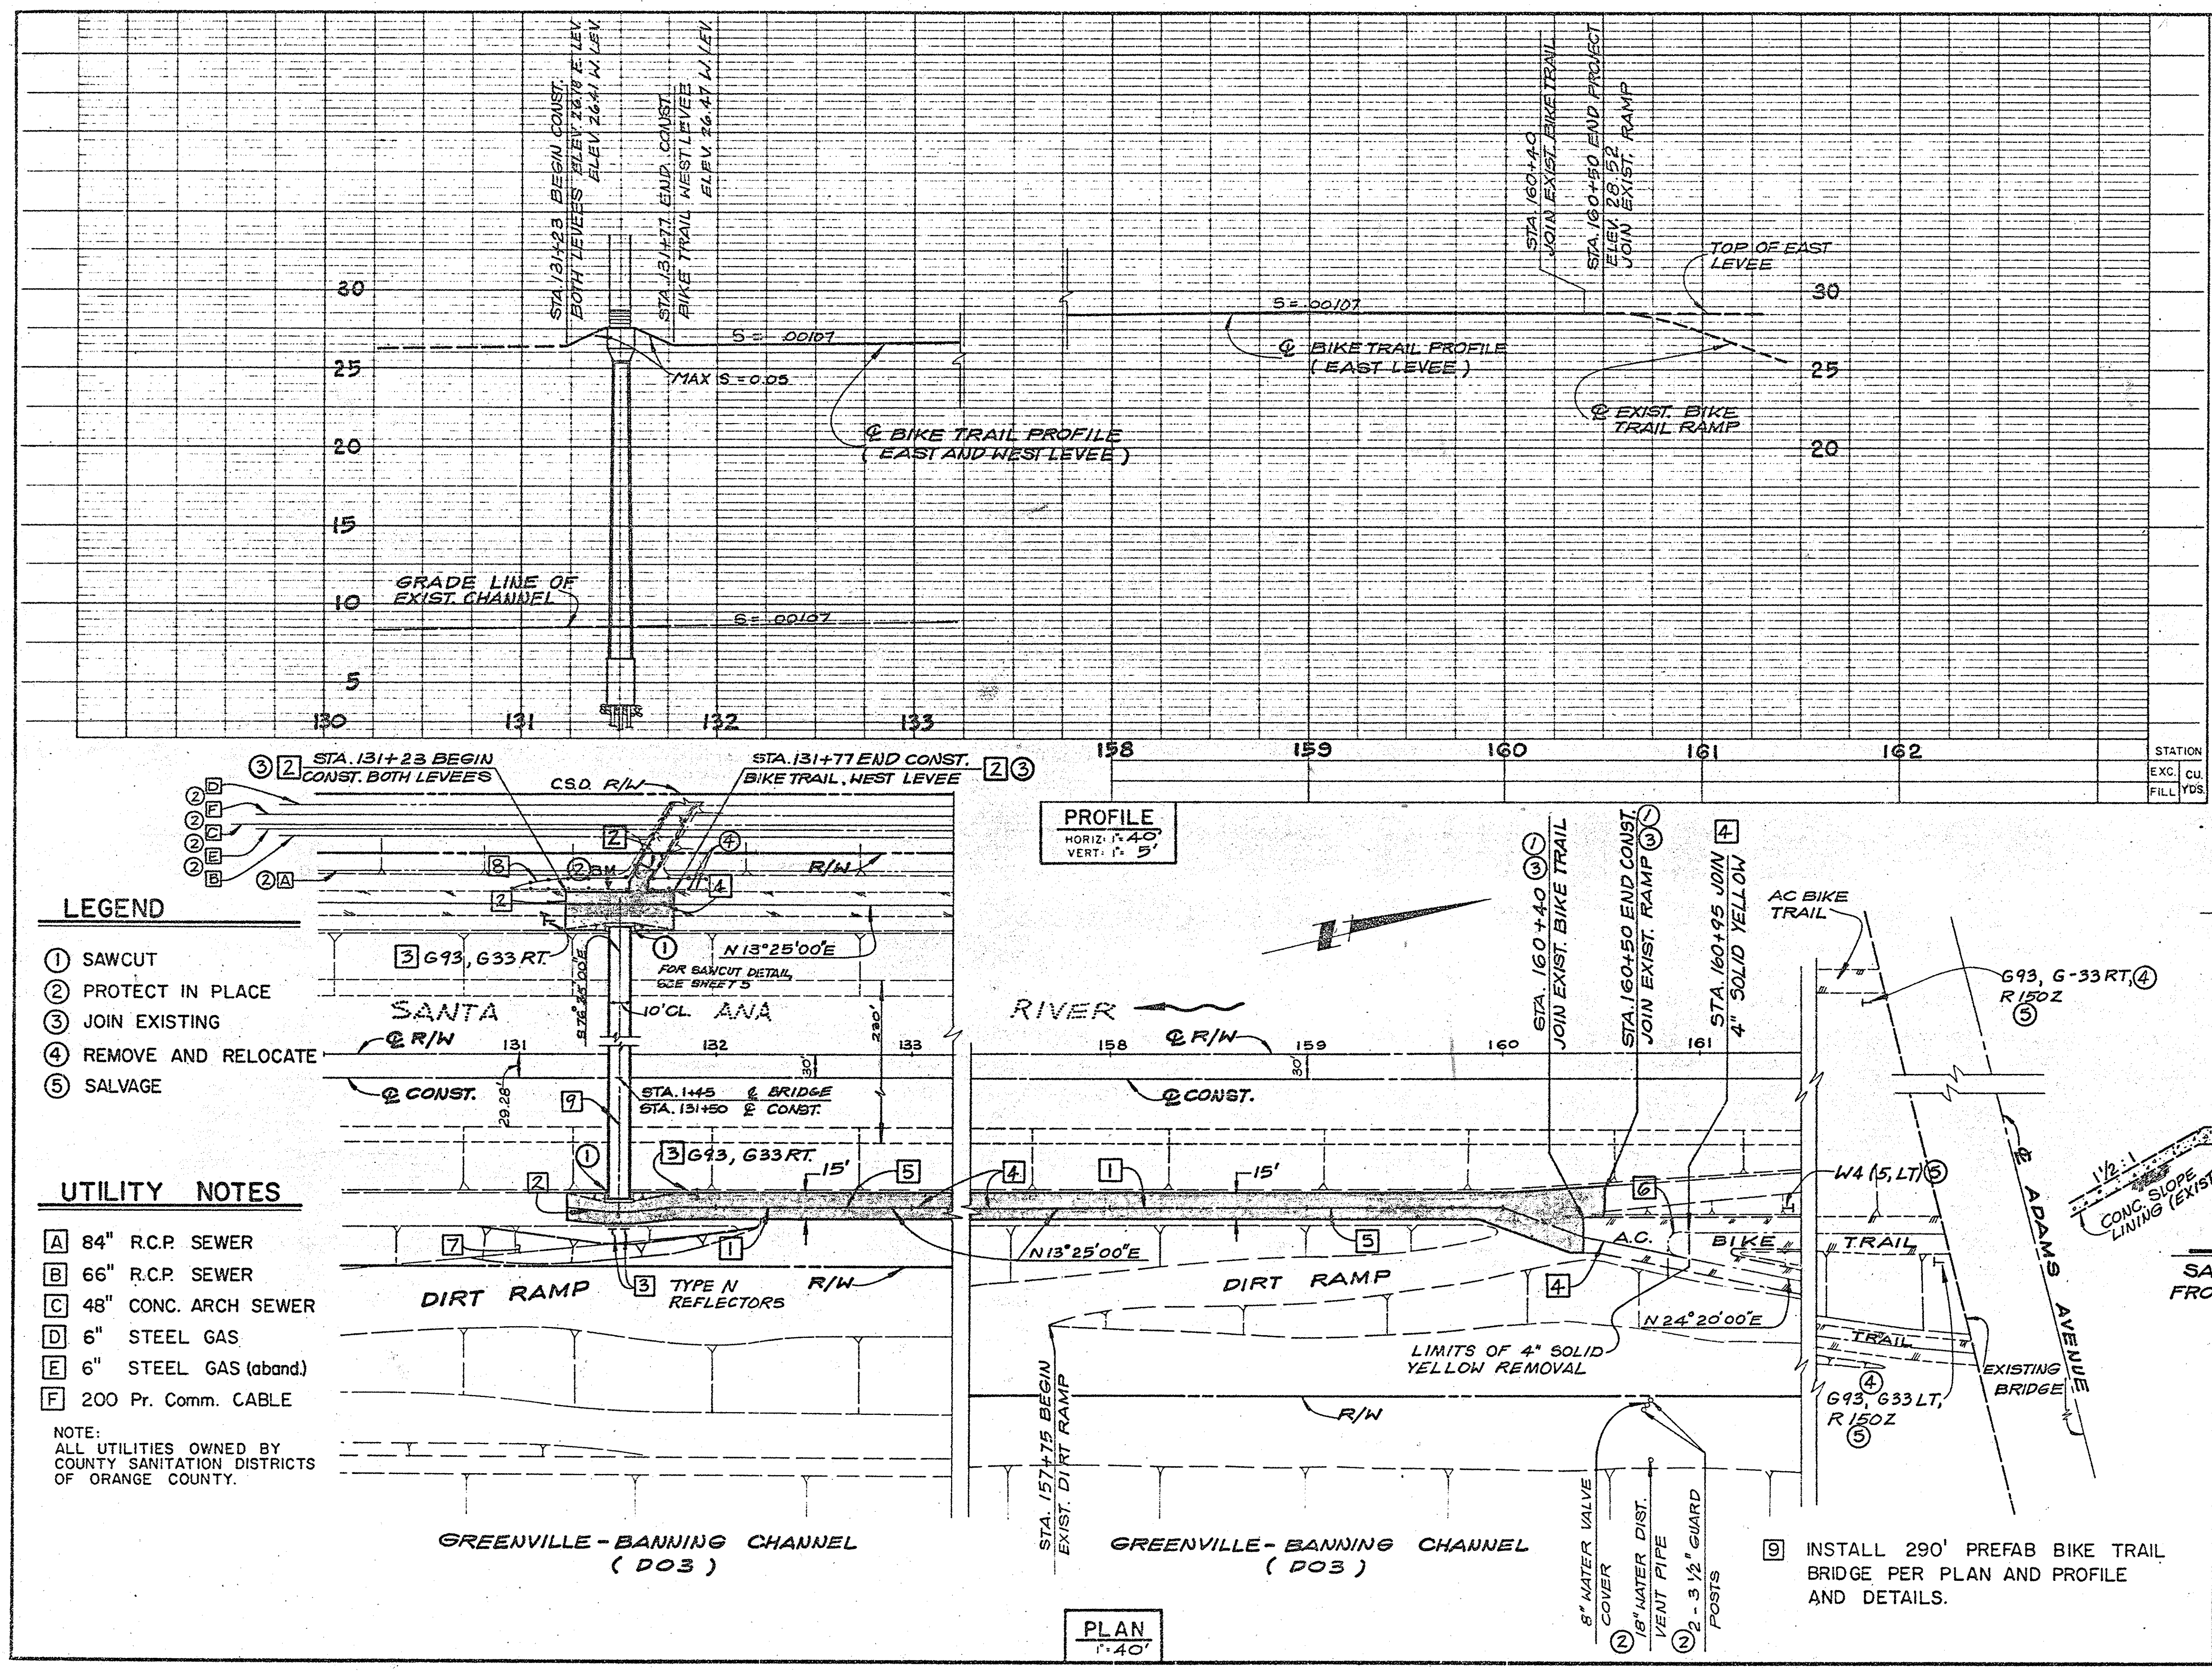


CONSTRUCTION NOTES

1. CONSTRUCT 3" A.C. OVER NATIVE SOIL.
2. CAP EXISTING TRAIL TO MEET GRADE, WITH SLOPE NOT TO EXCEED 5%.
3. INSTALL BIKE TRAIL SIGN.
4. STRIPE CENTERLINE OF BIKE TRAIL WITH 4" SOLID YELLOW.
5. APPLY SOIL STERILANT TO SUBGRADE PRIOR TO A.C. PAVING.
6. REMOVE EXISTING 4" SOLID YELLOW RADIUS FROM STA. 160+85 TO STA. 160+95.
7. CONSTRUCT SLOPE PER PLAN AND DETAILS SHEET 3.
8. RELOCATE GUARD CABLE FENCE PER DETAILS, SHEETS 2 & 3, AND AS DIRECTED BY ENGINEER.

EXIST. SIGN	NEW SIGN	REMOVE AND RELOCATE	SALVAGE	FURNISH AND INSTALL	TOTAL # OF SIGNS
G33	—	2	—	—	2
G93	—	2	—	—	2
R150Z	—	—	2	—	2
W4	—	—	1	—	1
—	TYPE N	—	—	2	2

BIKE TRAIL SIGNING SUMMARY

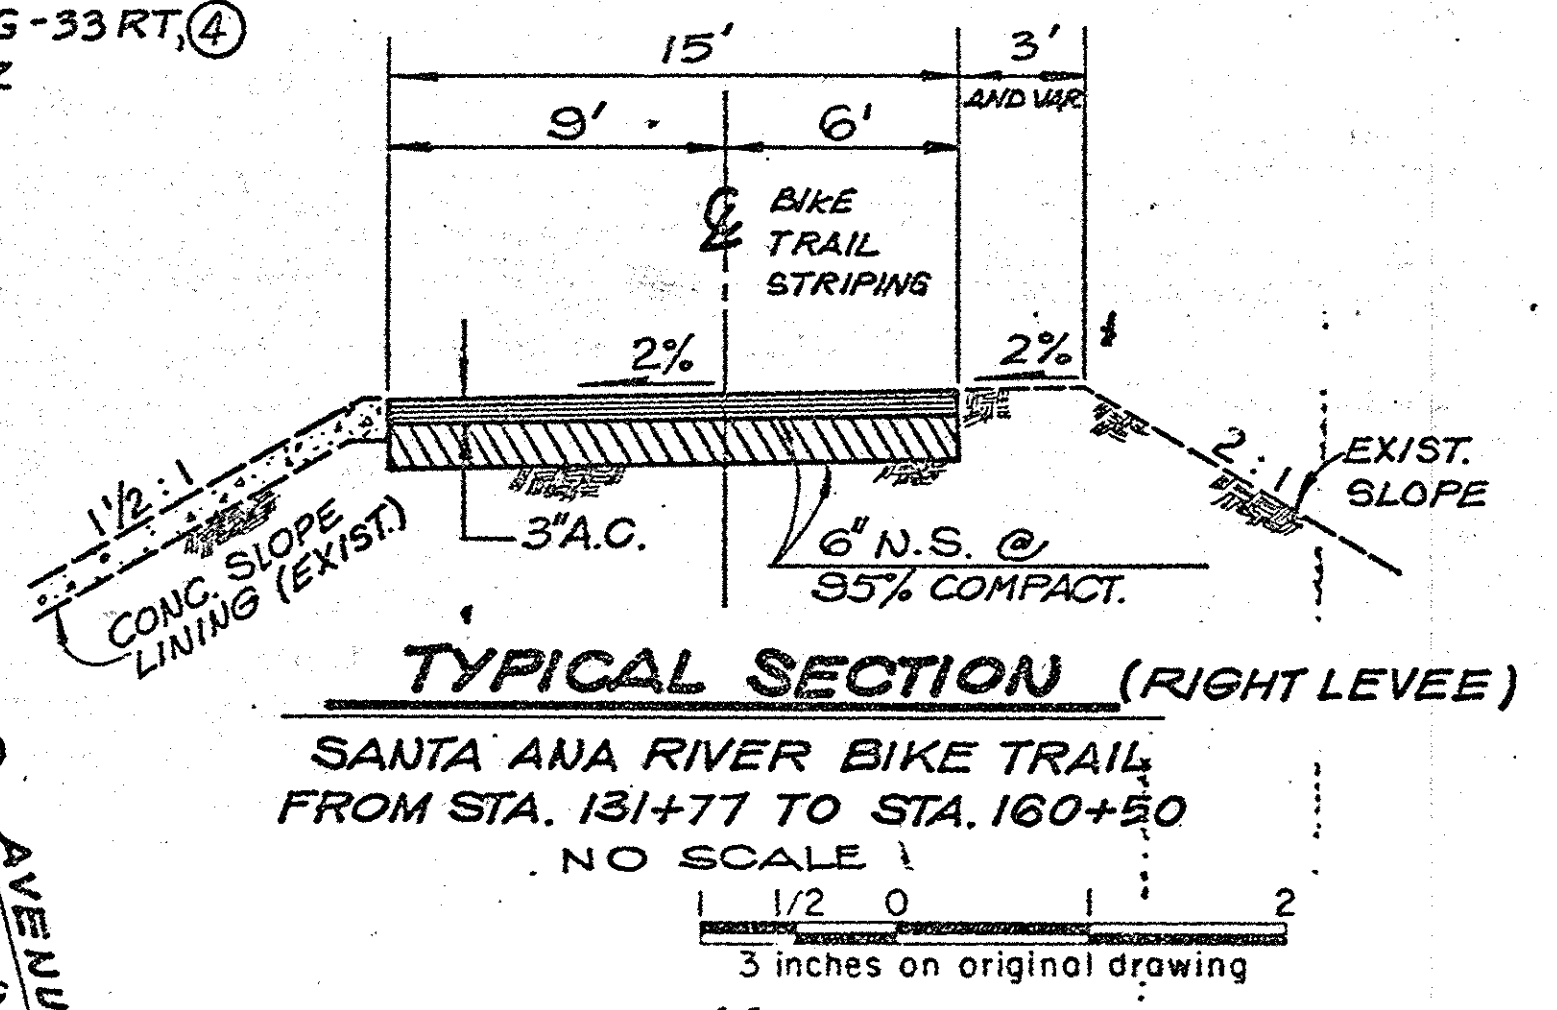

ORANGE COUNTY ENVIRONMENTAL MANAGEMENT AGENCY			
SANTA ANA RIVER BIKE TRAIL CROSSING			
PLAN AND PROFILE			
MARK DATE	DESCRIPTION	PREPARED UNDER SUPERVISION OF	SHEET 2 OF 6
DESIGNED V.P.R.	REVISIONS	R.C.E. 30829	DATE 2
DRAWN H.R., T.C.B.	CHECKED V.P.R.	SCALE AS SHOWN	DATE APR. 85

DR 12 (1502