
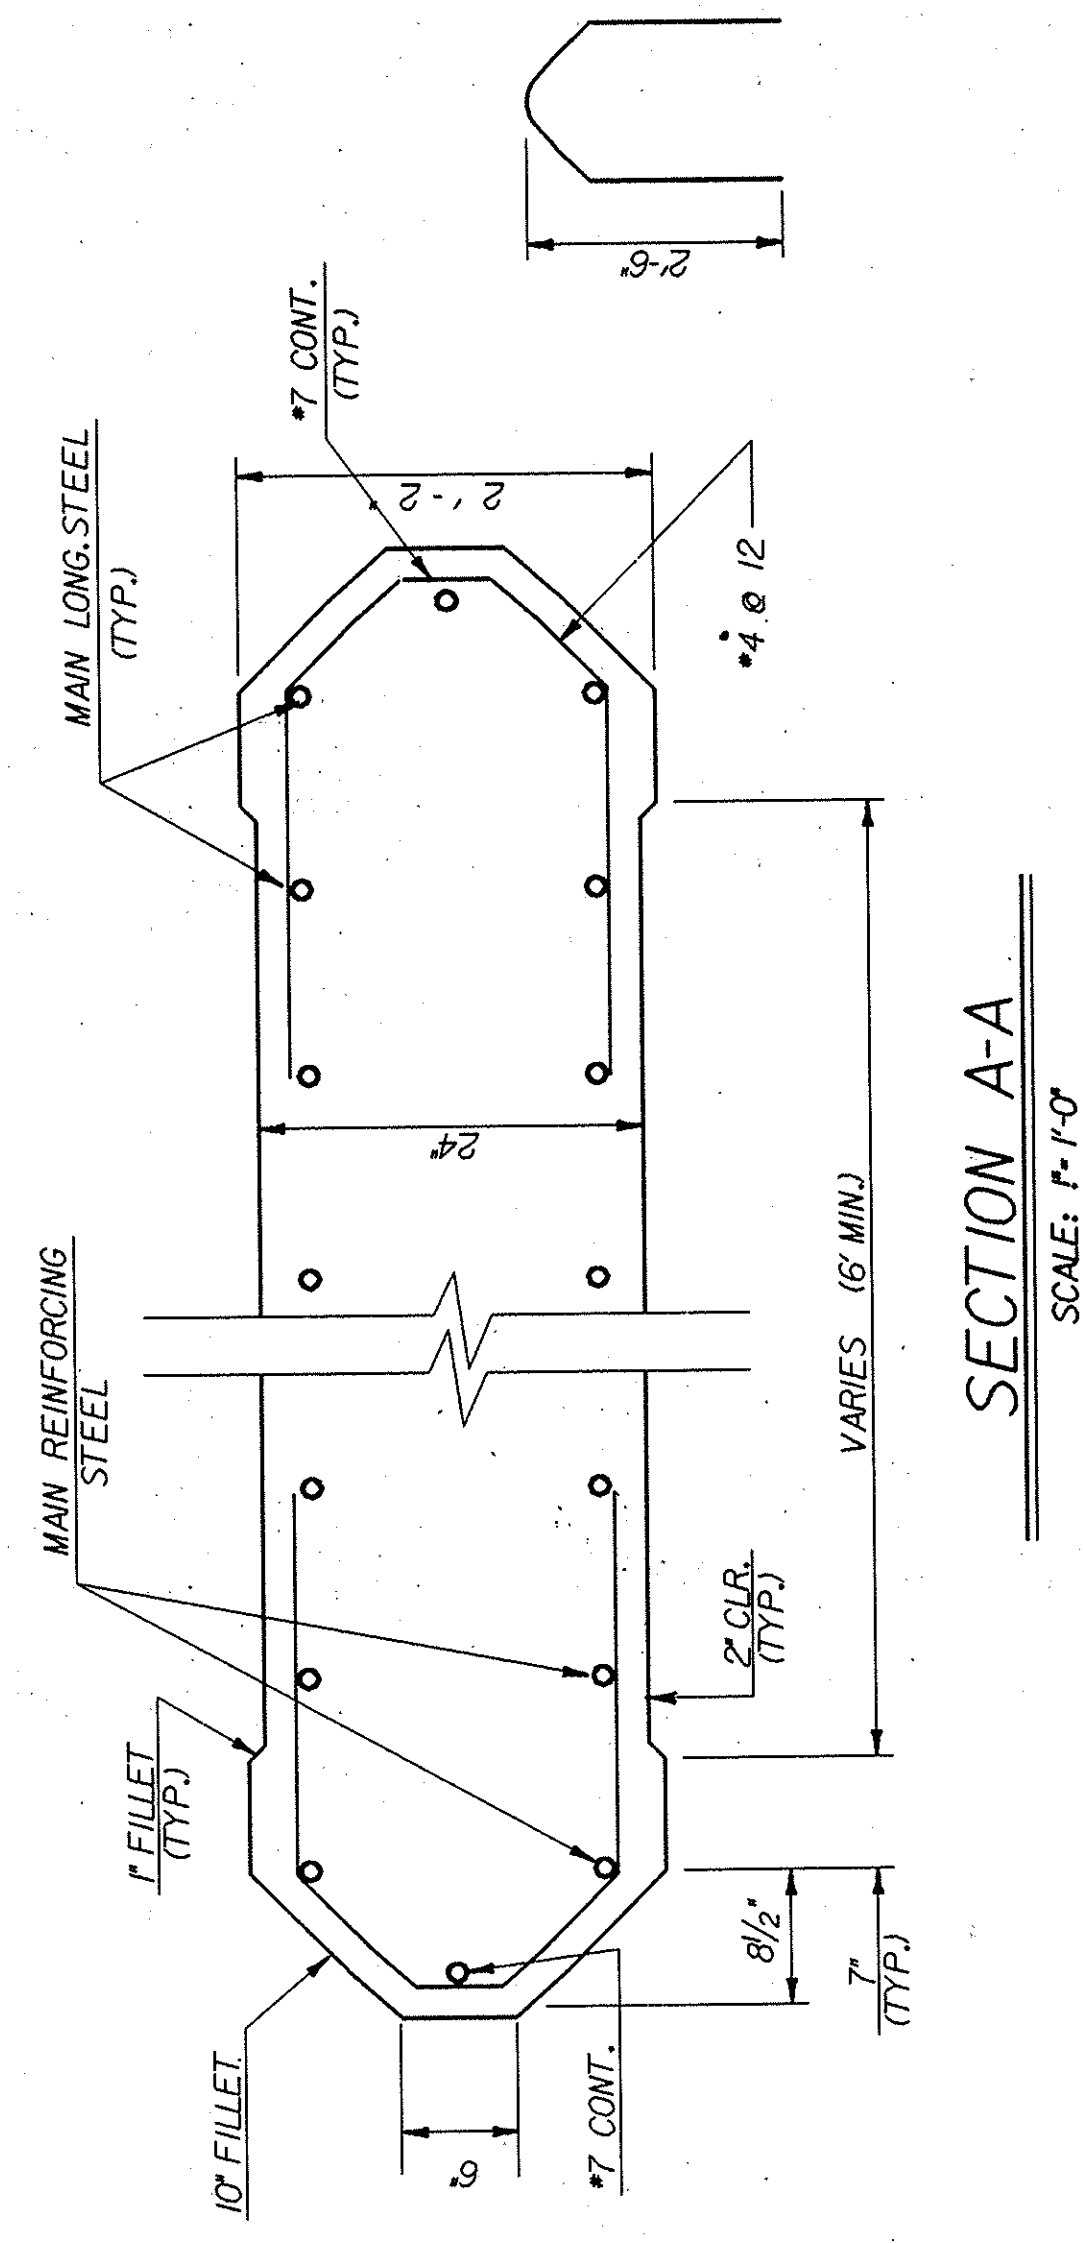
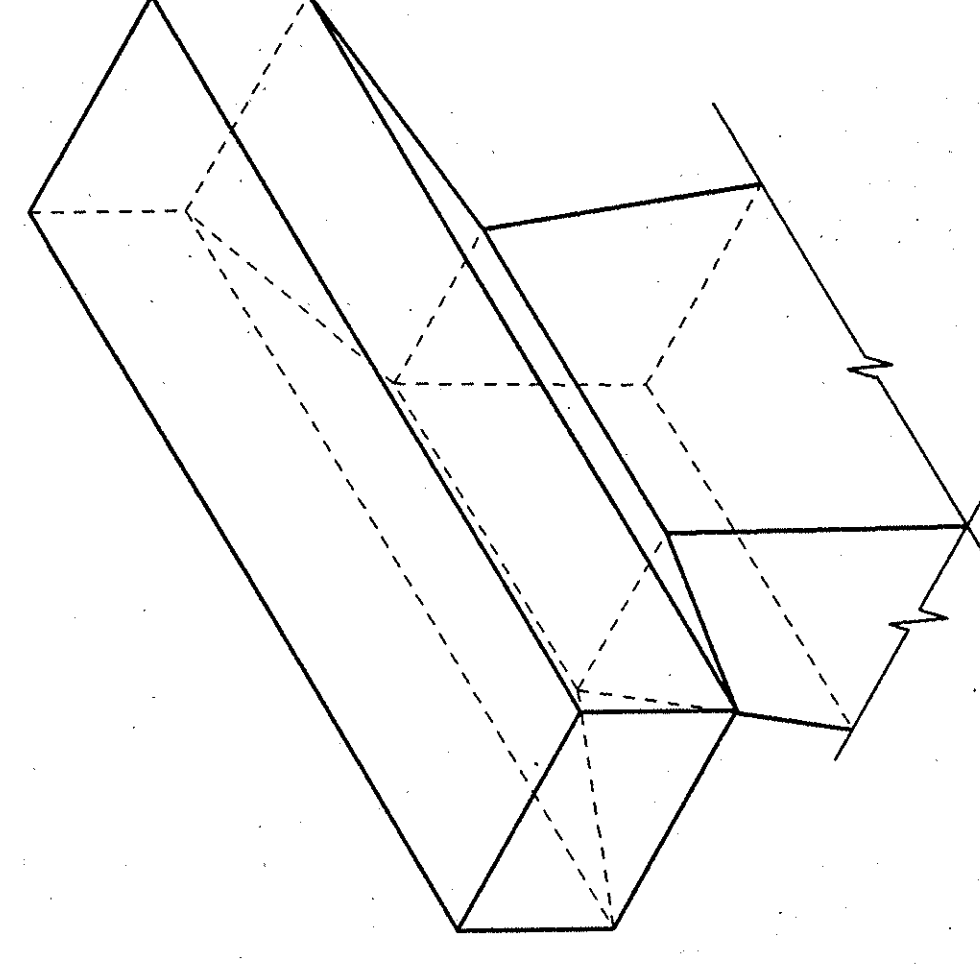
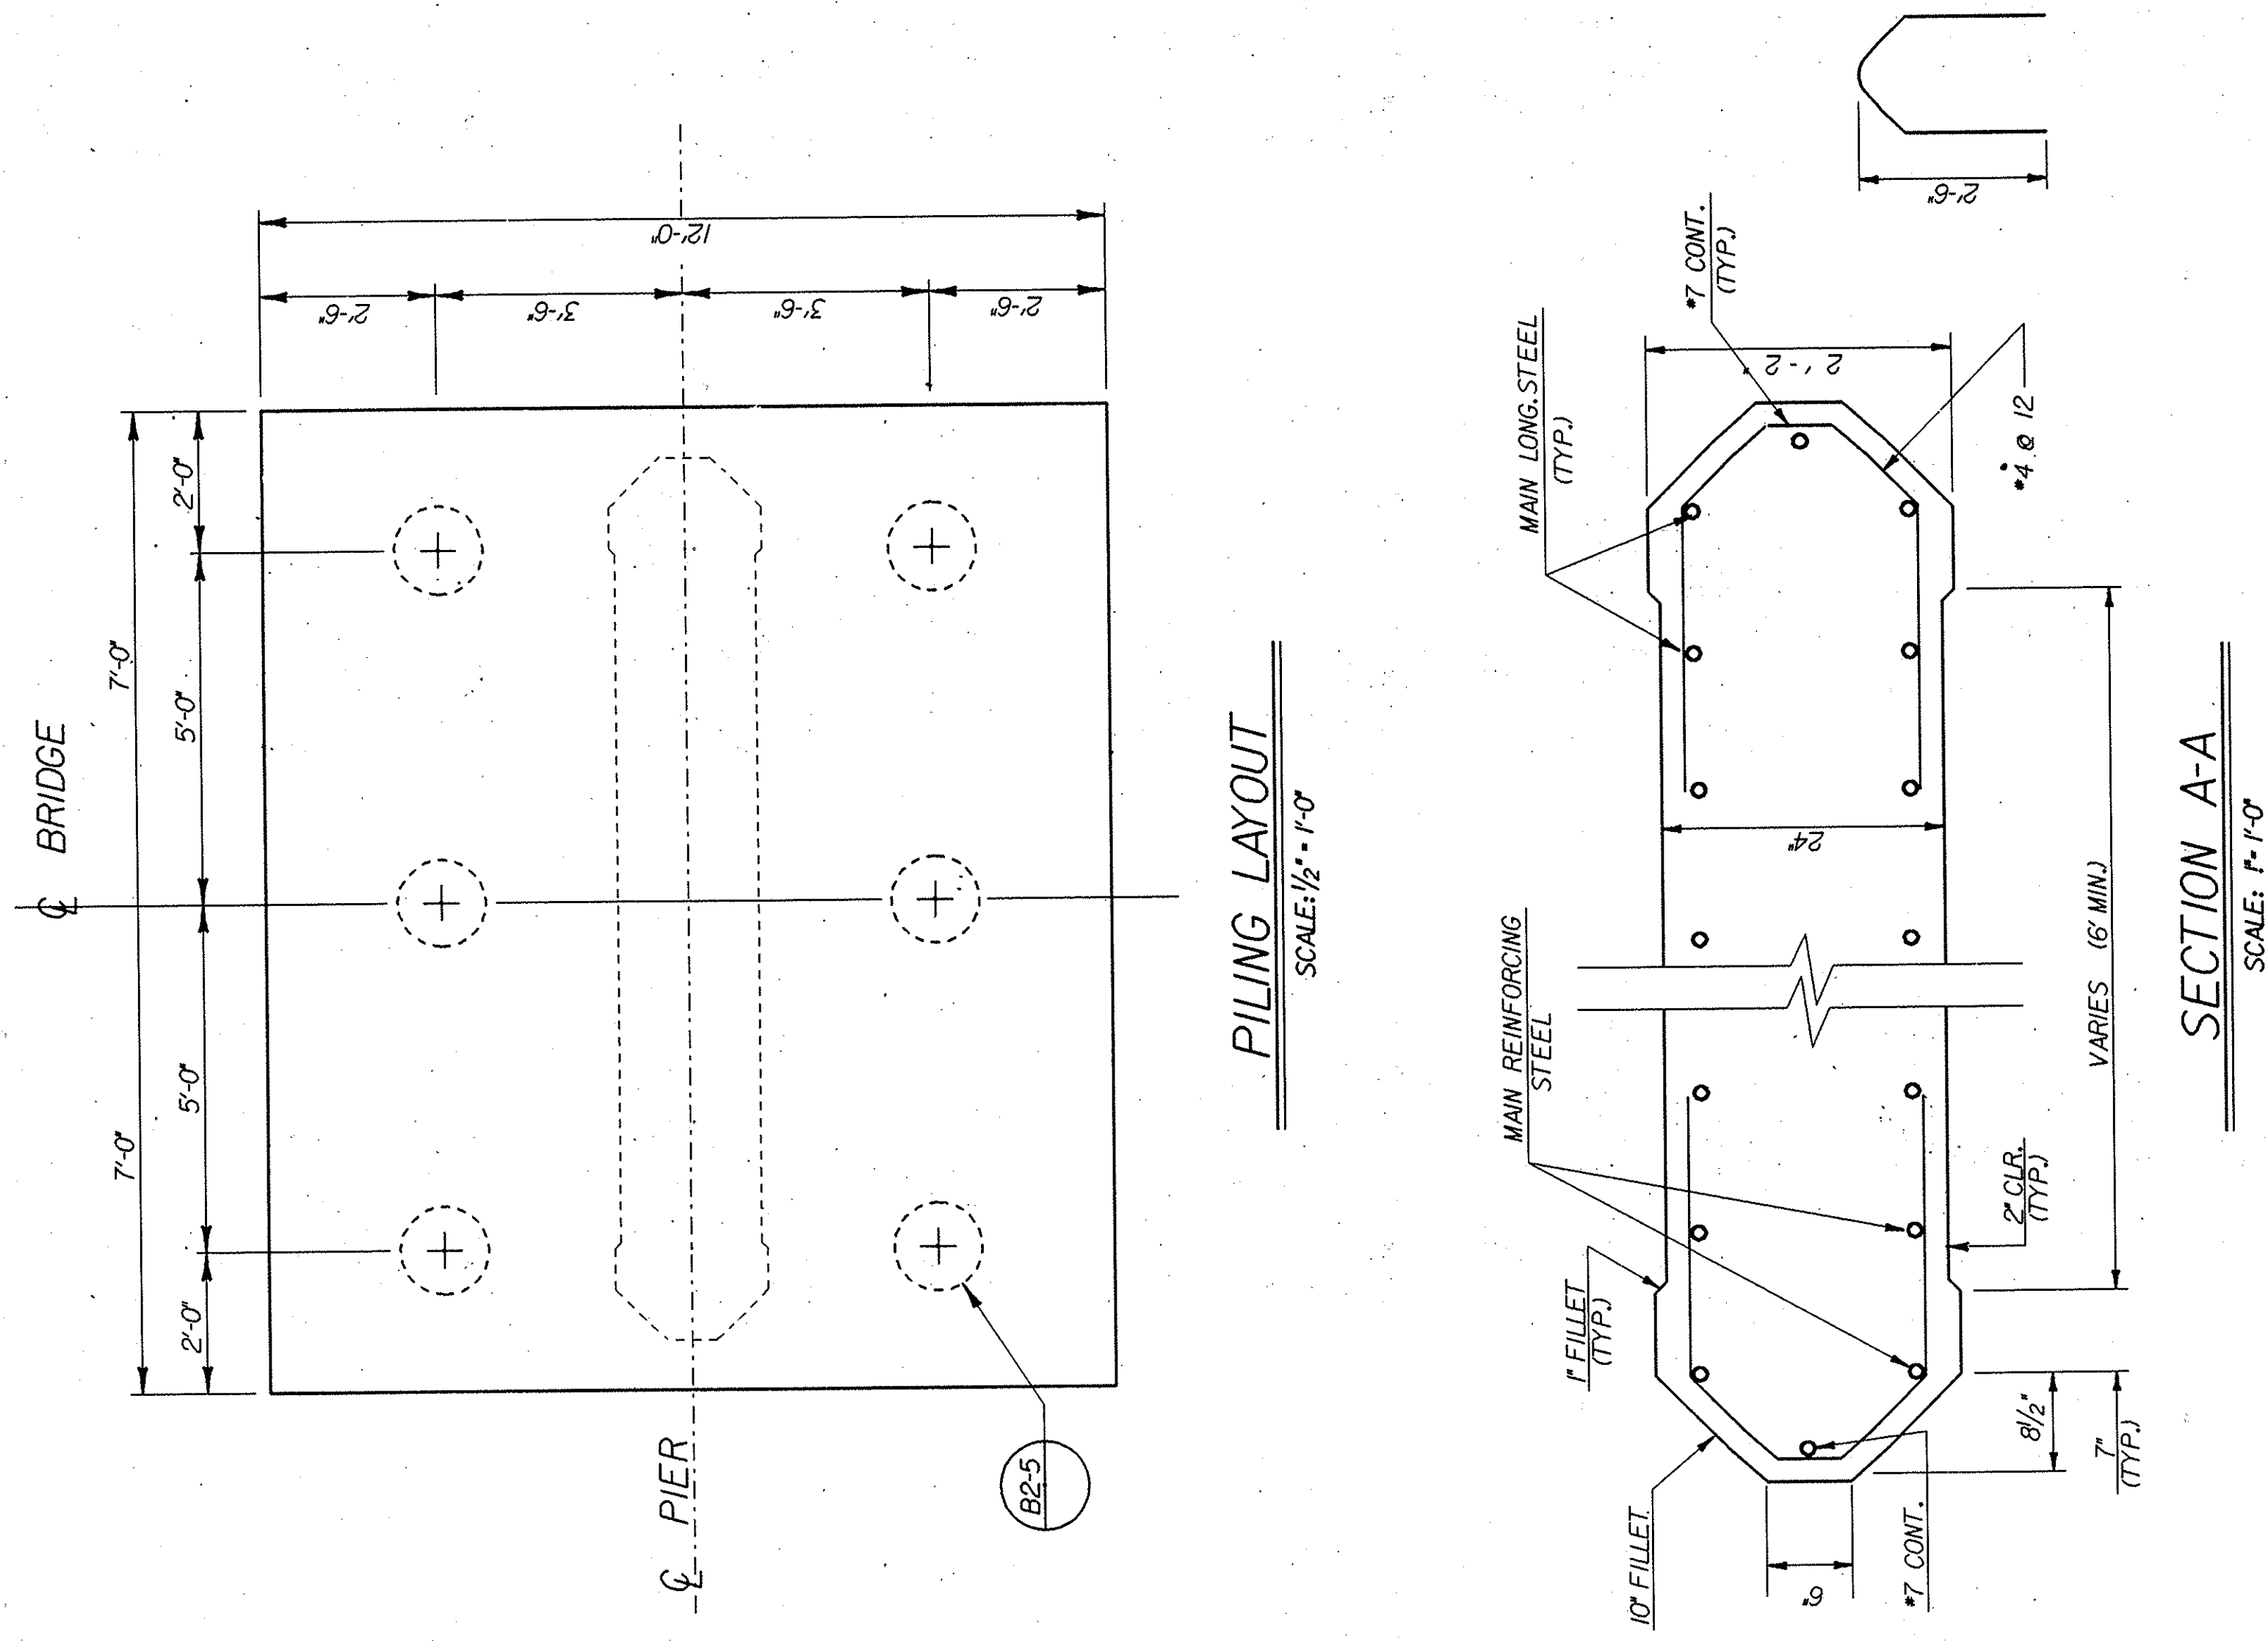
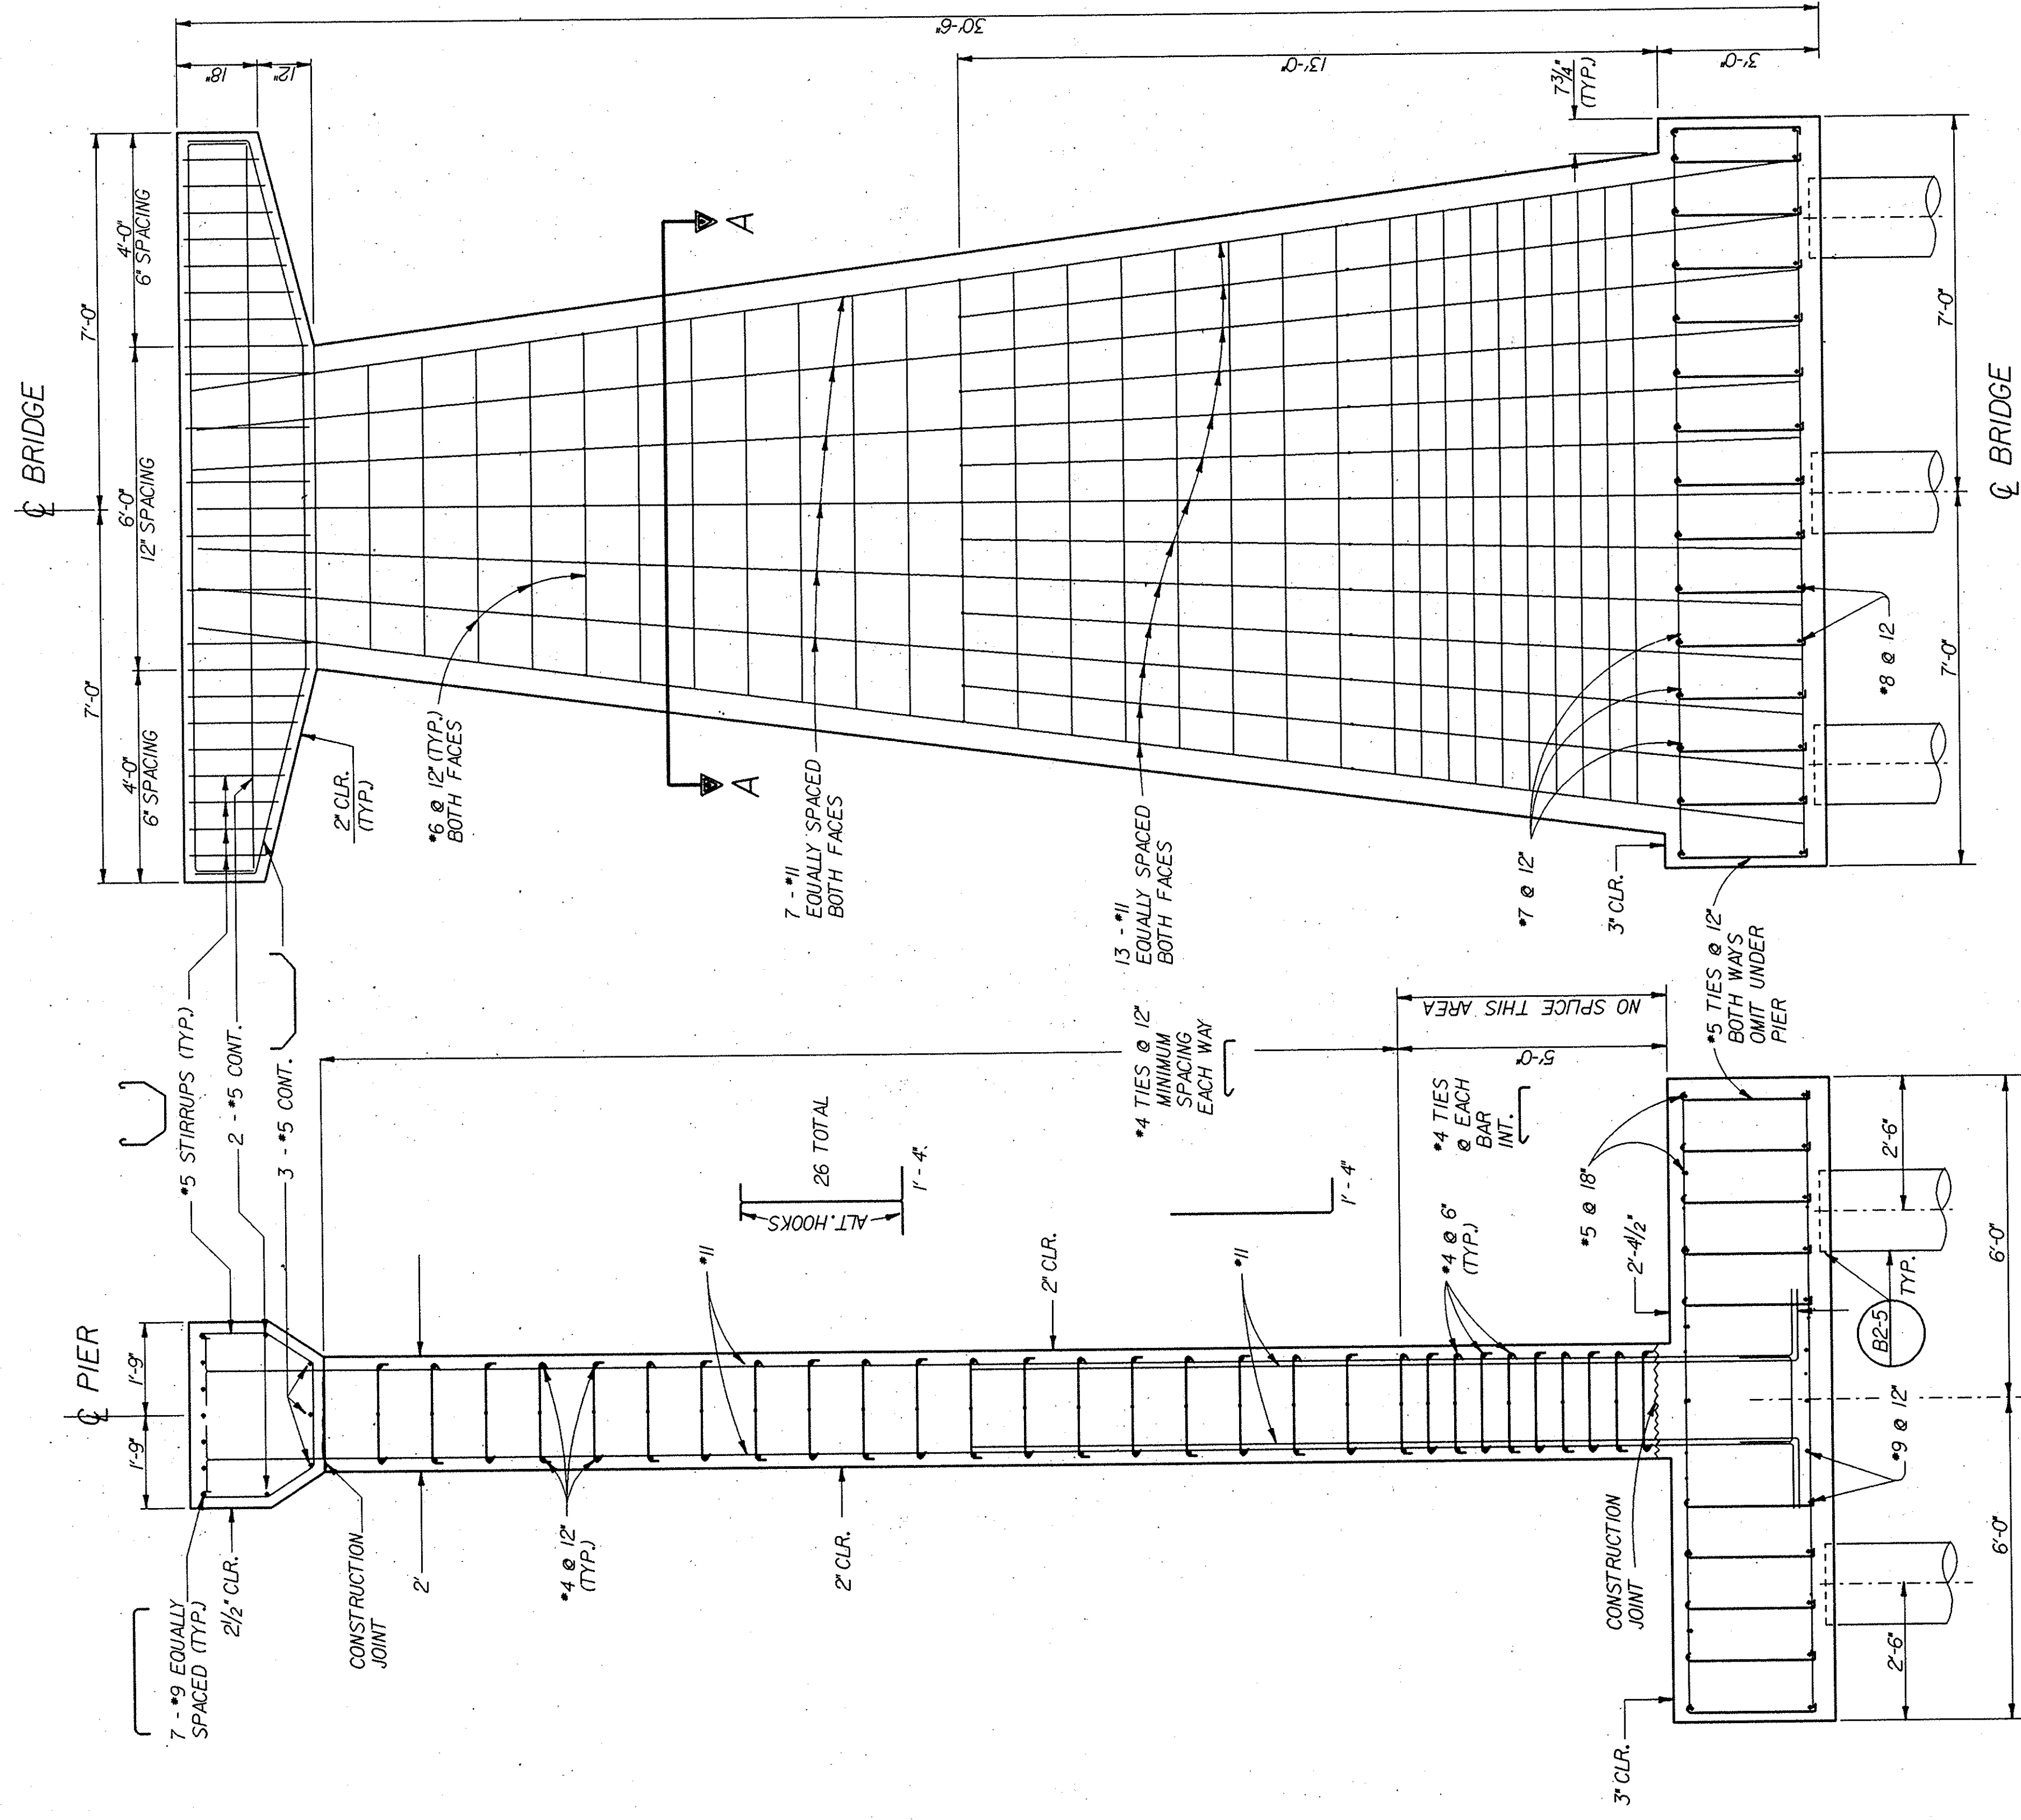


VALUE ENGINEERING PAYS

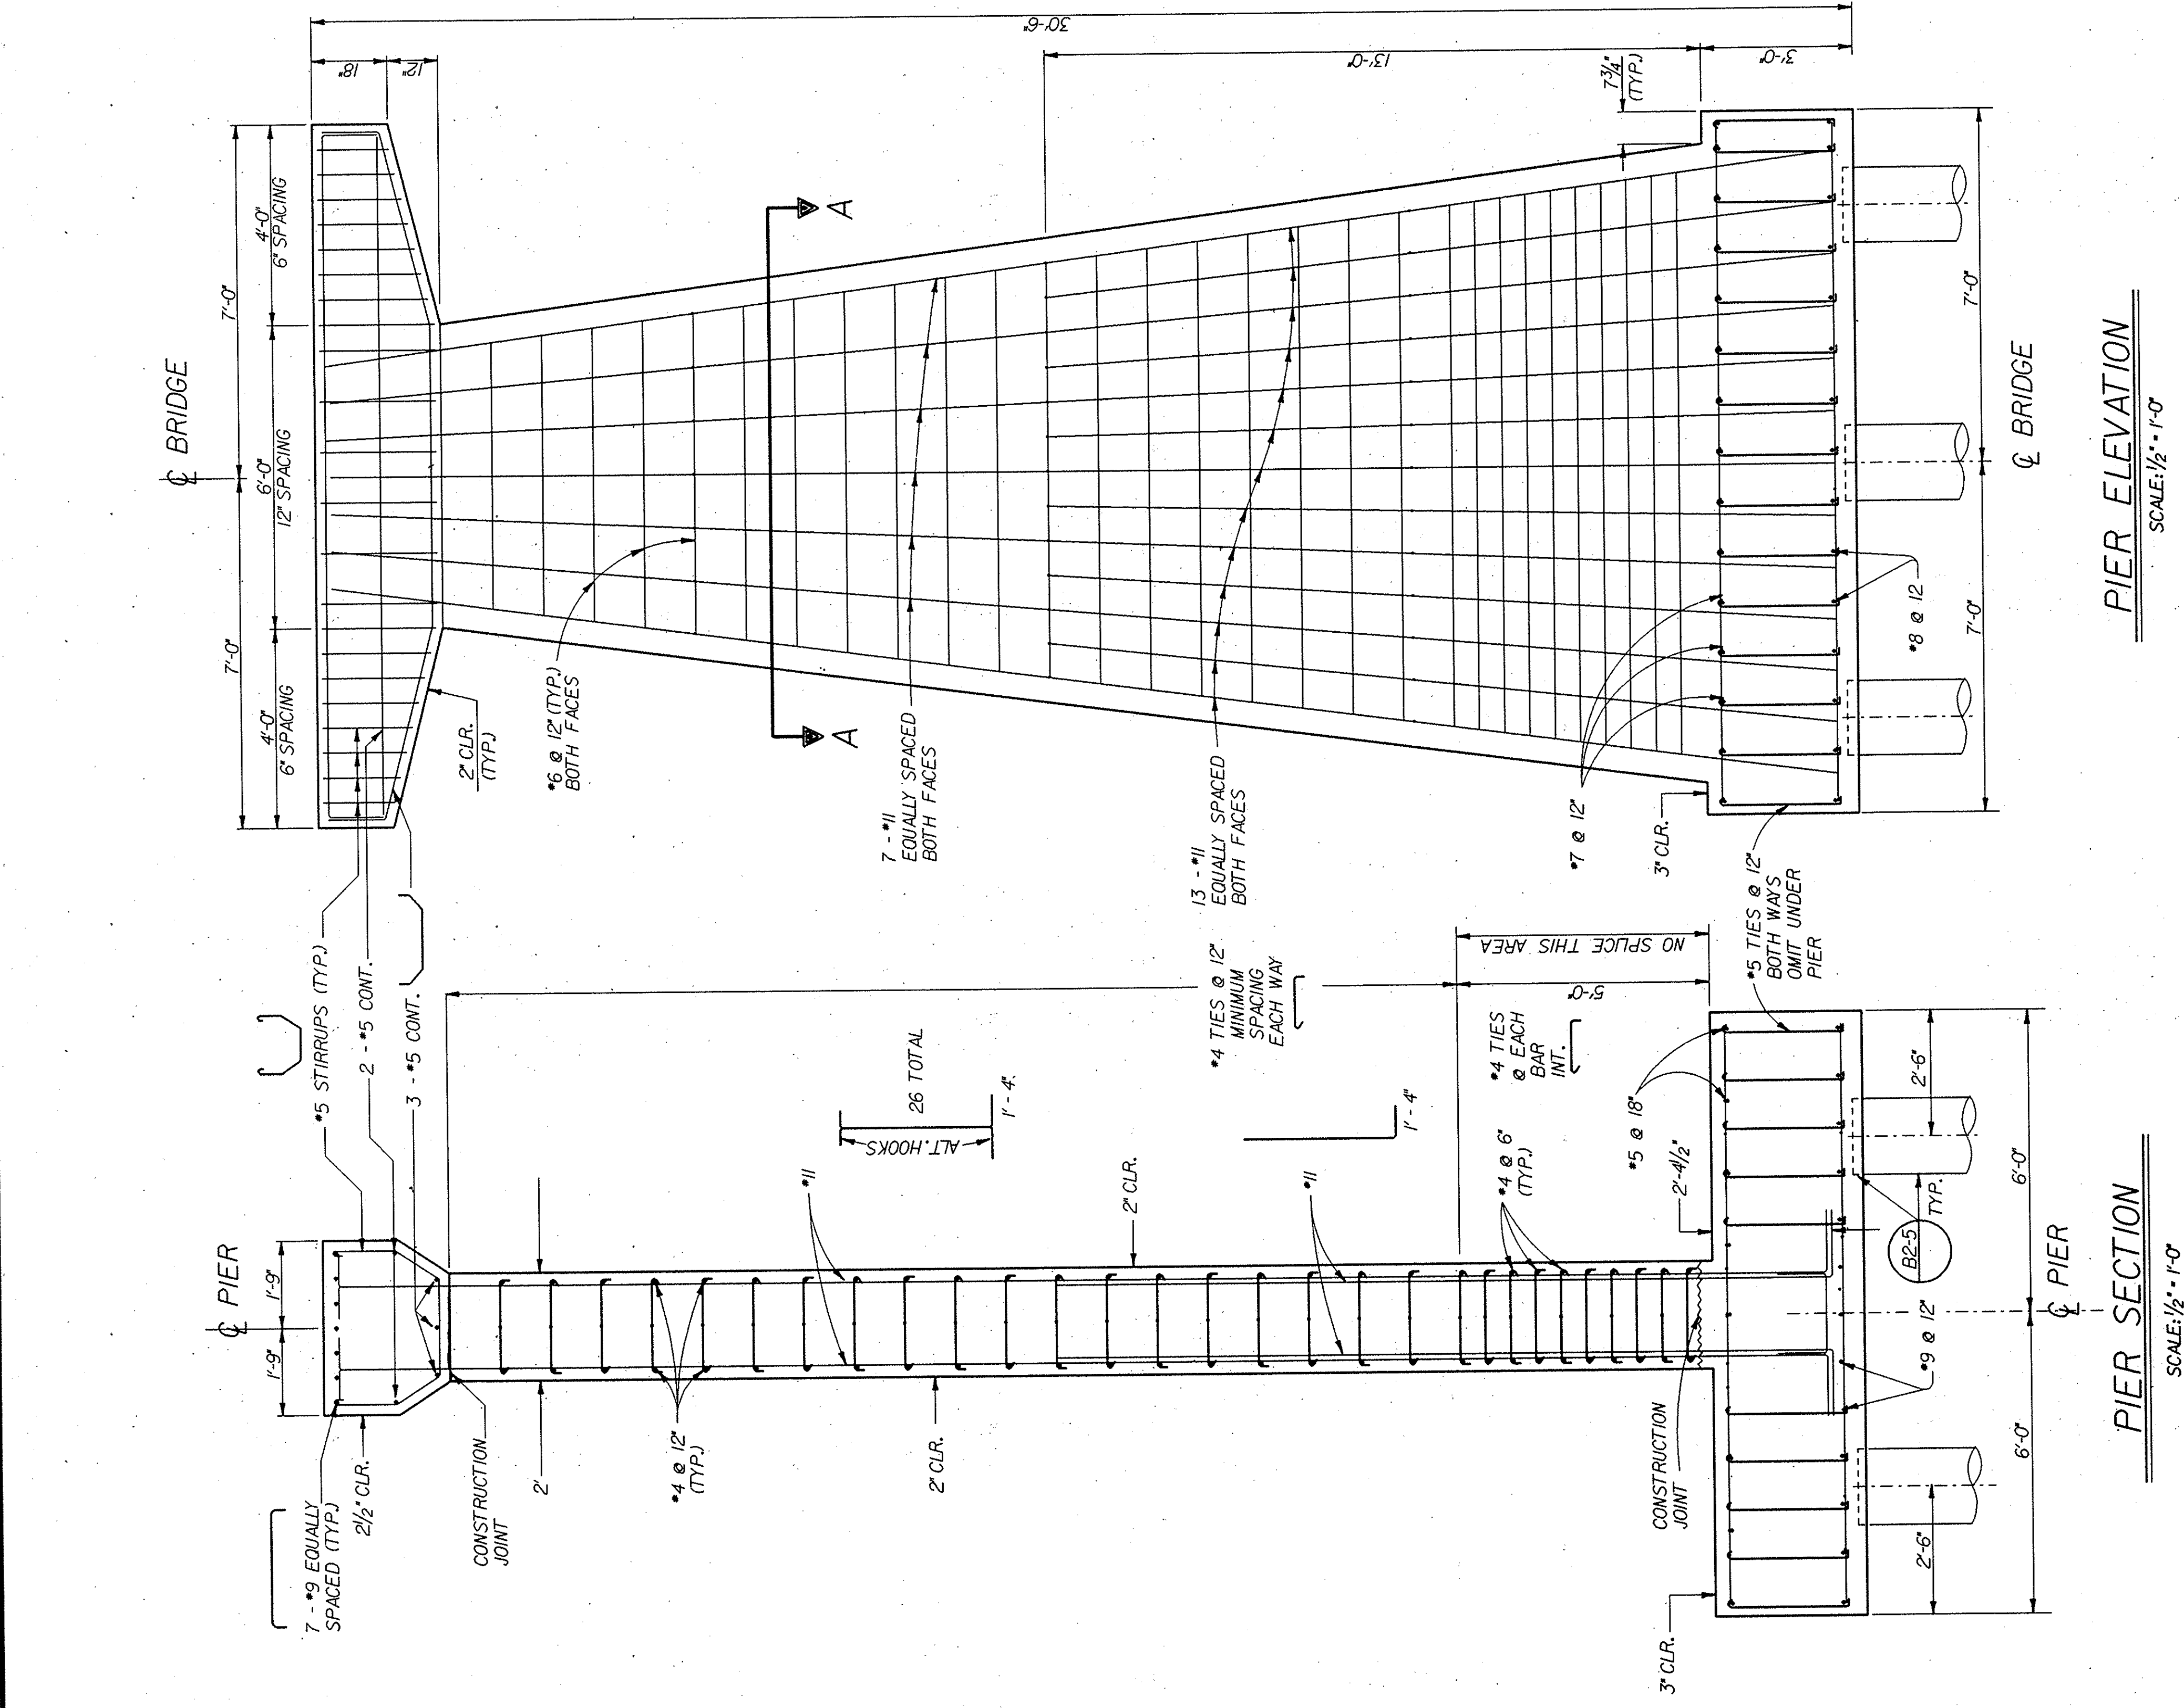

ENVIRONMENTAL
ENHANCEMENT
THRU ENGINEERING

SAFETY PAYS