



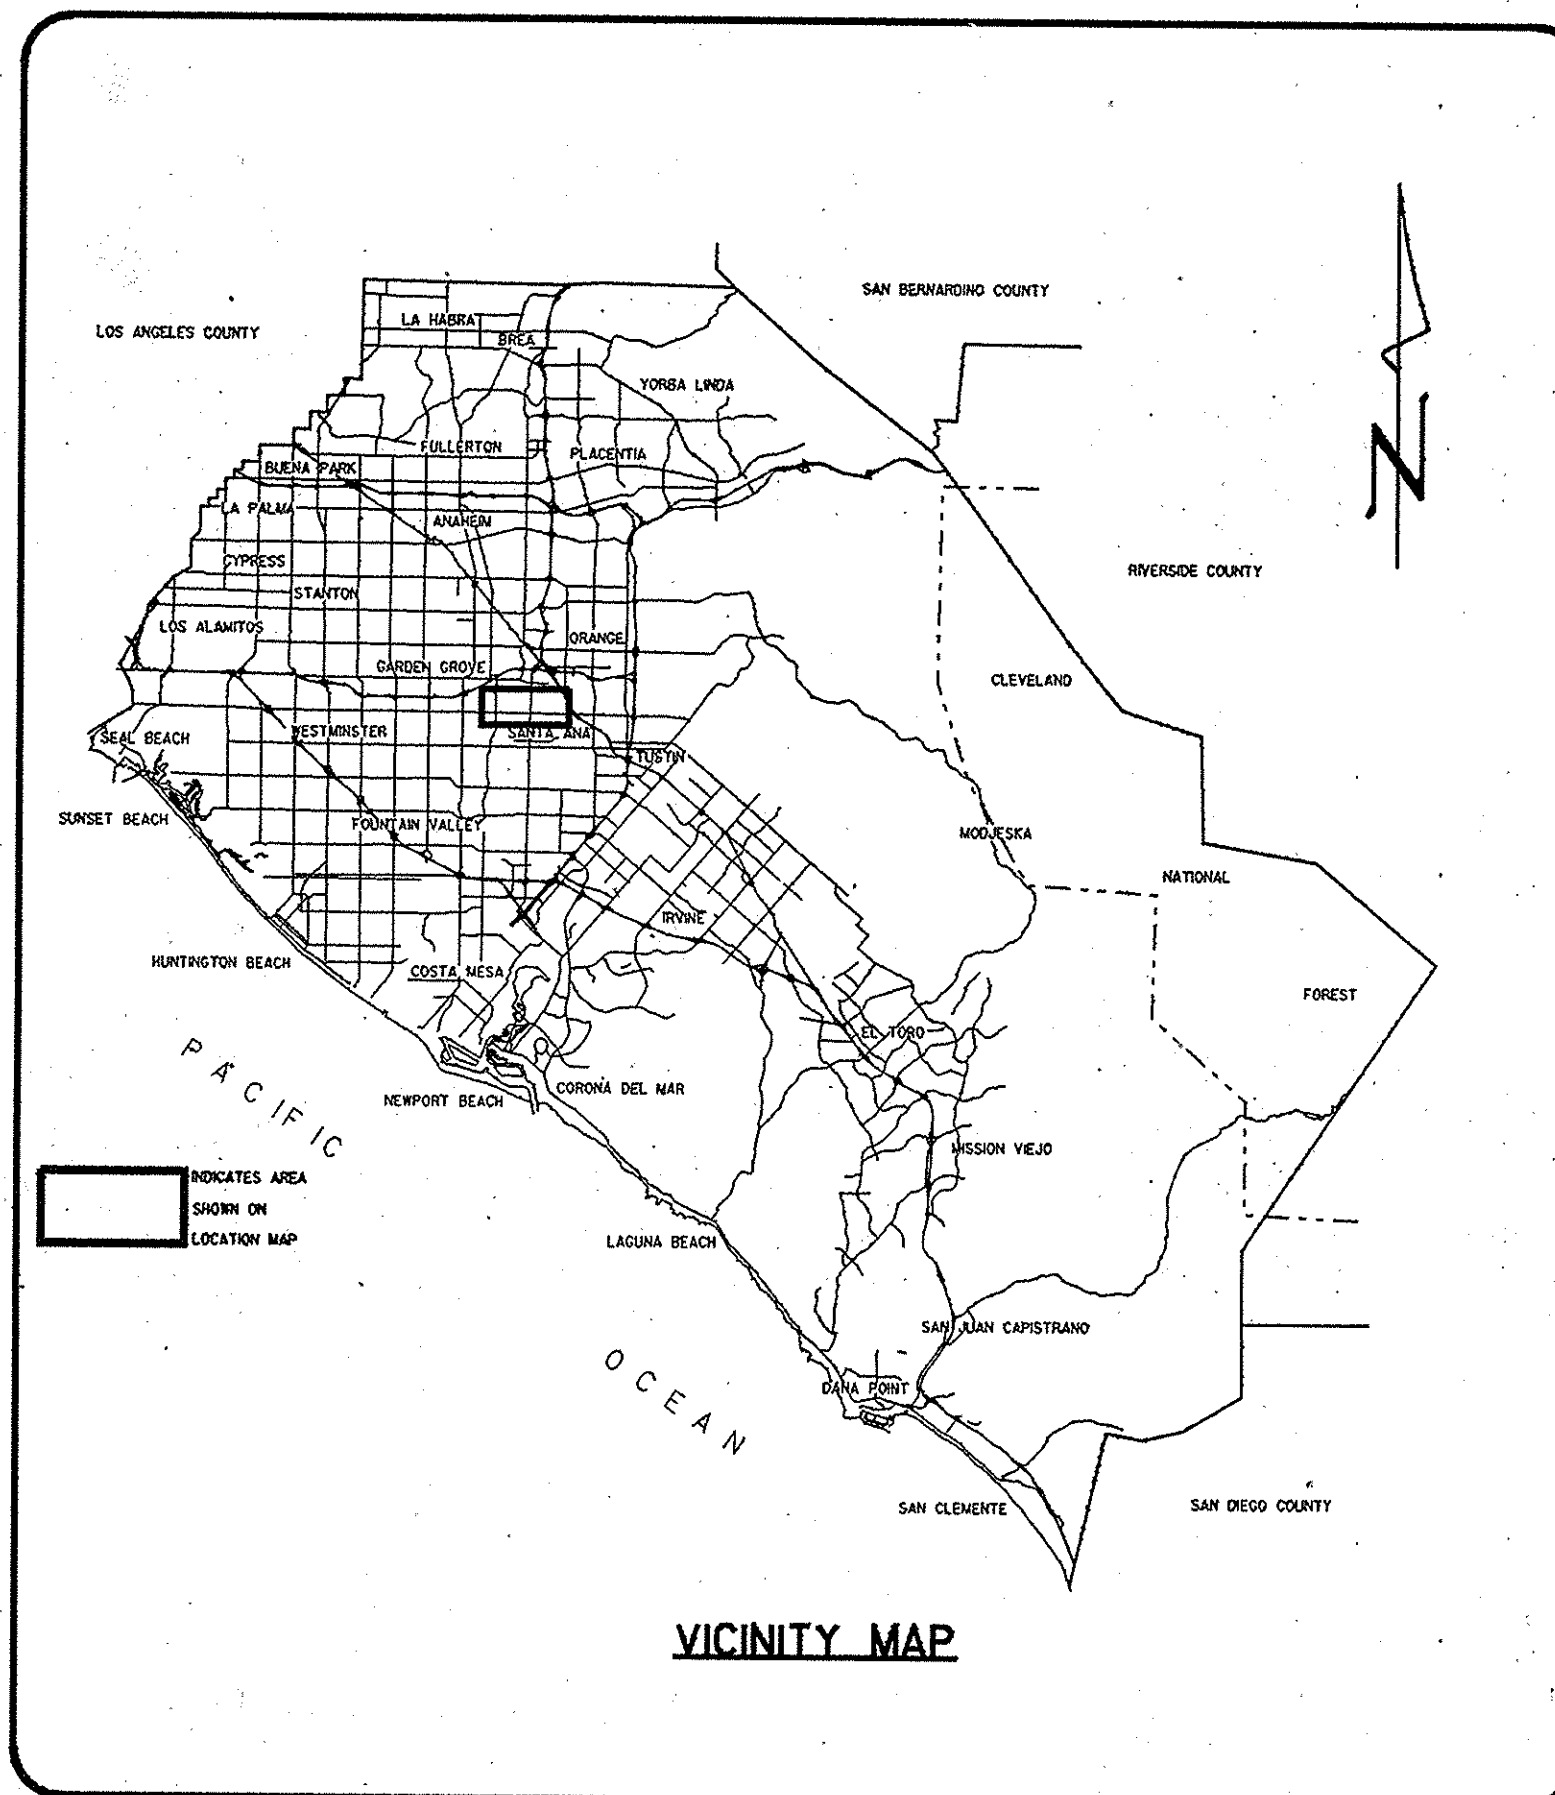

VICINITY MAP

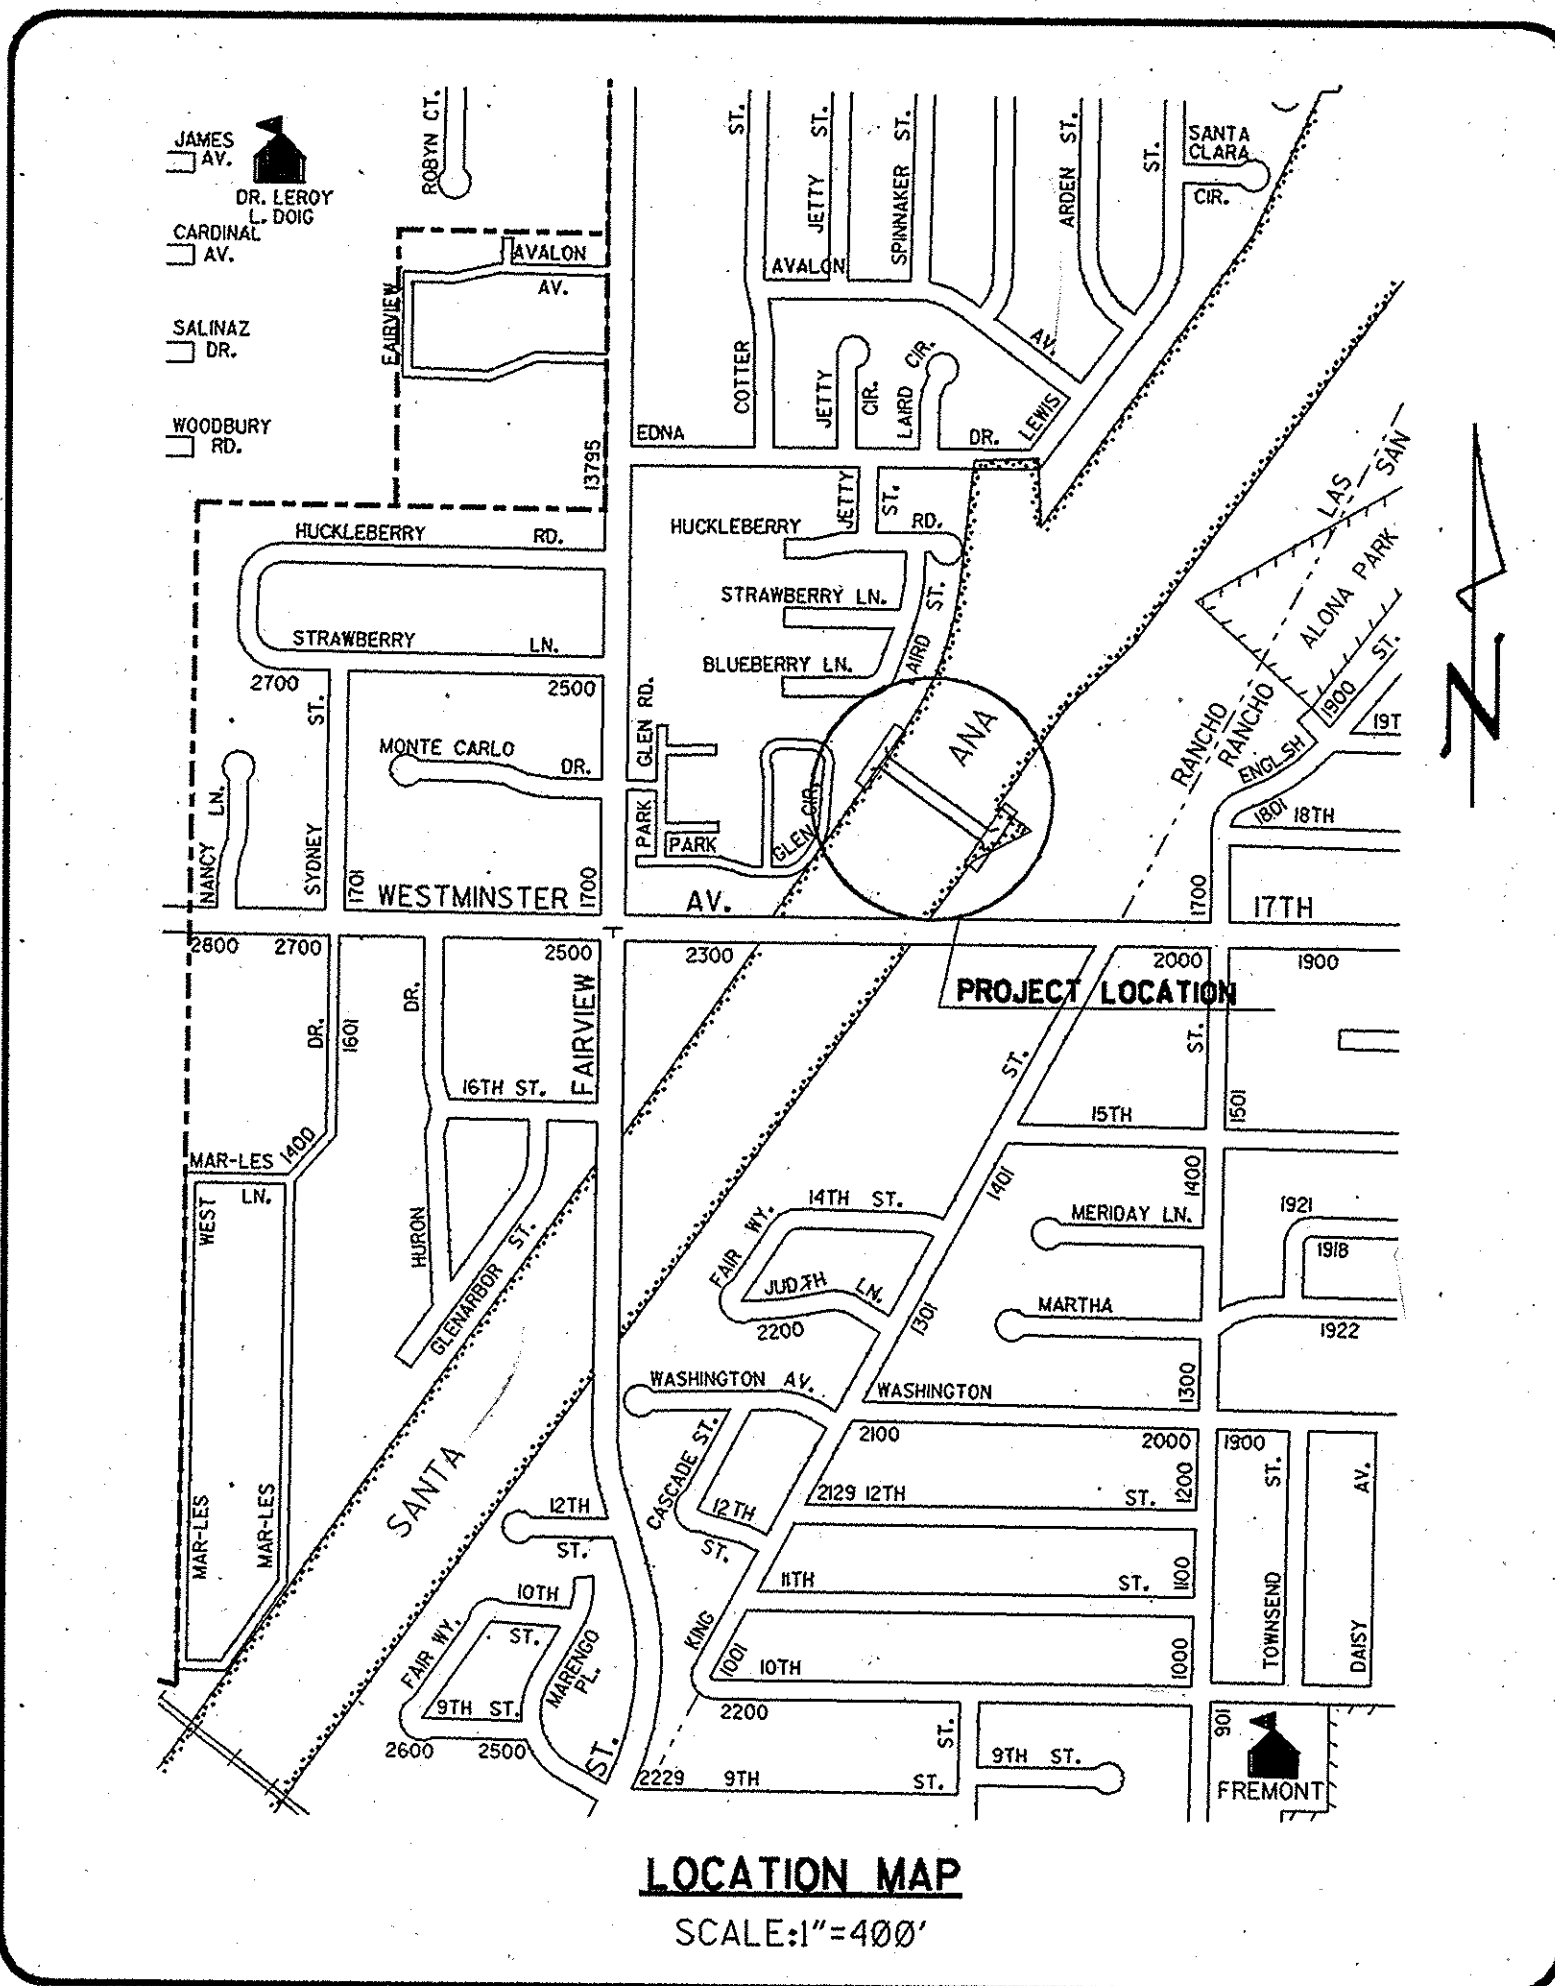

LOCATION MAP
SCALE: 1"=400'

ORANGE COUNTY ENVIRONMENTAL MANAGEMENT AGENCY

SANTA ANA, CALIFORNIA
E. SCHNEIDER, DIRECTOR

PLANS FOR CONSTRUCTION OF SANTA ANA RIVER BIKE TRAIL

BRIDGE NEAR 17TH STREET AUGUST 1988

FUNDED BY: SB821 AND AB244 GRANT FUNDS

EMA - PUBLIC WORKS

SUBMITTED: [Signature] DATE 7-21-88

RECOMMENDED: [Signature] DATE 7/20/88

APPROVED: [Signature] DATE 7/20/88

INDEX OF SHEETS	
SHEET	DESCRIPTION
1	TITLE SHEET
2	GENERAL PLAN
3	FOUNDATION PLAN & MISCELLANEOUS DETAILS
4	ABUTMENT AND PIER DETAILS
5	LOG OF TEST BORING
6	PILING DETAILS

AS BUILT

CONTRACTOR : JOHN L. MEEK CONST.
INSPECTOR : C. L. RAWLIN
COMPLETED : 9/5/89

UTILITY OWNER	PHONE NO.	CONTACT
UNDERGROUND SERVICE ALERT COUNTY SANITATION DISTRICT OF ORANGE COUNTY	(800)422-4133 (714) 962-2411 EXT. 538	Mr. RUSS WOLD

BENCH MARK: IC-127-82 SET IN THE TOP OF THE CONCRETE ABUTMENT FOR THE NORTHEAST CORNER OF THE BRIDGE OVER THE SANTA ANA RIVER AT 17TH ST.; APPROXIMATELY 48.5 FT. NORTHERLY OF THE CENTERLINE OF 17TH ST.; 0.5 FT. HIGHER THAN THE BRIDGE DECK. ELEVATION: 105.110 1976 ADJUSTMENT	BASIS OF BEARINGS: THE BEARING OF N29°37'20"E BETWEEN S ANA 85 & S ANA 77 PER O.C.S. TIE NOTES A/4-10, Pg. 801 .
---	--

NO.	DESCRIPTION	ALL SHT.	APPROVED	DATE
1	AS BUILT			9/25/89