

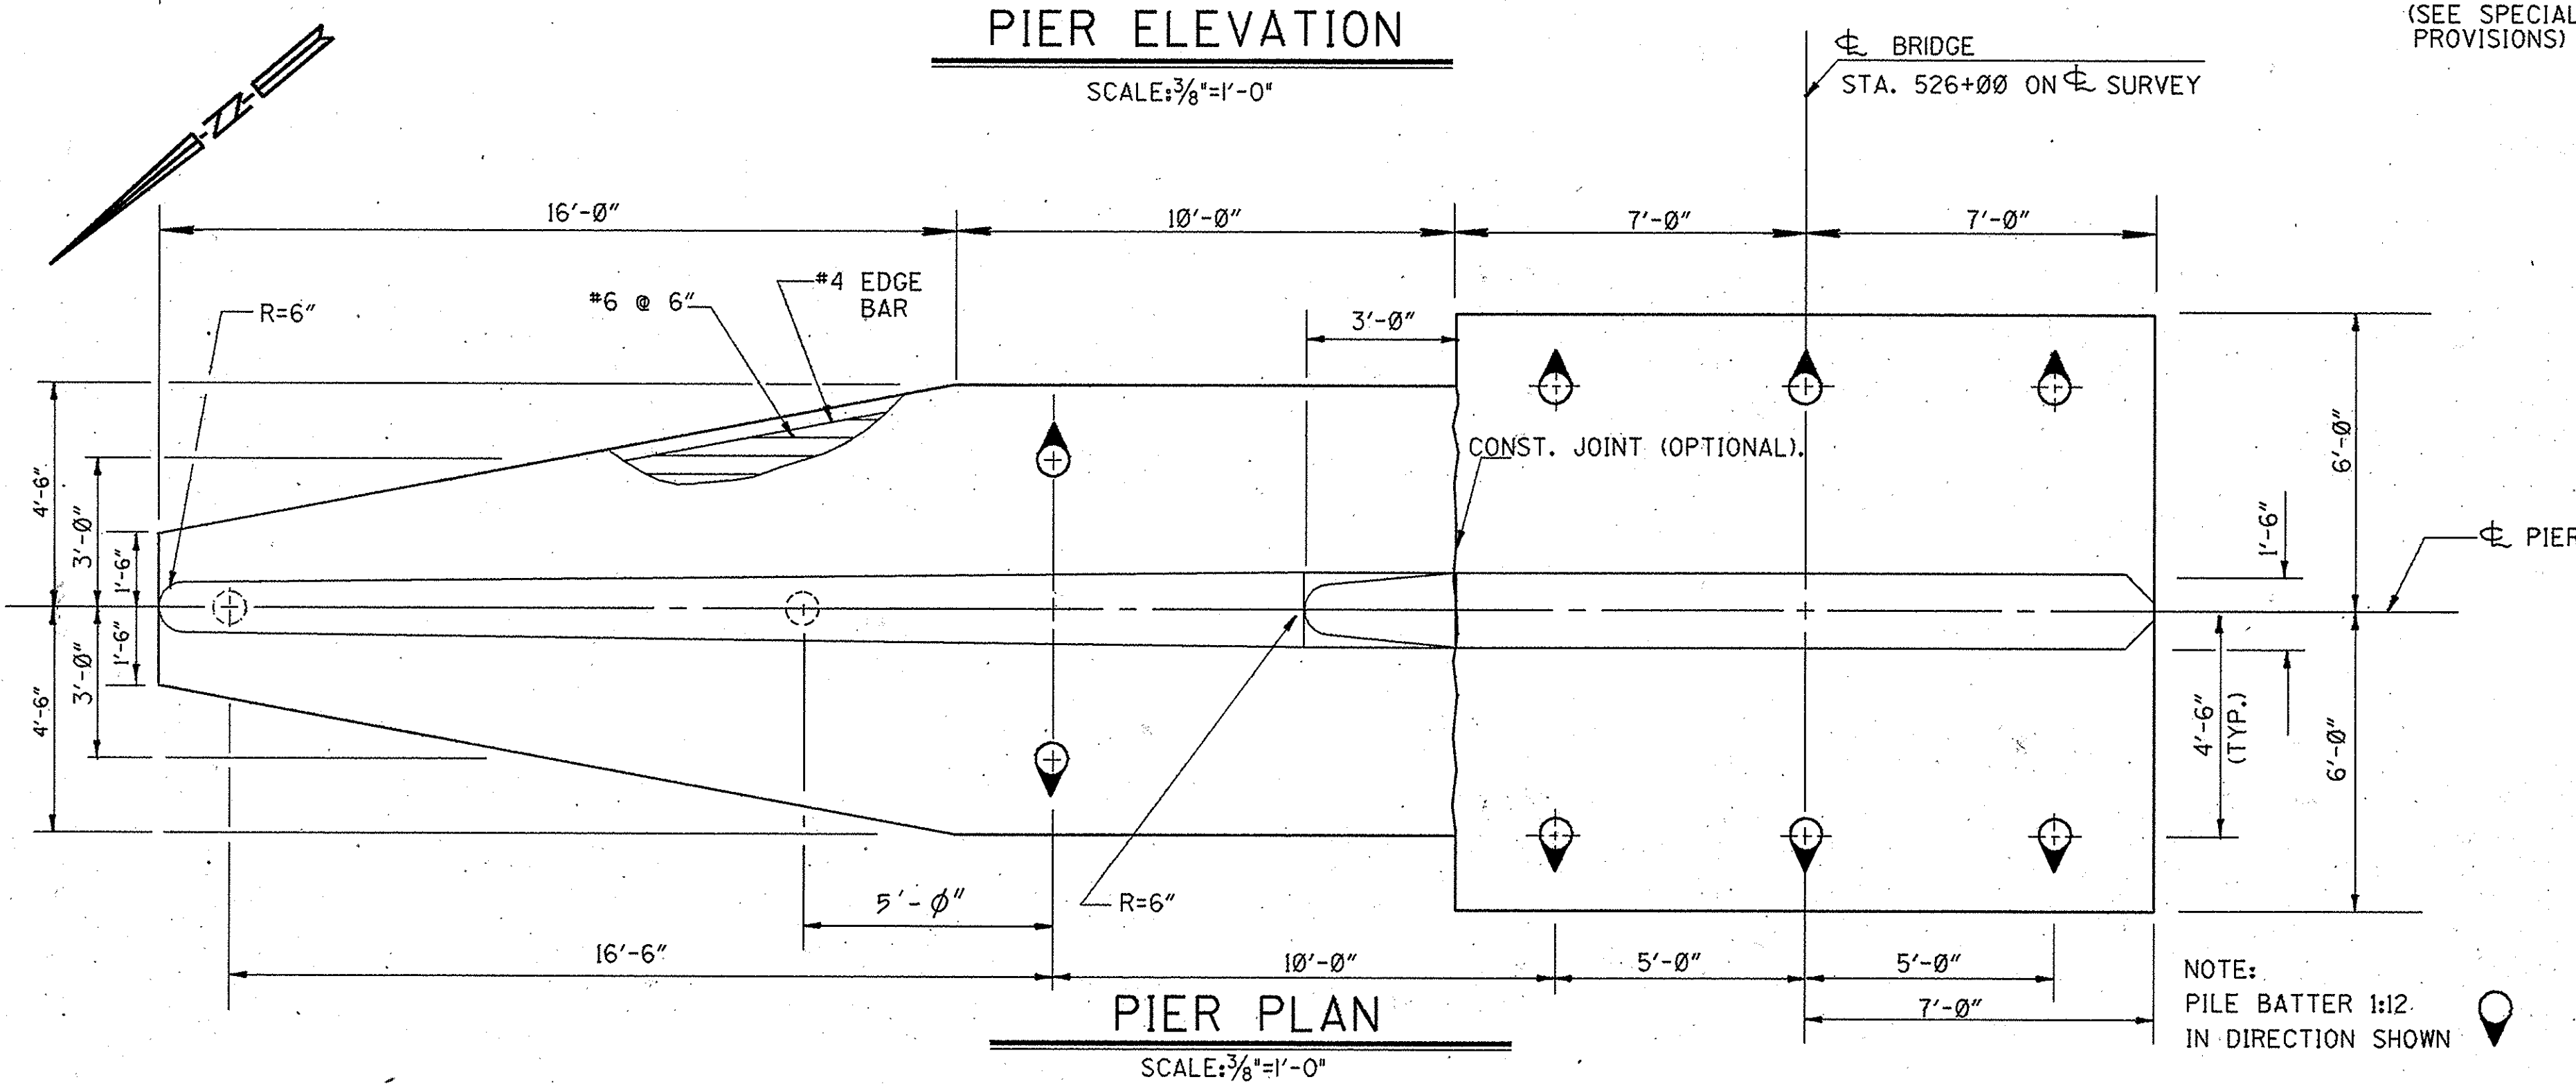
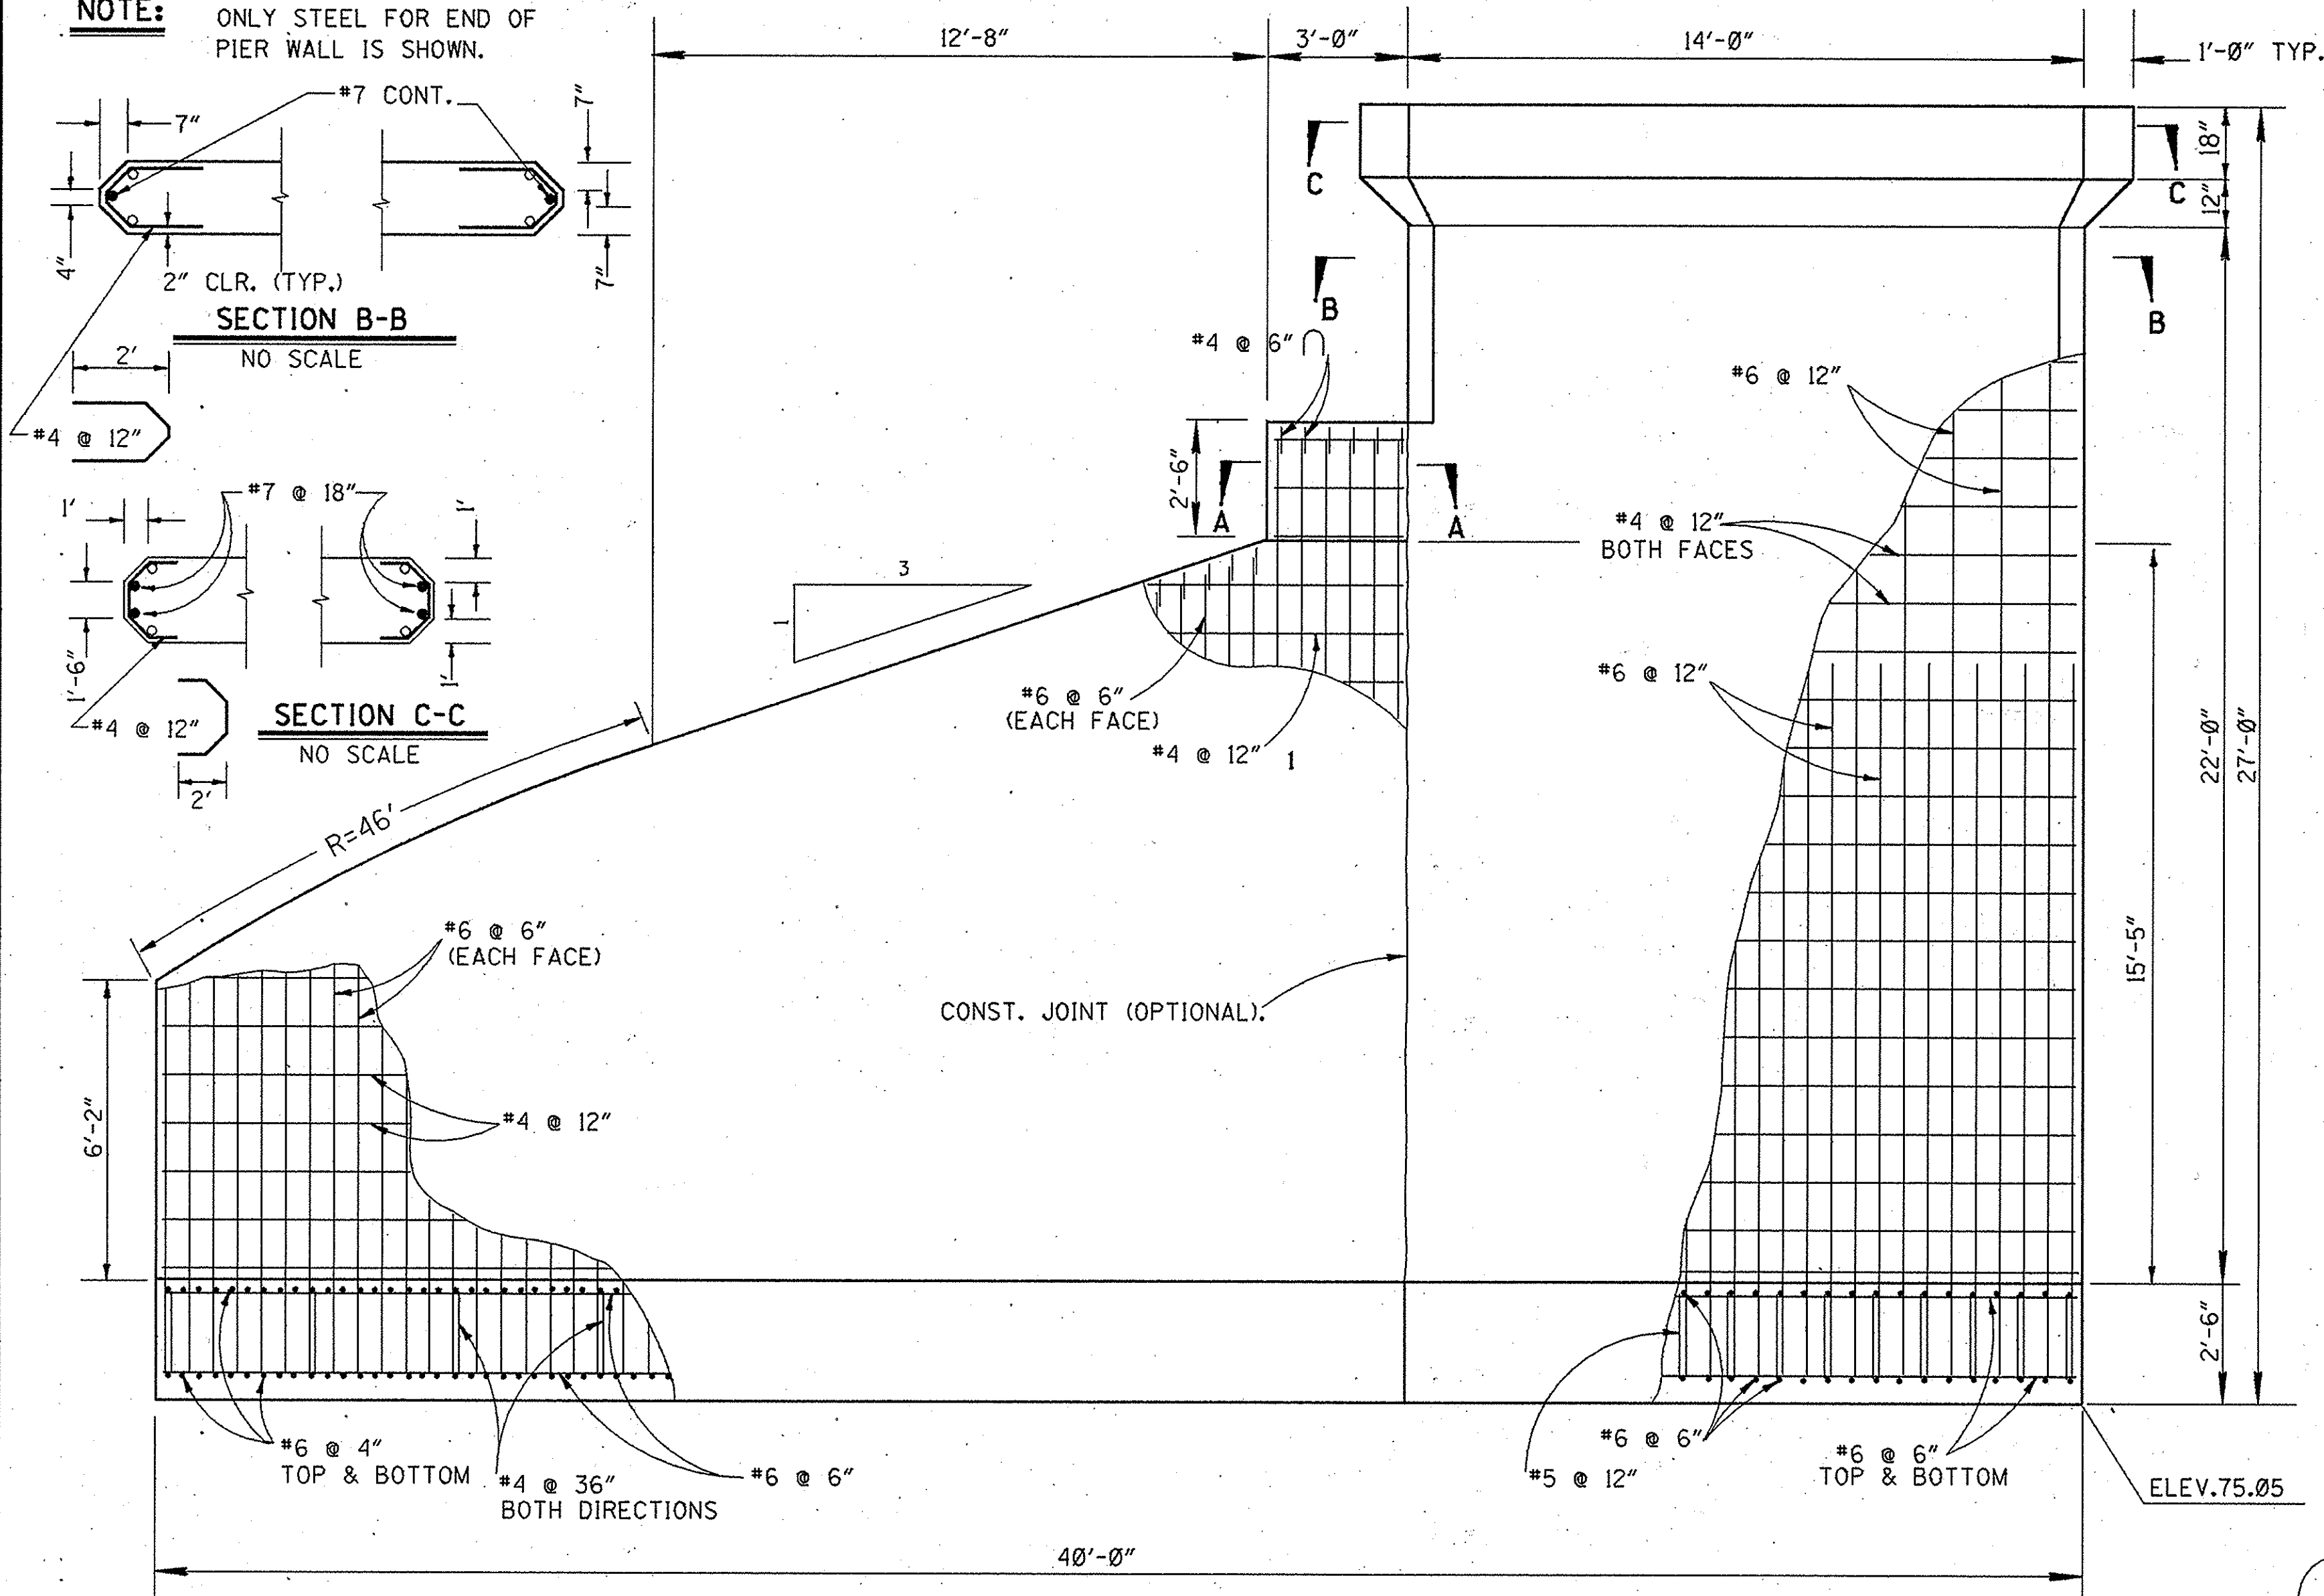
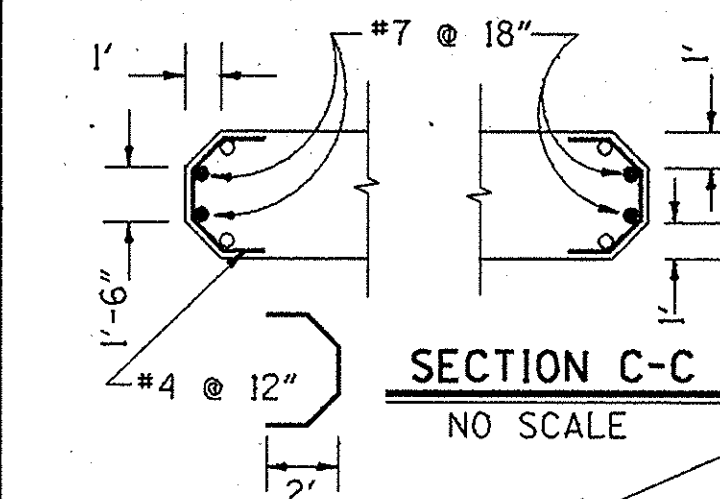
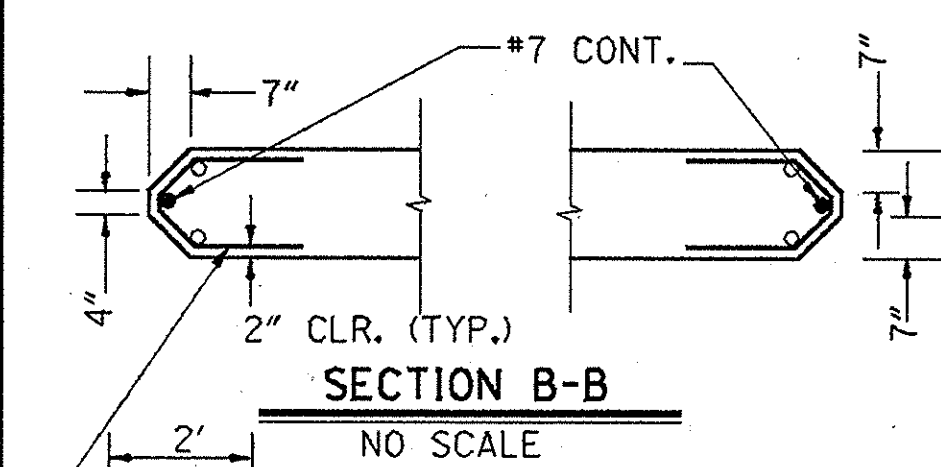
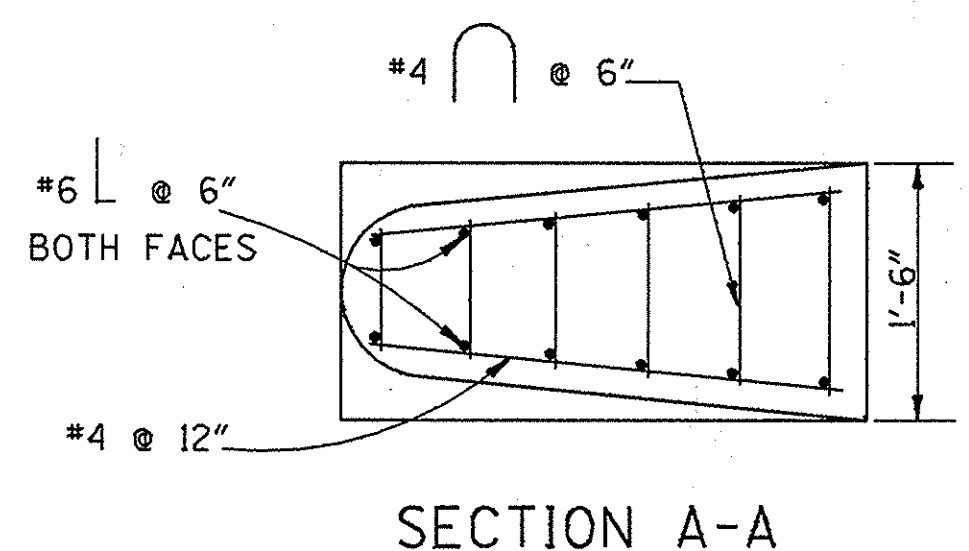
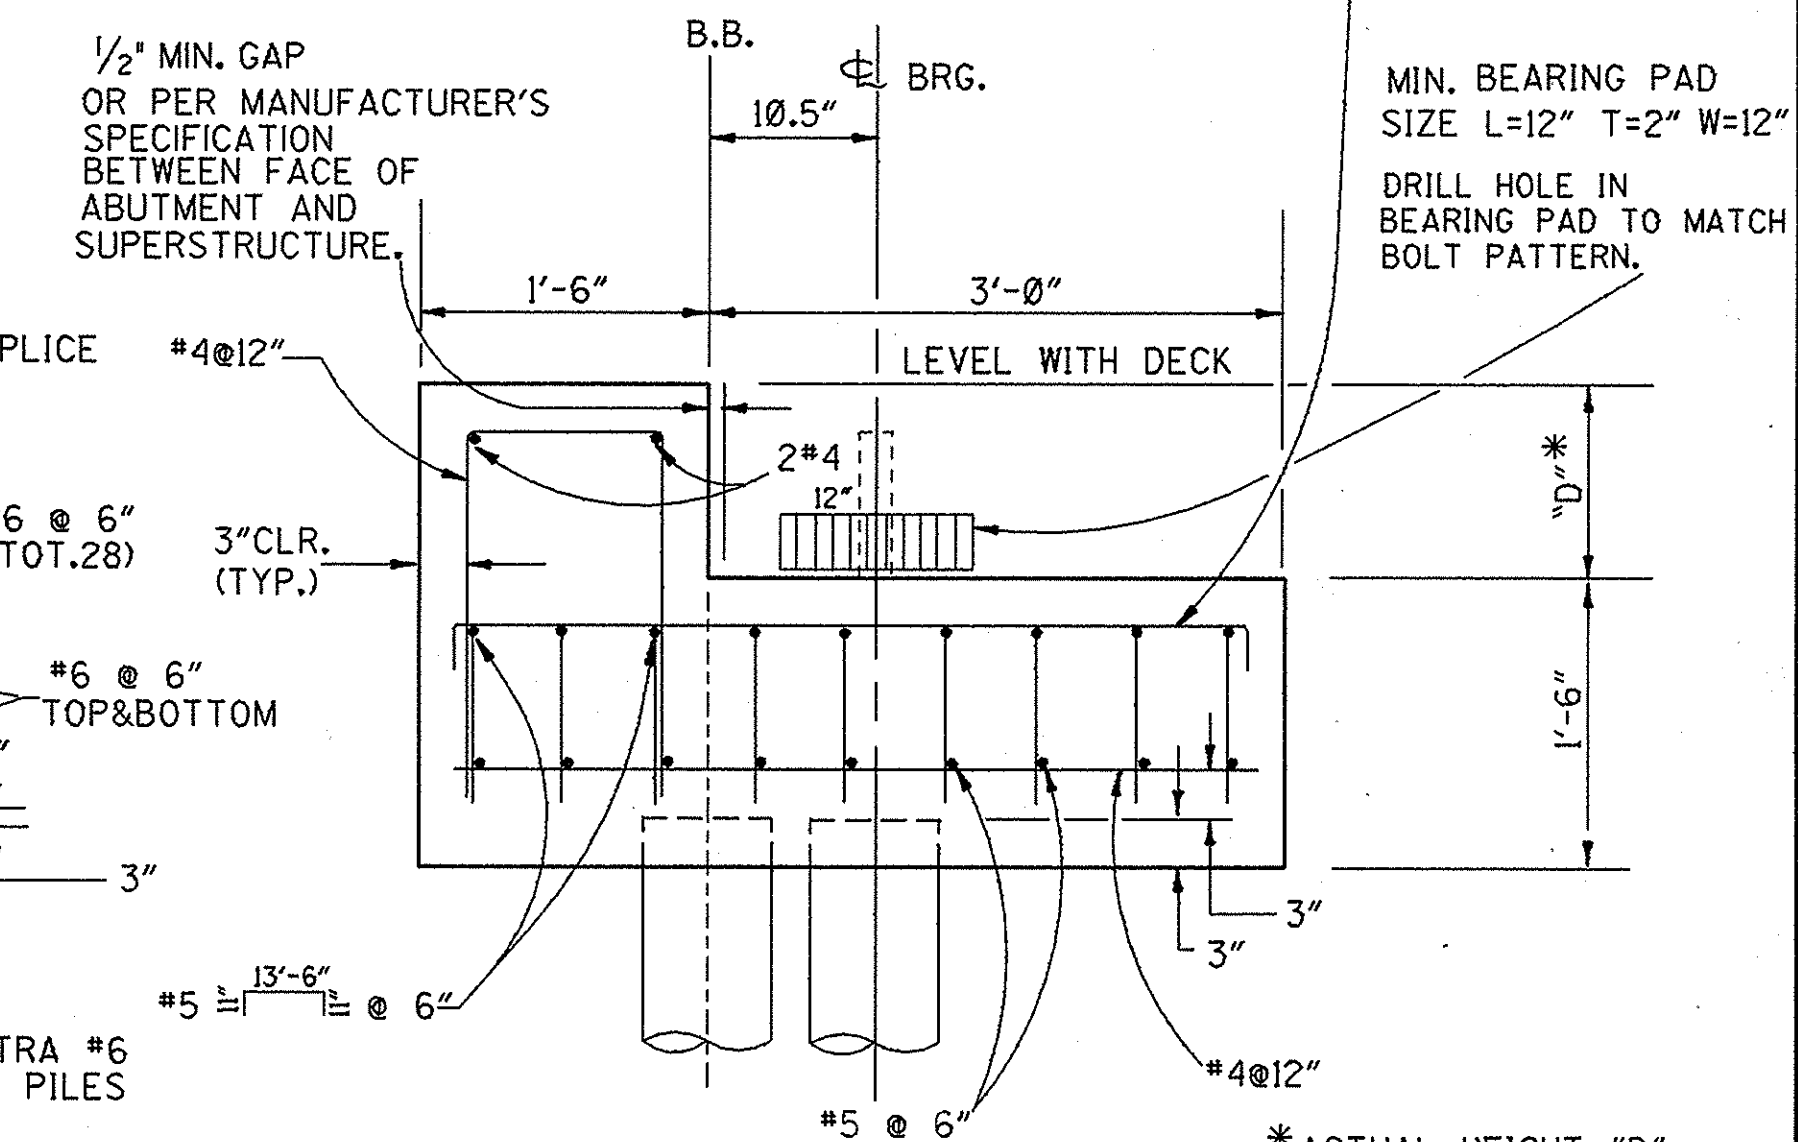
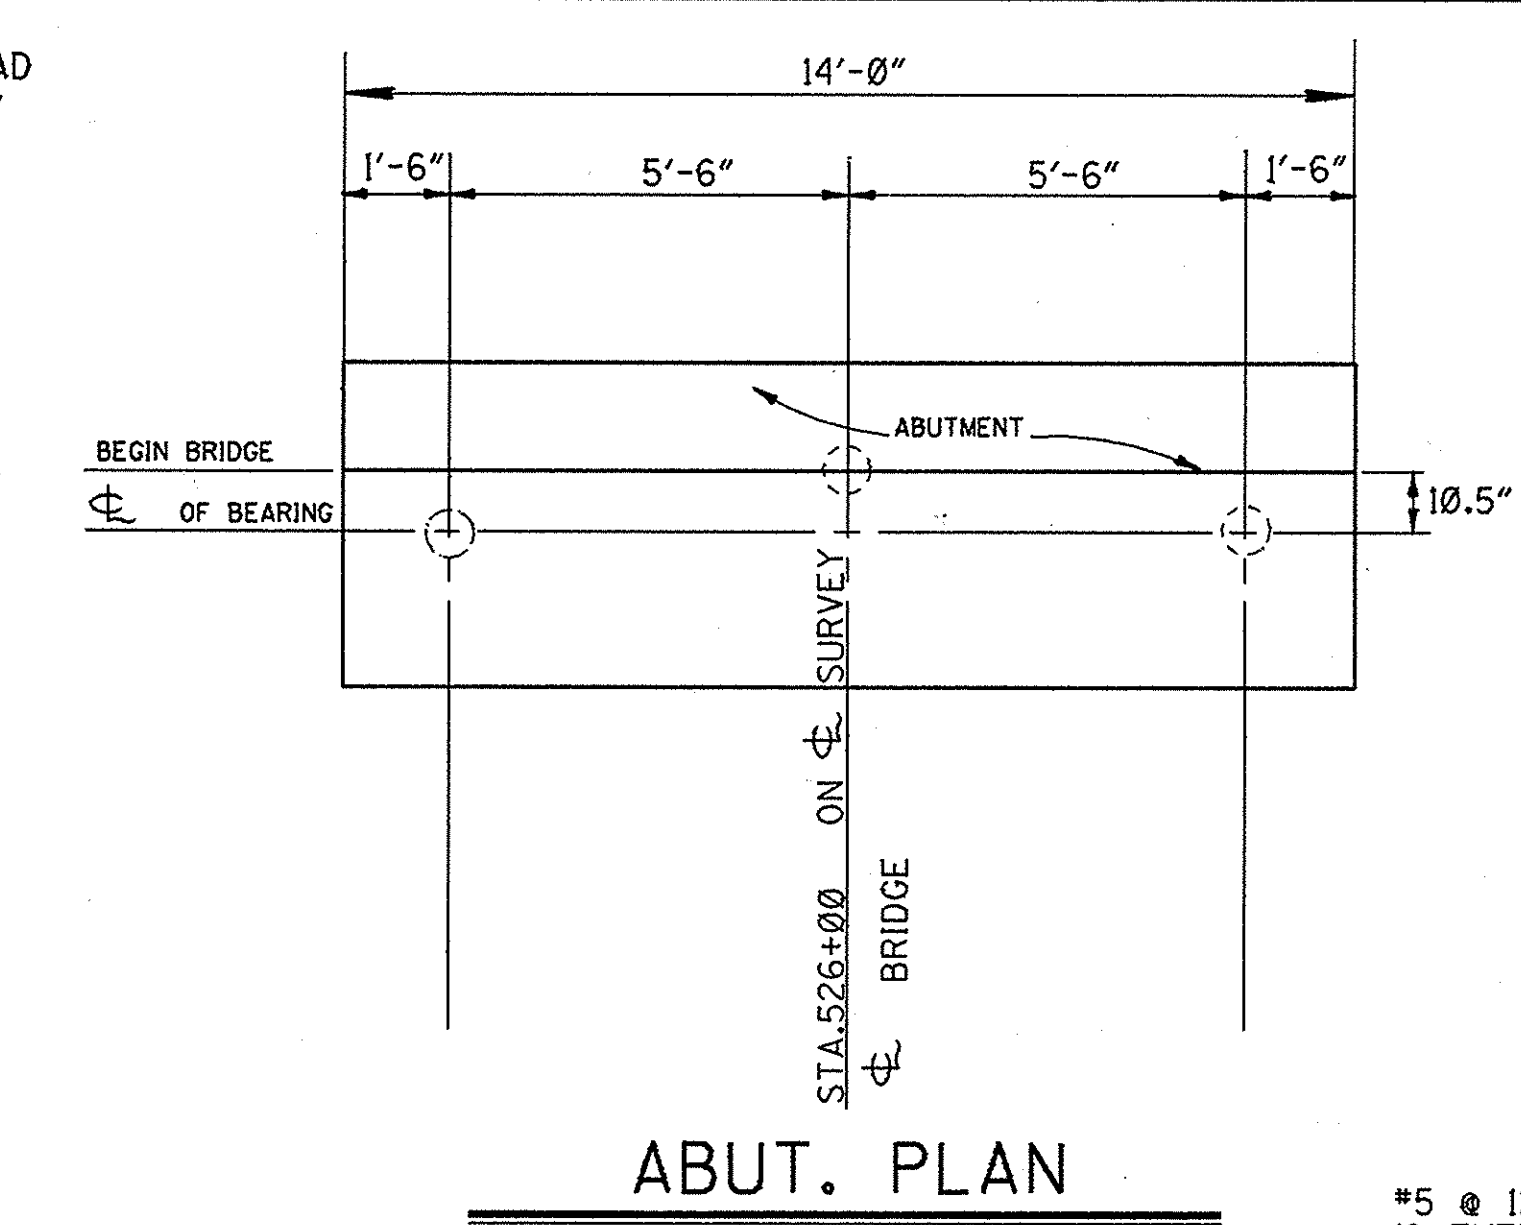
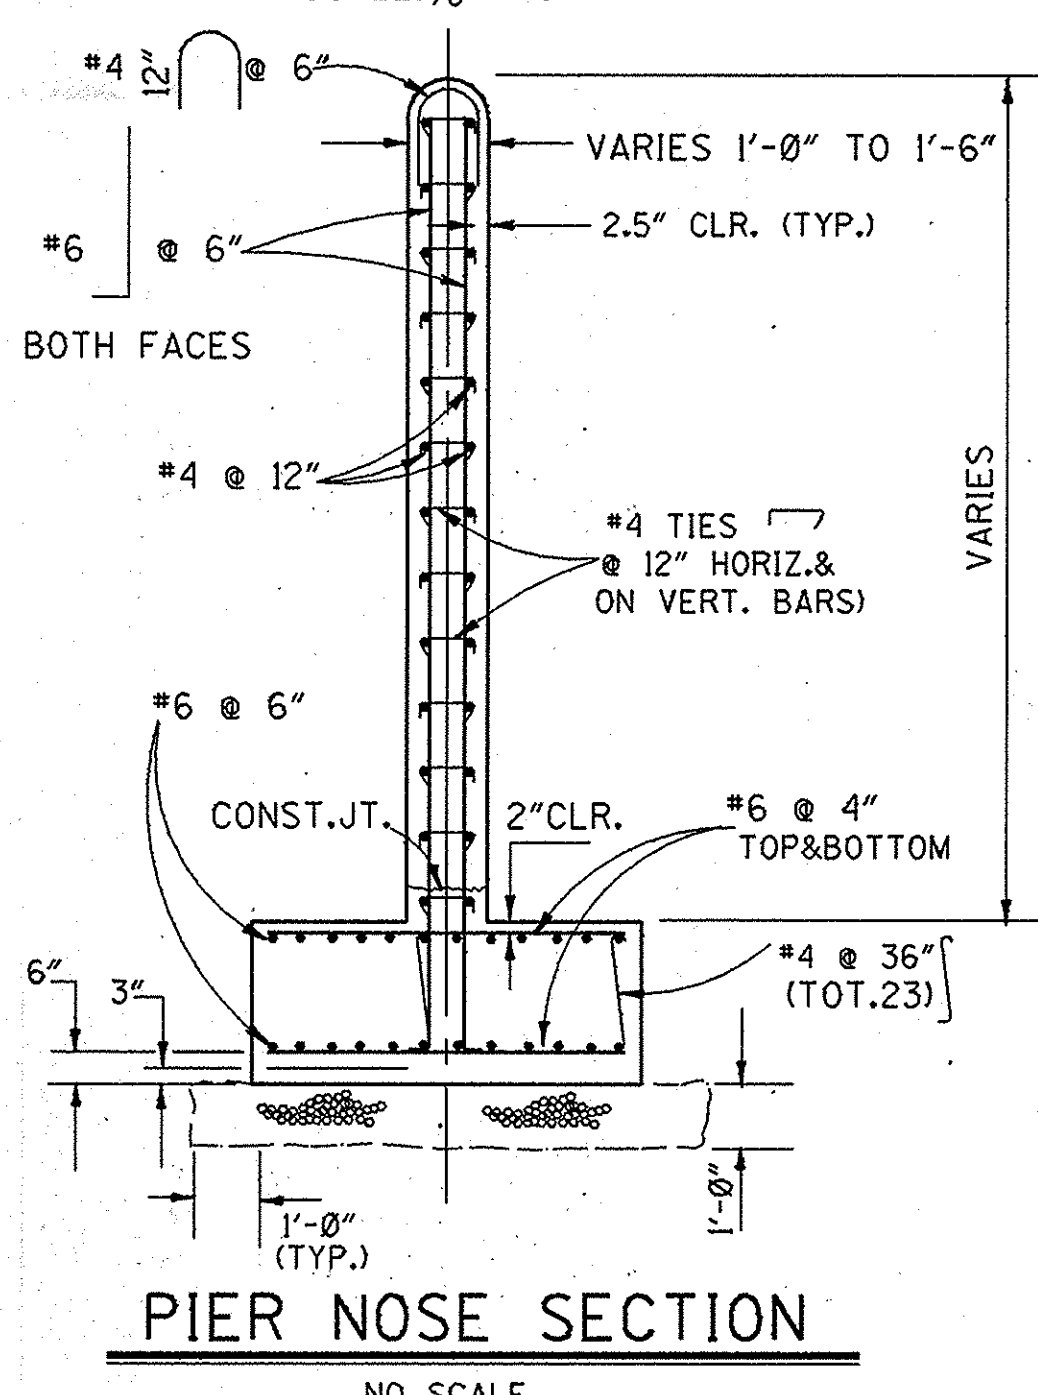


NOTE: ONLY STEEL FOR END OF PIER WALL IS SHOWN.

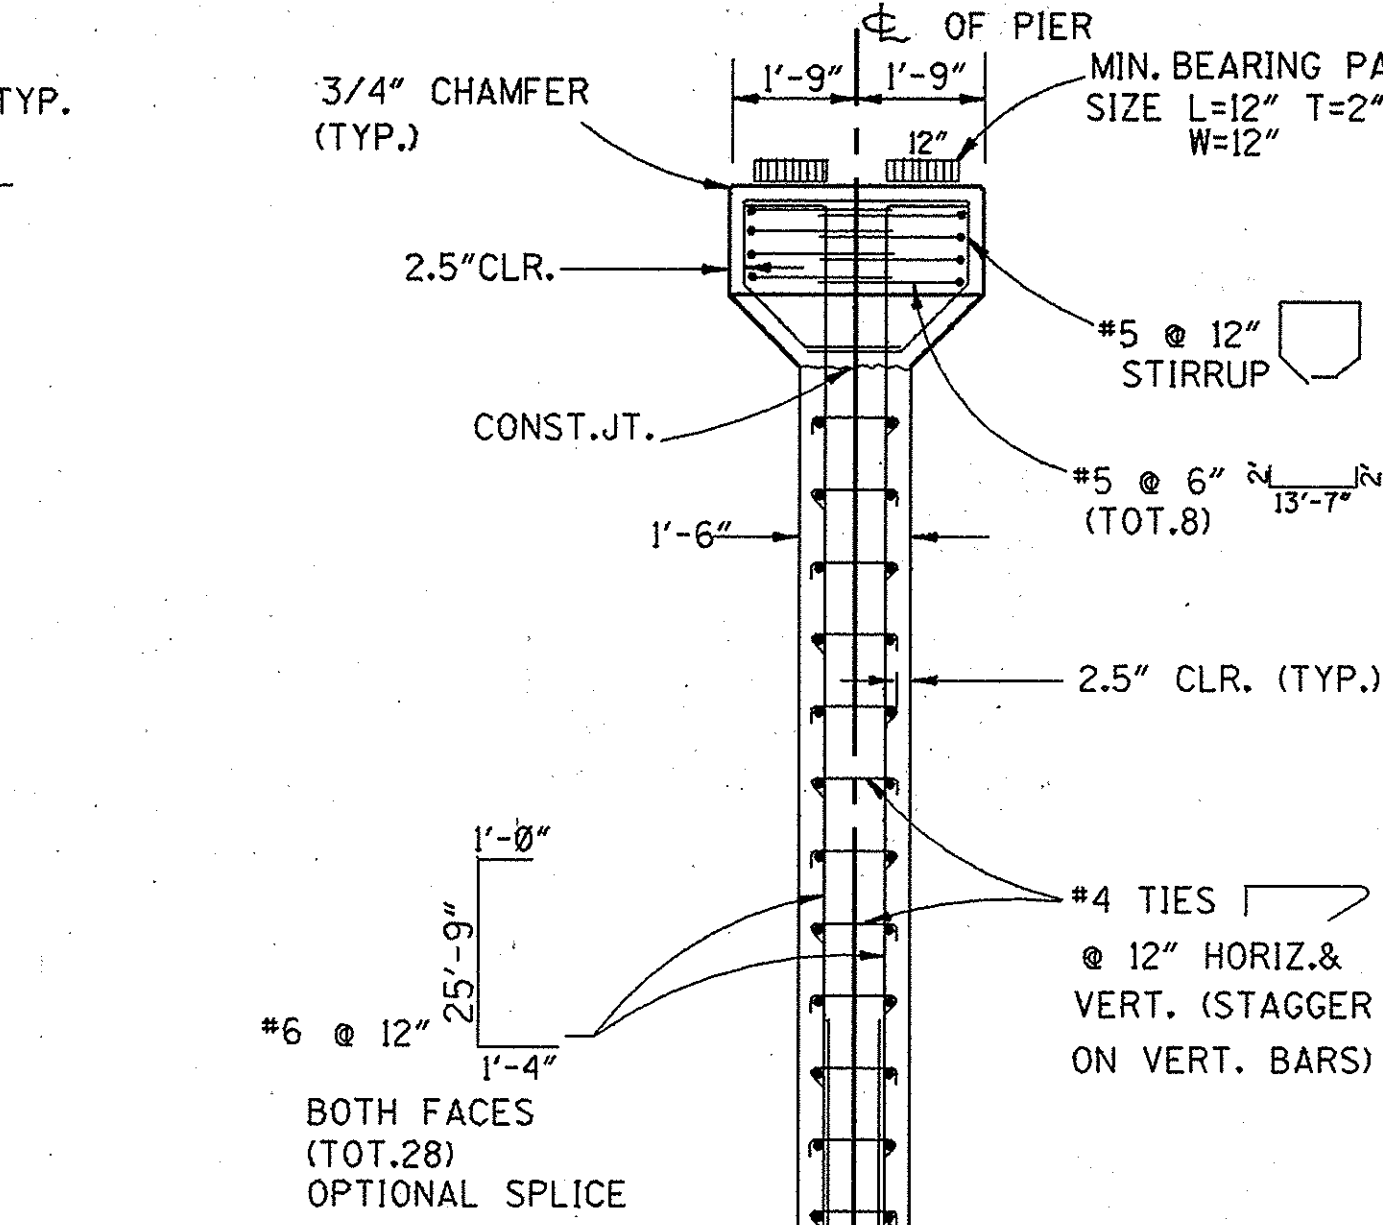

NOTE: PILE BATTER 1:12 IN DIRECTION SHOWN

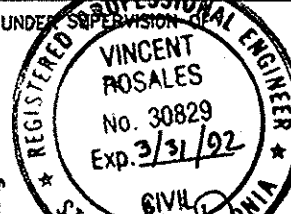

			ORANGE COUNTY ENVIRONMENTAL MANAGEMENT AGENCY
			SANTA ANA RIVER BIKE TRAIL BRIDGE NEAR 17TH STREET
MARK	DATE	DESCRIPTION	
REVISIONS			
PREPARED UNDER SUPERVISION		ABUTMENT AND PIER DETAILS	
		DESIGNED <u>N. K. PORTER</u>	
<i>Vincent Rosales</i> 7/1/88		DRAWN <u>H. PHAM/A. OLSON</u> CHECKED <u>VPR</u>	
DATE		SCALE <u>AS SHOWN</u> DATE <u>7/21/1988</u> DRAWING NO.	
		SHEET <u>4</u> OF 6	