


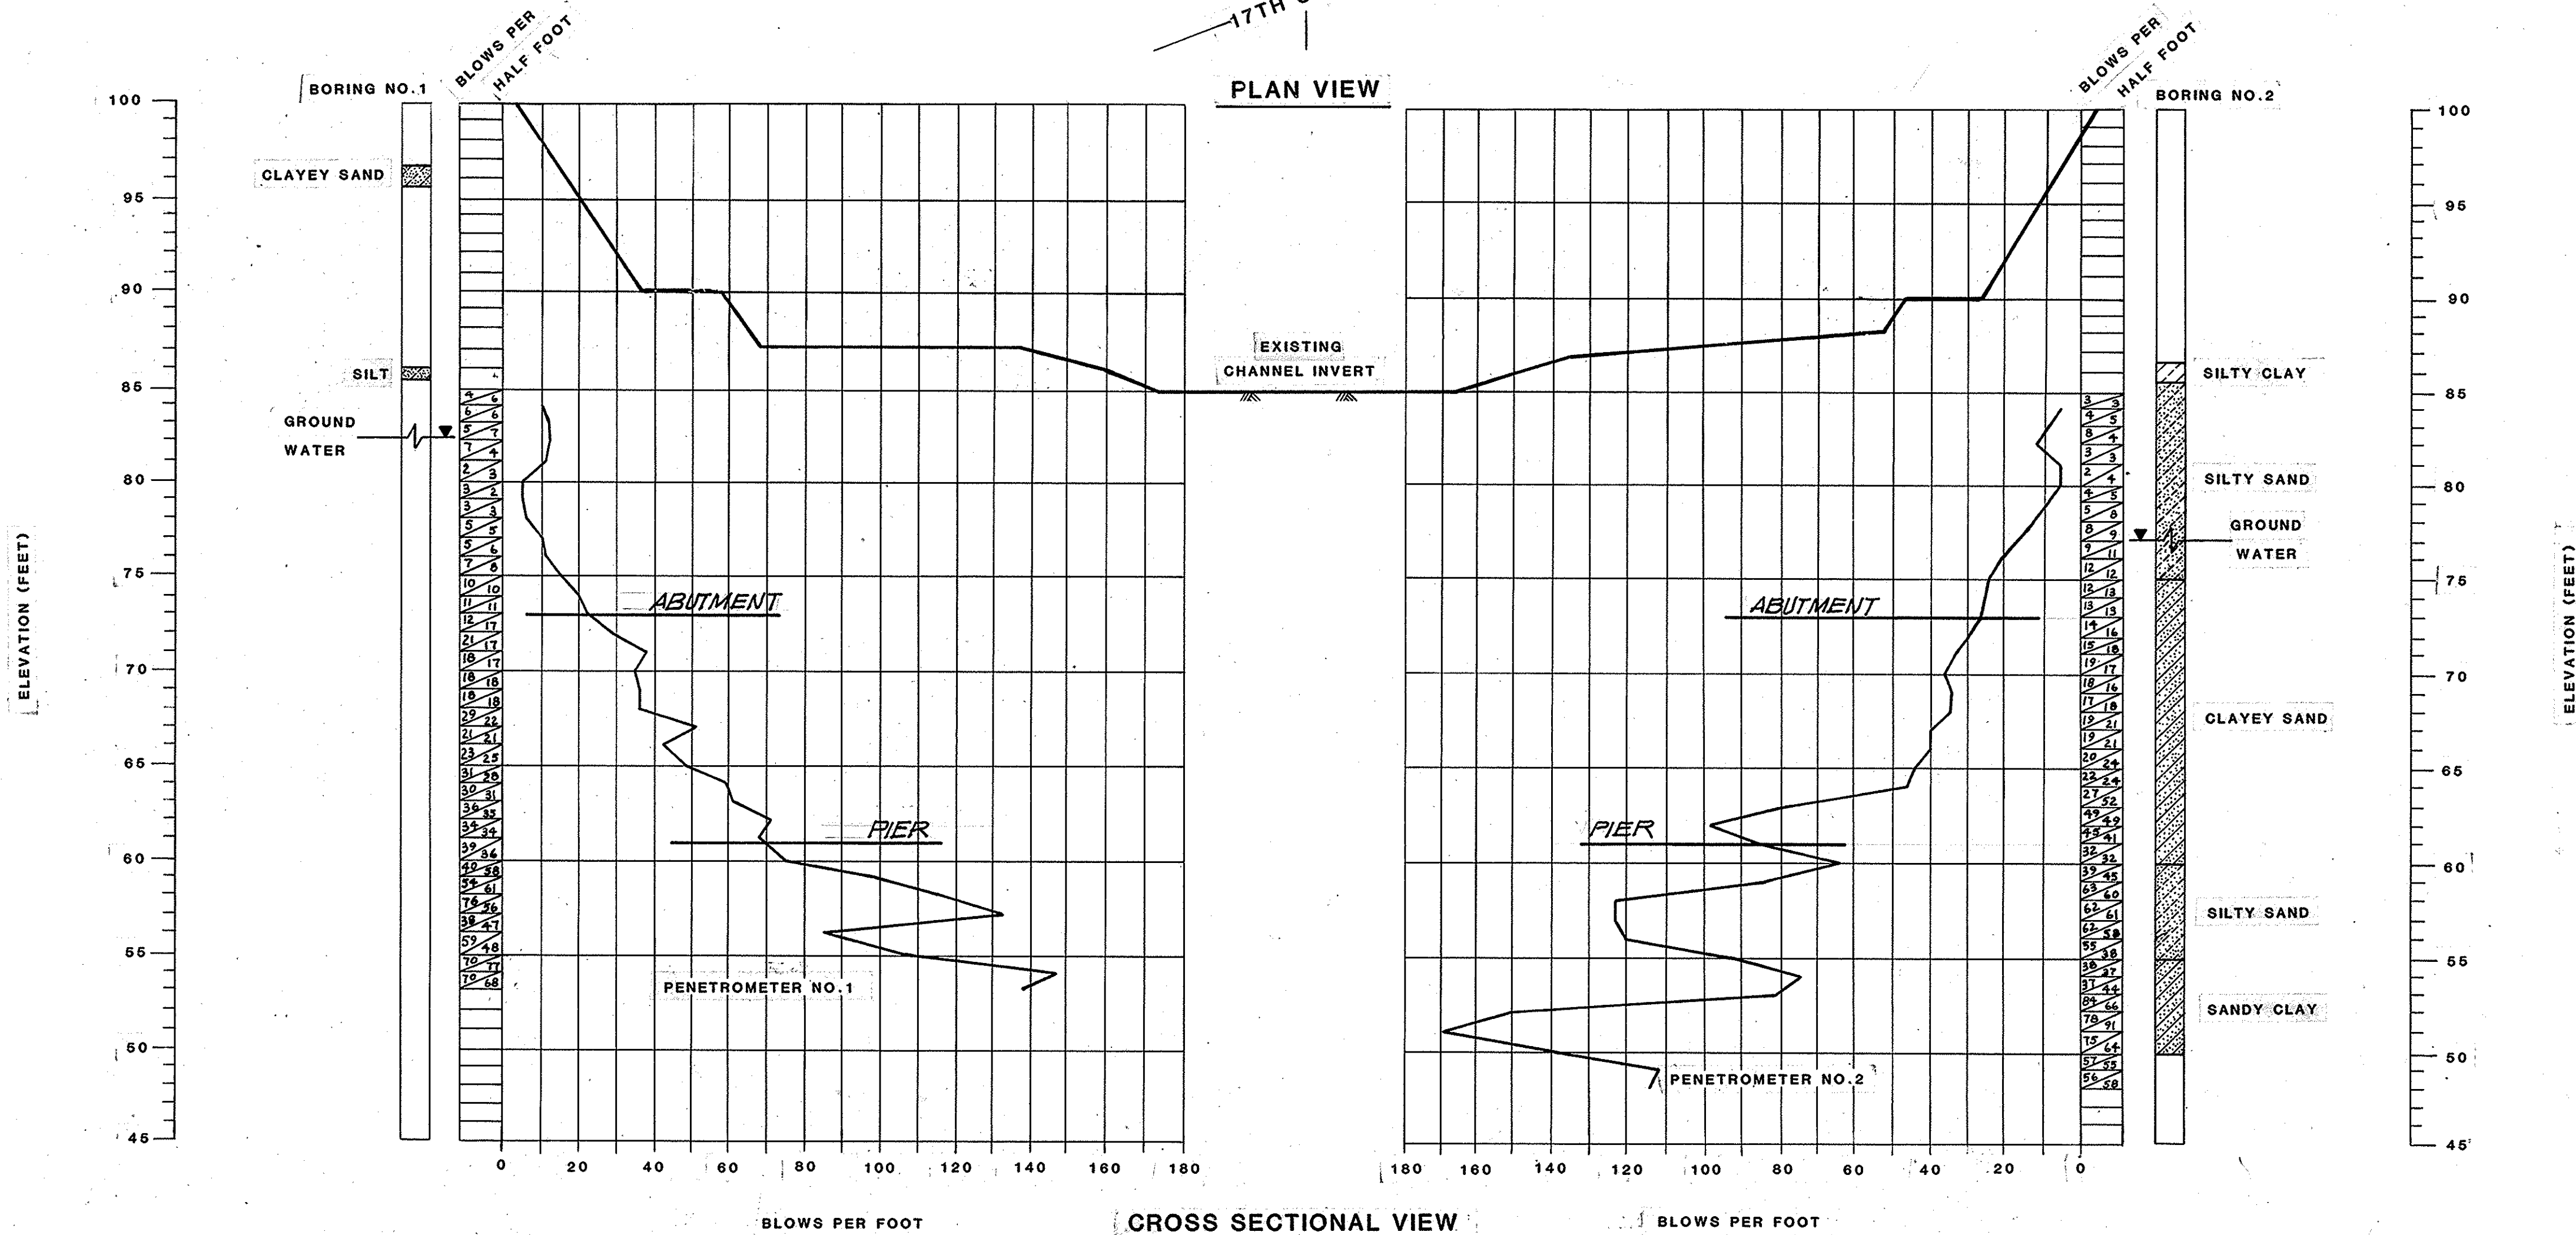


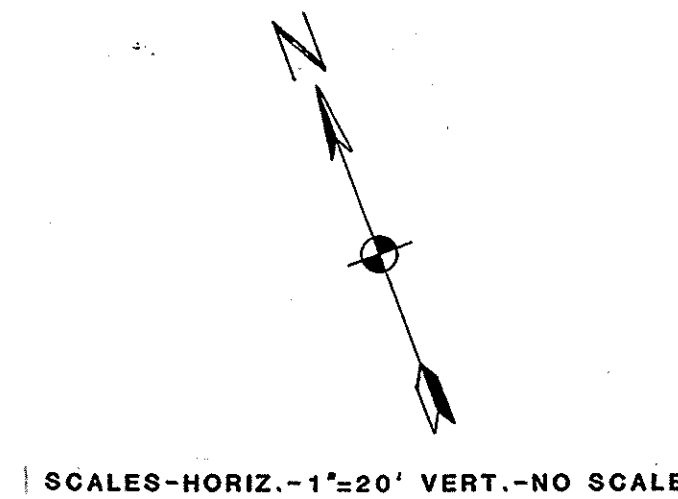


NOTE :
 SOIL PENETROMETER TESTS TAKEN PER STATE OF CALIFORNIA TESTING METHOD . PLOT OF DEPTH (FEET) VS. PENETRATION (SECONDS PER FOOT)
 DATE OF SOIL BORINGS : MARCH 8 & 9 , 1988 .

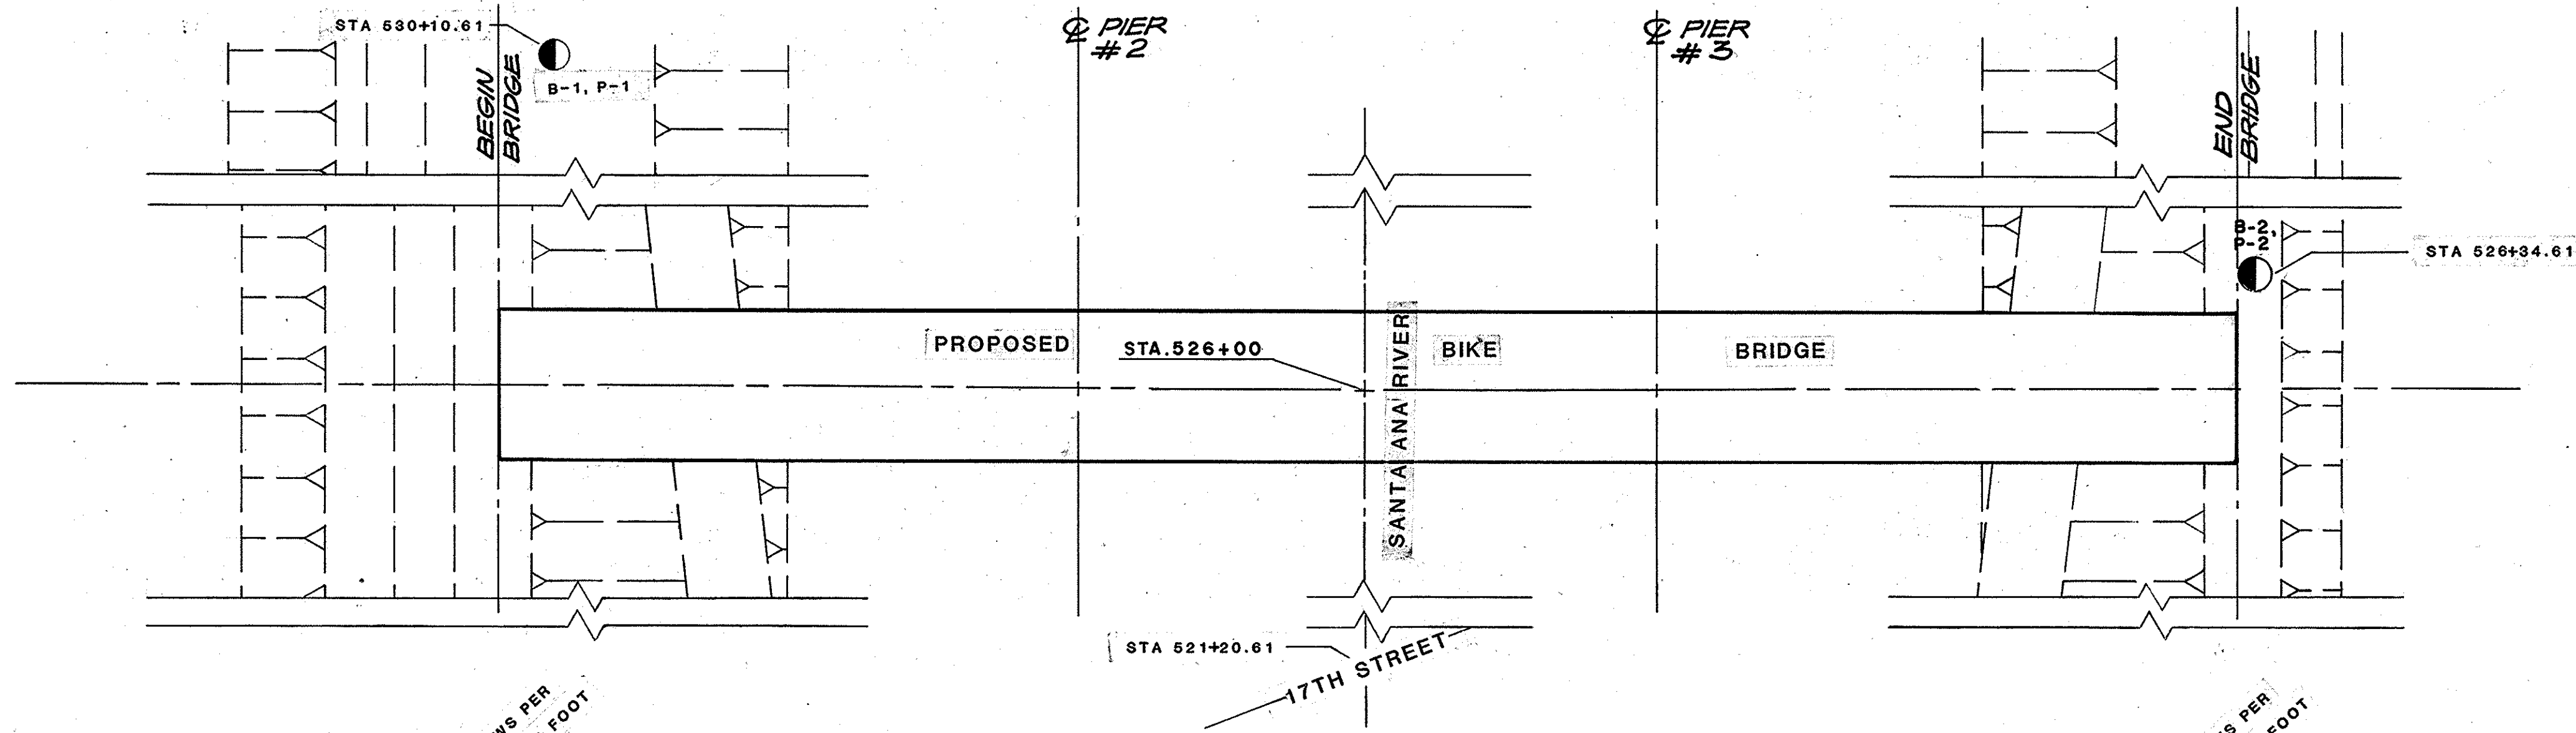

LEGEND OF EARTH MATERIALS

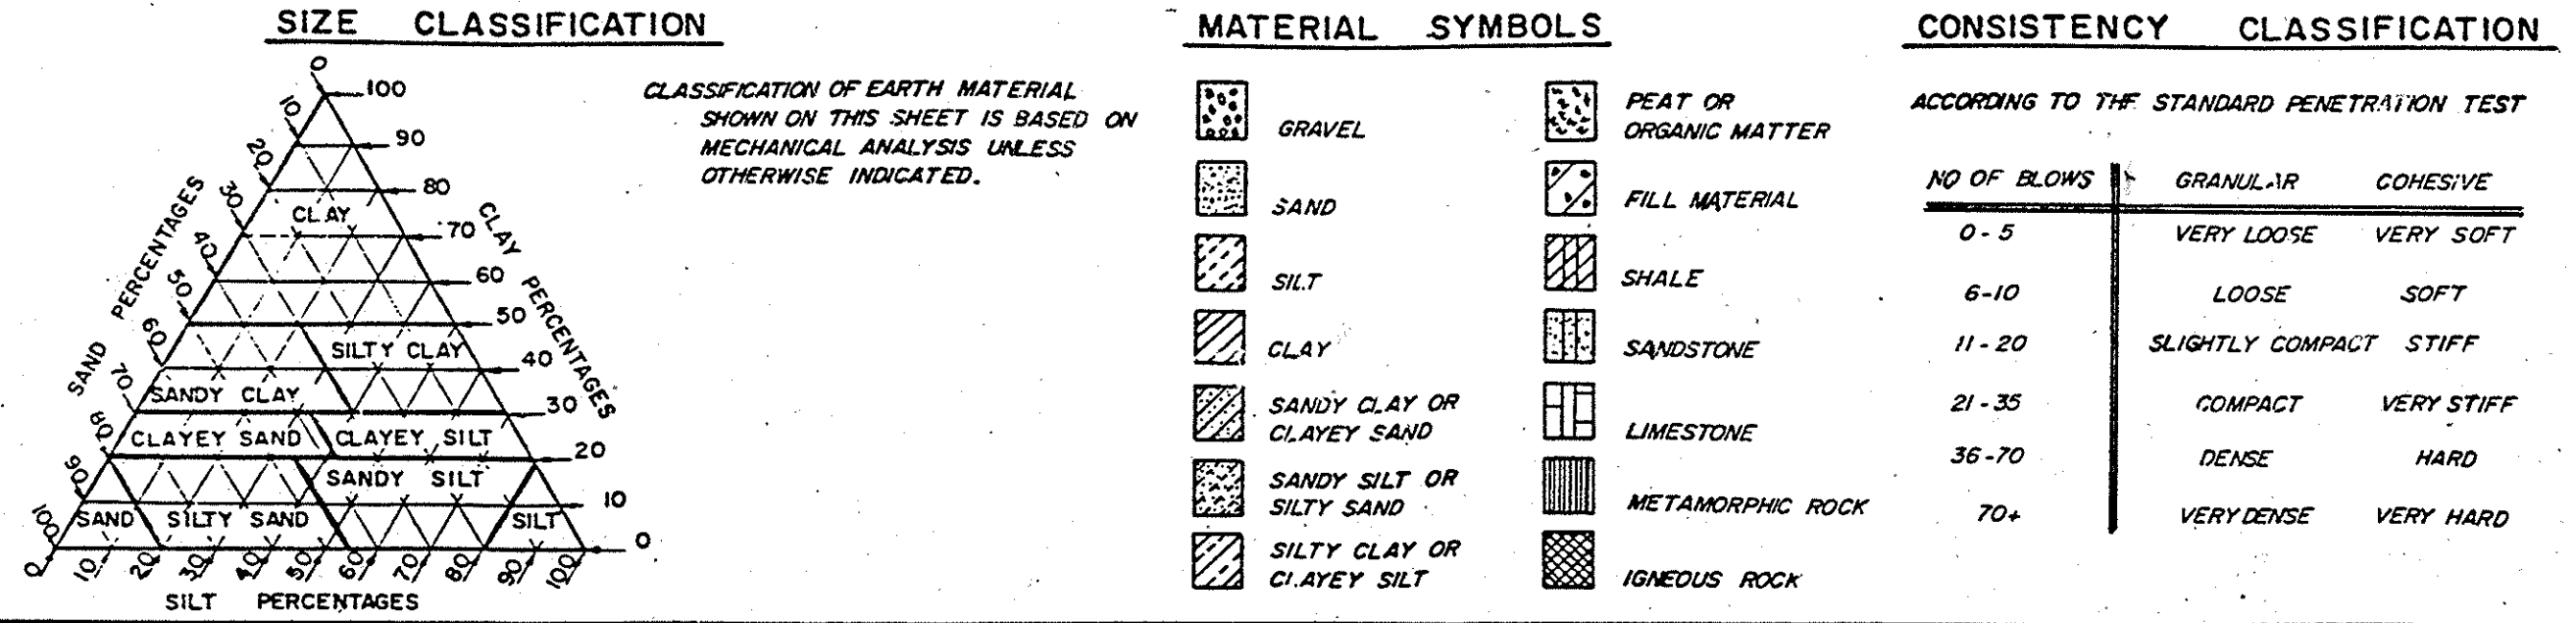

LEGEND OF BORING OPERATIONS

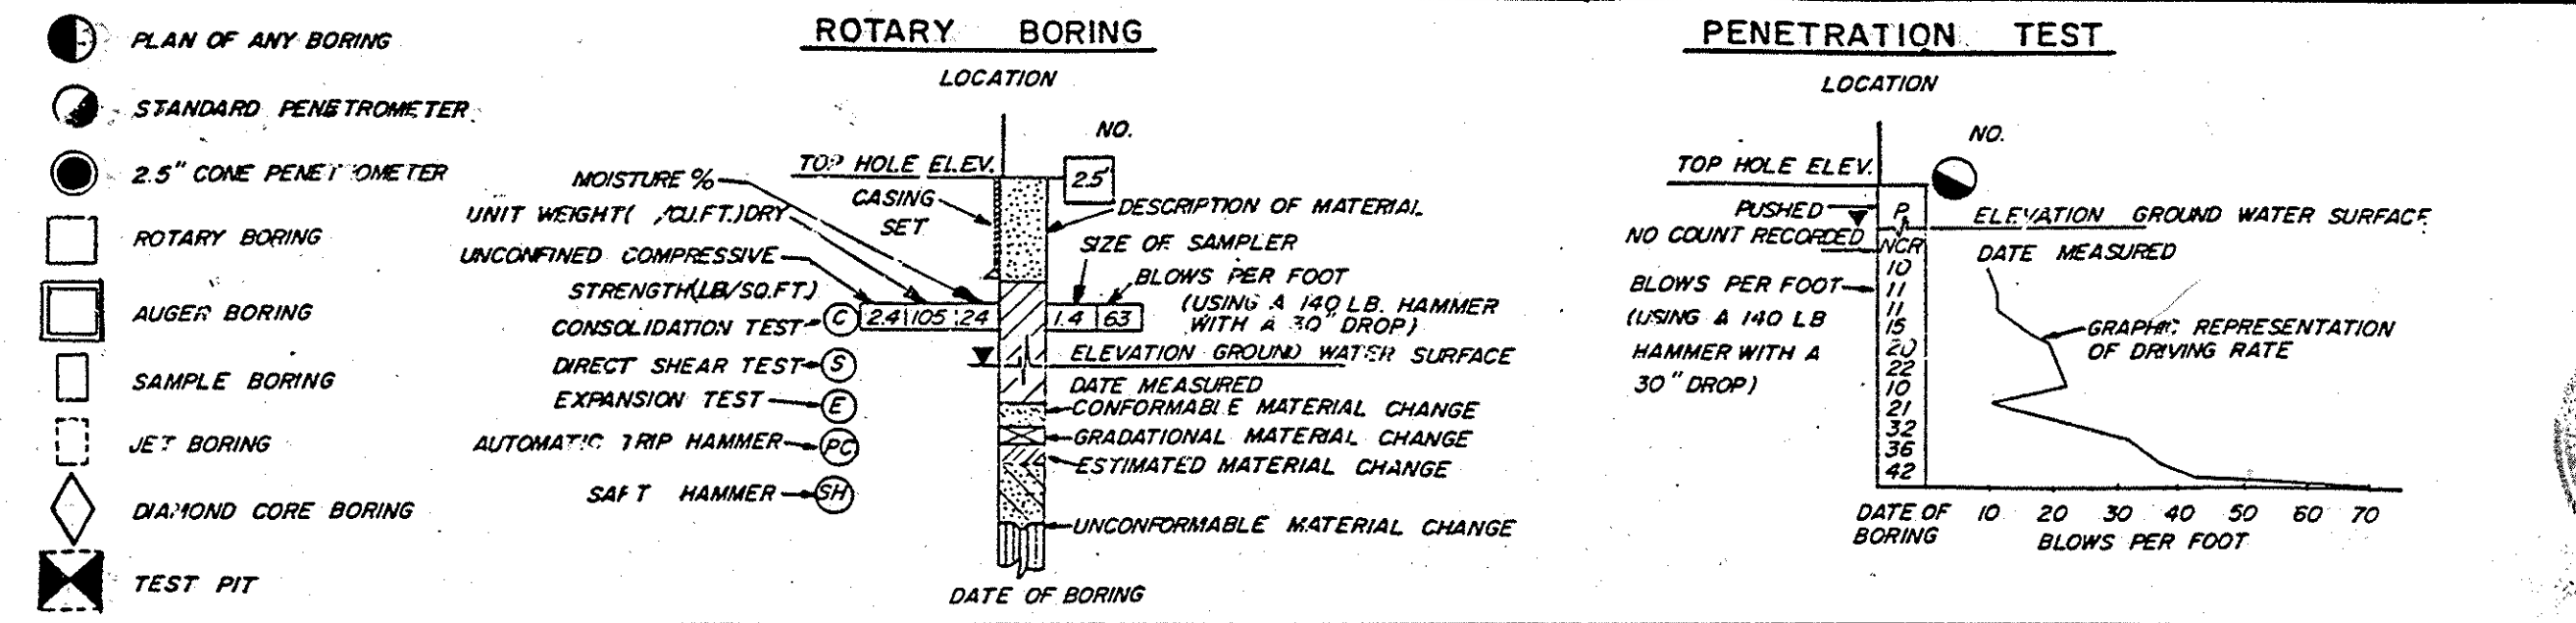

ORANGE COUNTY
 ENVIRONMENTAL MANAGEMENT AGENCY

SANTA ANA RIVER BIKE
 TRAIL BRIDGE NEAR
 17TH STREET

LOG OF TEST BORING

MARK	DATE	DESCRIPTION	PREPARED UNDER SUPERVISION OF	SHEET
			Edward Kwan	5
REVISIONS			SCALE	DATE
DESIGNED BY: L.L.			DWG. NO.	OF 6
DRAWN BY: T.S.W.			CHECKED BY: M.Y.K.	AS SHOWN