



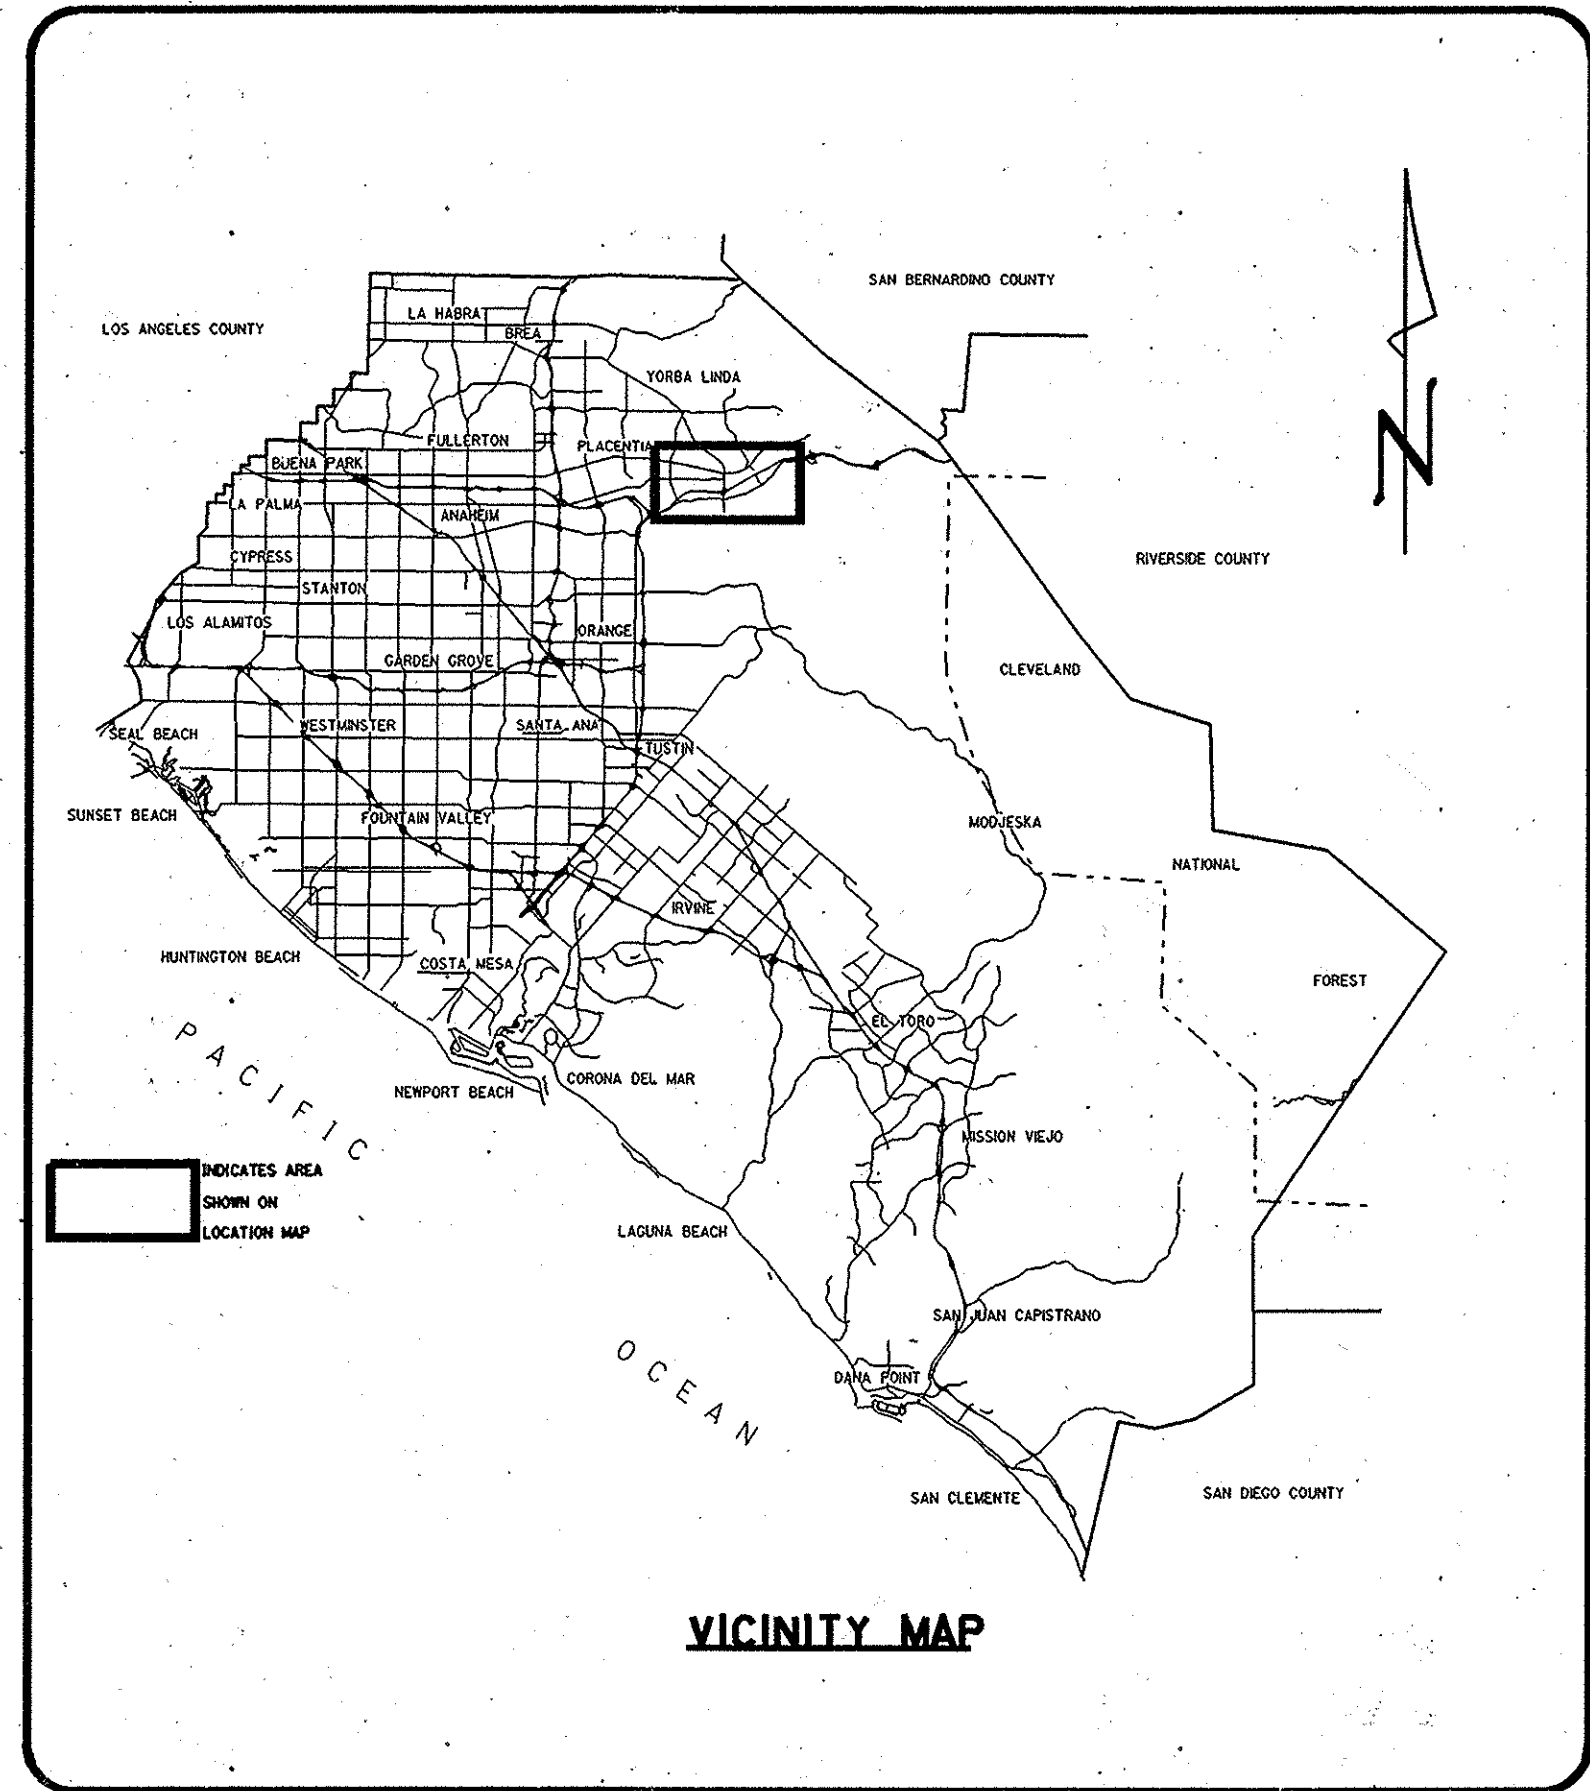


ORANGE COUNTY
ENVIRONMENTAL MANAGEMENT AGENCY
SANTA ANA, CALIFORNIA
MICHAEL M. RUANE, DIRECTOR

PLANS FOR CONSTRUCTION OF
**SANTA ANA RIVER
BIKE TRAIL BRIDGE**

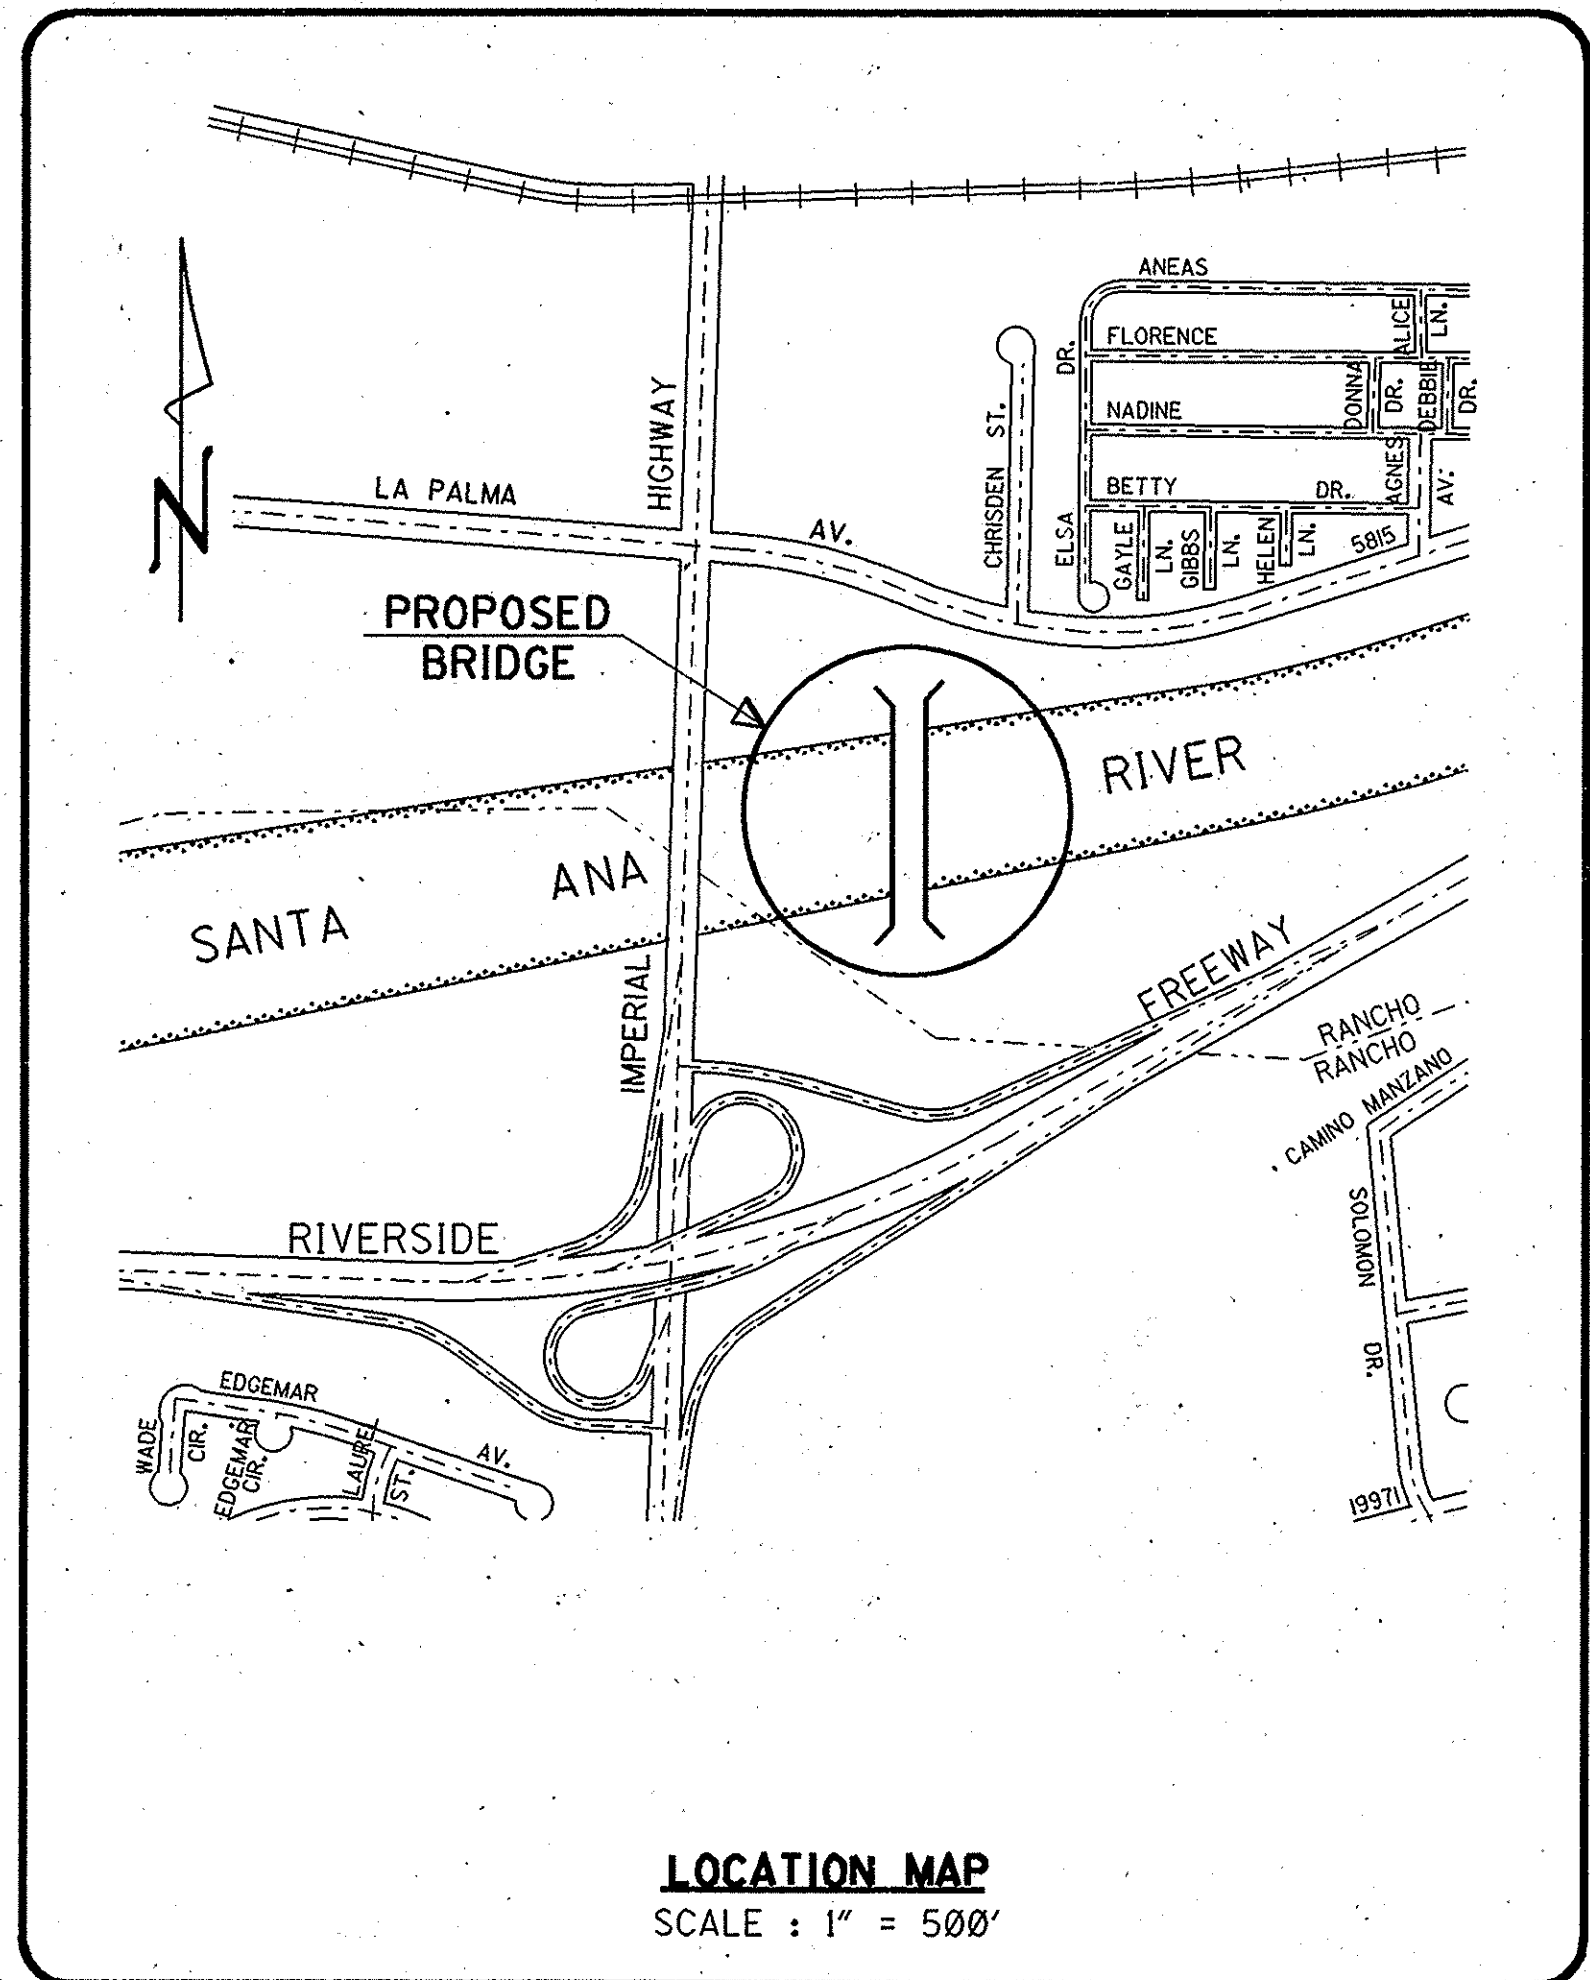

428 FT U/S OF
IMPERIAL HWY
MAY 1992

FUNDED BY: S.B.821

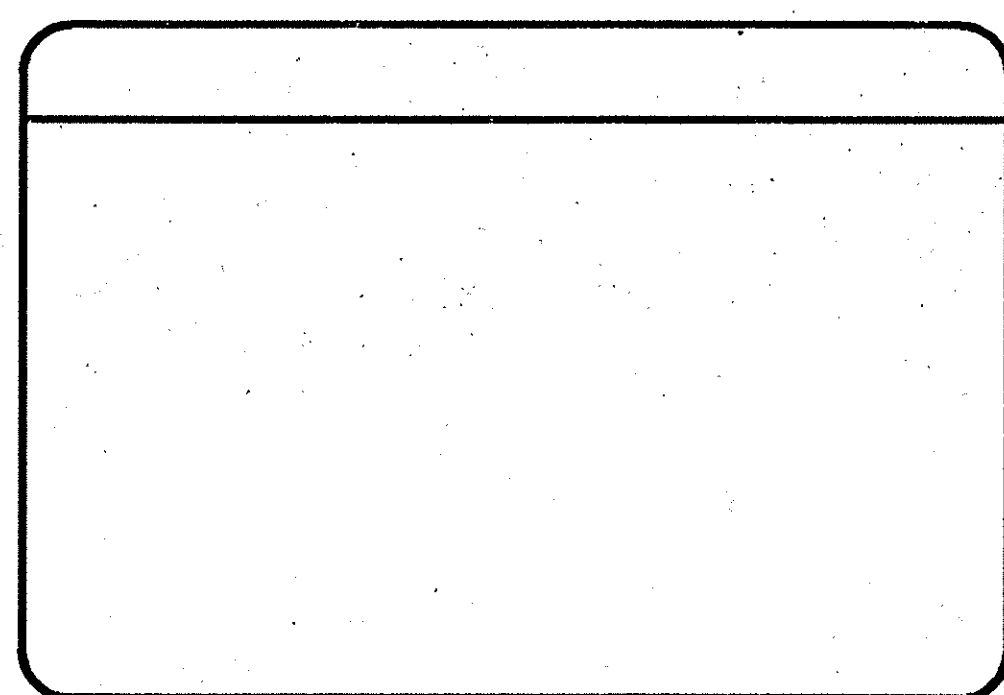

SUBMITTED: *Vincent Road*
CHIEF, ROAD DESIGN

RECOMMENDED: *James W. Williams*
MANAGER, DESIGN DIVISION

APPROVED: *William Brown*
DIRECTOR OF PUBLIC WORKS

REGISTERED PROFESSIONAL ENGINEER
No. 30829
Exp. 3-31-94
CIVIL
DATE 4-22-92

REGISTERED PROFESSIONAL ENGINEER
No. 13154
Exp. 3-31-93
CIVIL
DATE 4-22-92

AS BUILT
9/6/95

RECORD DRAWINGS

CONTRACTOR : SOUTH UNDERGROUND CONST.

INSPECTOR : CARLOS A LOPEZ

COMPLETION DATE : FEB. 2, 1993

INDEX OF SHEETS	
SHEET	DESCRIPTION
1	TITLE SHEET
2	GENERAL PLAN
3	PIER WALL
4	ABUTMENT & TRAIL IMPROVEMENTS
5	LOG OF BORINGS
1-8 SHOP DRAWINGS	
E1 SHOP DRAWINGS	
S-1 to S-3 SHOP DRAWINGS	
TOTAL: 17 SHT.	

UTILITY OWNER	PHONE NO.	CONTACT
UNDERGROUND SERVICE ALERT	1-800-422-4133	

BENCH MARK:
O.C.S. BM 2J-44-71, 1976 ADJ
TAKEN AS ELEV. 283.208

BASIS OF BEARINGS:
CENTERLINE OF SANTA ANA
RIVER FROM CORP OF ENGI-
NEERS GDM N'LY OF IMPE-
RIAL HIGHWAY TAKEN AS
N78°15'20"E

NO.	DESCRIPTION	SHT.	APPROVED	DATE
1	CHANGE ELEV. OF BOT. OF PIER WALL FOOT. REVISE AS SHOWN	3	AS BUILT	9/6/95
REVISIONS				

W. O. NO. R09738
DWG. NO.

SHEET 1 OF 5/17A