


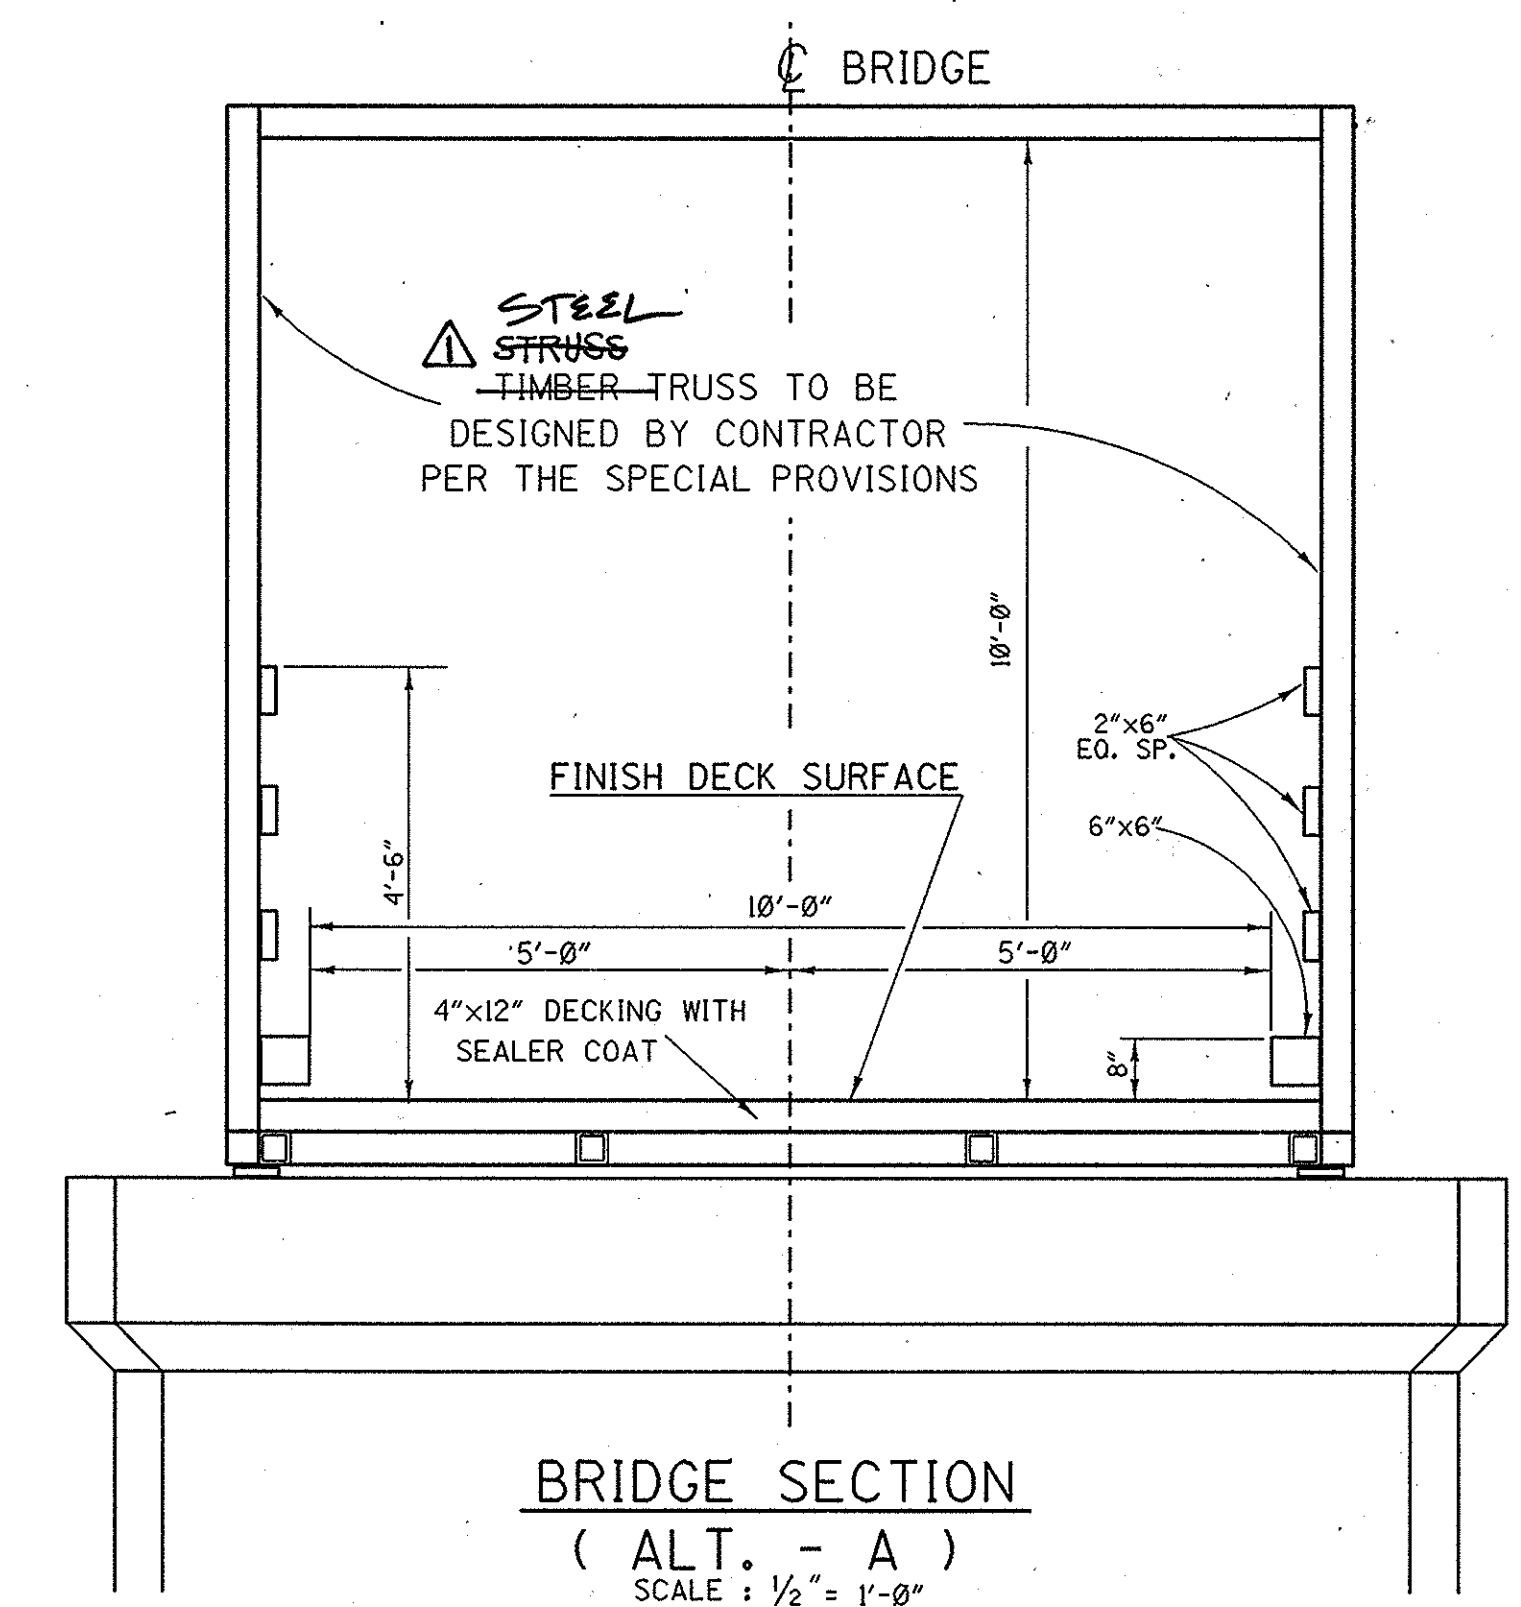

BRIDGE

TIMBER TRUSS TO BE DESIGNED BY CONTRACTOR PER THE SPECIAL PROVISIONS

FINISH DECK SURFACE

4'-6"

5'-0"

10'-0"

5'-0"

4"x12" DECKING WITH SEALER COAT

10'-0"

2"x6" E.O. SP.

6"x6"

3'-0"

BRIDGE SECTION
(ALT. - B)
SCALE: 1/2" = 1'-0"

