
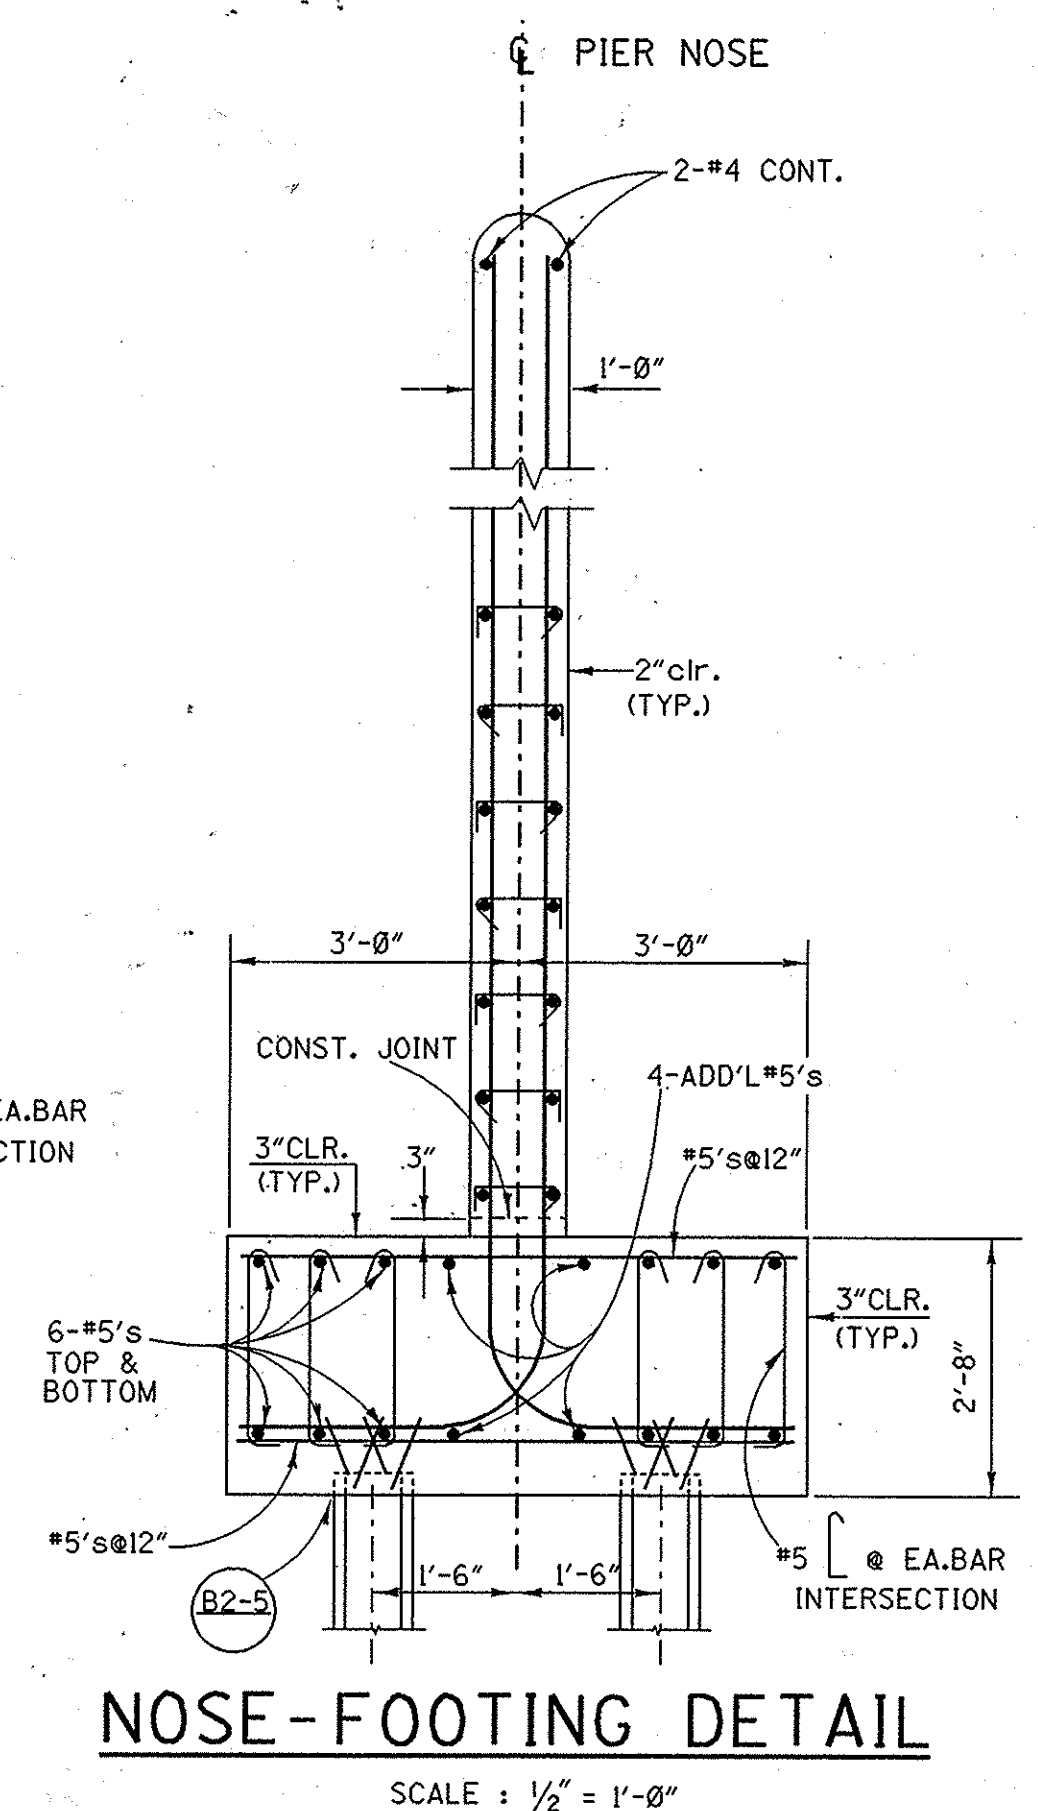
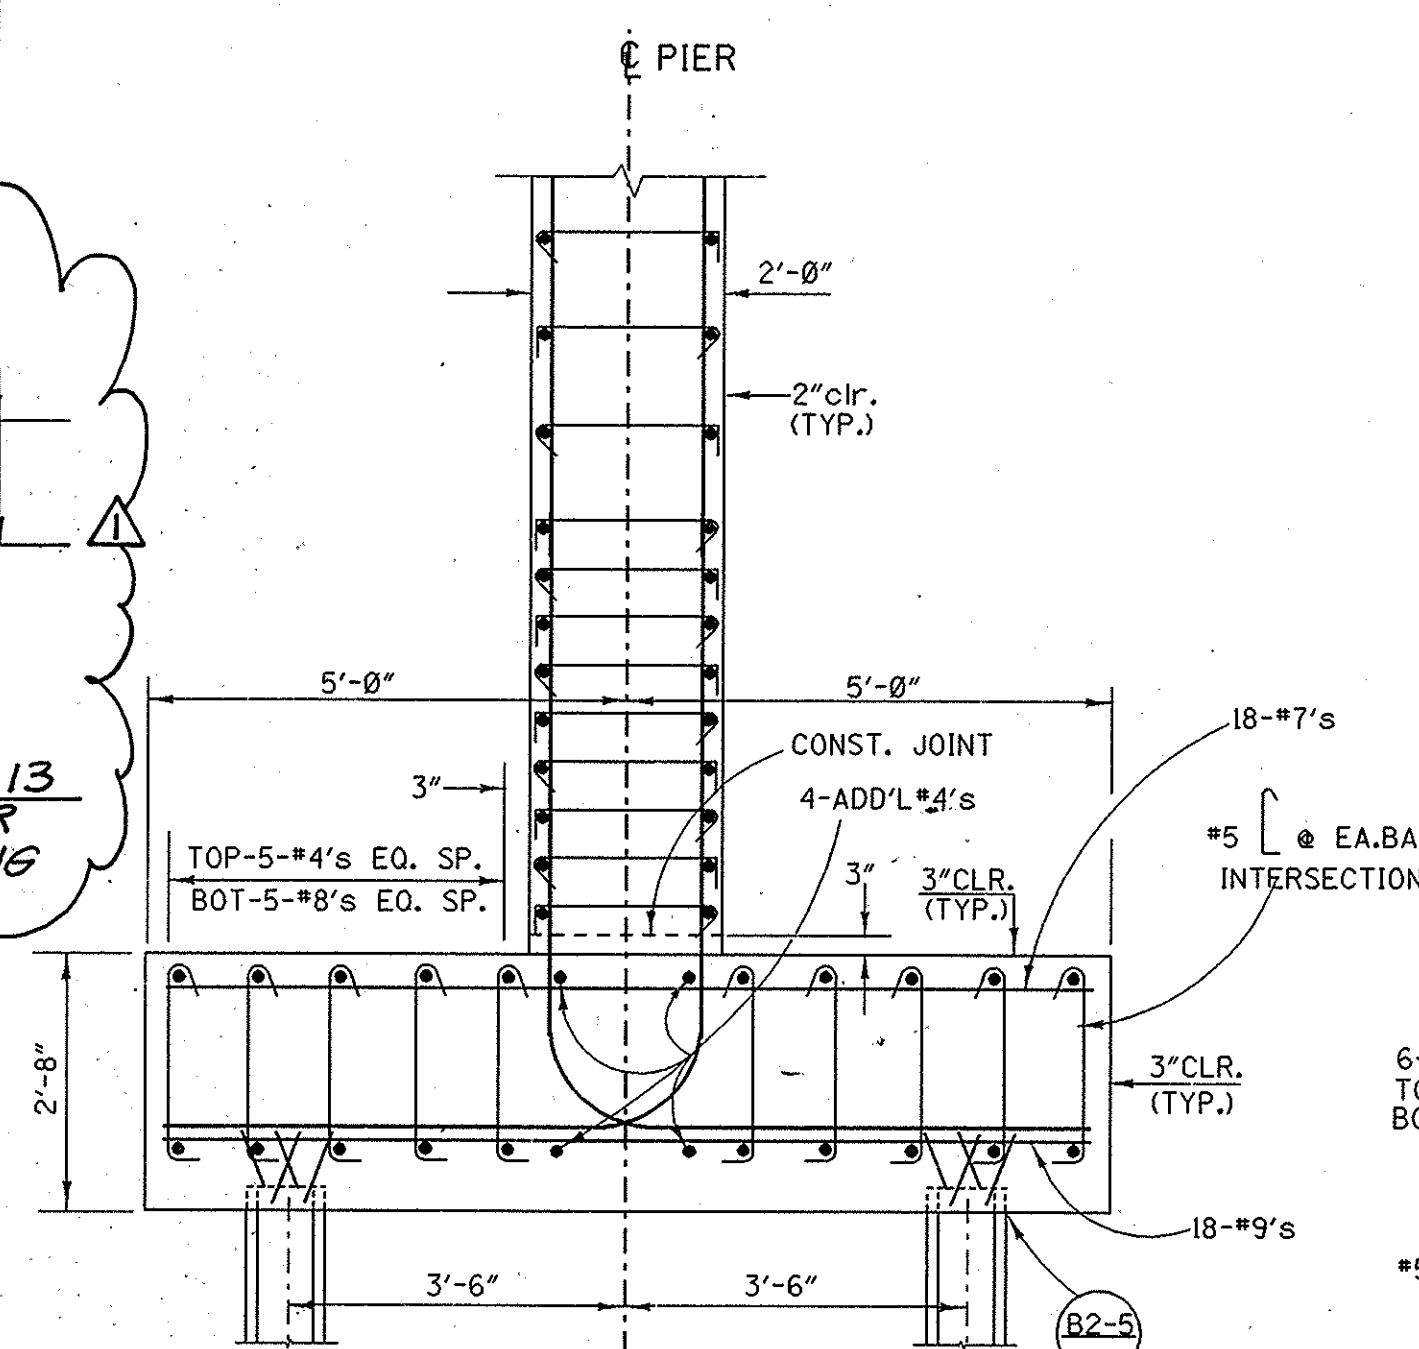
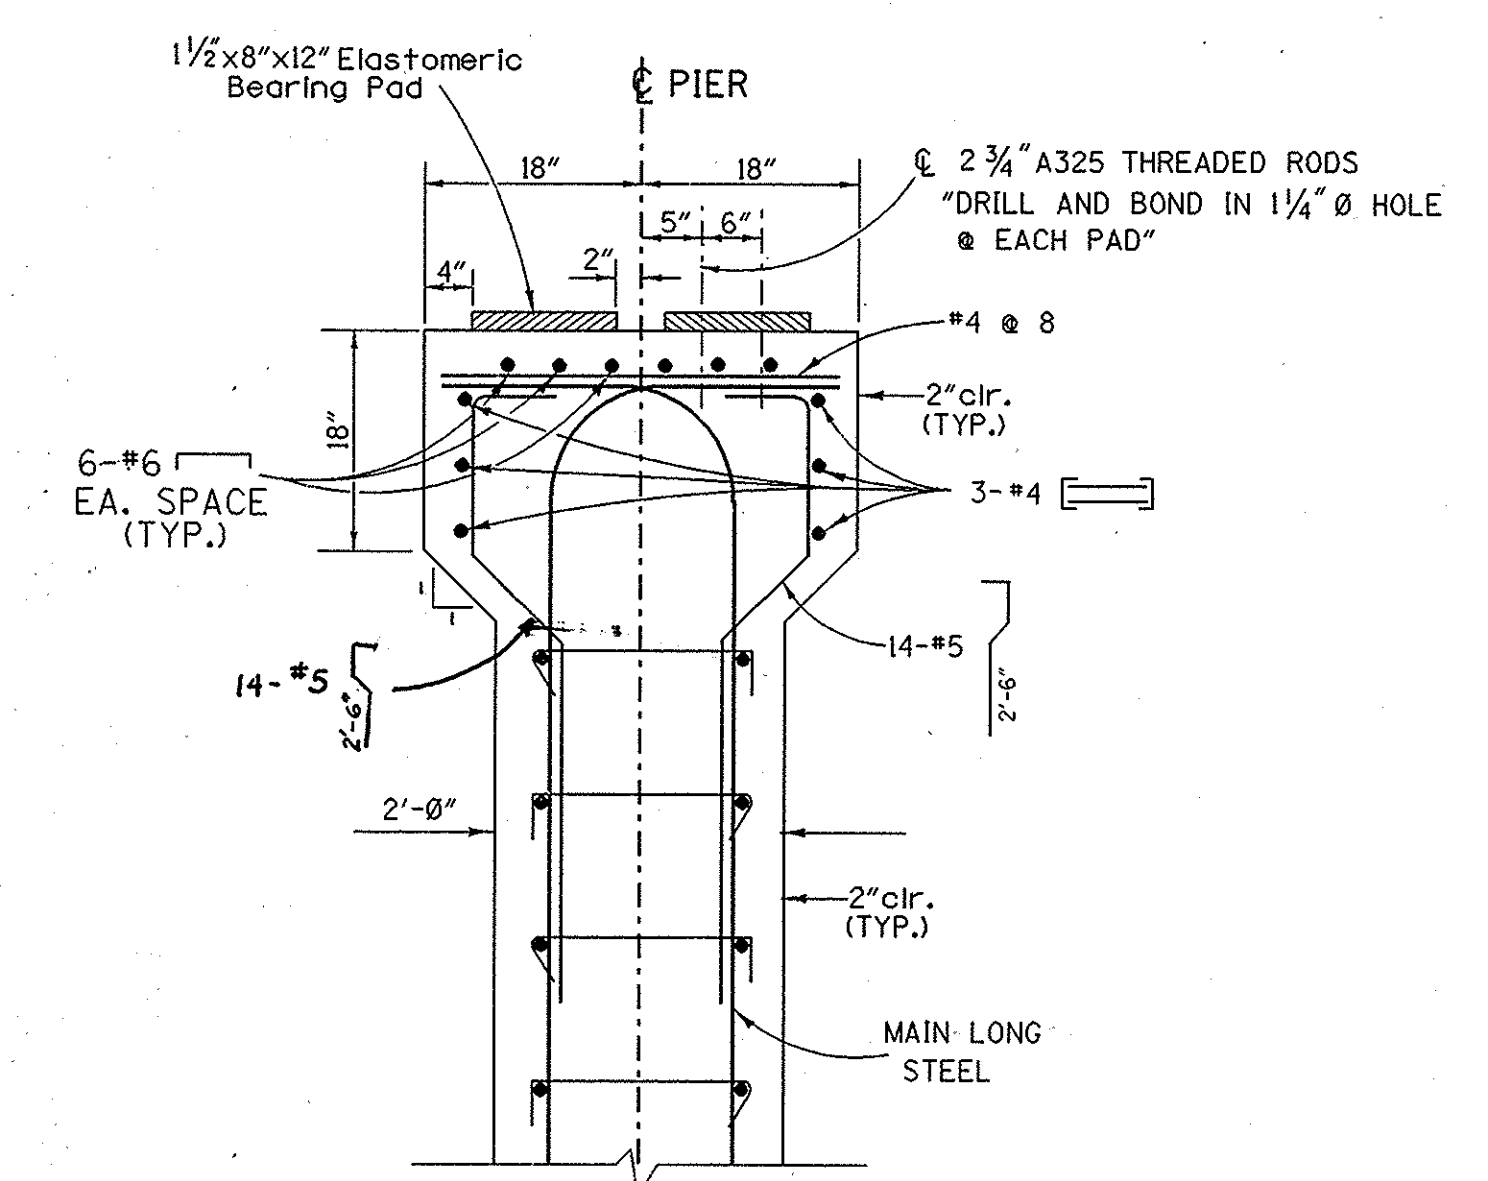
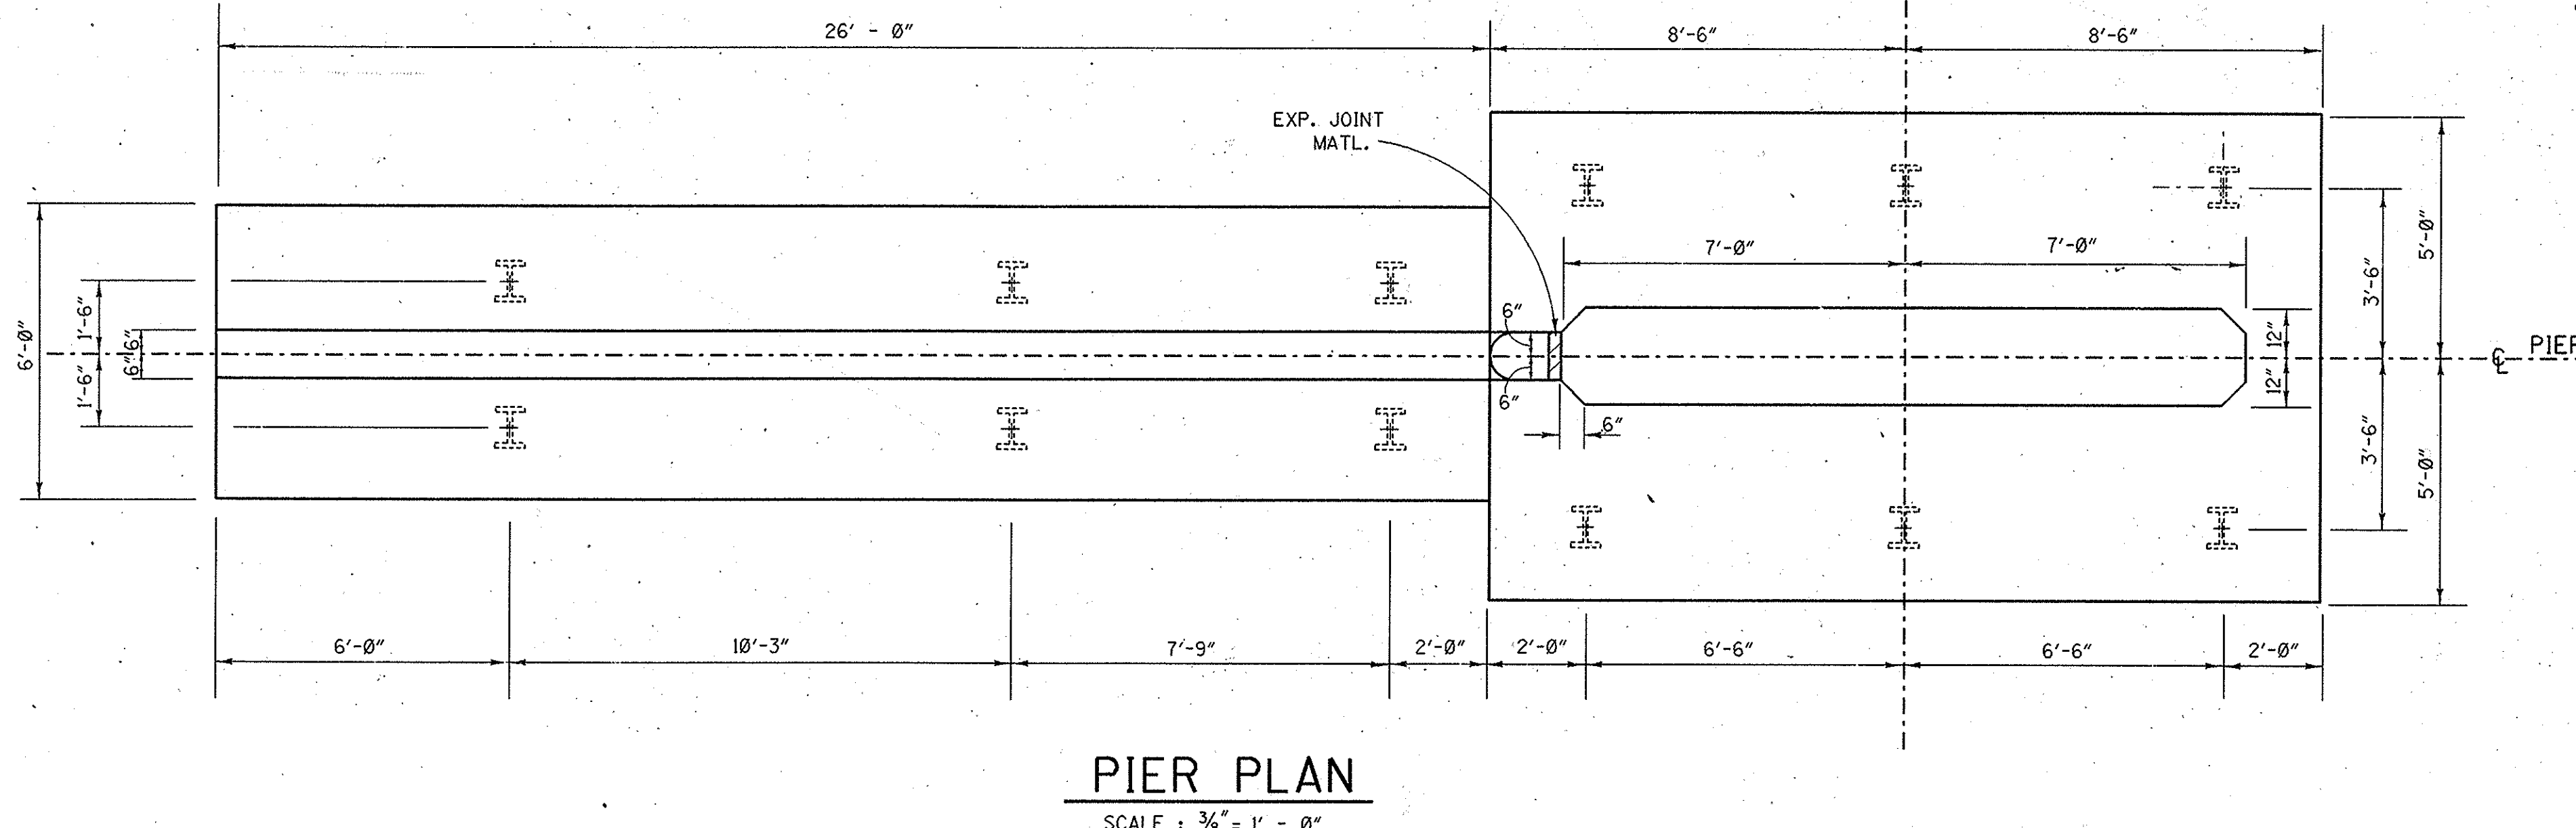


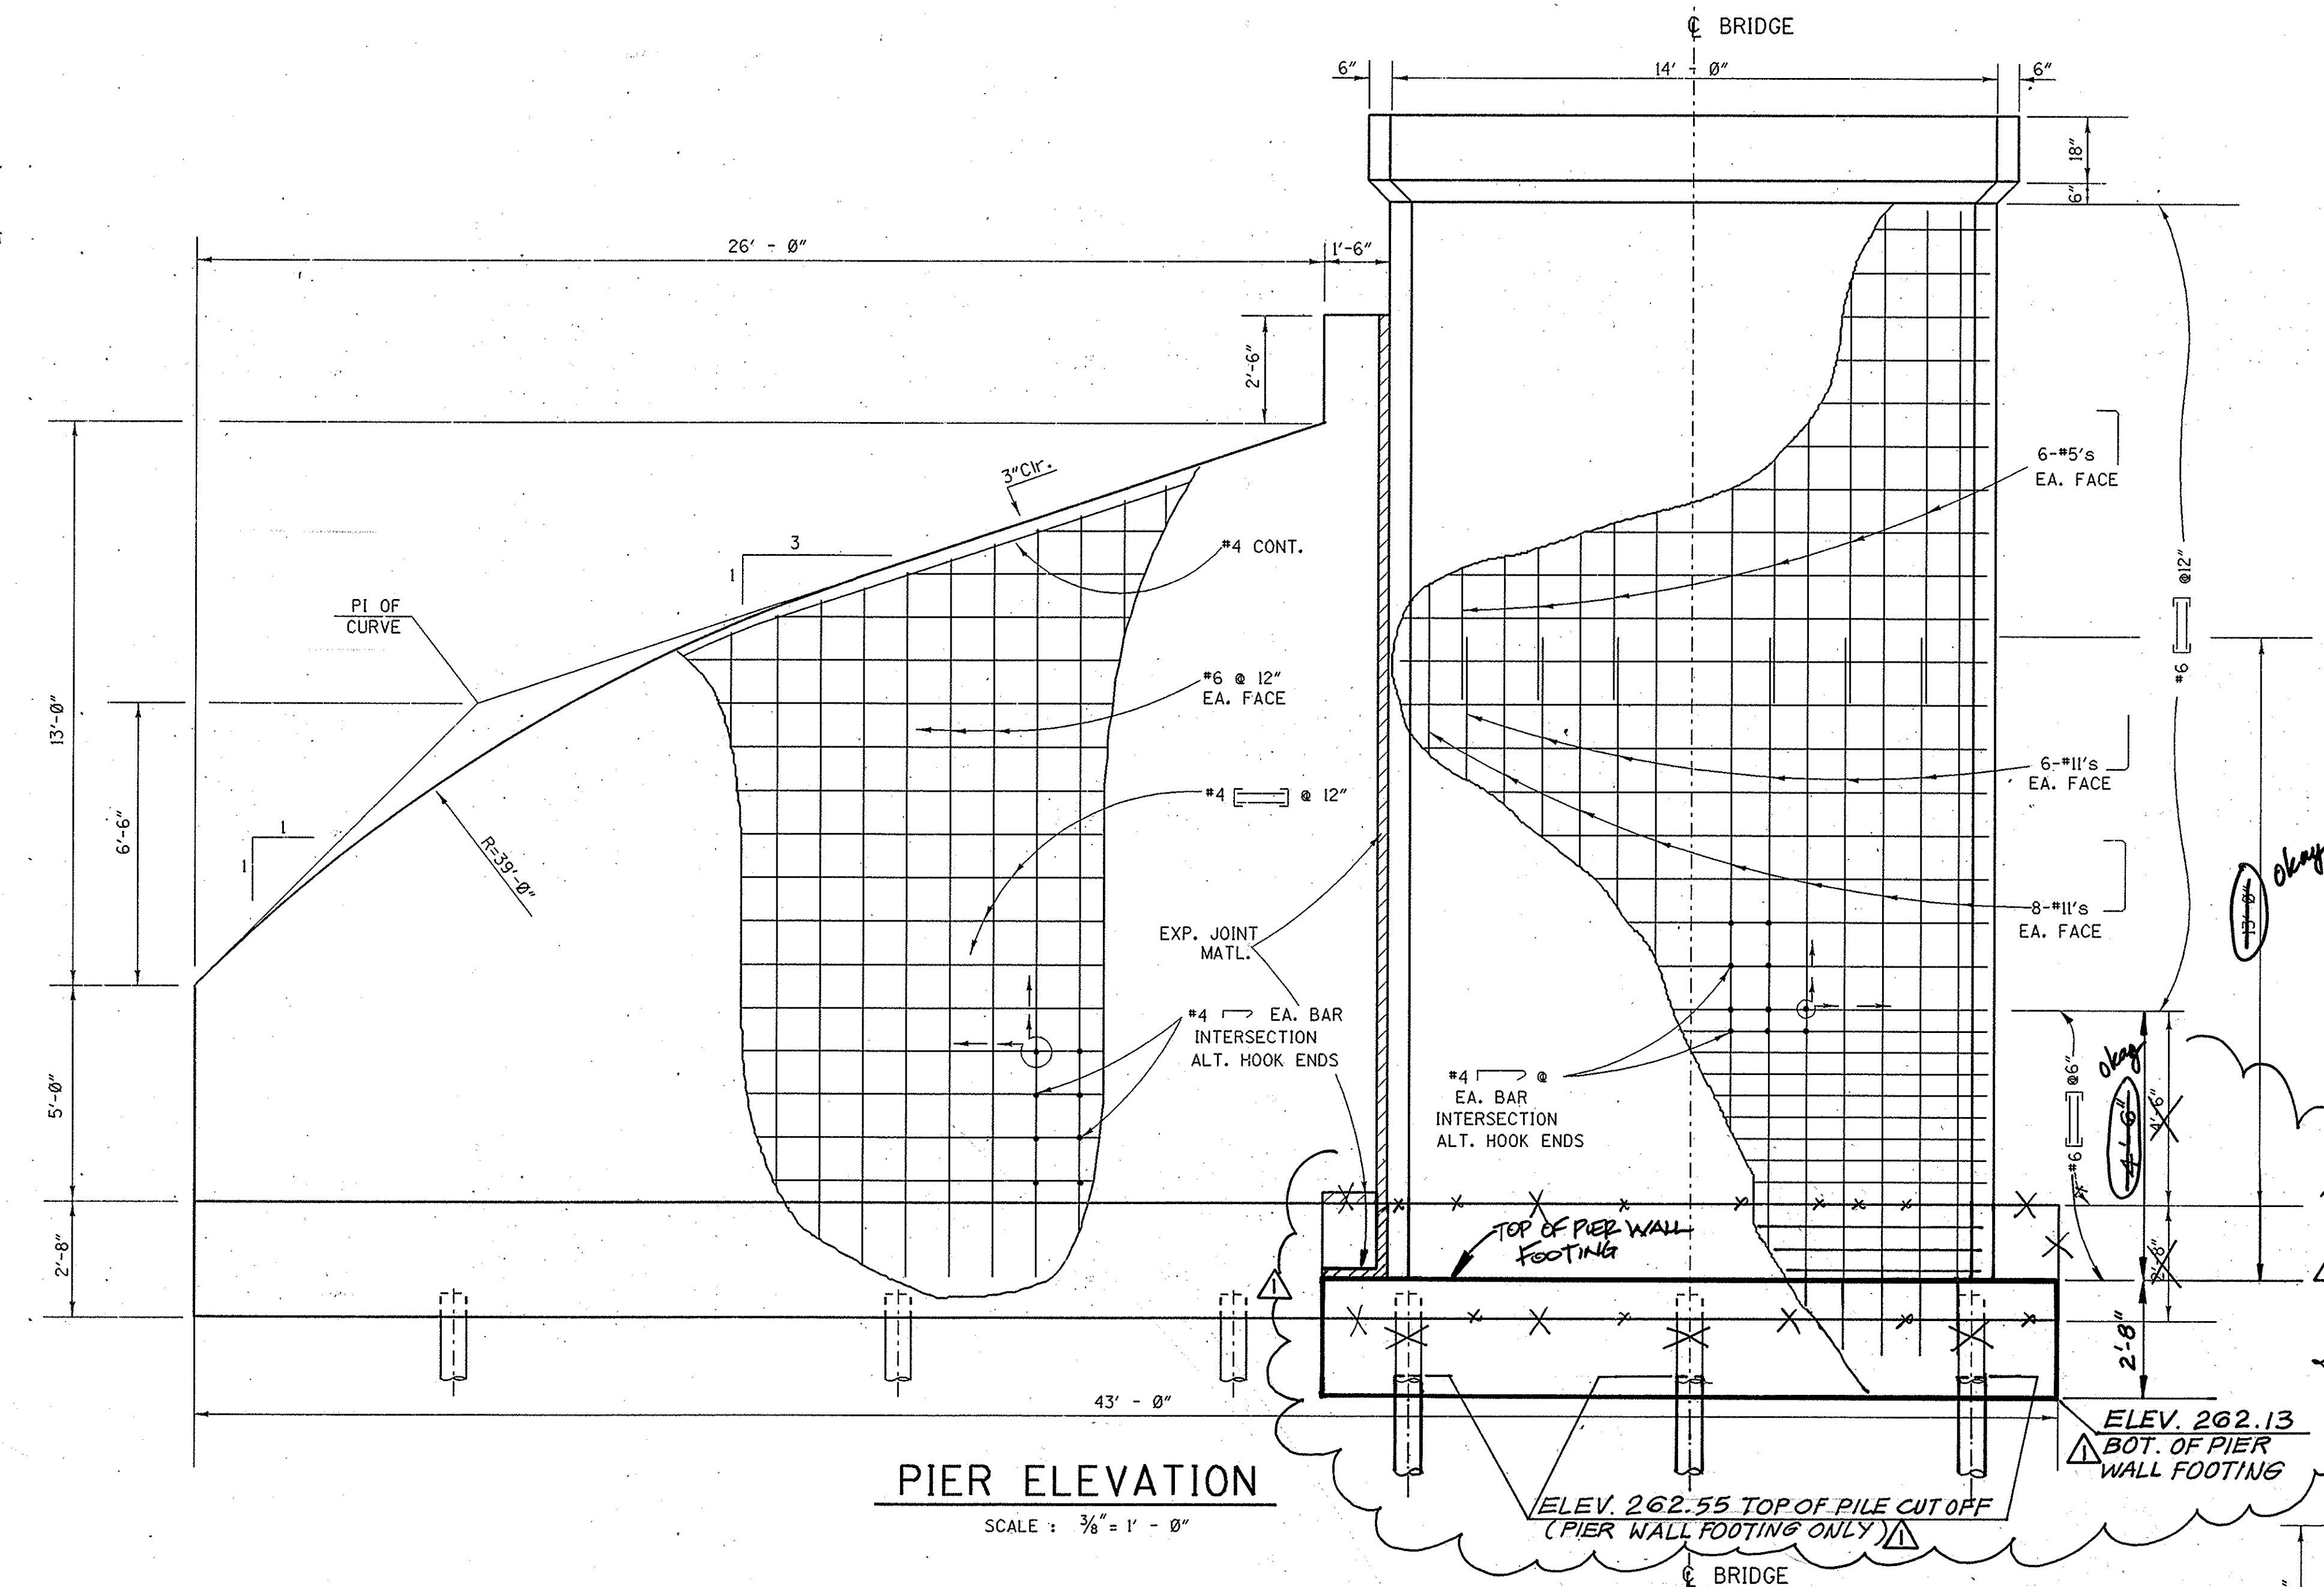

		ORANGE COUNTY ENVIRONMENTAL MANAGEMENT AGENCY IMPERIAL HIGHWAY BIKE BRIDGE ACROSS SANTA ANA RIVER PIER WALL	
DESIGNED <u>R.H.</u> DRAWN <u>H.P.</u> SCALE <u>AS SHOWN</u>	CHECKED <u>R.H.</u> DATE <u>4/2/92</u>	SHEET 3 OF 5	