

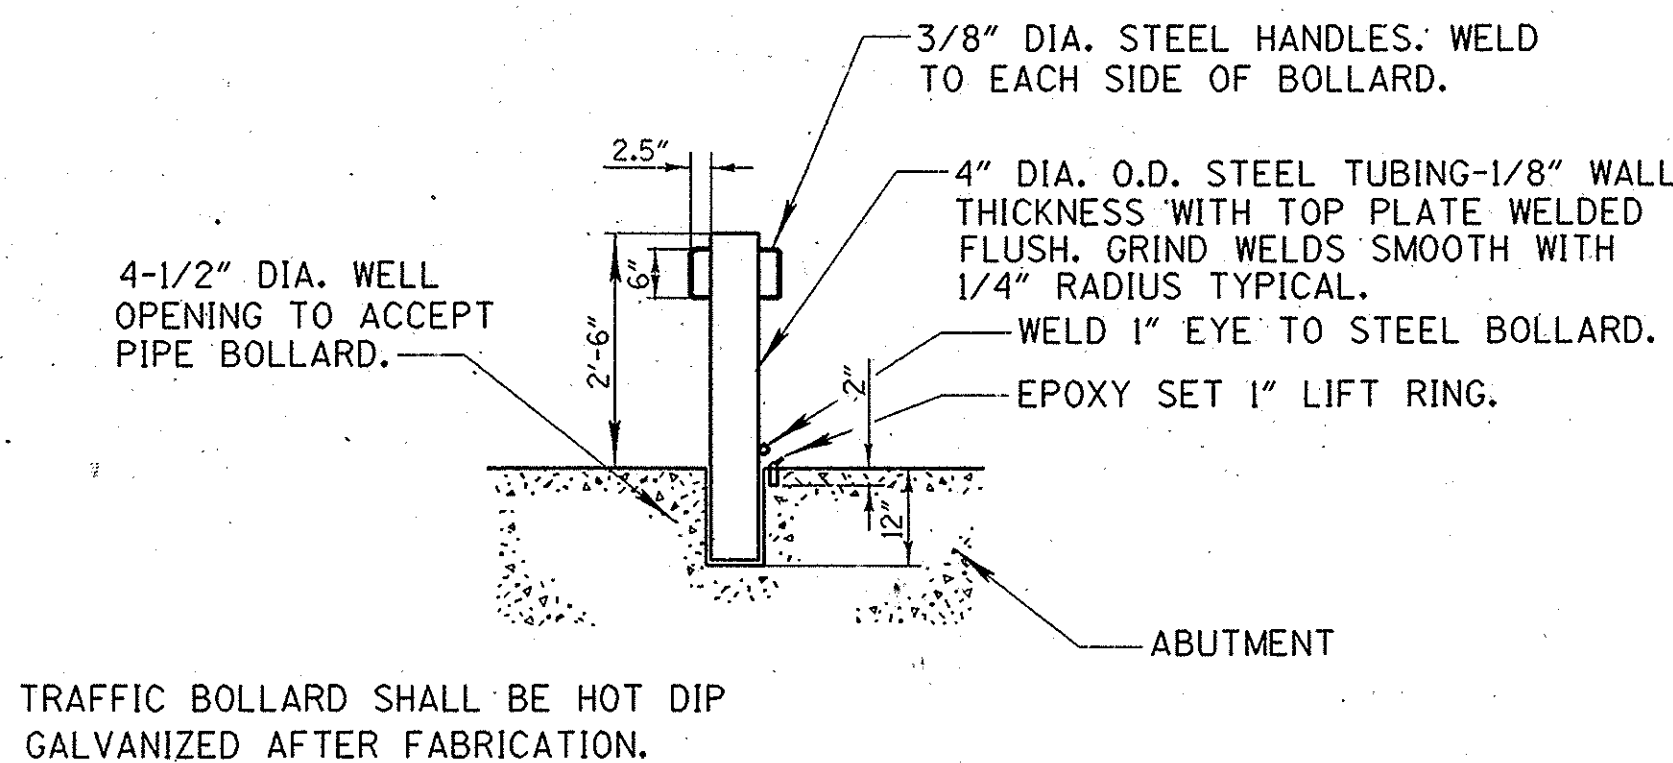
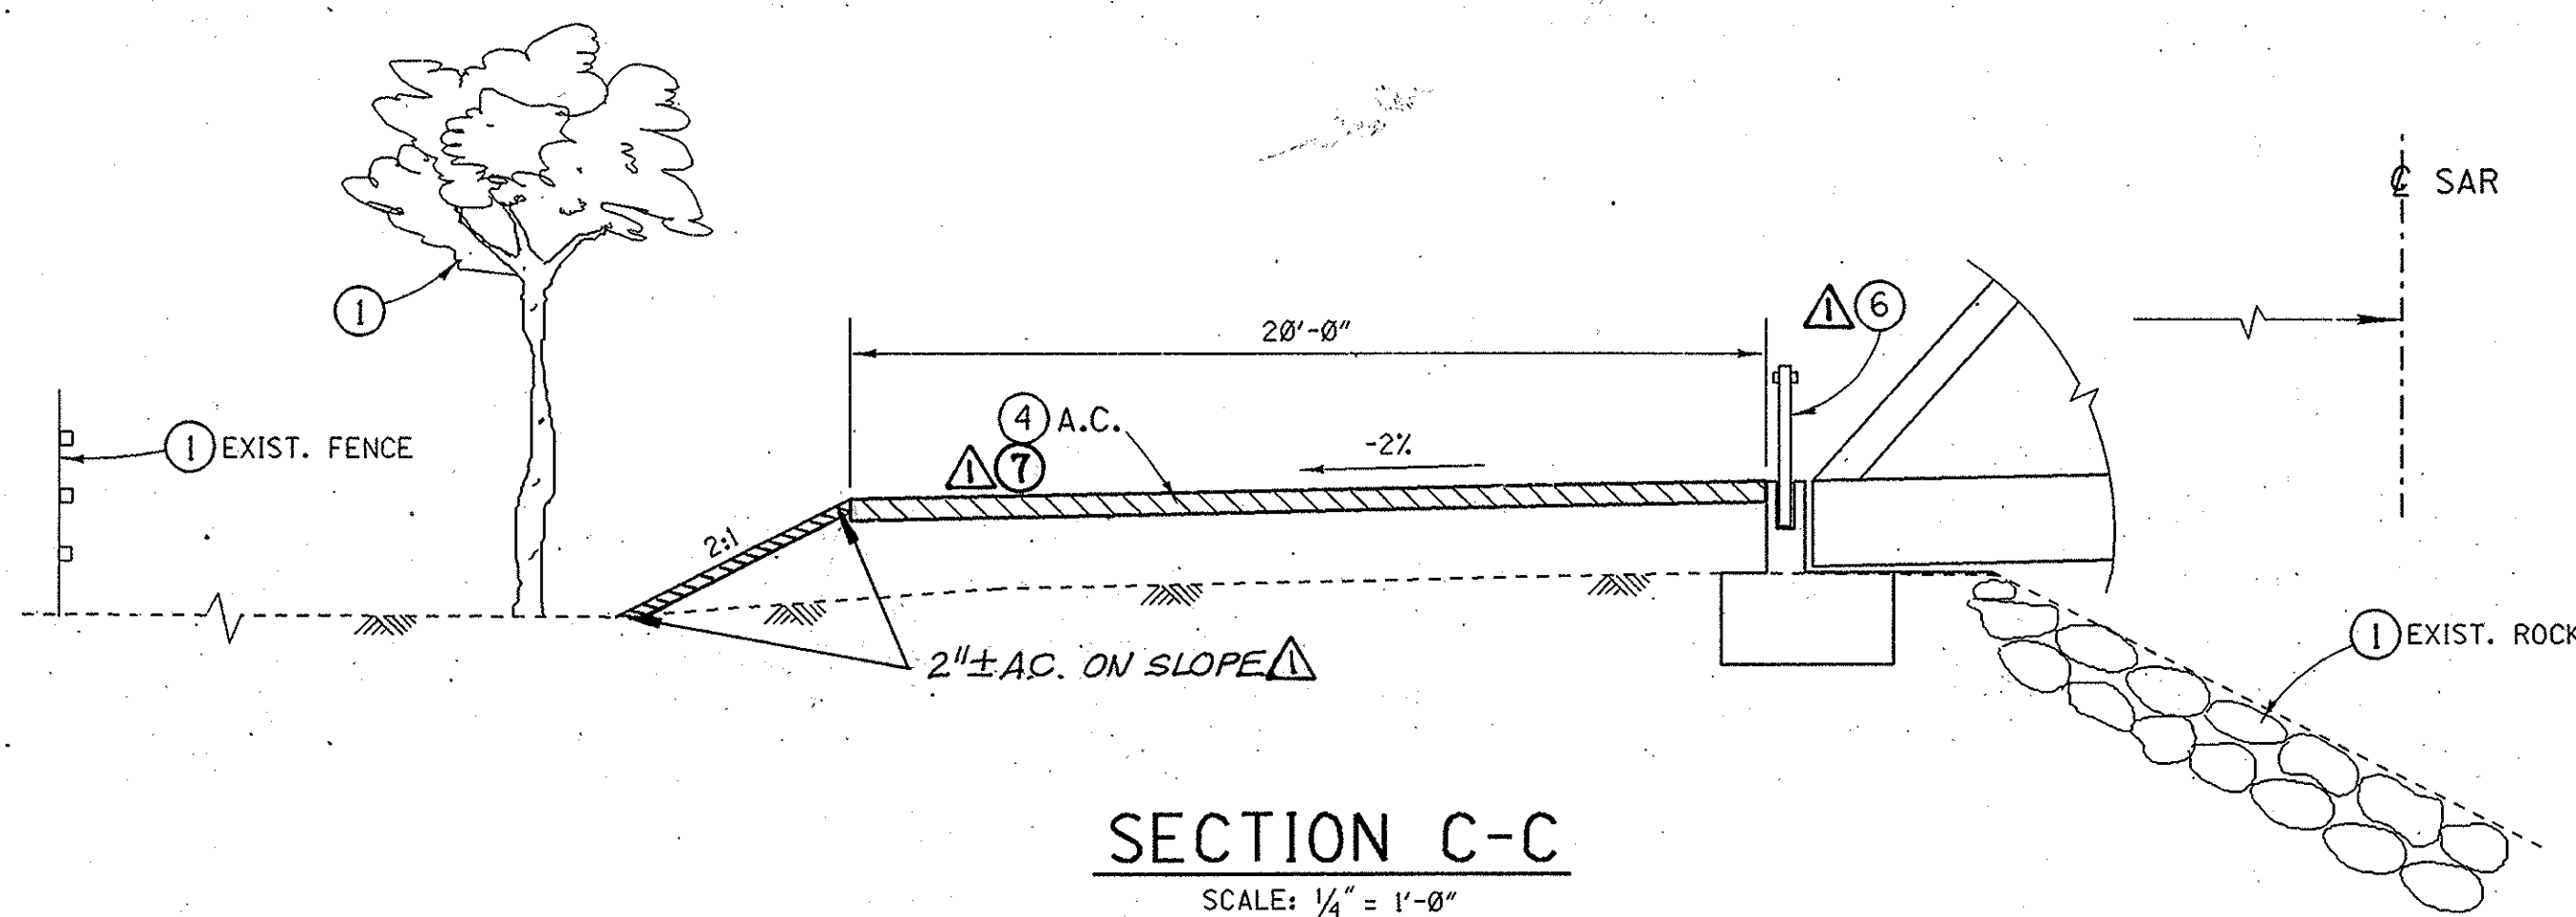
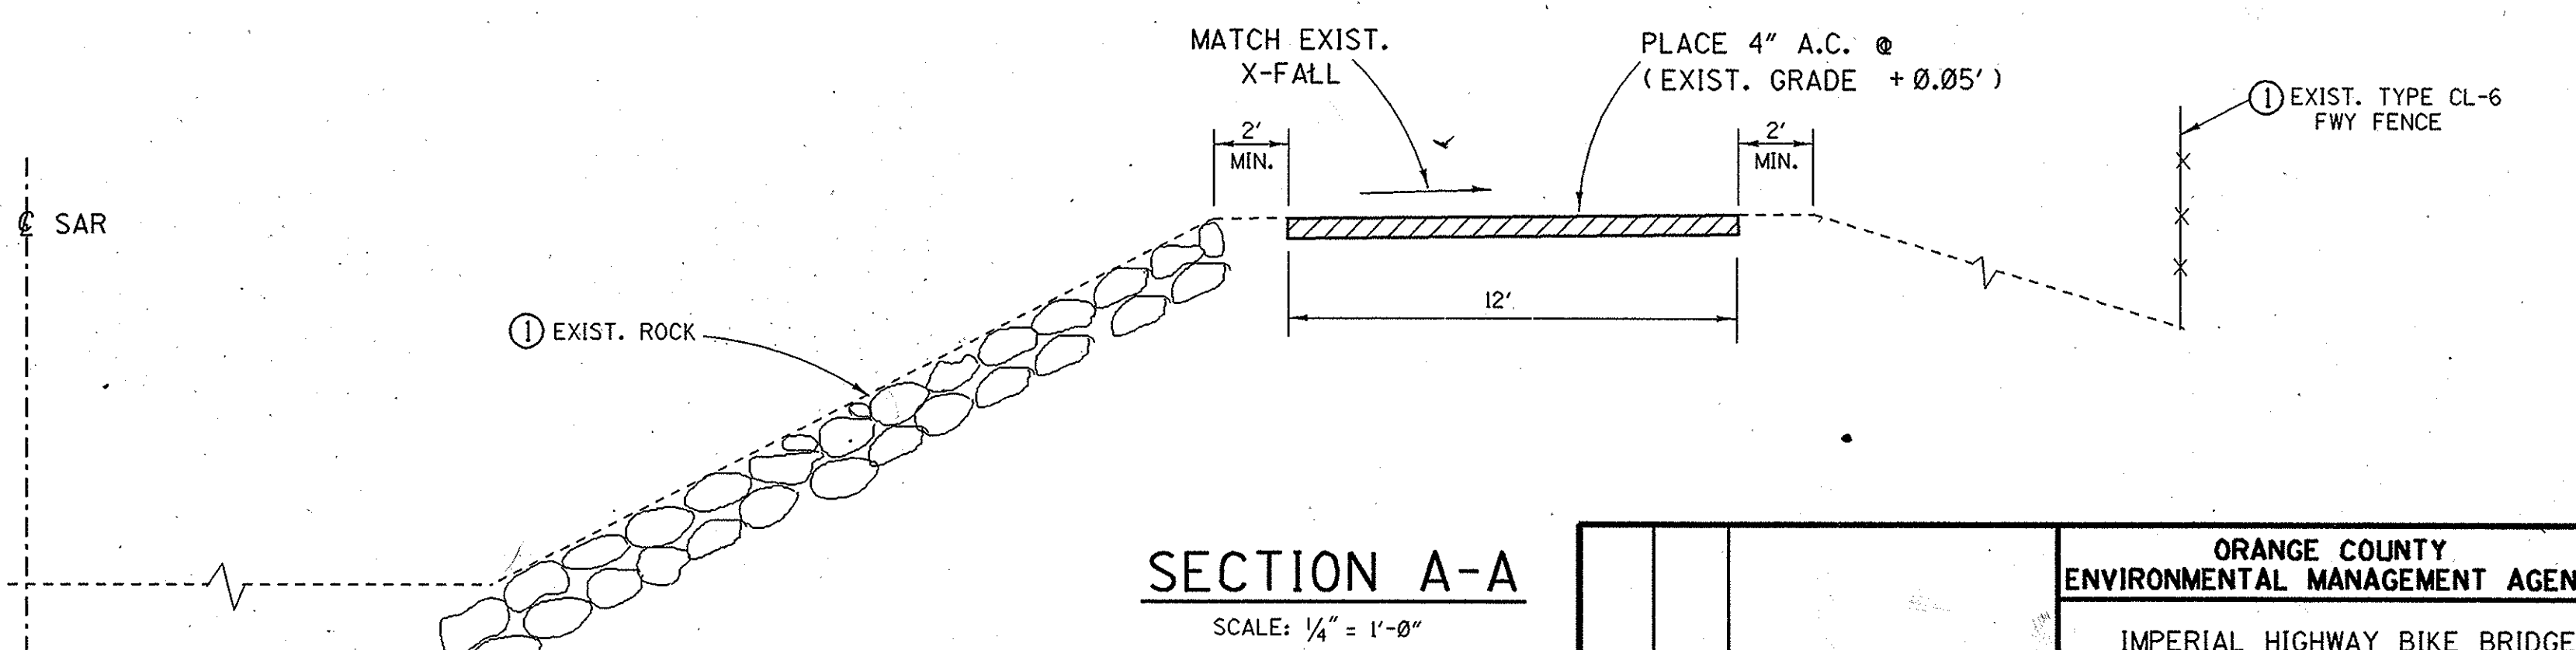
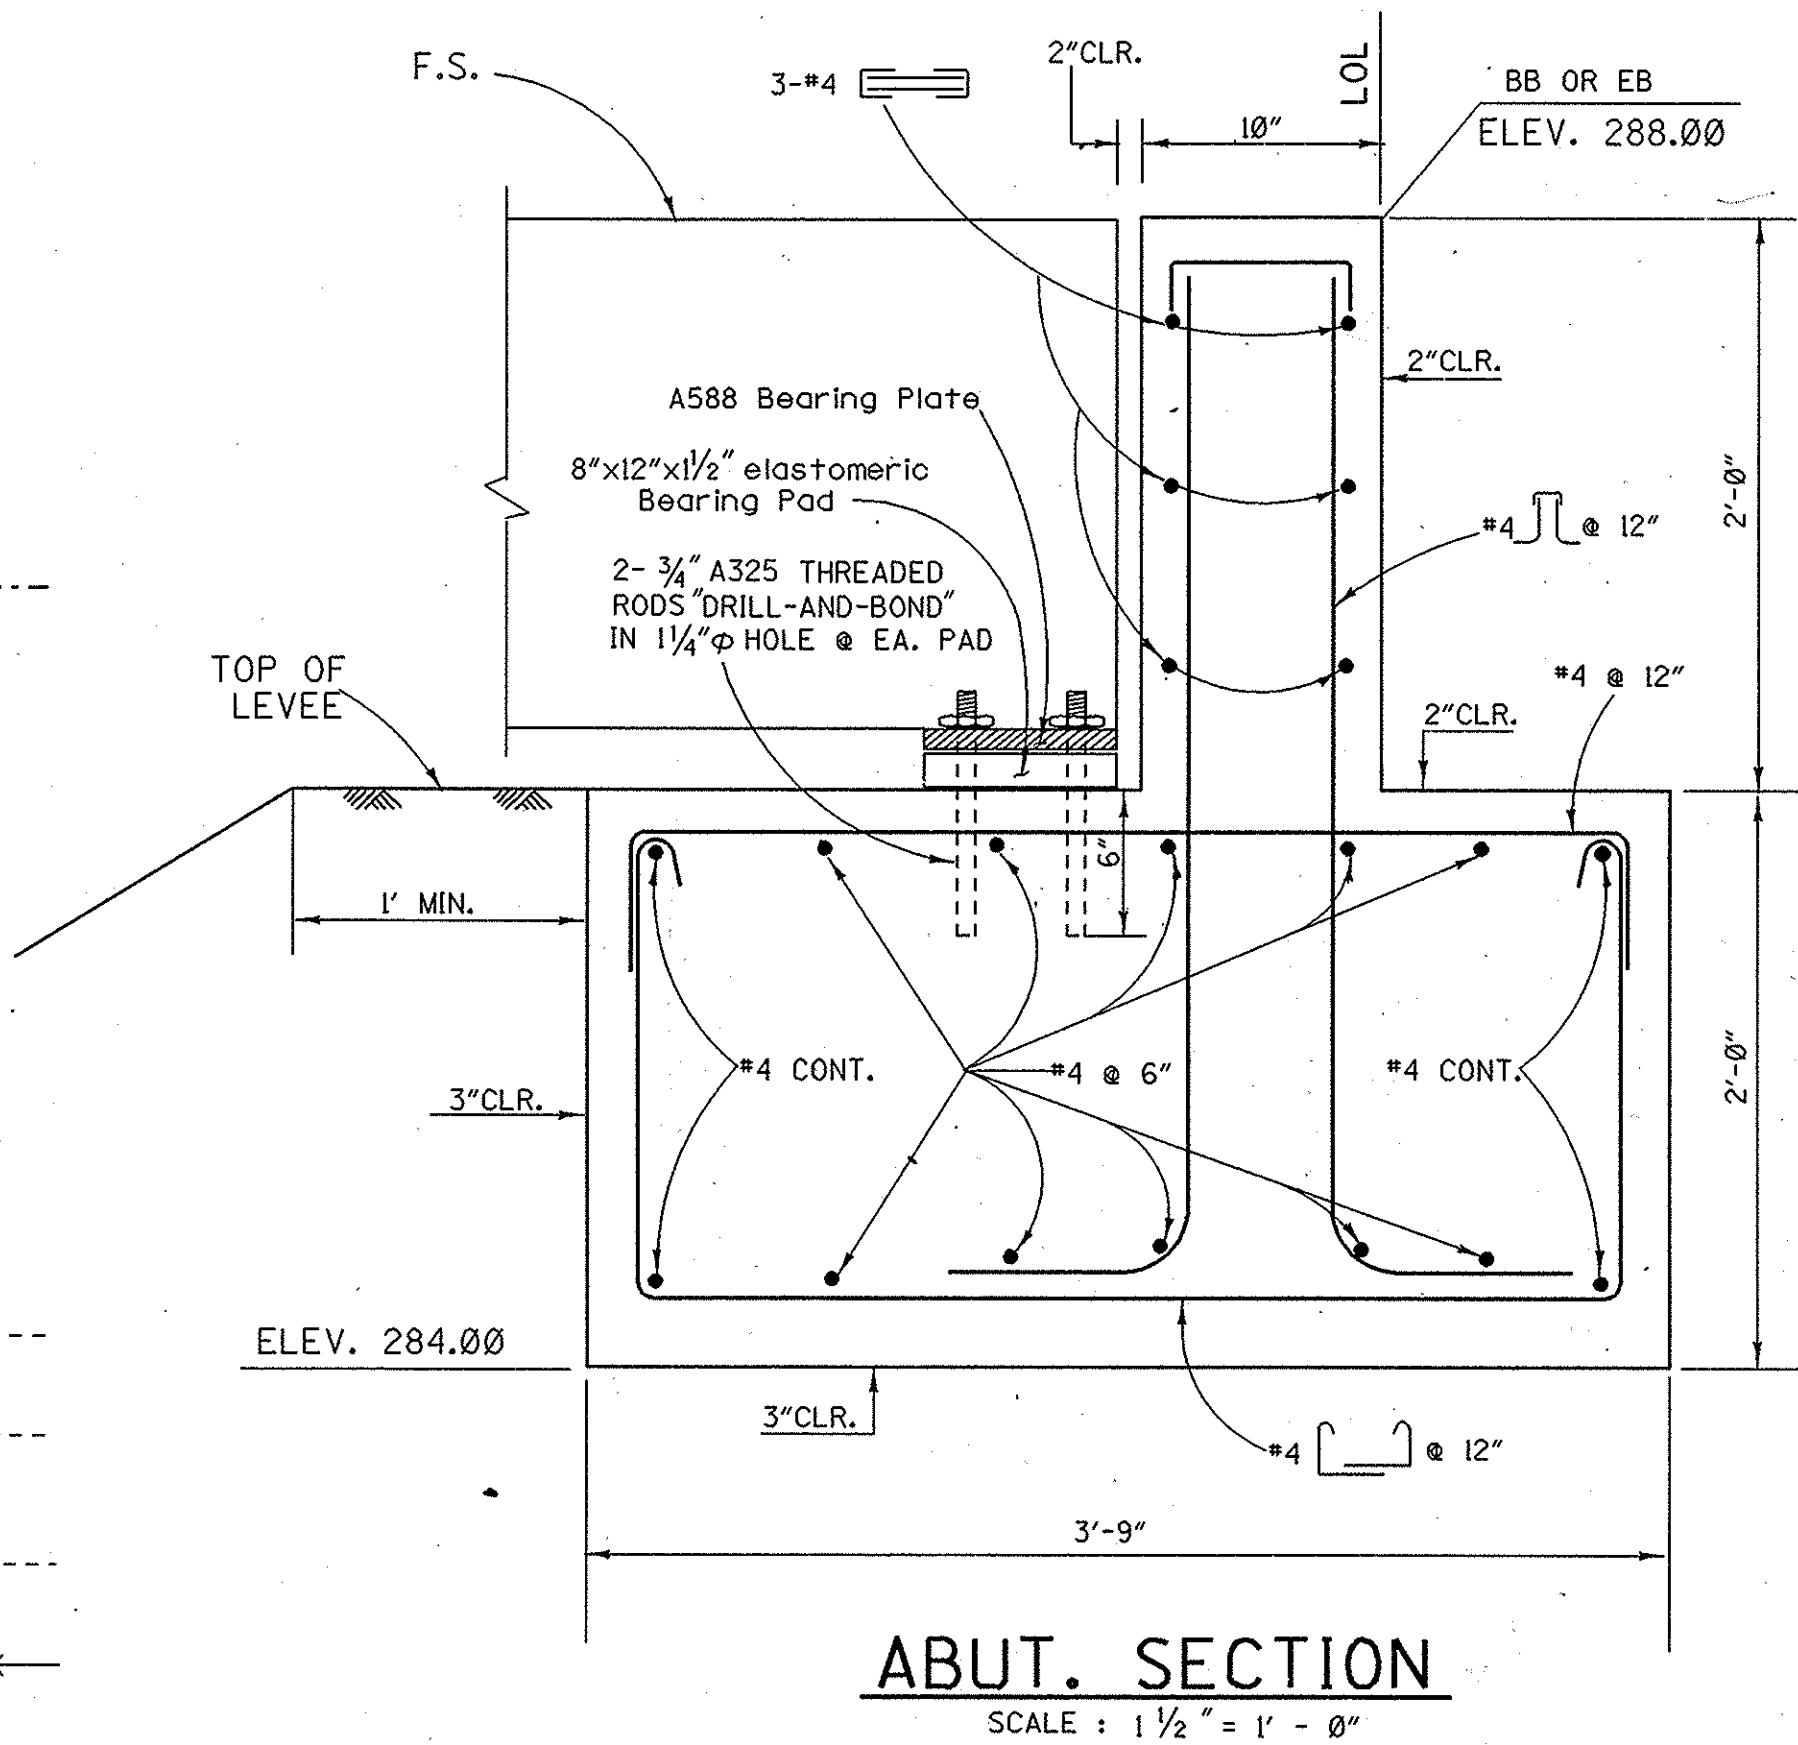


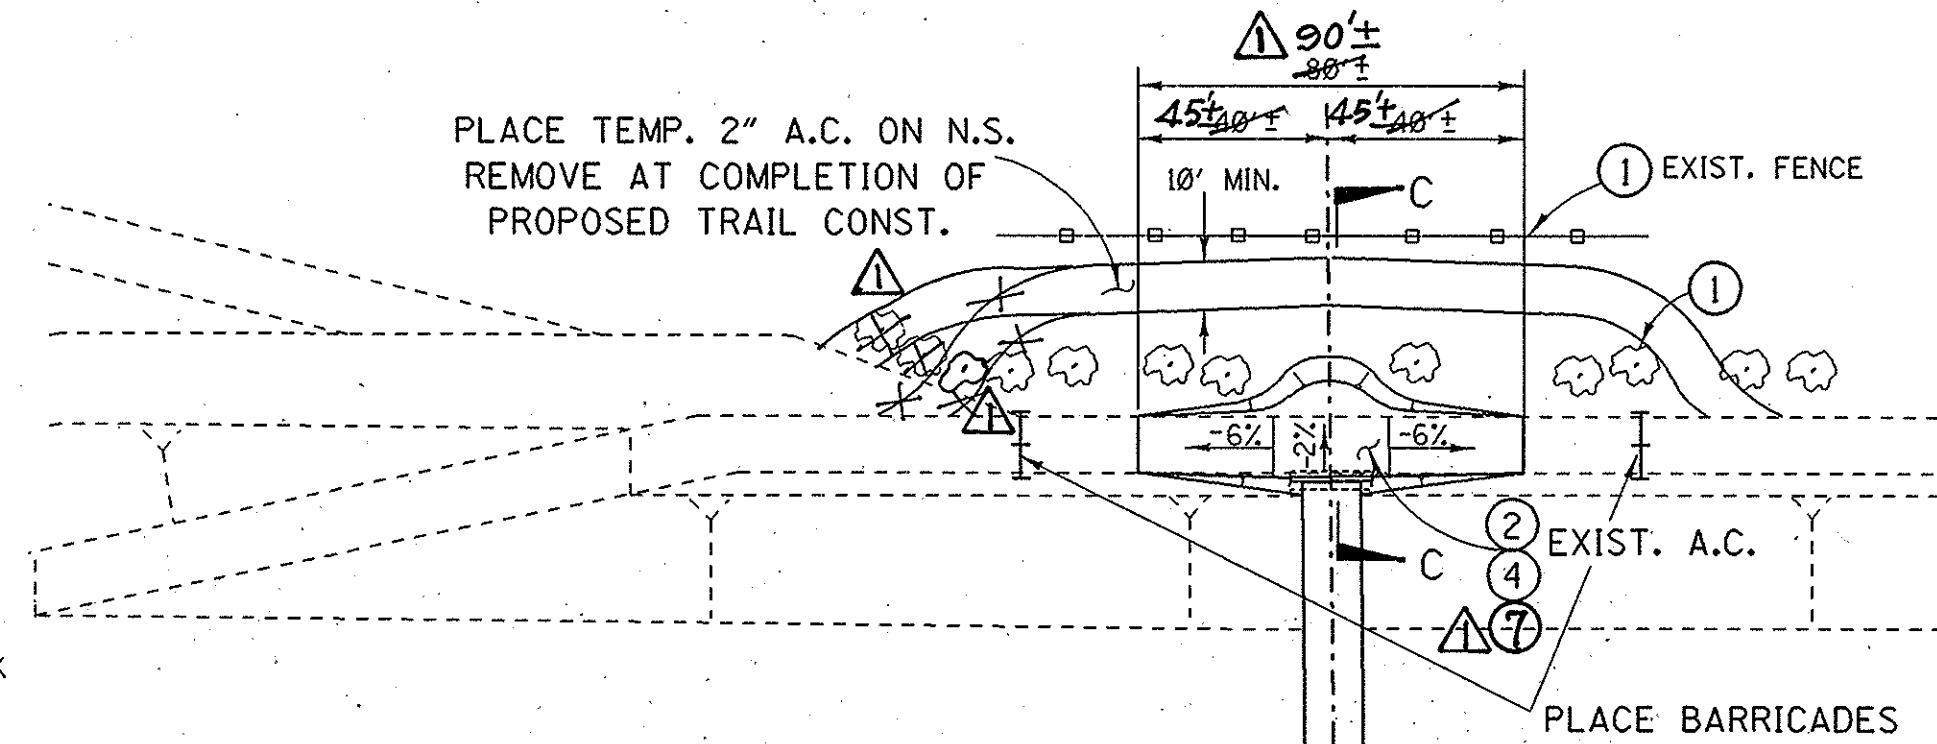

- NOTES :**
- ① PROTECT
 - ② REMOVE
 - ③ SAWCUT & JOIN
 - ④ PLACE 4" MIN. A.C.
 - ⑤ PLACE 5' CHAIN LINK FENCE PER APWA STD. PLAN 600-0 (ELIMINATED PER DESIGN SECT.)
 - ⑥ PLACE REMOVABLE TRAFFIC BOLLARD BOLLARD REMOVED- WELL FILLED
 - ⑦ TYPE I SLURRY SEAL

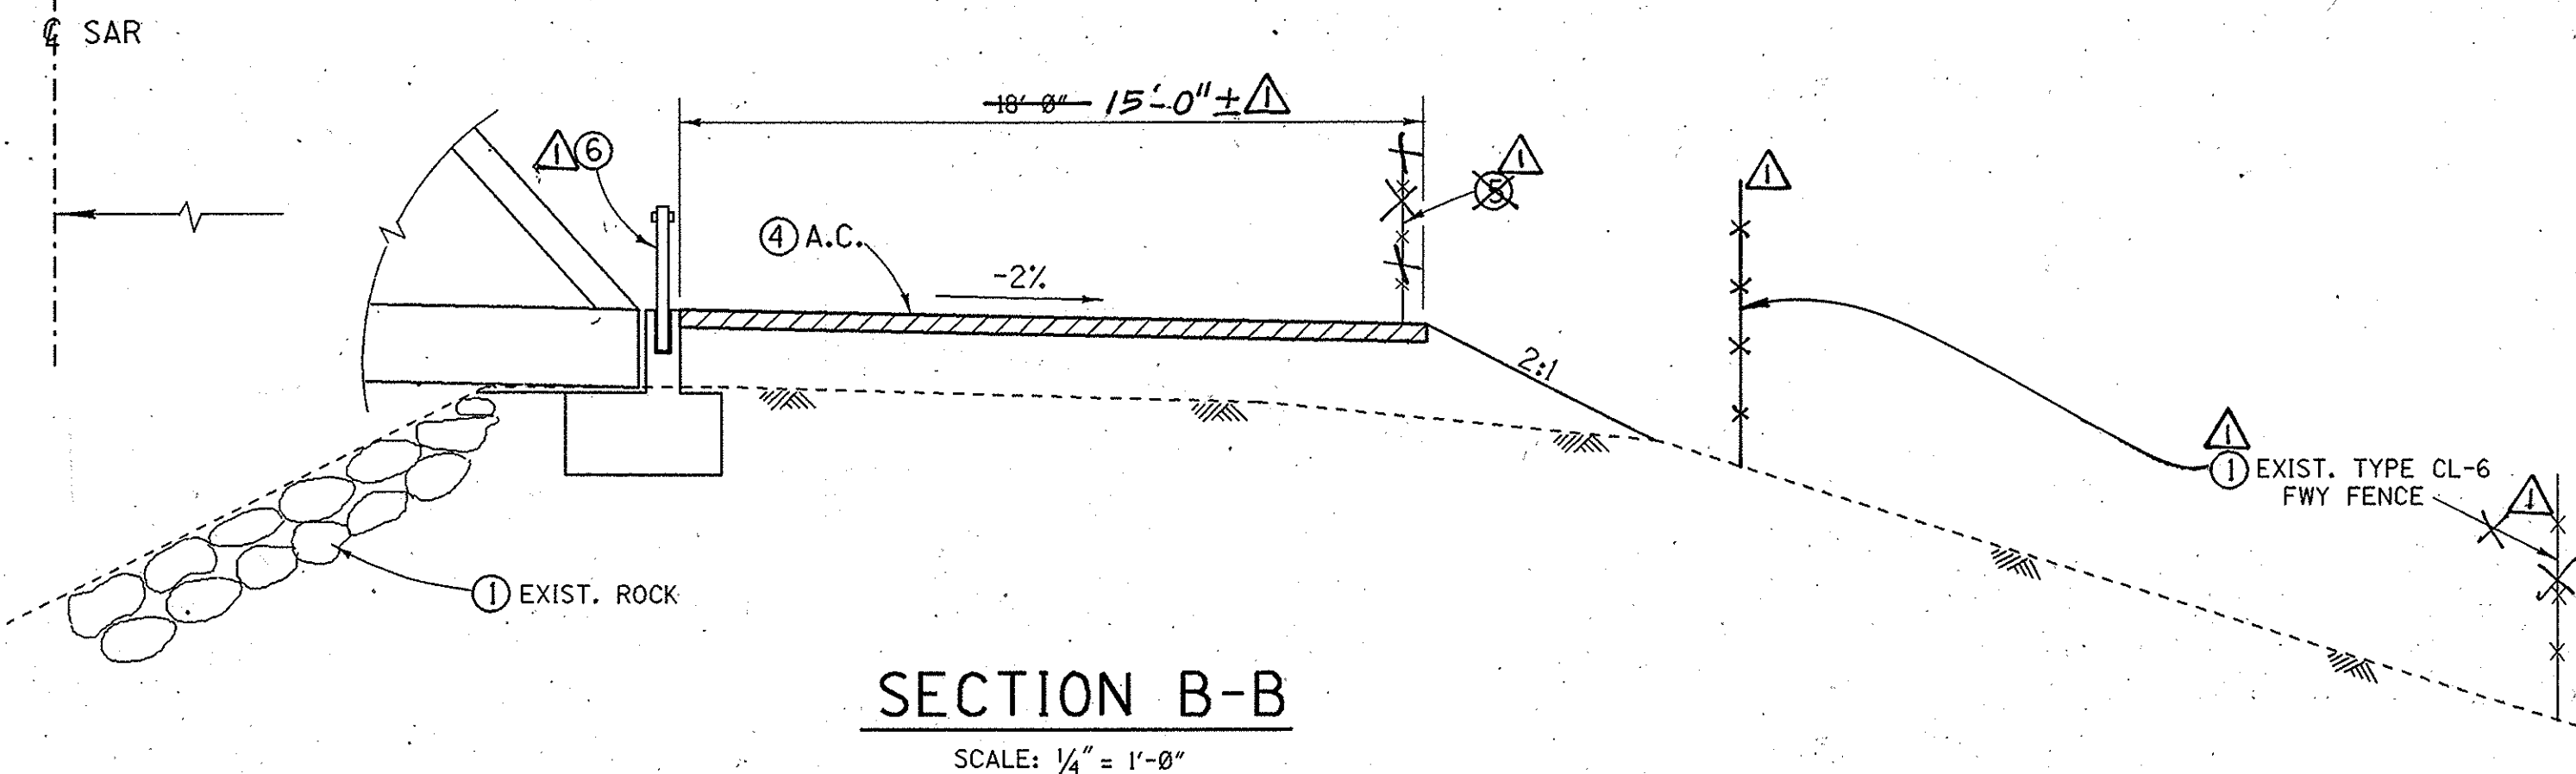

ORANGE COUNTY ENVIRONMENTAL MANAGEMENT AGENCY		IMPERIAL HIGHWAY BIKE BRIDGE ACROSS SANTA ANA RIVER	
ABUTMENT & TRAIL IMPROVEMENTS		SHEET 4 OF 5	
DESIGNED R.H.	CHECKED R.H.	DATE 4/1/92	
DRAWN H.P.	SCALE AS SHOWN	DRAWING NO.	