



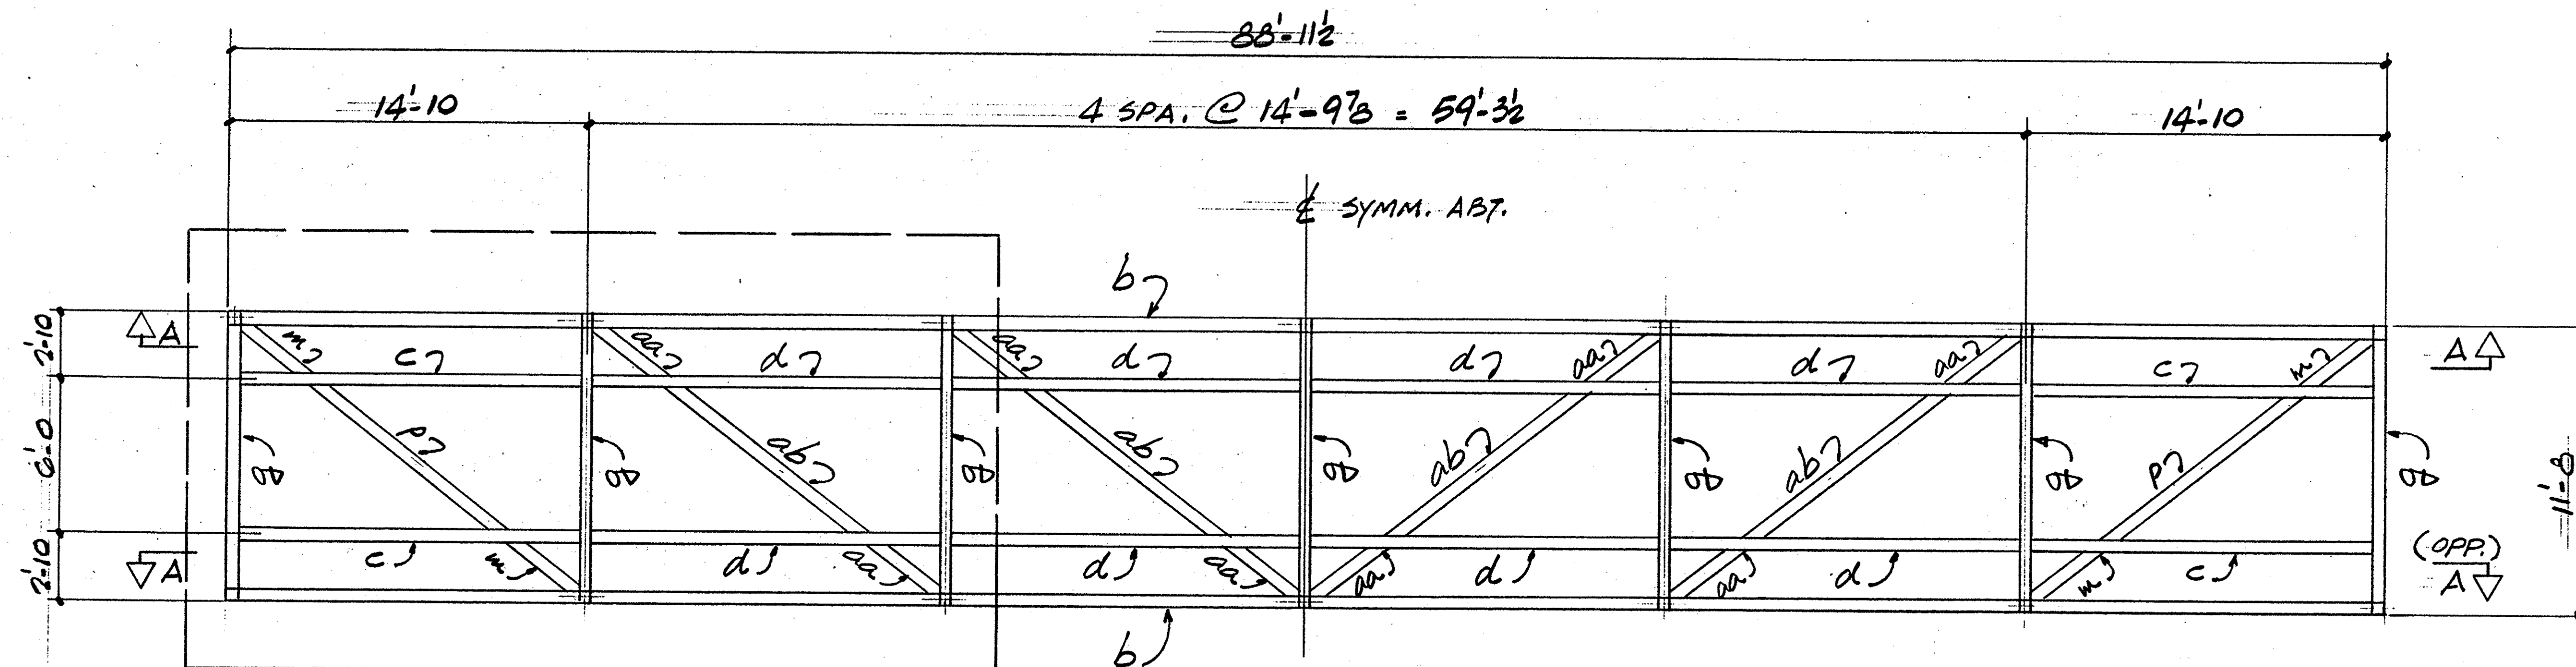


DETAIL 2

TRUSS FLOOR PLAN
(4x12 PLANKS NOT SHOWN FOR CLARITY)

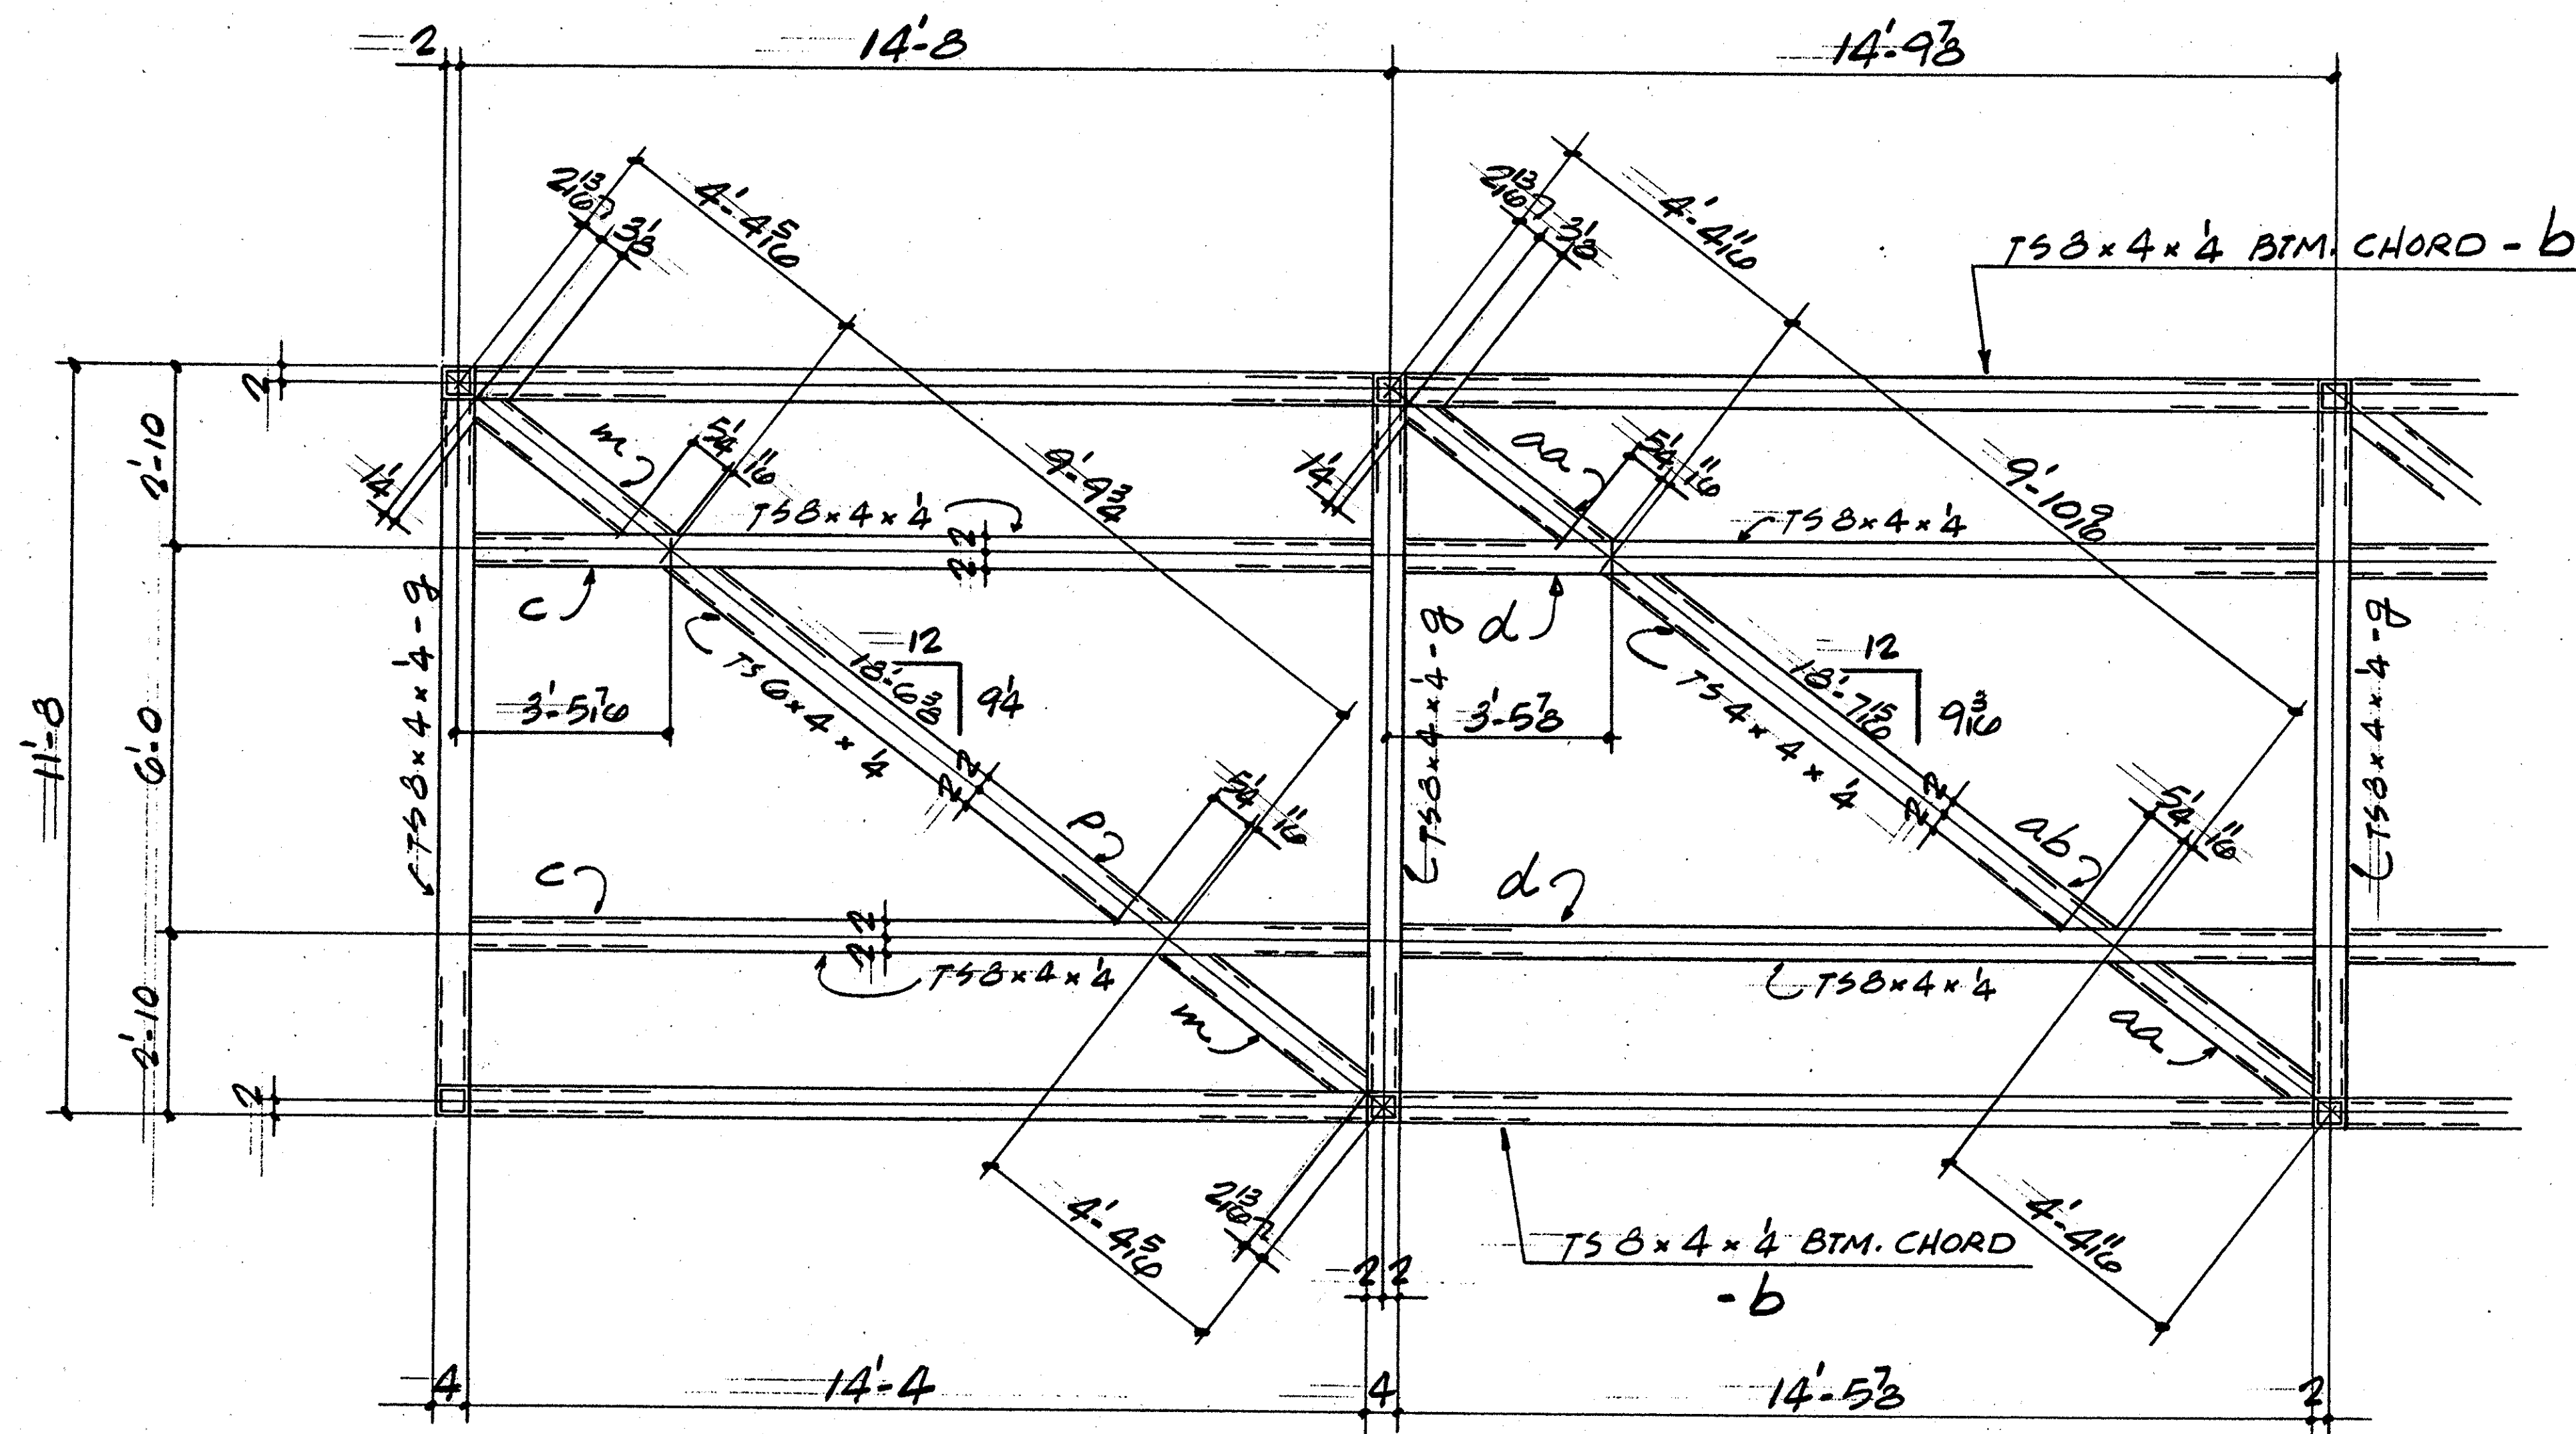

ENLARGED DETAIL 2

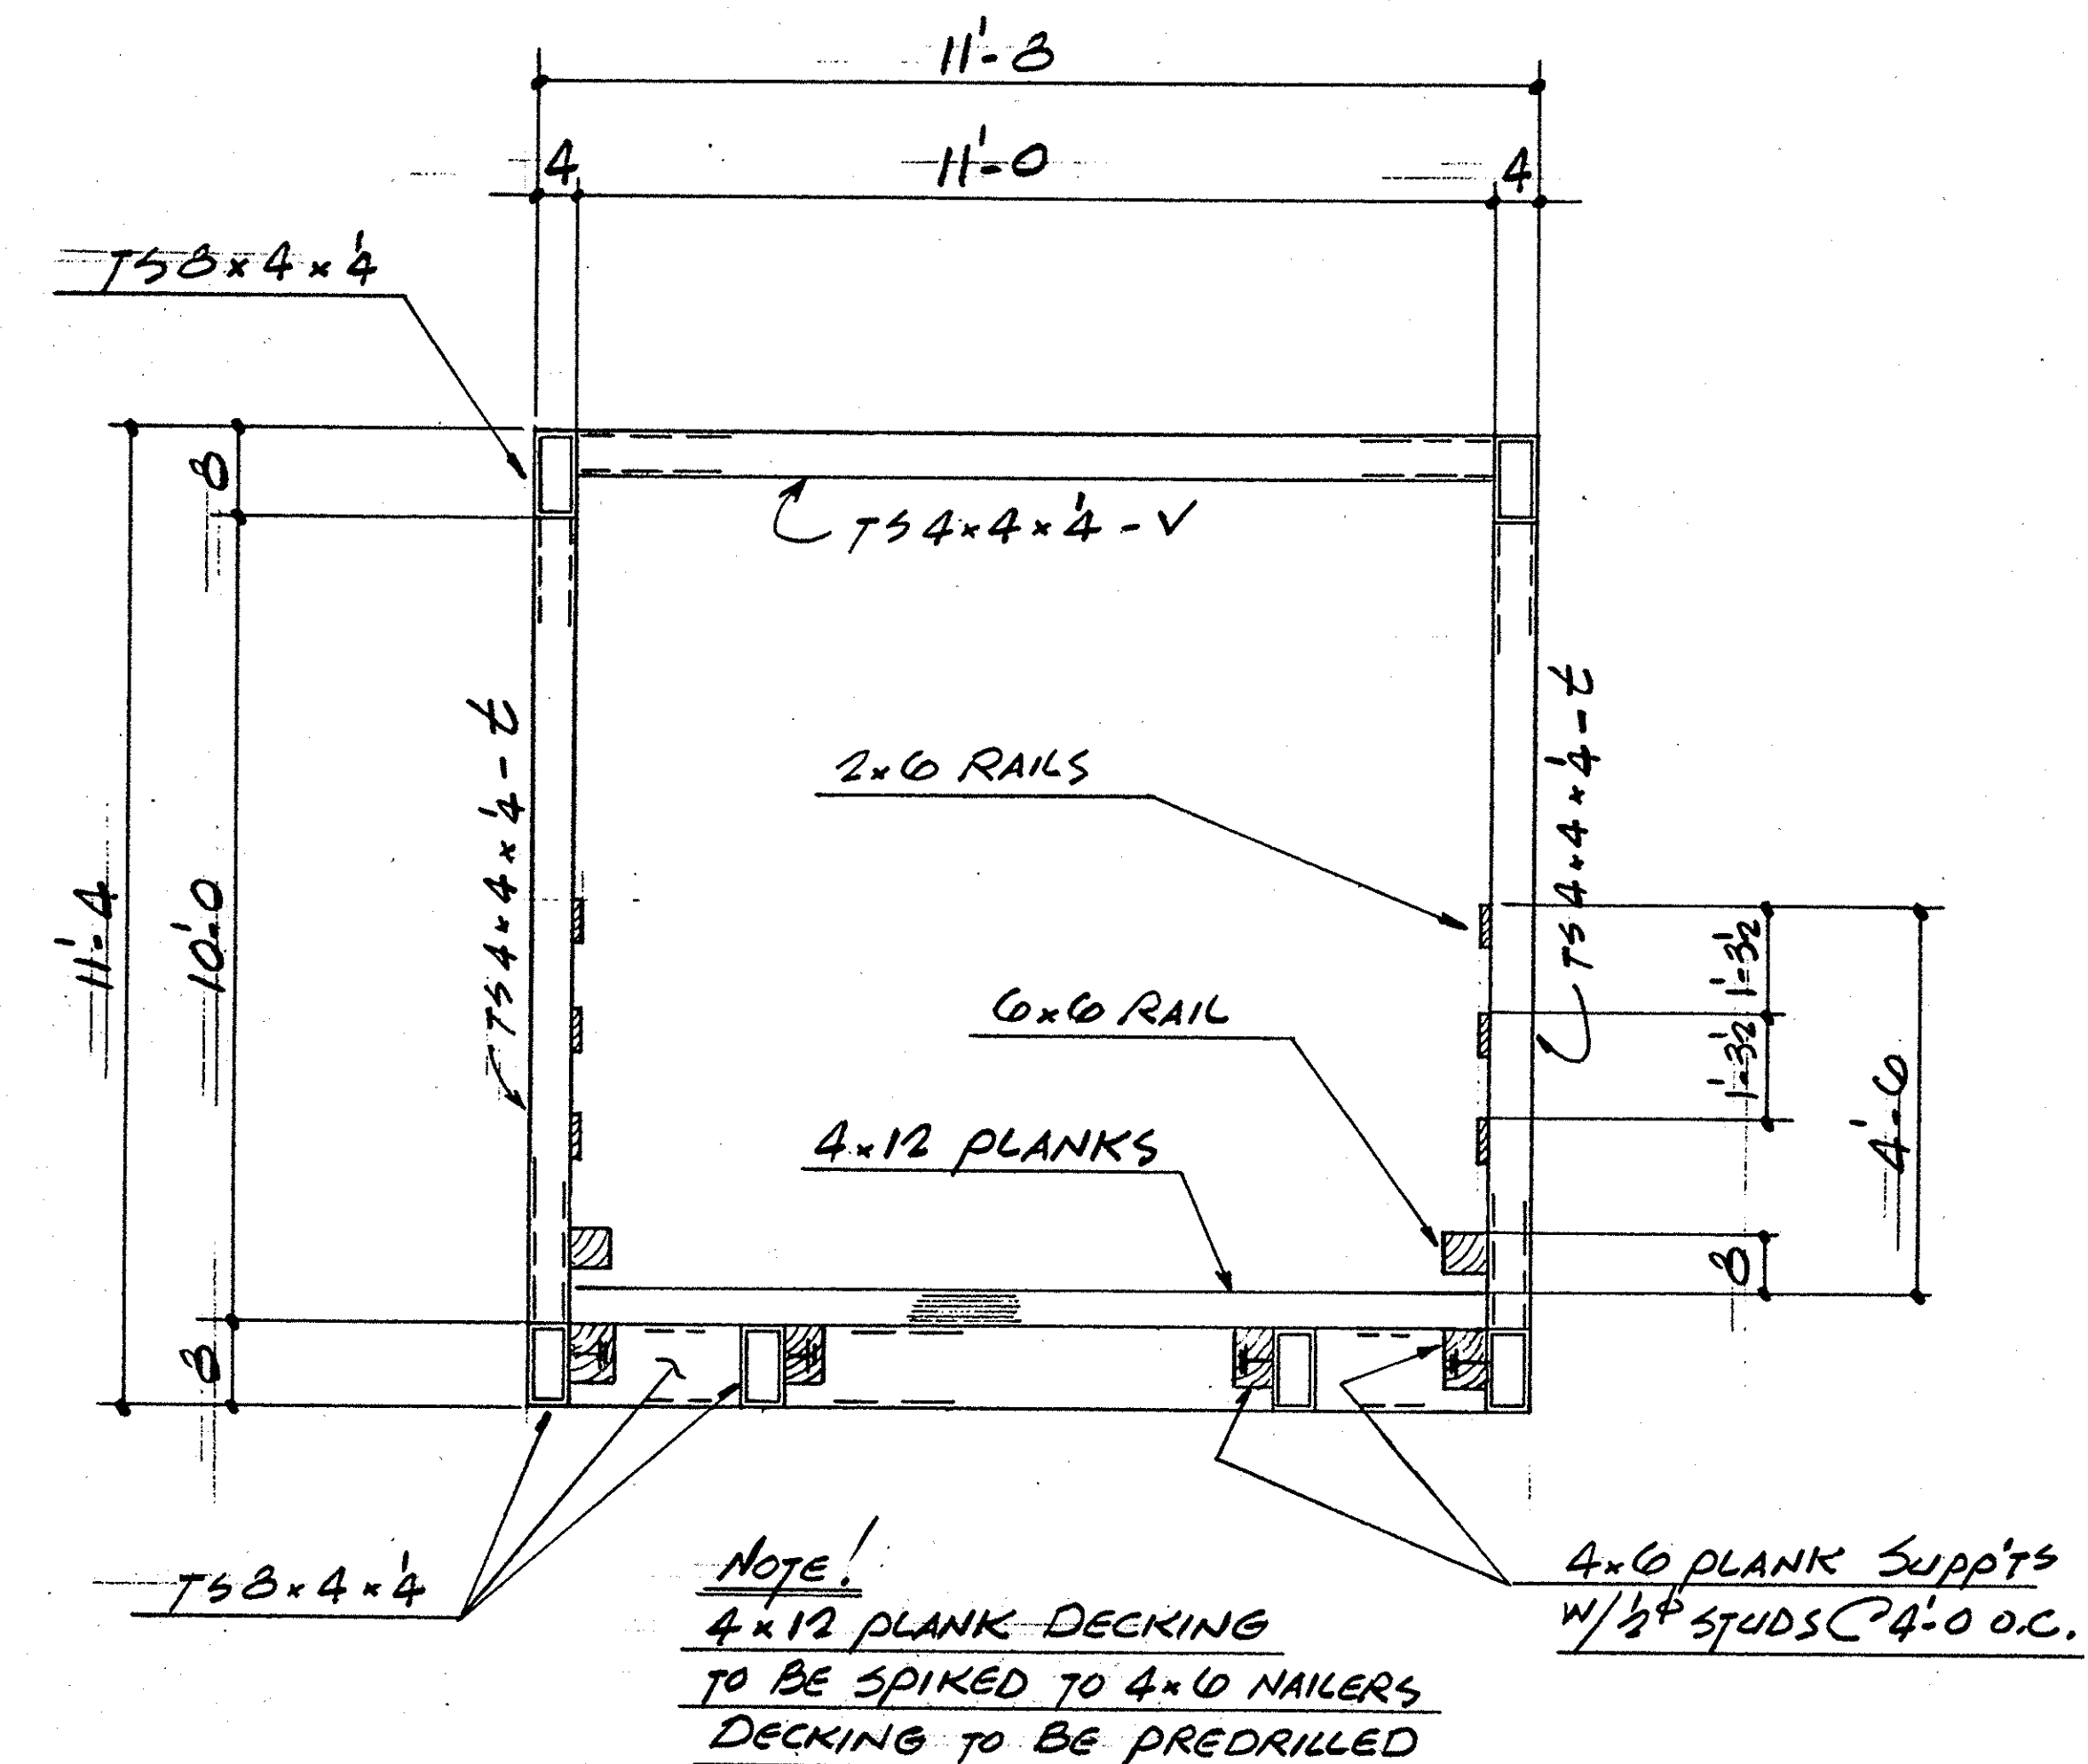

SECT. B-B THRU BRIDGE

WORK THIS DWG. WITH DWG. NOS 1, 2 & 4

NO.		DATE	DESCRIPTION	SCALE:		DRAWN BY: <u>DL</u> 9/92		CHECKED BY: <u>LS</u> 9/92		APPROD BY: <u>LS</u> 9/92		CUST. P.O. NO.		WORK ORDER NO.		DWG. NO.		REV.	
				REVISIONS															
THIS DWG AND ALL INFORMATION HEREON IS THE PROPERTY OF PLAS-TAL MFG. CO., INC. AND IS LENT TO THE BORROWER FOR HIS CONFIDENTIAL USE ONLY. ALL RIGHTS OF DESIGN & DETAILS ARE RESERVED.																			
PLAS-TAL MFG. CO., INC. 8815 SO. SORESEN AVE. SANTA FE SPRINGS, CALIF. 213 • 685-6874 213 • 691-0517										CUSTOMER SOUTH UNDERGROUND CONST. JOB DESCRIPTION BIKE TRAIL BRIDGE LOCATION SANTA ANA RIVER									
J-4602										3									