



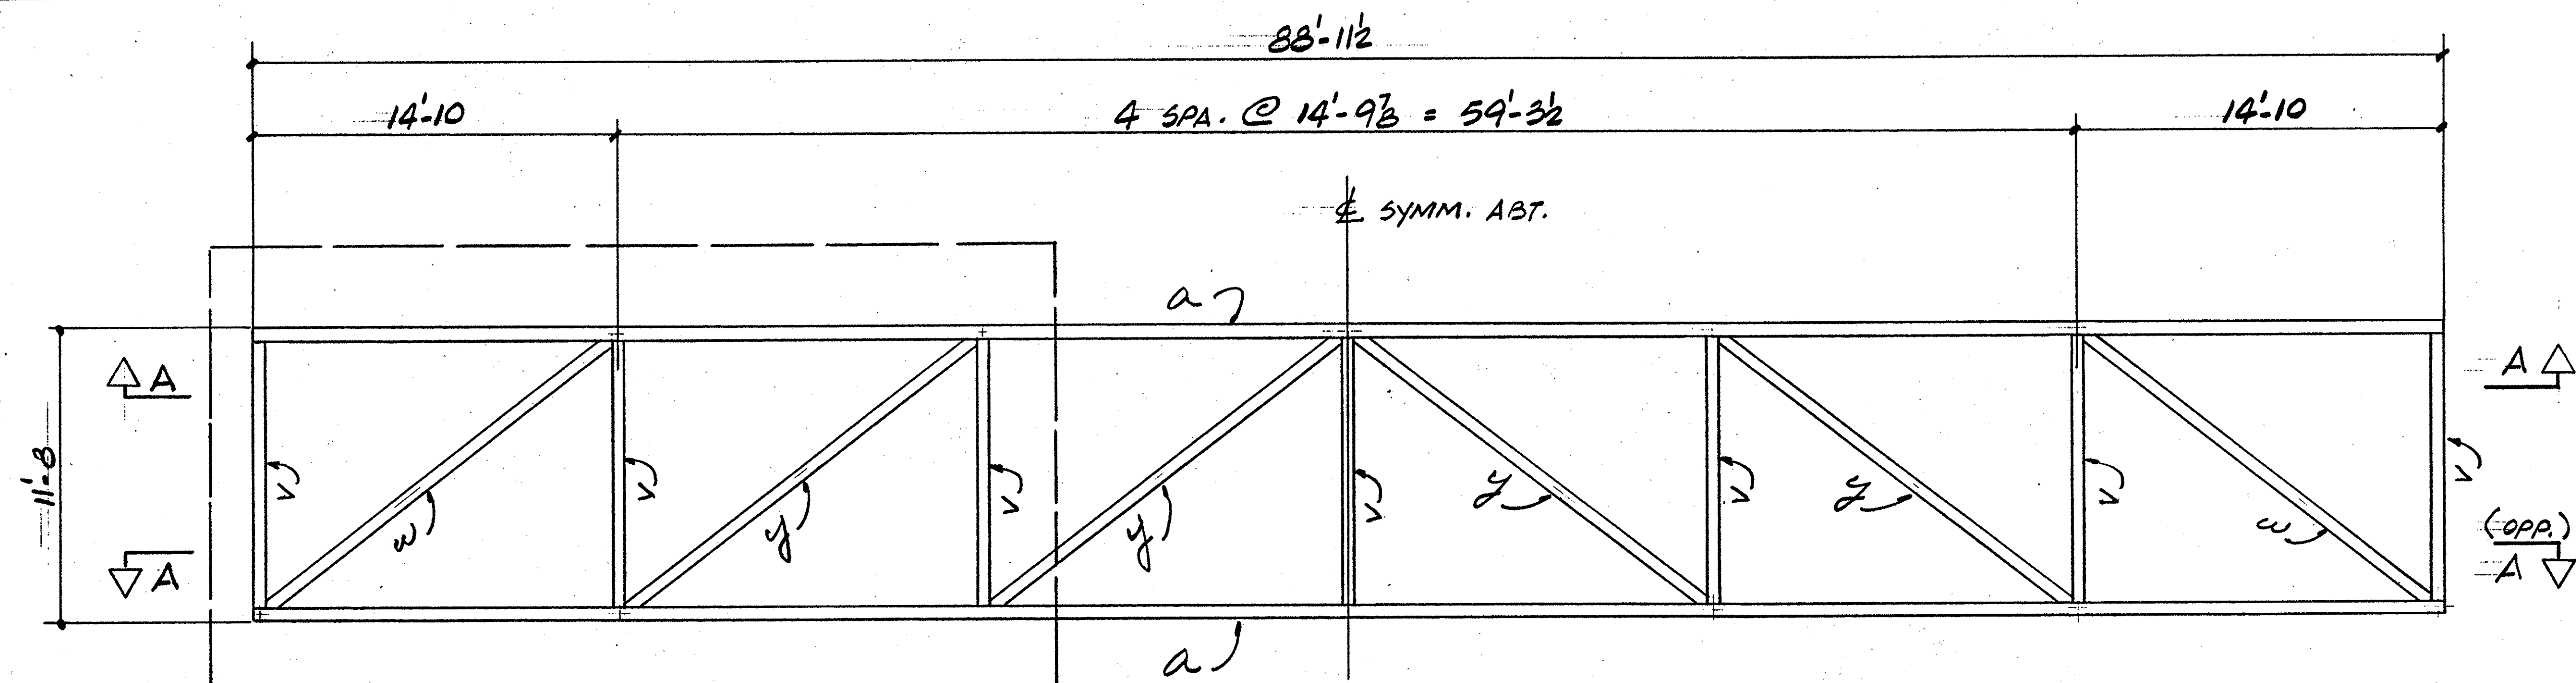


DETAIL 3

TRUSS TOP PLAN

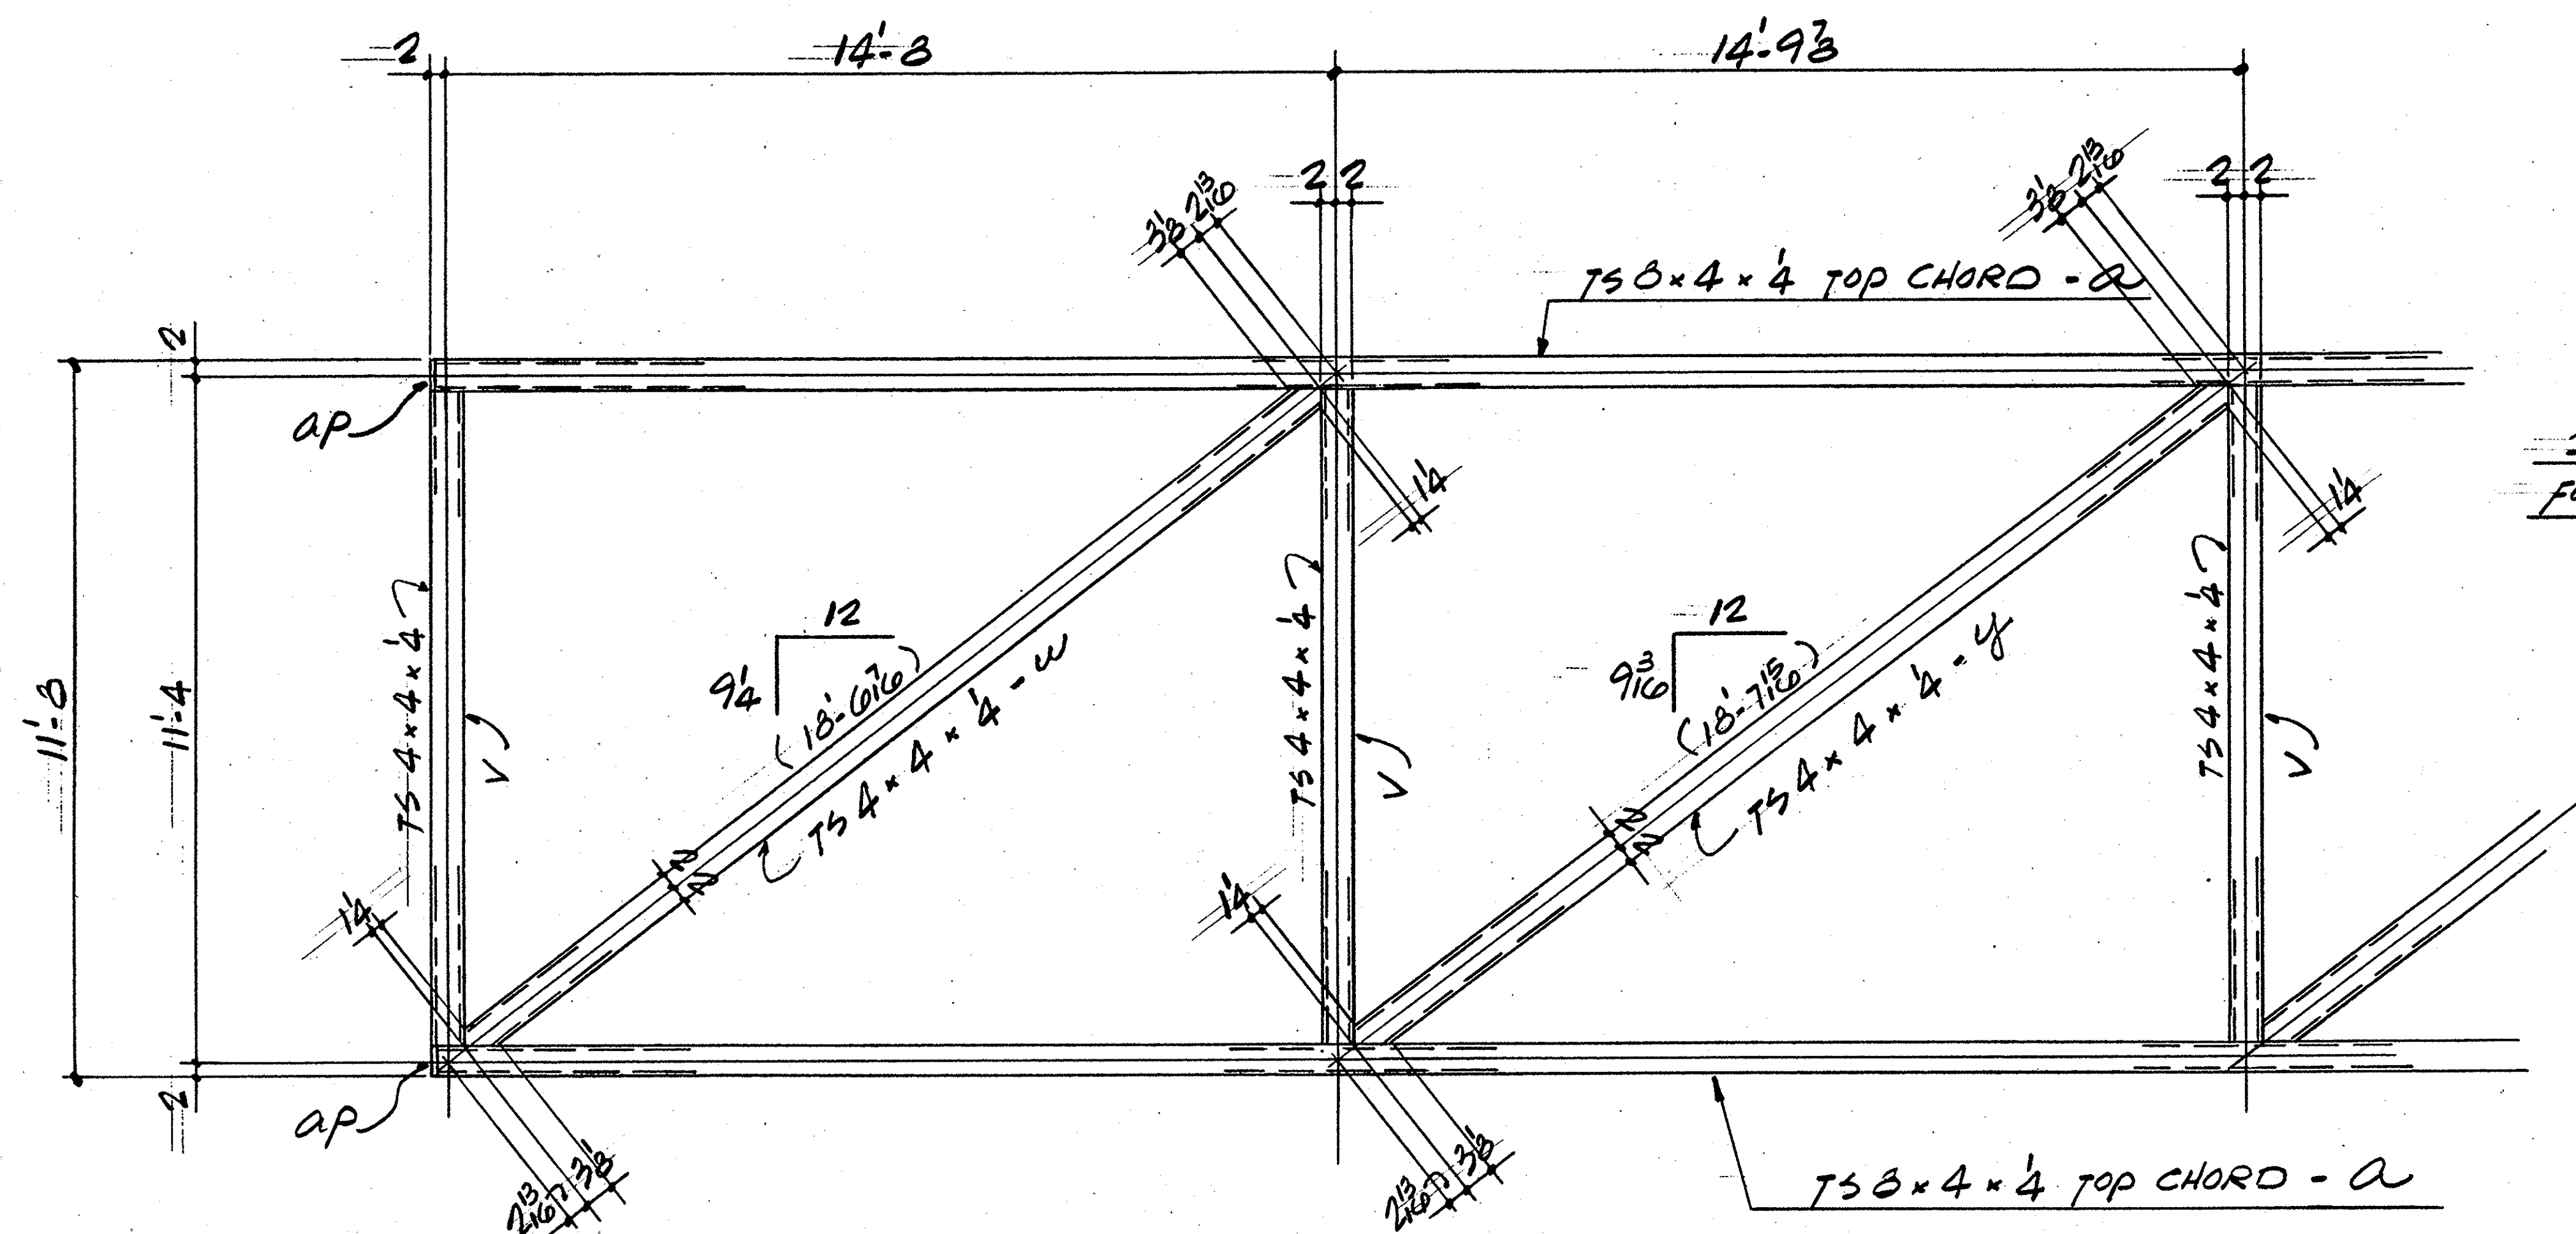

ENLARGED DETAIL 3

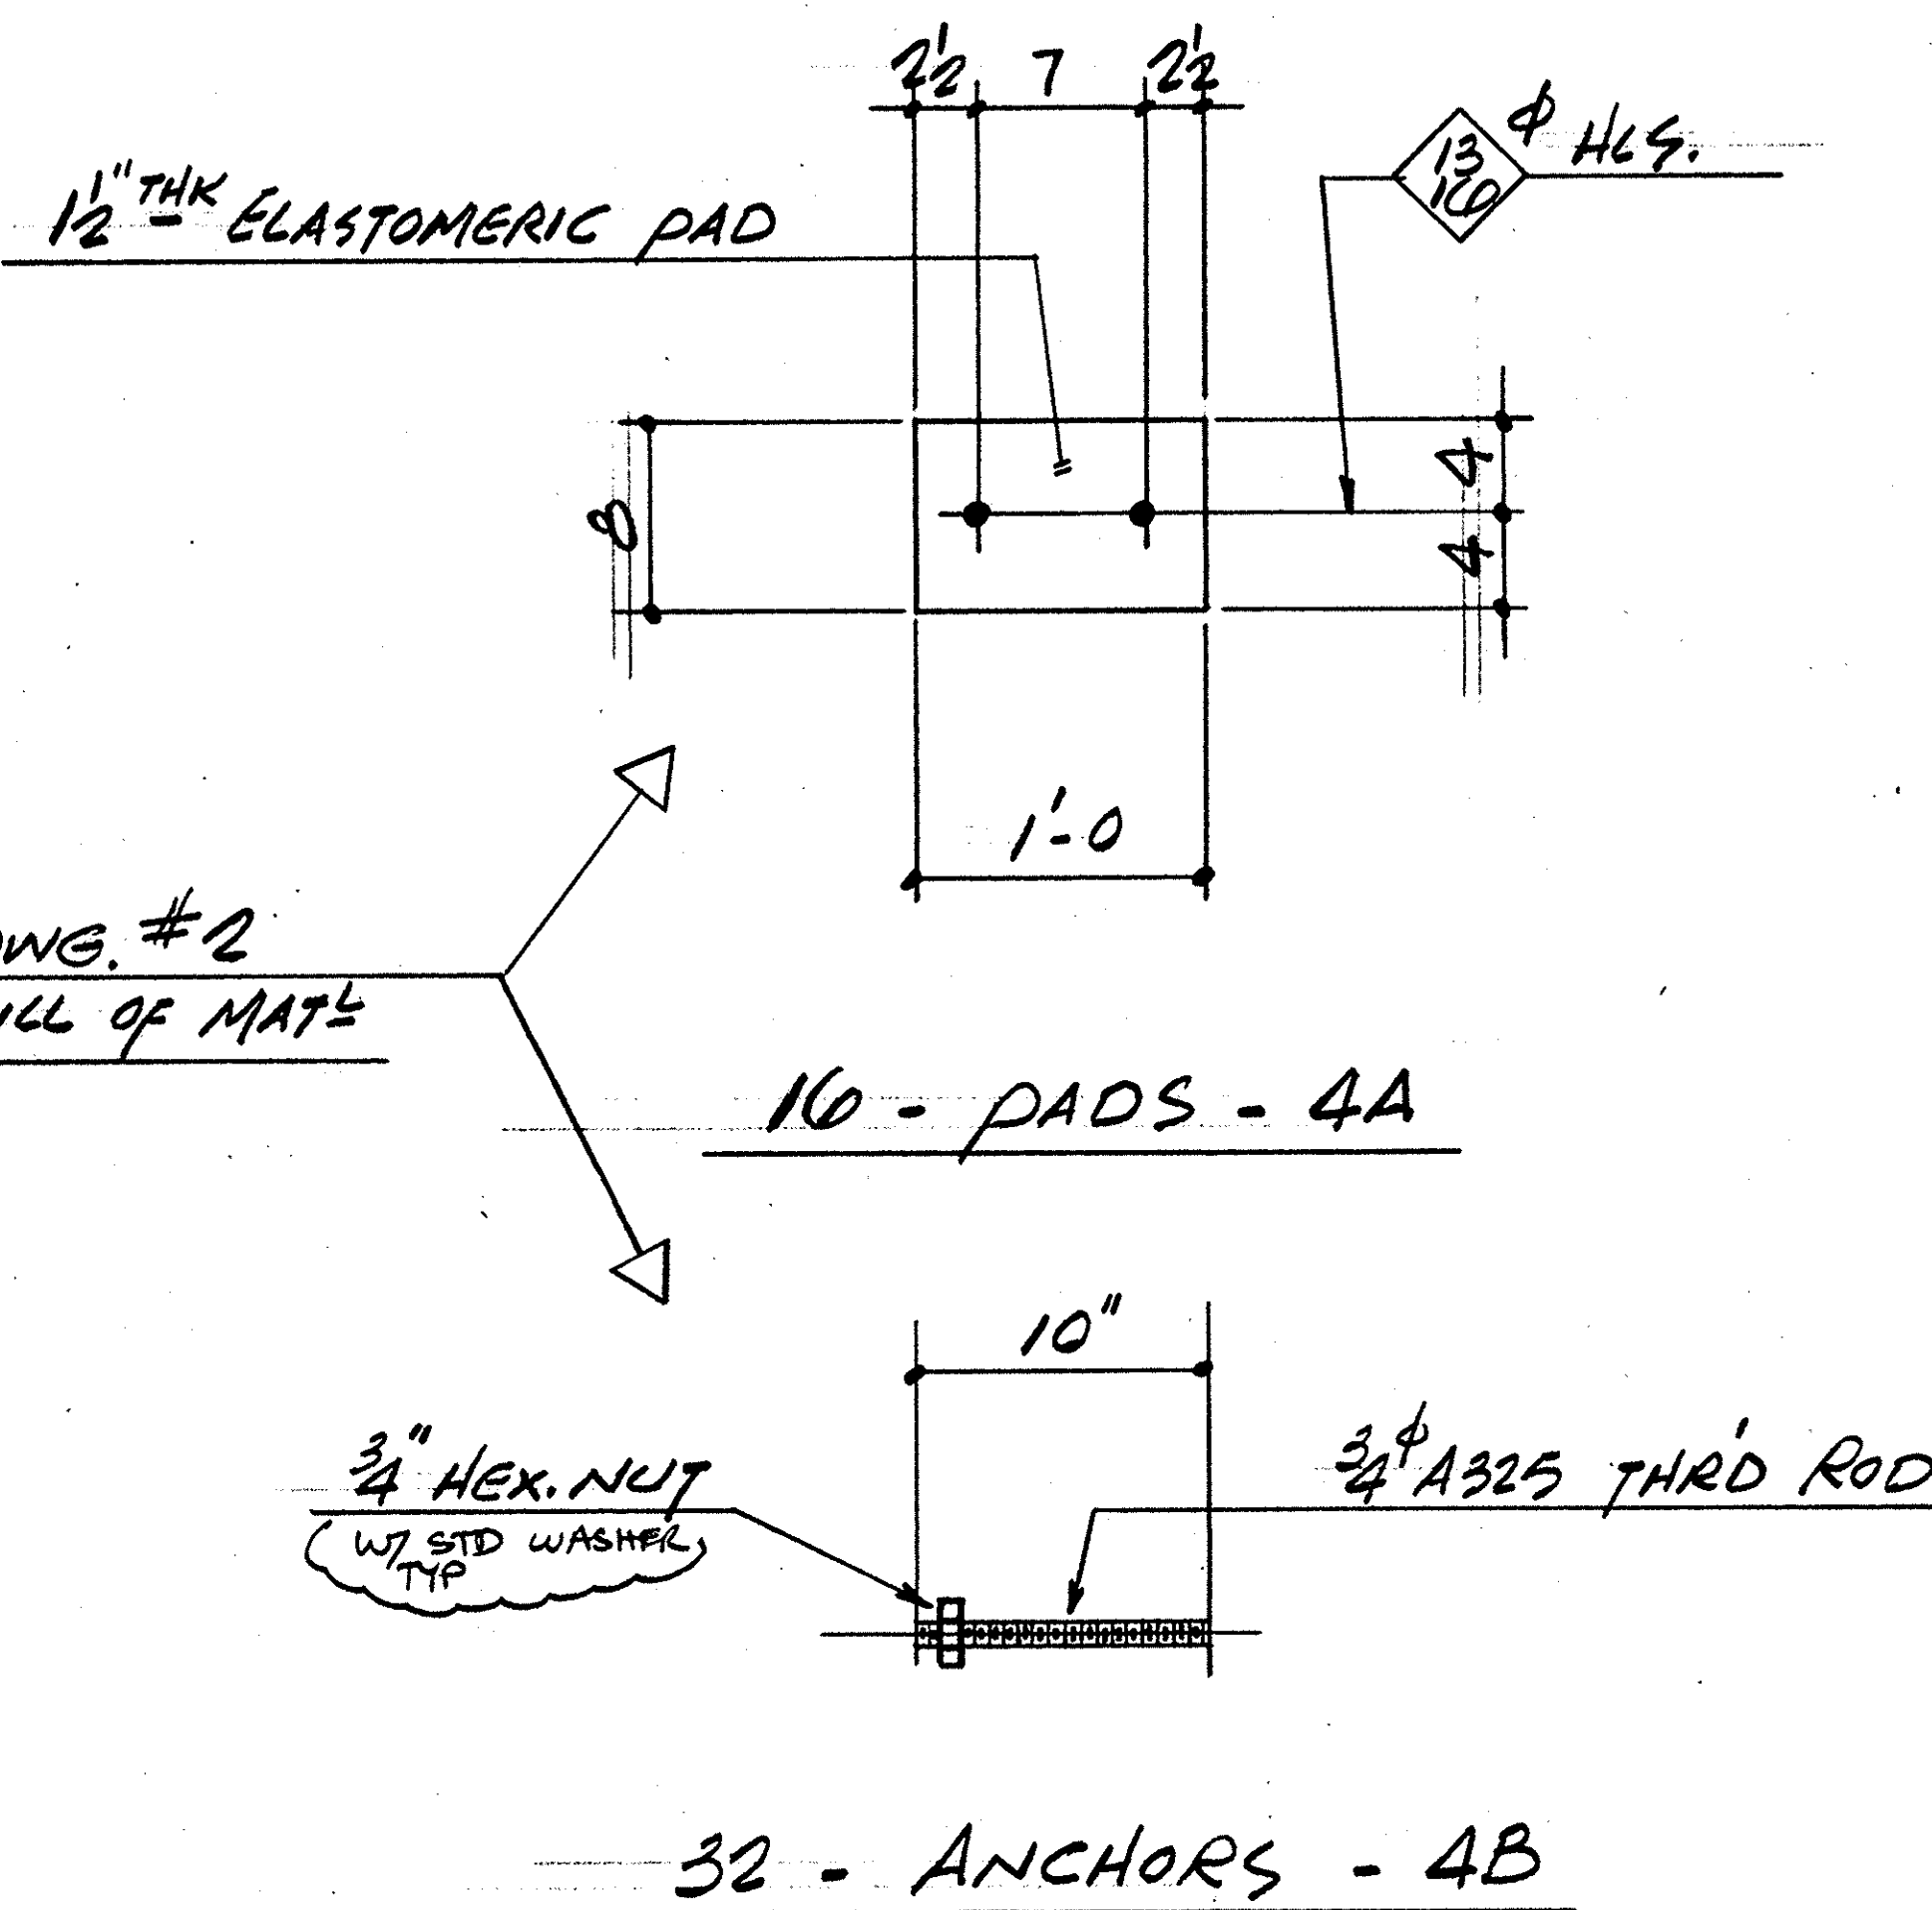

32 - ANCHORS - 4B

WORK THIS DWG. WITH DWG. NOS 1, 2 & 3

SCALE: DRAWN BY: <u>IL</u> DATE: <u>9/92</u> CHECKED BY: <u>J</u> DATE: <u>9/92</u> APPROVED BY: _____ DATE: _____ NO. DATE DESCRIPTION 1092 ADD NOTE FOR WASHERS @ 4B		PMC PLAS-TAL MFG. CO., INC. 8815 SO. SORENSON AVE. SANTA FE SPRINGS, CALIF. 91786 213 • 685-6874 213 • 691-0517 CUSTOMER: <u>SOUTH UNDERGROUND CONST.</u> JOB DESCRIPTION: <u>BIKE TRAIL BRIDGE</u> LOCATION: <u>SANTA ANA RIVER</u> CUST. P.O. NO.: _____ WORK ORDER NO.: <u>J-4602</u> DWG. NO.: <u>4</u>	
THIS DWG AND ALL INFORMATION HEREON IS THE PROPERTY OF PLAS-TAL MFG. CO., INC. AND IS LENT TO THE BORROWER FOR HIS CONFIDENTIAL USE ONLY. ALL RIGHTS OF DESIGN & DETAILS ARE RESERVED.		REV. <u>1</u>	

SAR BIKE TRAIL BR., 428' U/S OF IMPERIAL HWY - 5/1992
 SH. 9/17