




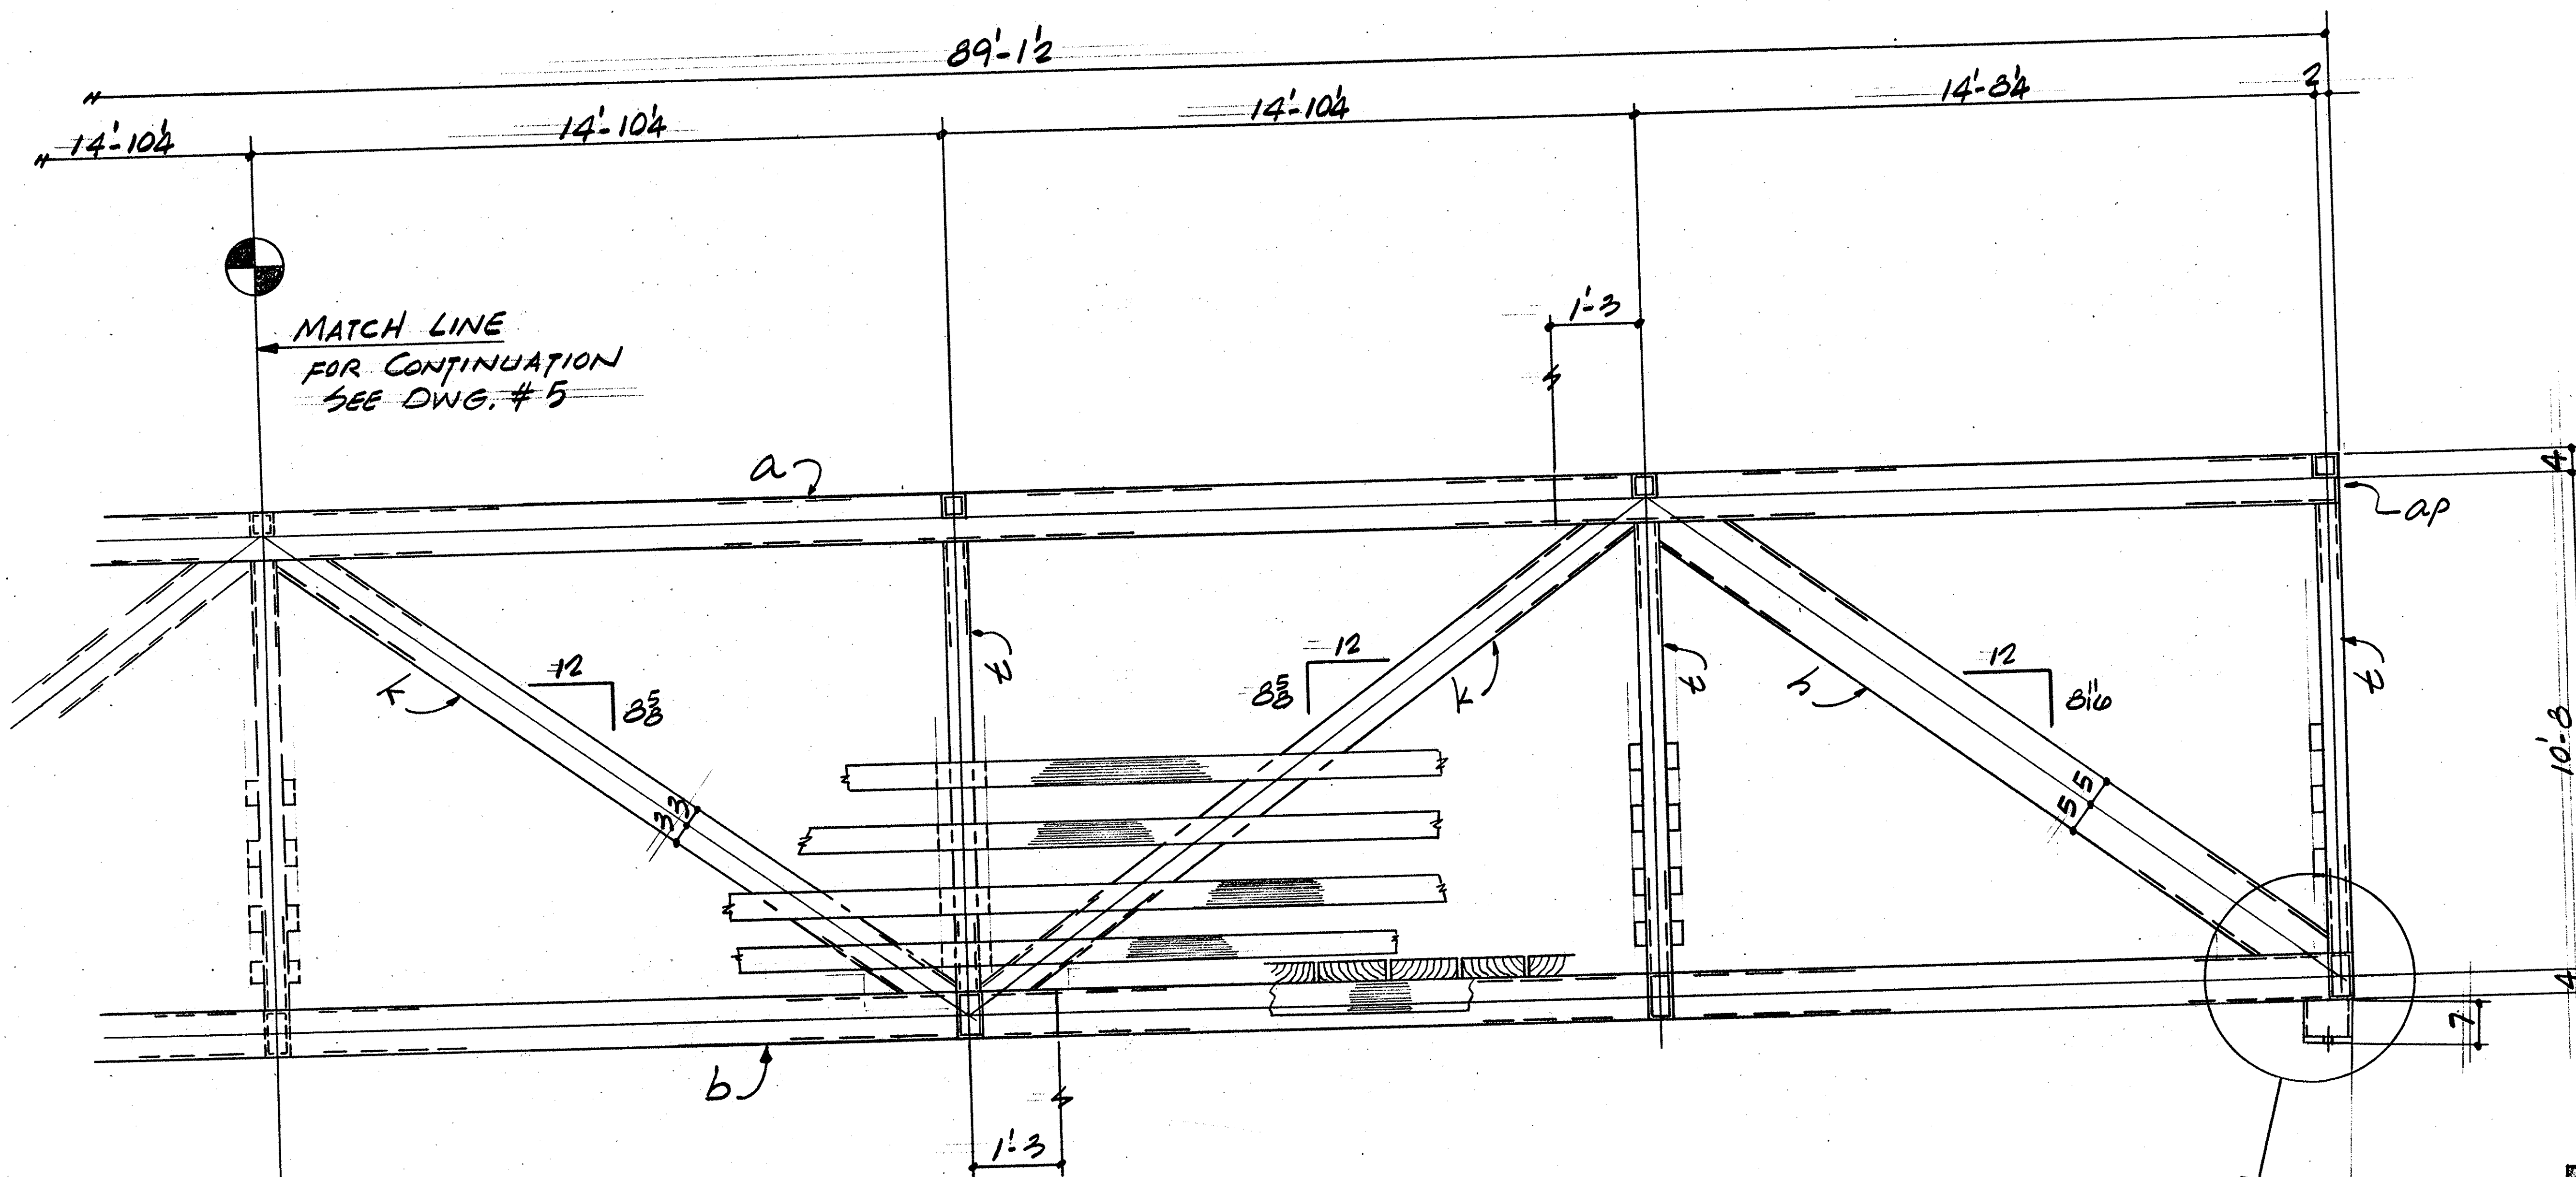


FOR SIZES & NOTES
NOT SHOWN SEE DWG. # 5

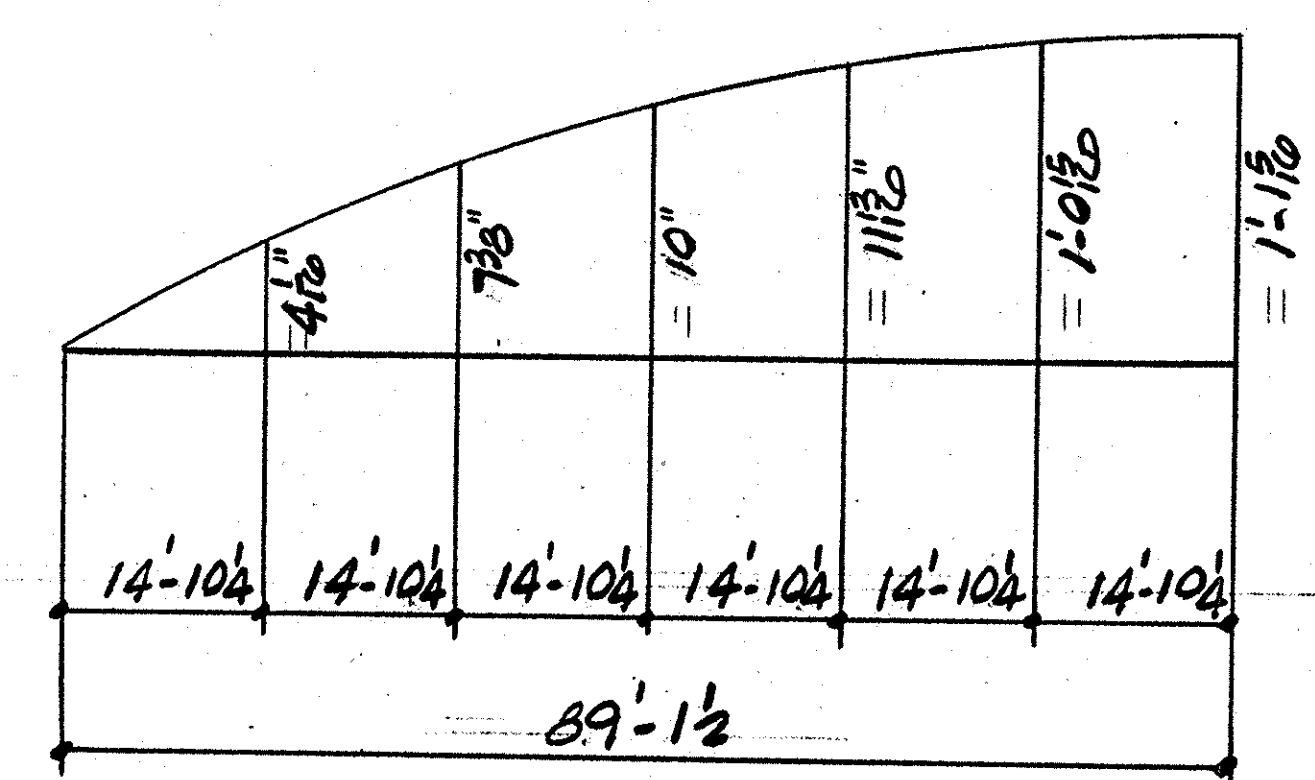

CAMBER DIAGRAM

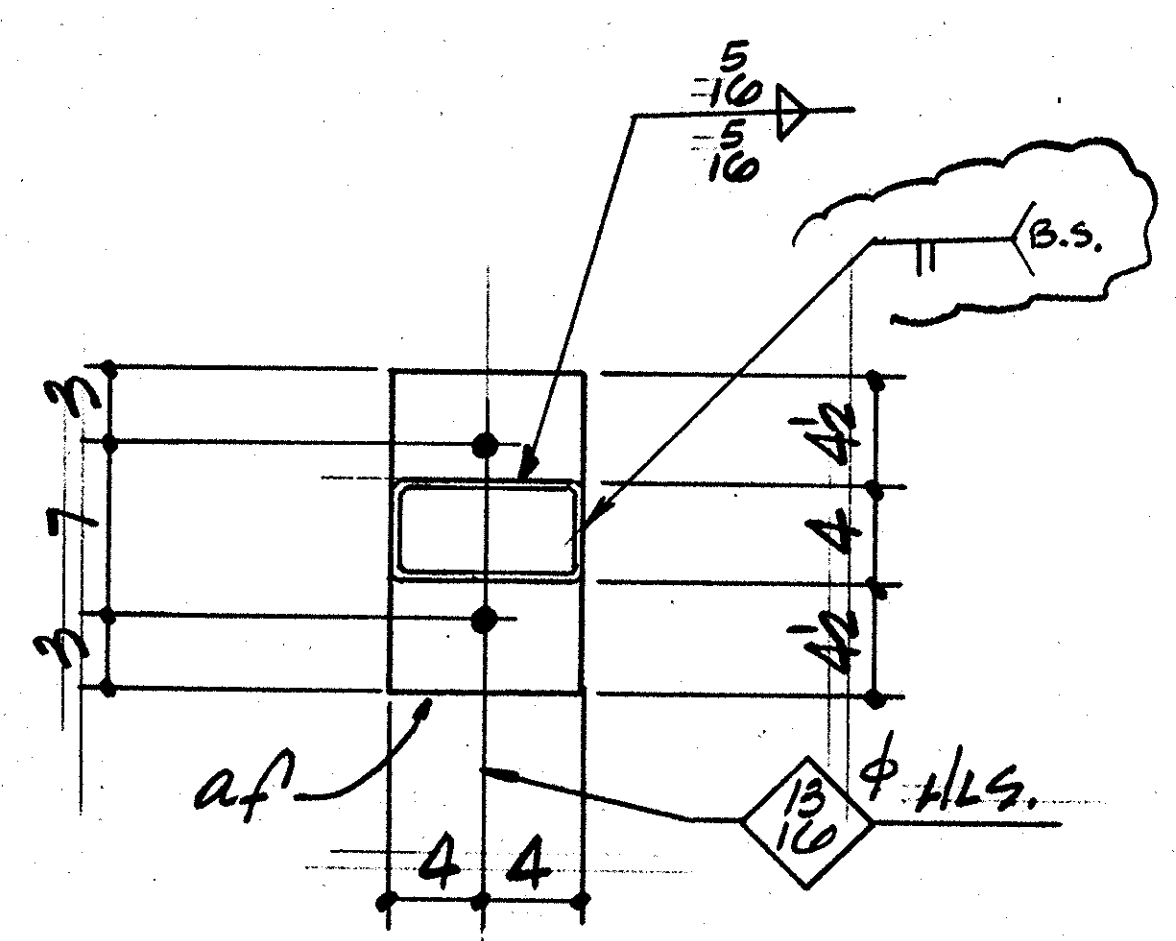

PLAN X

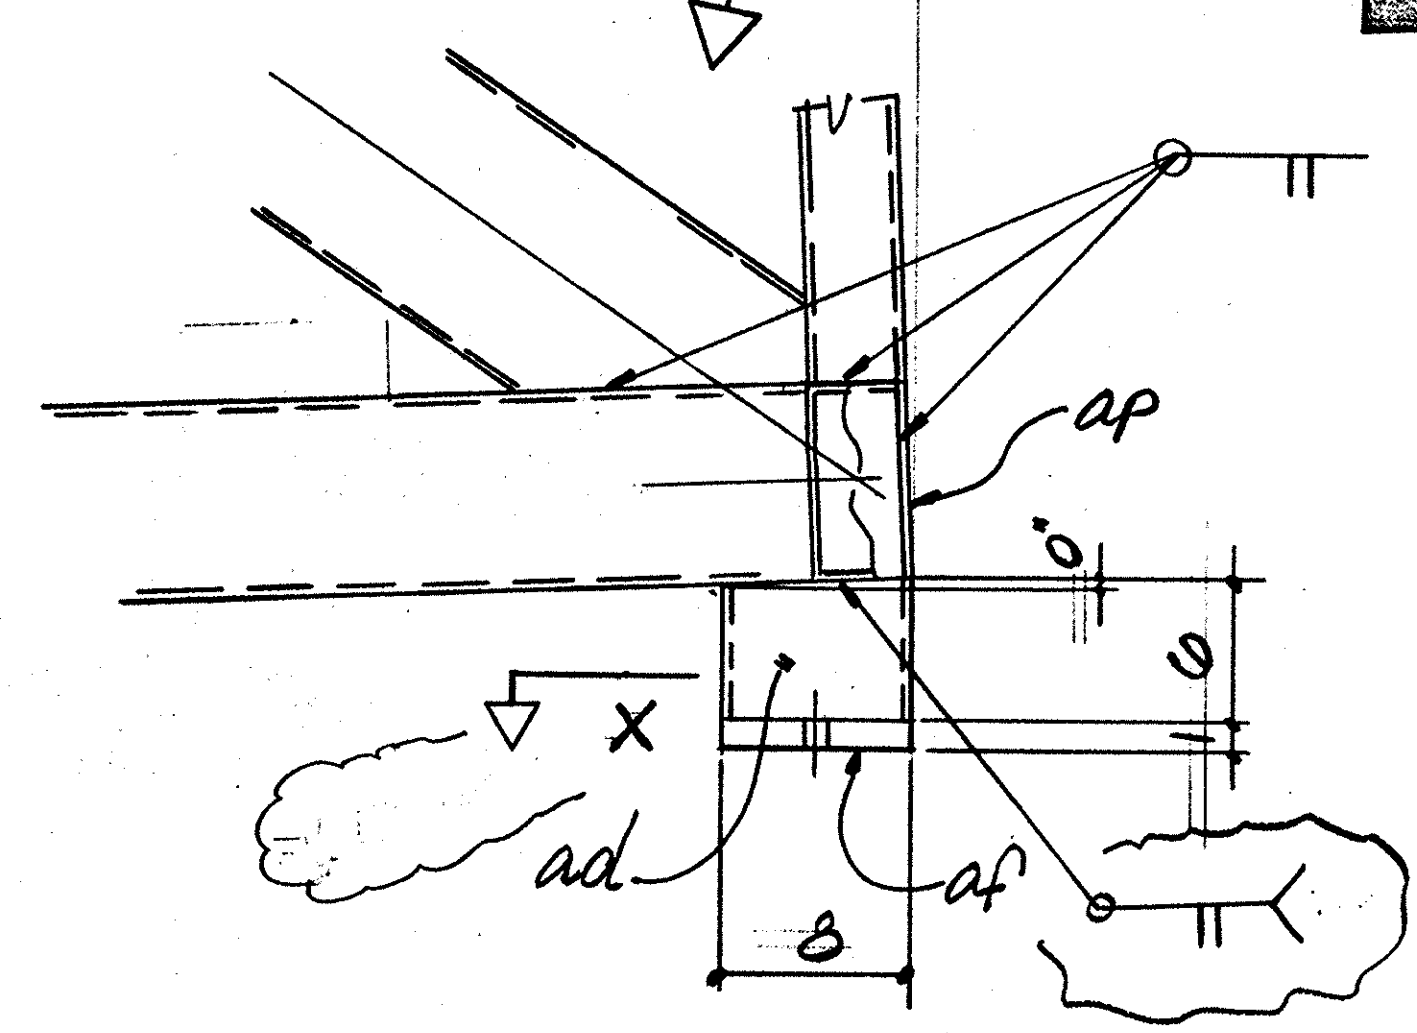

SHIPPING MARKS TO
READ RIGHT SIDE UP ON
LEFT END OF MEMBER
IN POSITION SHOWN.

APPL	SHOP	FIELD	PURCH

BILL OF MATERIAL																																																																																																																																																																																																																																																																																																																								
NO OF PIECES	SHIP MARK	ASSY MARK	SECTION	LENGTH		REMARKS	WT.																																																																																																																																																																																																																																																																																																																	
				FEET	INCHES																																																																																																																																																																																																																																																																																																																			
ONE 5A			BRIDGE TRUSS																																																																																																																																																																																																																																																																																																																					
ONE 5B			do																																																																																																																																																																																																																																																																																																																					
4	a		TSB x 4 x 4	89	1	SHOP SPlice AS SHW. ADD FOR CAMBER																																																																																																																																																																																																																																																																																																																		
4	b			89	1	"																																																																																																																																																																																																																																																																																																																		
8	c			14	4 1/2																																																																																																																																																																																																																																																																																																																			
10	d			14	0 1/2																																																																																																																																																																																																																																																																																																																			
14	e			11	0																																																																																																																																																																																																																																																																																																																			
8	h		TS 10 x 4 x 4	17	5 1/2	FIT. 2.E.																																																																																																																																																																																																																																																																																																																		
10	k		TS 10 x 4 x 4	17	7 1/2	FIT. 2.E.																																																																																																																																																																																																																																																																																																																		
8	m			4	0 1/2	FIT. 1.E. BEV. 1.E.																																																																																																																																																																																																																																																																																																																		
4	p		do	9	3/2	BEV. 3.E.																																																																																																																																																																																																																																																																																																																		
23	t		TS 4 x 4 x 1/2	10	0																																																																																																																																																																																																																																																																																																																			
14	v			11	0																																																																																																																																																																																																																																																																																																																			
4	w			18	1	FIT. 2.E.																																																																																																																																																																																																																																																																																																																		
8	y			18	2 1/2	"																																																																																																																																																																																																																																																																																																																		
10	aa			4	1 1/2	FIT. 1.E. BEV. 1.E.																																																																																																																																																																																																																																																																																																																		
8	ab			9	9 1/2	BEV. 2.E.																																																																																																																																																																																																																																																																																																																		
4	ac		TSB x 4 x 4	0	0 1/2	BEV. 1.E.																																																																																																																																																																																																																																																																																																																		
4	ad		do	0	0	"																																																																																																																																																																																																																																																																																																																		
4	af		1 x 8	1	1																																																																																																																																																																																																																																																																																																																			
4	ag		do	1	1																																																																																																																																																																																																																																																																																																																			
8	ap		F.B. 4 x 4	0	3	CLOSURES (TEMP.)																																																																																																																																																																																																																																																																																																																		
184	ae		F.B. 2 x 4	0	5 1/2																																																																																																																																																																																																																																																																																																																			
180			4x12 PLANKS	10	11	FLOOR																																																																																																																																																																																																																																																																																																																		
24			4x6 WOOD	7 1/2	4 1/2	" SUPPL																																																																																																																																																																																																																																																																																																																		
			6x6 WOOD	14	10	RAILS																																																																																																																																																																																																																																																																																																																		
72			2x6 WOOD	14	10	do																																																																																																																																																																																																																																																																																																																		
384			2" THRD STUDS	0	1 1/2	W/ NUT & WASH.																																																																																																																																																																																																																																																																																																																		
910			do	0	5 1/2																																																																																																																																																																																																																																																																																																																			
200			do	0	3 1/2	do																																																																																																																																																																																																																																																																																																																		
SHOP NOTE: ALL STEEL IS ASTM A533 OR A242 GRADE 50																																																																																																																																																																																																																																																																																																																								
REVISIONS <table border="1"> <thead> <tr> <th>NO.</th> <th>DATE</th> <th>DESCRIPTION</th> </tr> </thead> <tbody> <tr> <td>1</td> <td></td> <td></td> </tr> <tr> <td>2</td> <td></td> <td></td> </tr> <tr> <td>3</td> <td></td> <td></td> </tr> <tr> <td>4</td> <td></td> <td></td> </tr> <tr> <td>5</td> <td></td> <td></td> </tr> <tr> <td>6</td> <td></td> <td></td> </tr> <tr> <td>7</td> <td></td> <td></td> </tr> <tr> <td>8</td> <td></td> <td></td> </tr> <tr> <td>9</td> <td></td> <td></td> </tr> <tr> <td>10</td> <td></td> <td></td> </tr> <tr> <td>11</td> <td></td> <td></td> </tr> <tr> <td>12</td> <td></td> <td></td> </tr> <tr> <td>13</td> <td></td> <td></td> </tr> <tr> <td>14</td> <td></td> <td></td> </tr> <tr> <td>15</td> <td></td> <td></td> </tr> <tr> <td>16</td> <td></td> <td></td> </tr> <tr> <td>17</td> <td></td> <td></td> </tr> <tr> <td>18</td> <td></td> <td></td> </tr> <tr> <td>19</td> <td></td> <td></td> </tr> <tr> <td>95</td> <td></td> <td></td> </tr> <tr> <td>96</td> <td></td> <td></td> </tr> <tr> <td>97</td> <td></td> <td></td> </tr> <tr> <td>98</td> <td></td> <td></td> </tr> <tr> <td>99</td> <td></td> <td></td> </tr> <tr> <td>100</td> <td></td> <td></td> </tr> </tbody> </table>										NO.	DATE	DESCRIPTION	1			2			3			100		
NO.	DATE	DESCRIPTION																																																																																																																																																																																																																																																																																																																						
1																																																																																																																																																																																																																																																																																																																								
2																																																																																																																																																																																																																																																																																																																								
3																																																																																																																																																																																																																																																																																																																								
BOLTS: NOTED UNLESS NOTED HOLES: NONE PAINT: NONE																																																																																																																																																																																																																																																																																																																								
BRIDGE TRUSSES																																																																																																																																																																																																																																																																																																																								
DR BY: JL DATE: 9/92 CHECKED BY: LJ DATE: 9/92 APPROVED BY: [Signature]																																																																																																																																																																																																																																																																																																																								
PMC PLAS-TAL MFG. CO., INC. 8815 SO. SORESEN AVE. SANTA FE SPRINGS, CALIF. 310-945-0013																																																																																																																																																																																																																																																																																																																								
CUSTOMER: SOUTH UNDERGROUND CONST. JOB DESCRIPTION: BIKE TRAIL BRIDGE LOCATION: SANTA ANA RIVER																																																																																																																																																																																																																																																																																																																								
DATE: [Blank] SCALE: [Blank] WORK ORDER NO. J-4002 DWG. NO. 0.																																																																																																																																																																																																																																																																																																																								