



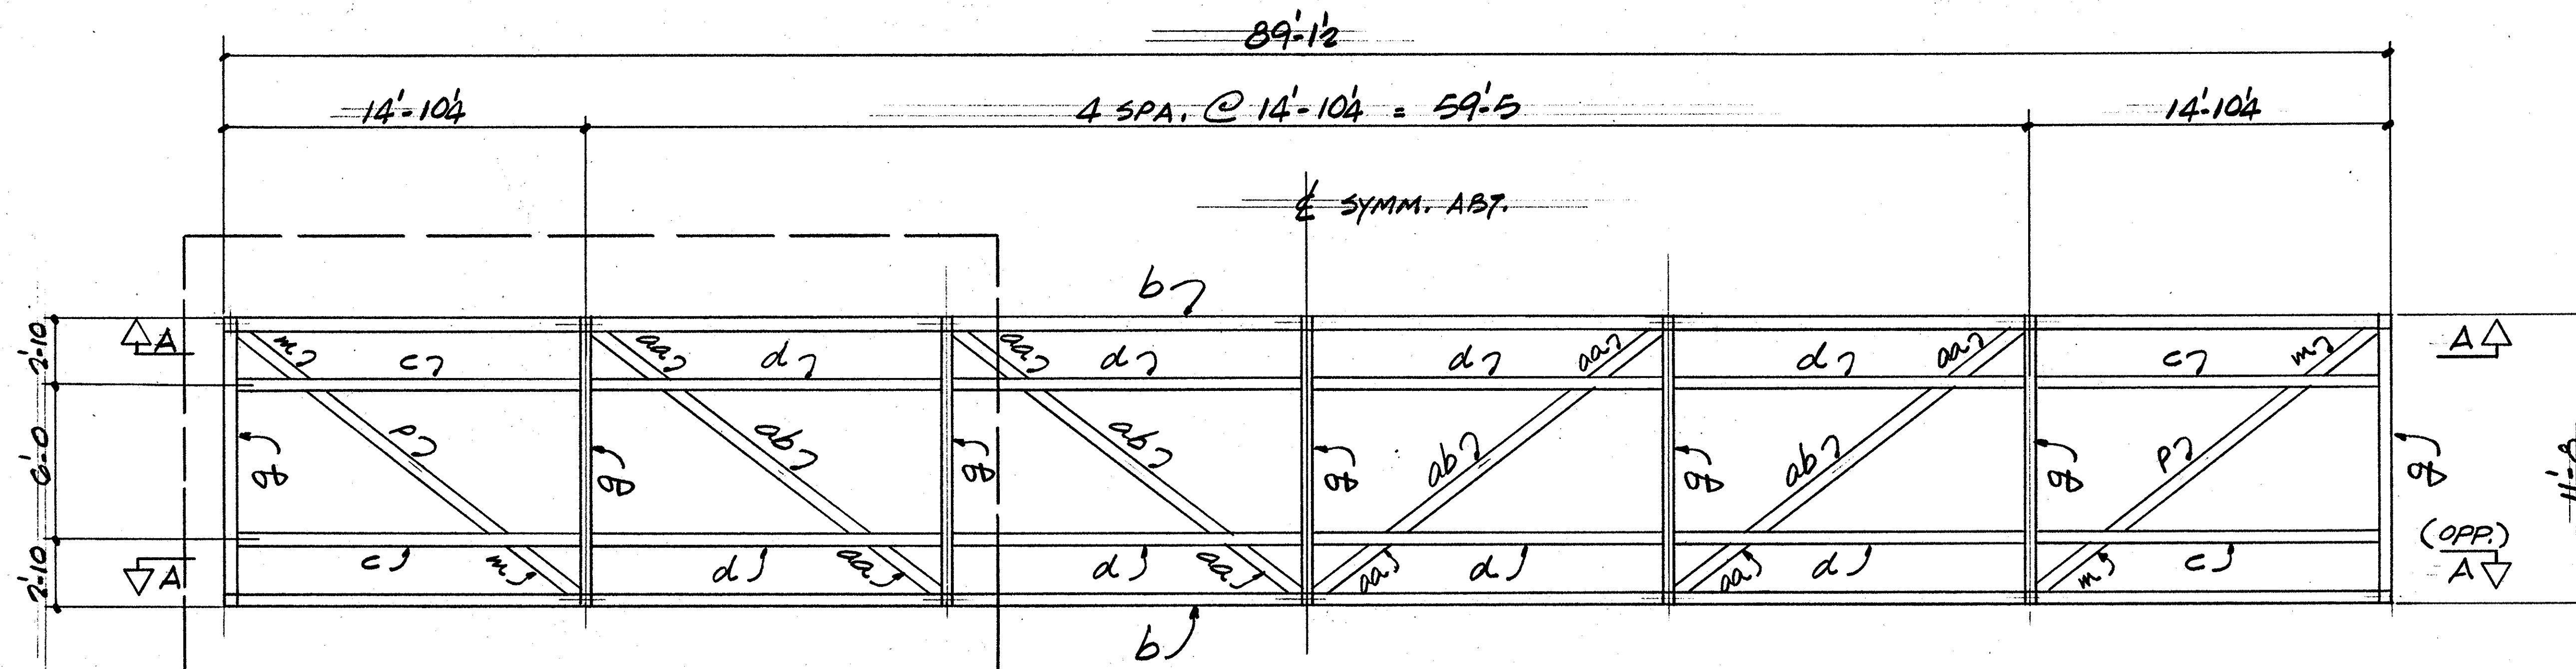


DETAIL 4

TRUSS FLOOR PLAN
(4x12 PLANKS NOT SHOWN FOR CLARITY)

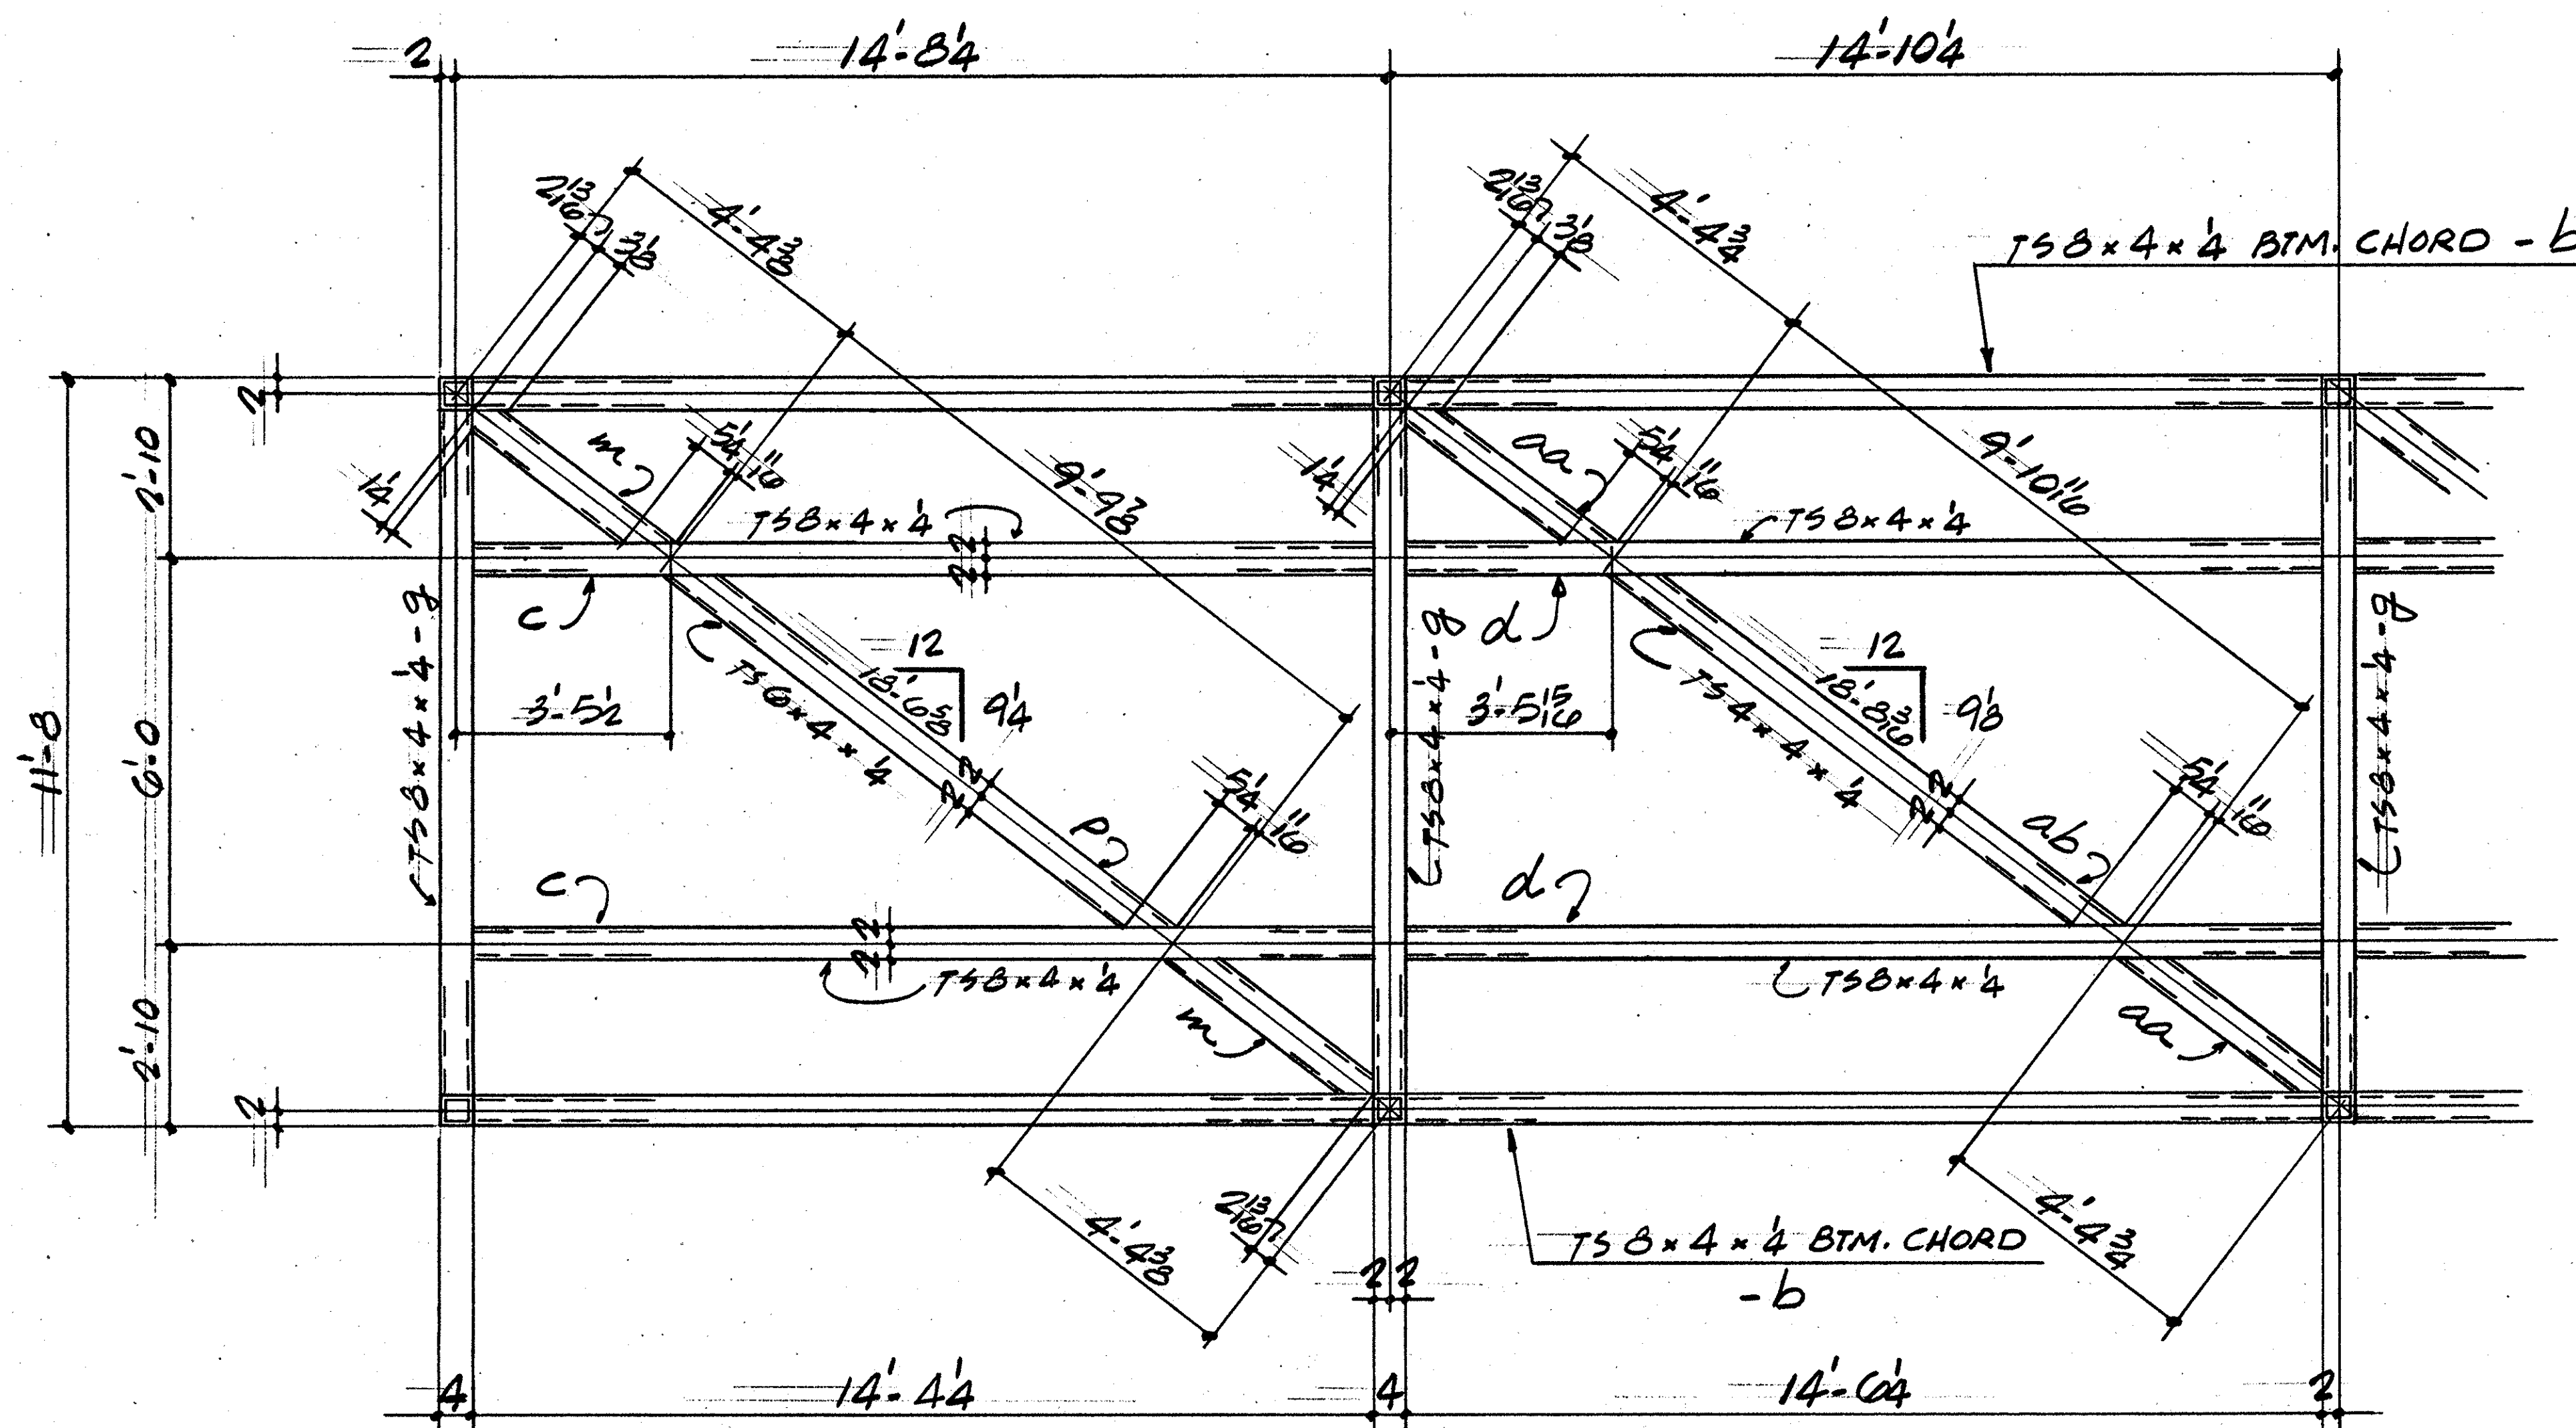

ENLARGED DETAIL 4

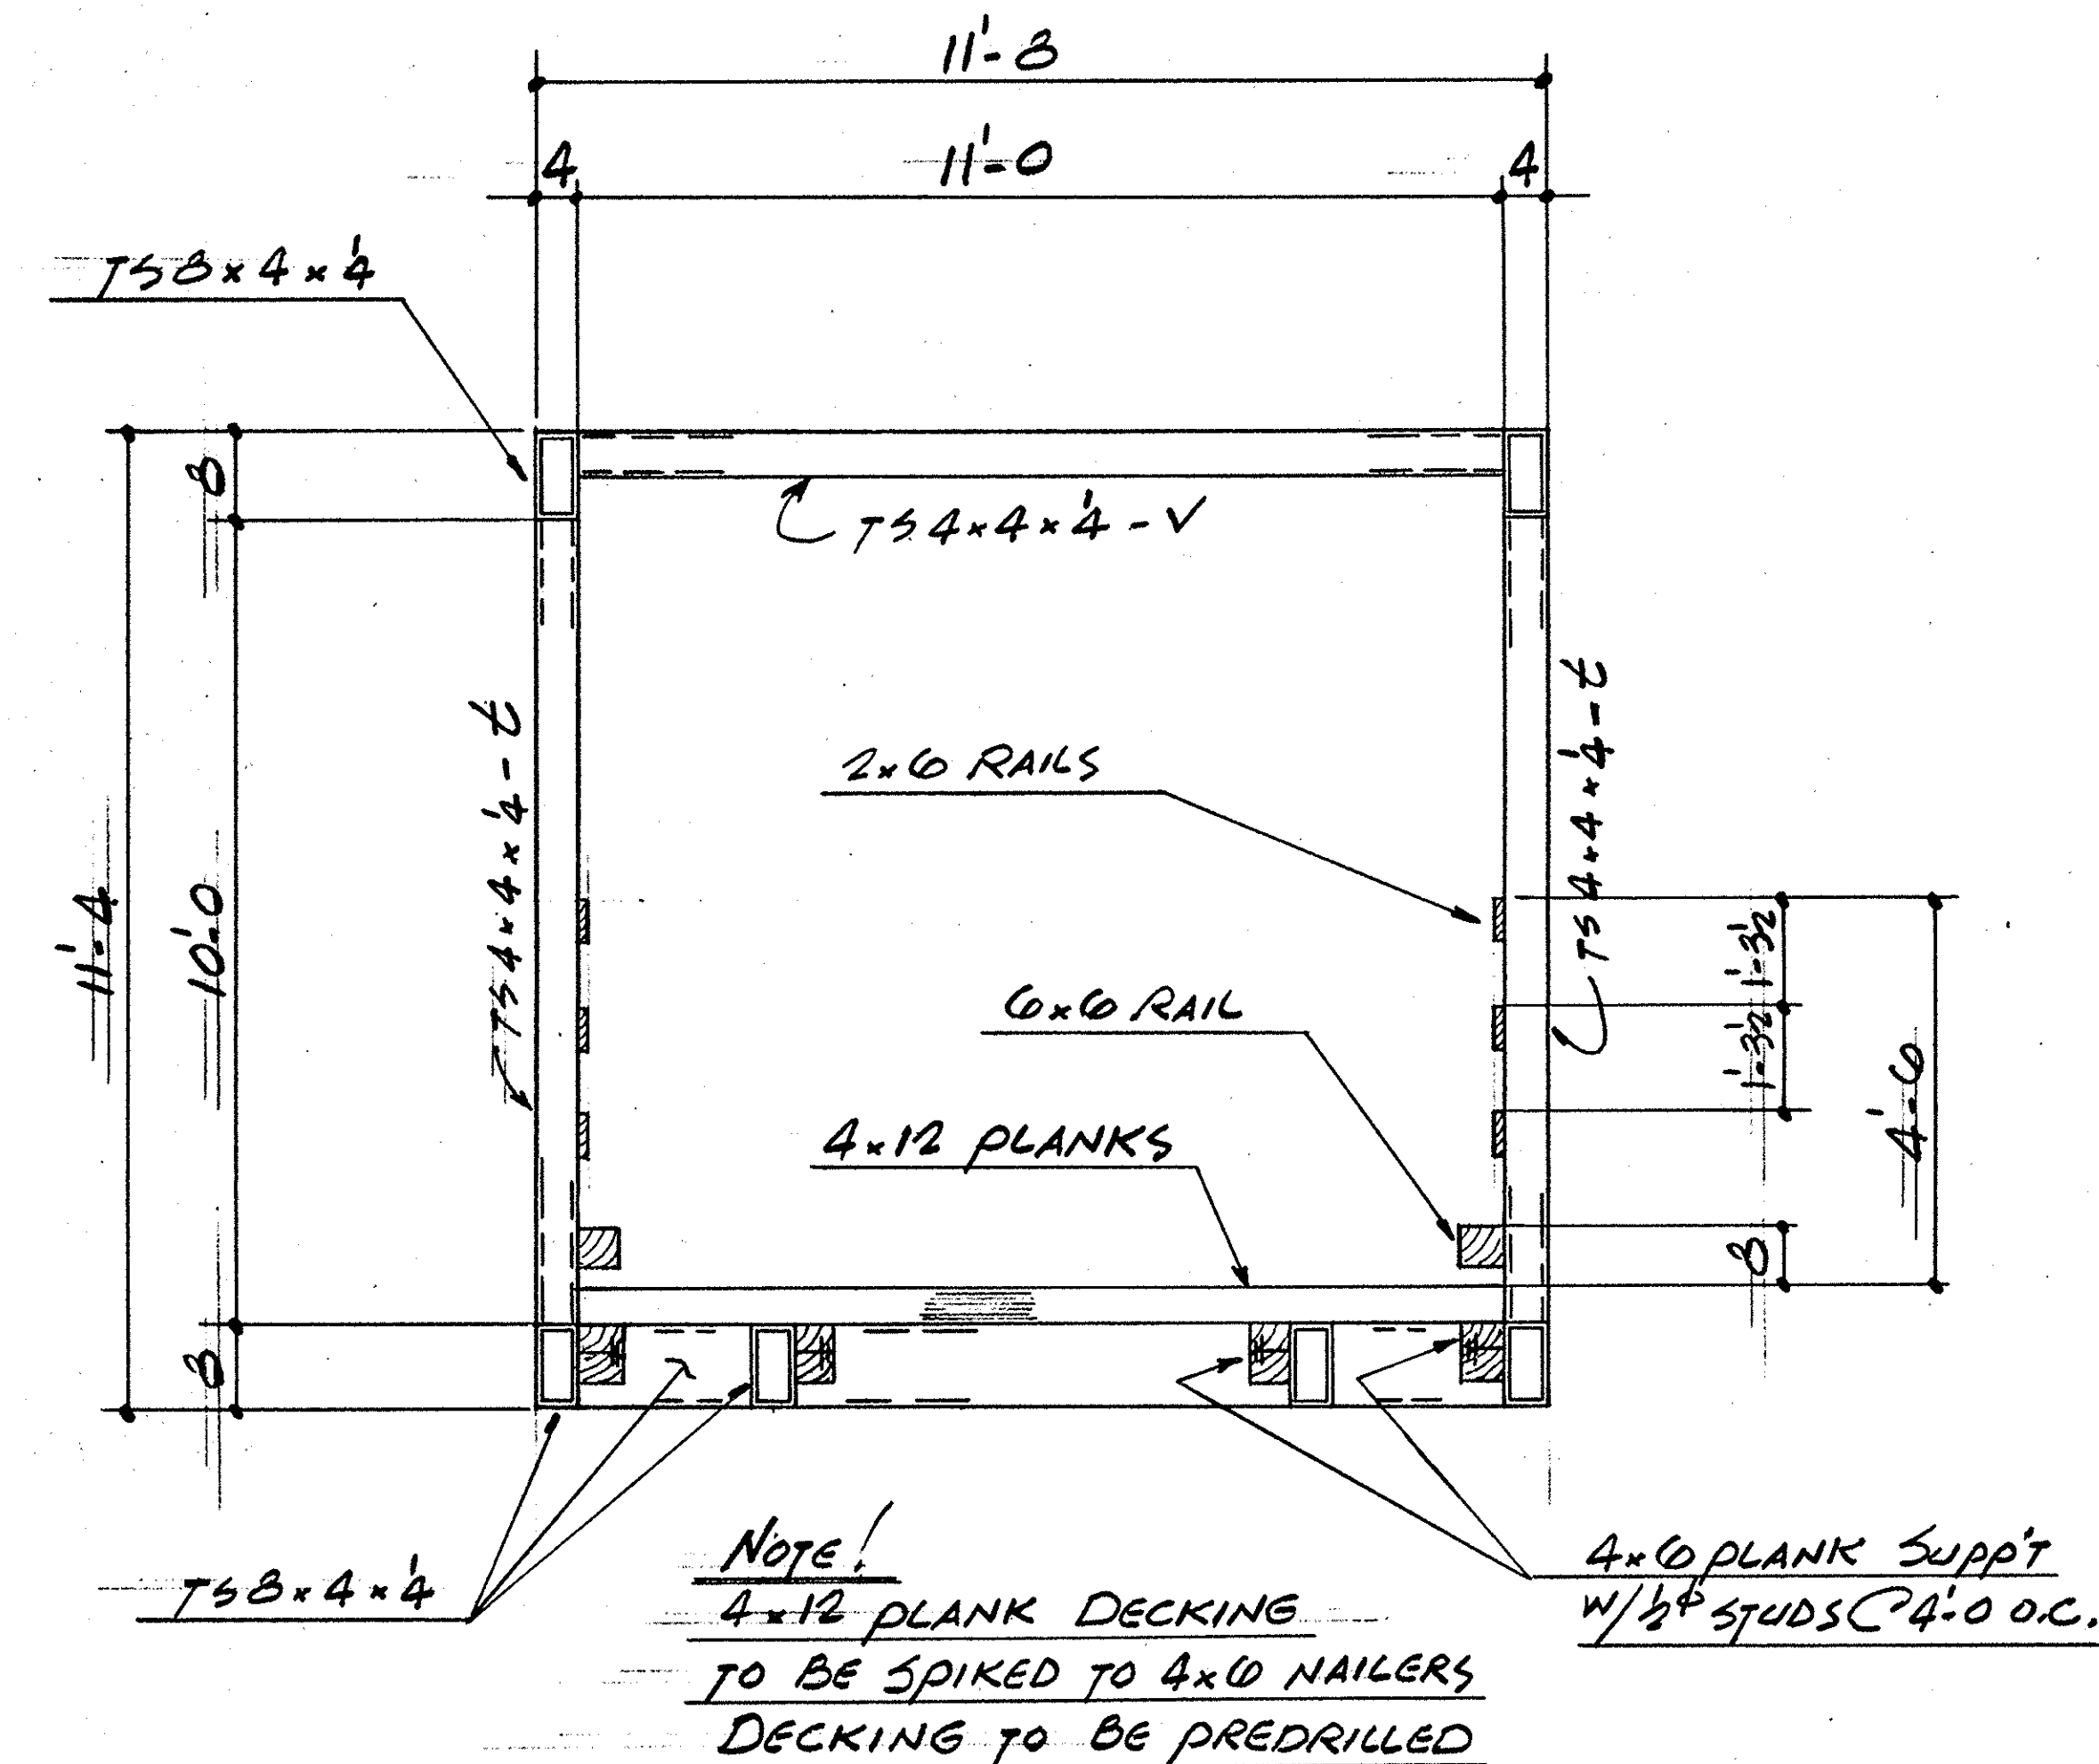

SECT. B-B THRU BRIDGE

WORK THIS DWG. WITH DWG. NOS 5, 6 & 8

SCALE: DRAWN BY: <u>DL</u> DATE: <u>9/92</u> CHECKED BY: <u>LS</u> DATE: <u>9/92</u> APPR'D BY: _____ DATE: _____ NO. DATE DESCRIPTION REVISIONS THIS DWG AND ALL INFORMATION HEREON IS THE PROPERTY OF PLAS-TAL MFG. CO., INC. AND IS LENT TO THE BORROWER FOR HIS CONFIDENTIAL USE ONLY. ALL RIGHTS OF DESIGN & DETAILS ARE RESERVED.		PMC PLAS-TAL MFG. CO., INC. 8815 SO. SORESENSEN AVE. SANTA FE SPRINGS, CALIF. 213 • 685-6874 213 • 691-0517 SOUTH UNDERGROUND CONST. JOB DESCRIPTION <u>BIKE TRAIL BRIDGE</u> LOCATION <u>SANTA ANA RIVER</u> WORK ORDER NO. <u>J-4602</u> DWG. NO. <u>7.</u>	
---	--	--	--

SAR Bike Trail Bridge 428'4" of Imperial Hwy 5/1992
SAR 12/17