



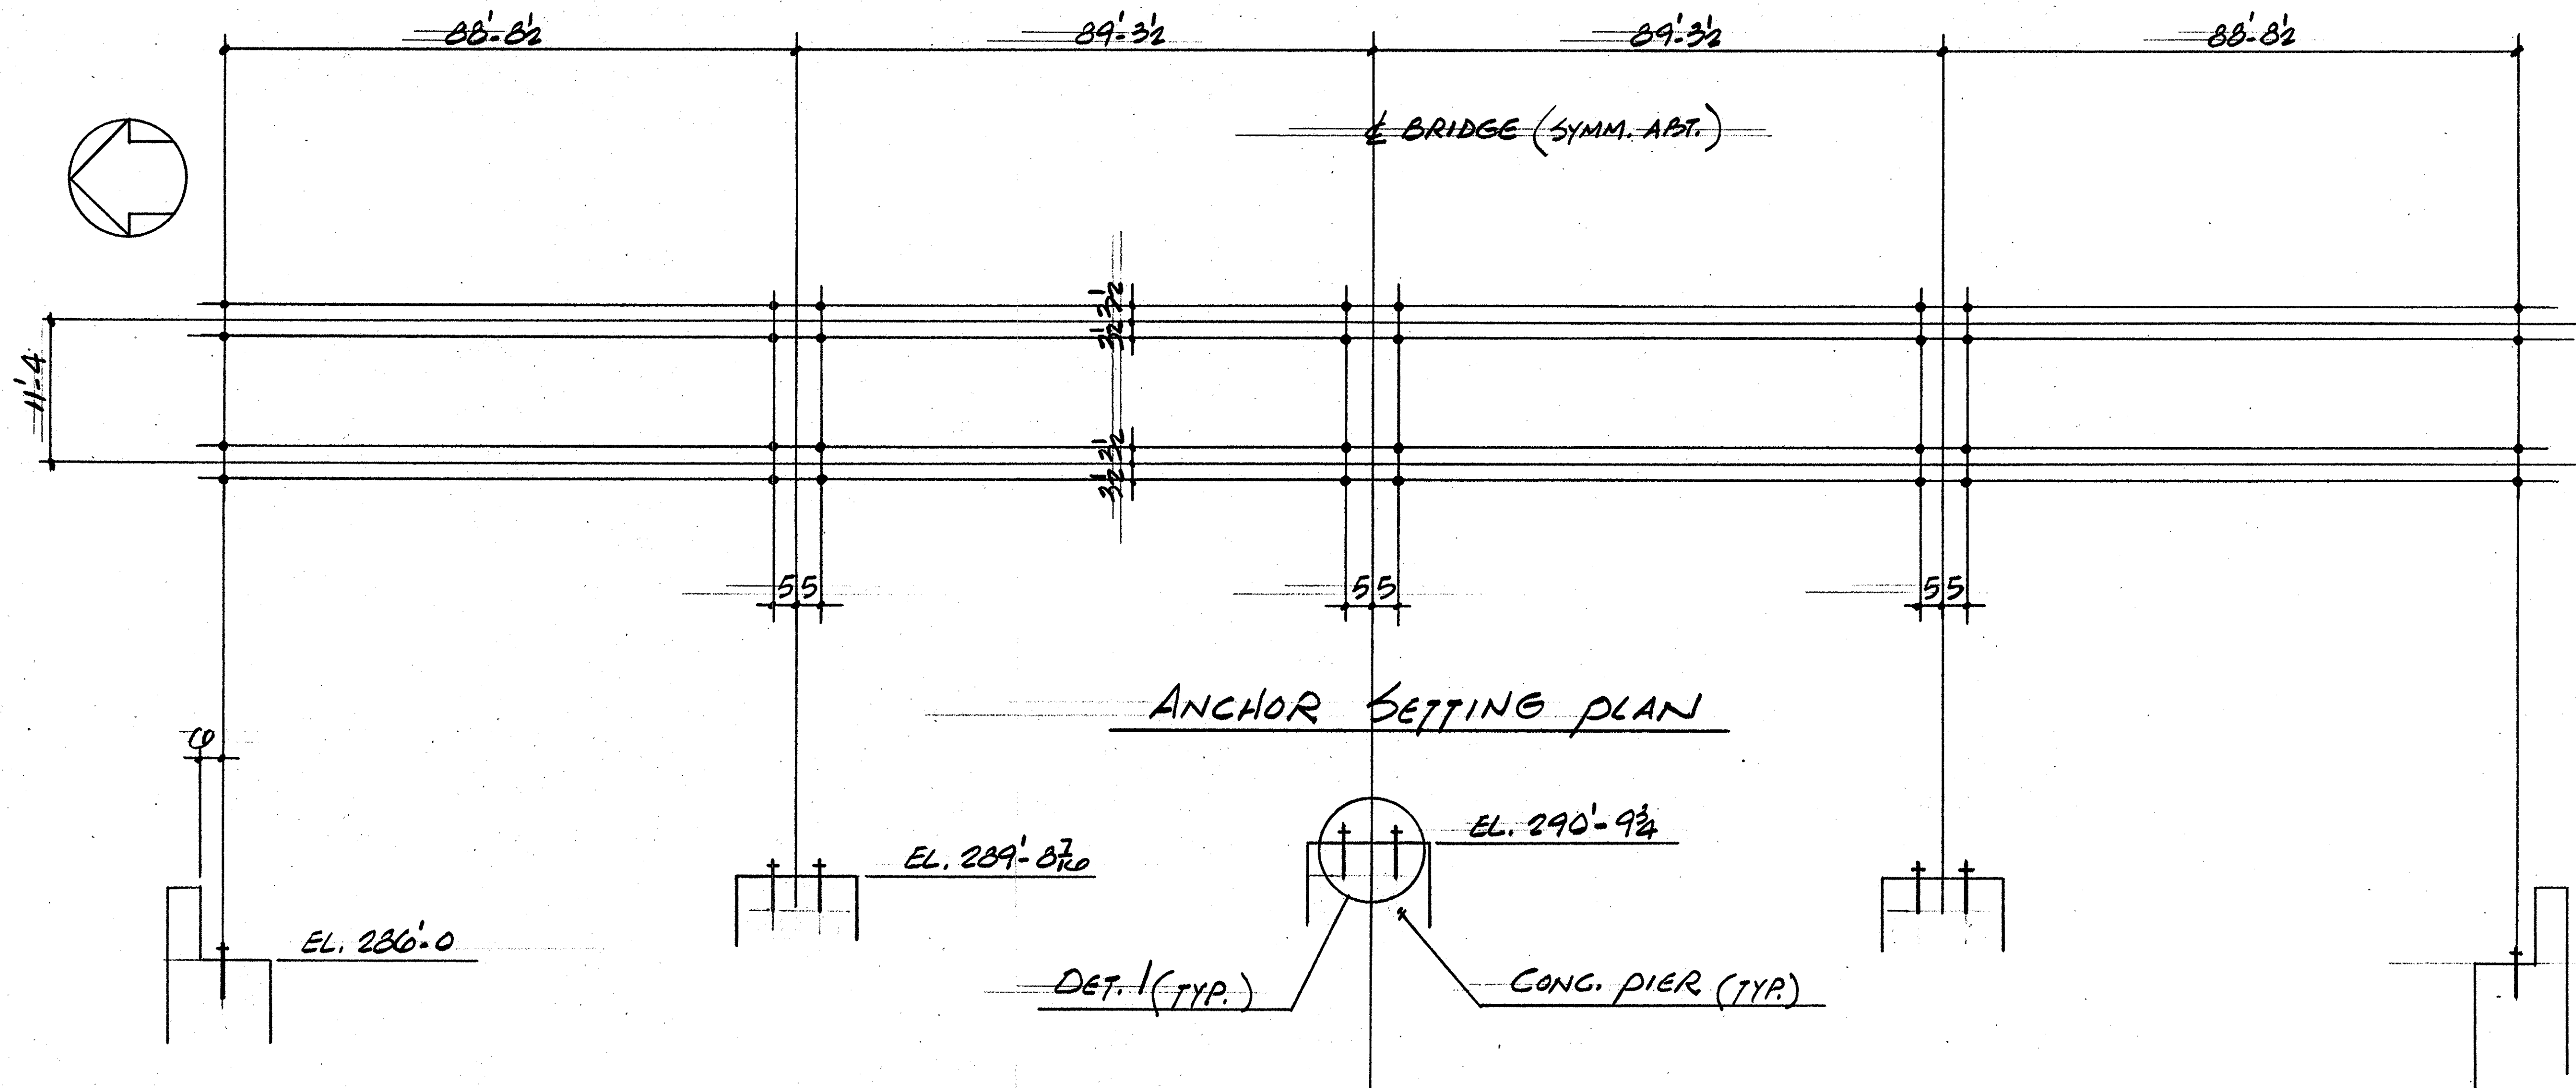

ANCHOR SETTING PLAN

ELEVATION

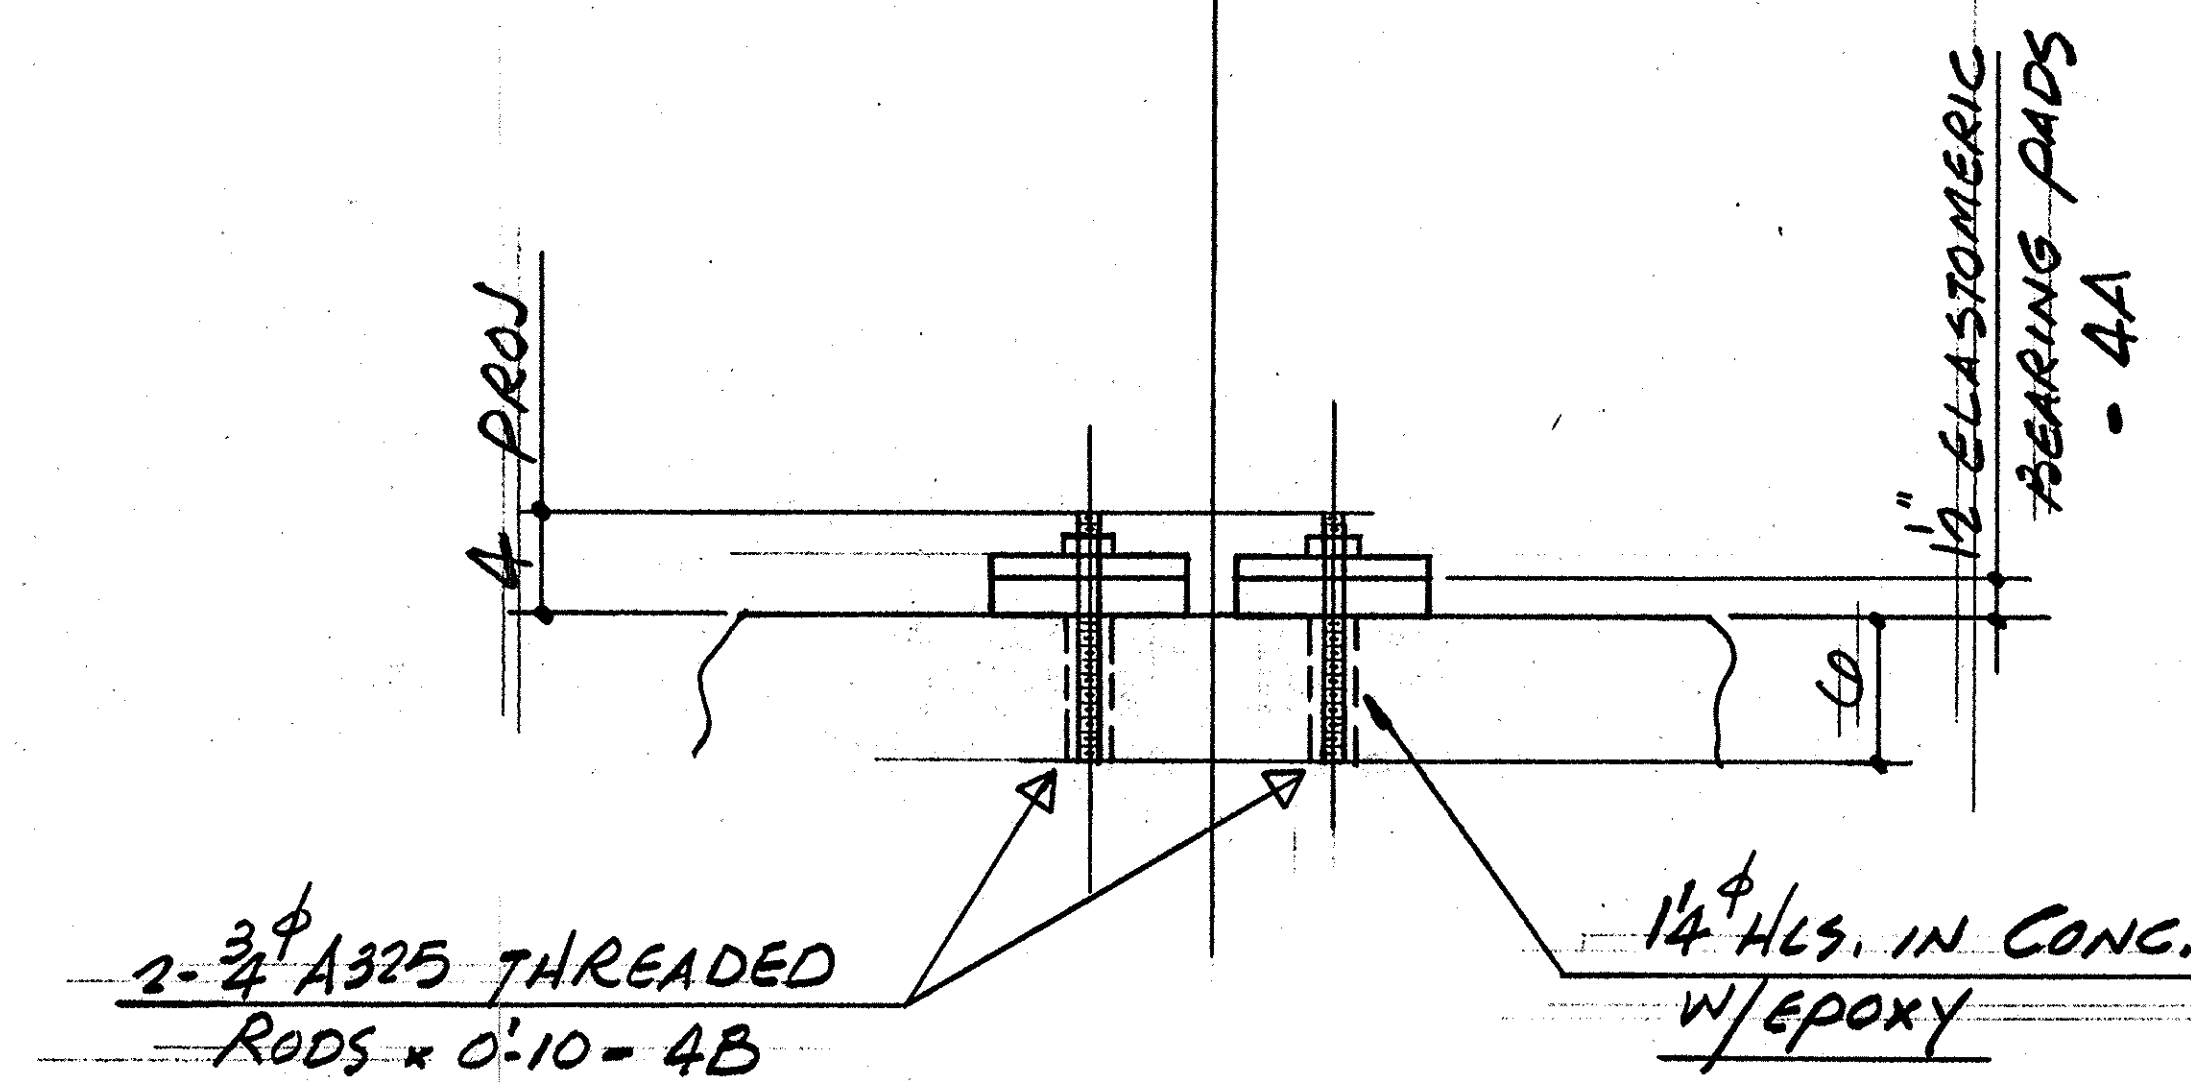

DETAIL 1

APPL	NO.	DATE	DESCRIPTION
SHOP			
FIELD			
PURCH			

NO.	DATE	DESCRIPTION

SCALE:		PLAS-TAL MFG. CO., INC. 8815 SO. SORENSON AVE. SANTA FE SPRINGS, CALIF. 213 • 685-6874 213 • 691-0517	
DRAWN BY:	DATE:	CUSTOMER:	REV.
9/92	9/92	SOUTH UNDERGROUND CONST.	
CHECKED BY:	DATE:	JOB DESCRIPTION:	
9/92	9/92	BIKE TRAIL BRIDGE	
APPROD BY:	DATE:	LOCATION:	
		SANTA ANA RIVER	
CUST. P.O. NO.		WORK ORDER NO.	DWG. NO.
		J-4002	E1

SAR BIKE TRAIL BR., 428' U/S OF IMPERIAL HWY 5/92