


TYPICAL BRIDGE TRUSS TOP PLAN


SCALE: 1/4" = 1'-0"

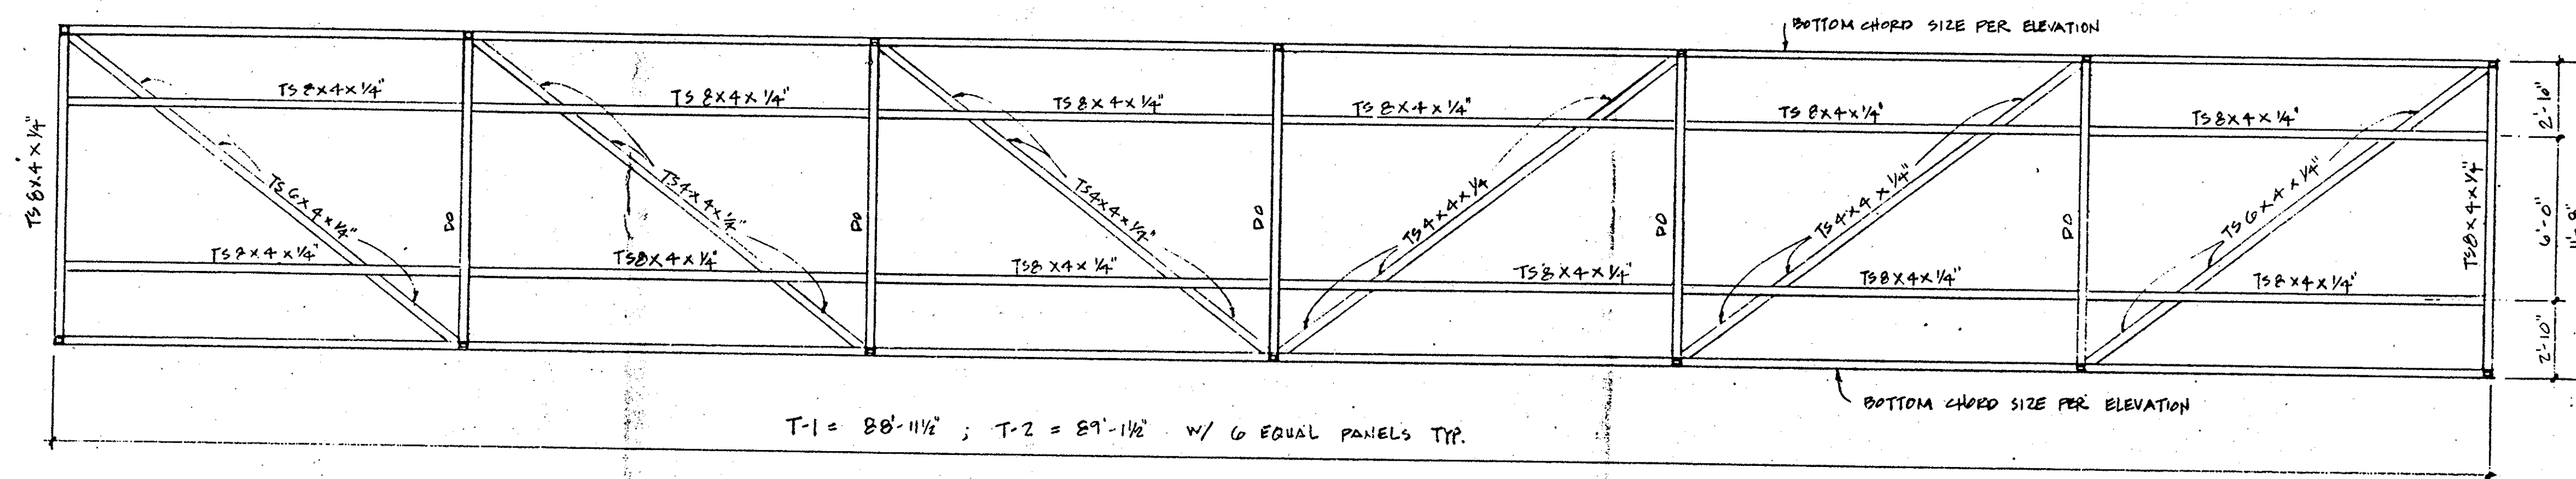

T-1 = 88'-11 1/2" ; T-2 = 89'-11 1/2" W/ 6 EQUAL PANELS TYP.


TYPICAL BRIDGE TRUSS FLOOR PLAN

SCALE: 1/4" = 1'-0"

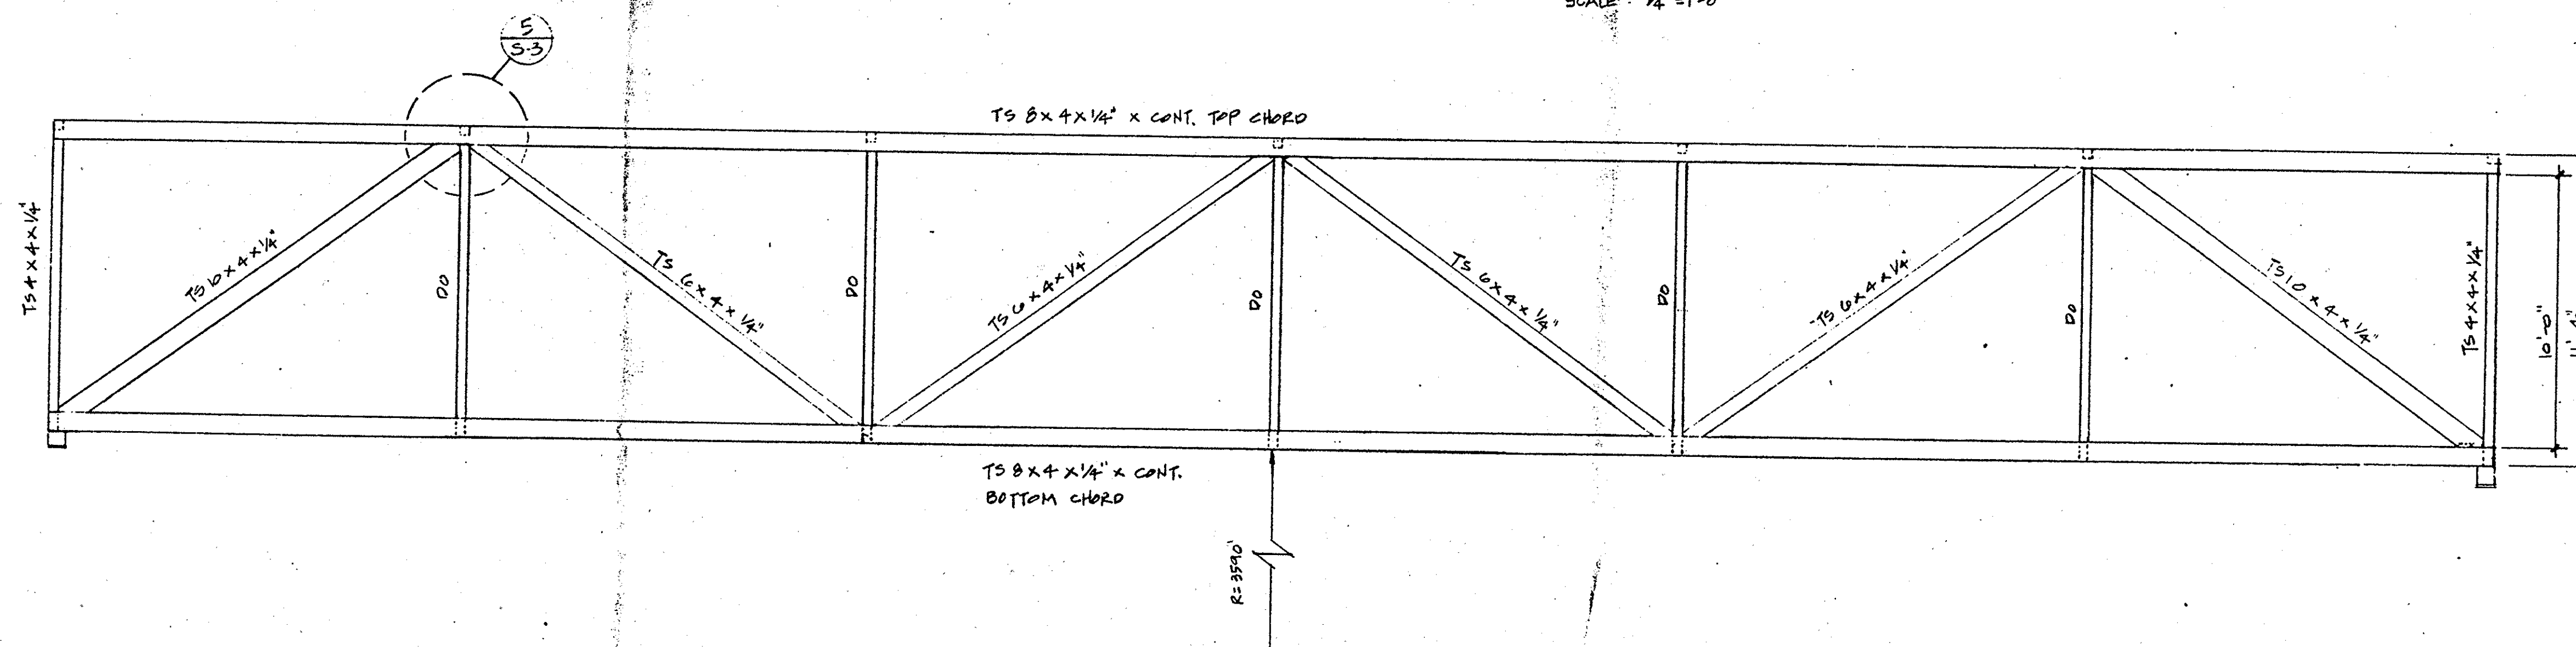

TYPICAL BRIDGE TRUSS ELEVATION

SCALE: 1/4" = 1'-0"

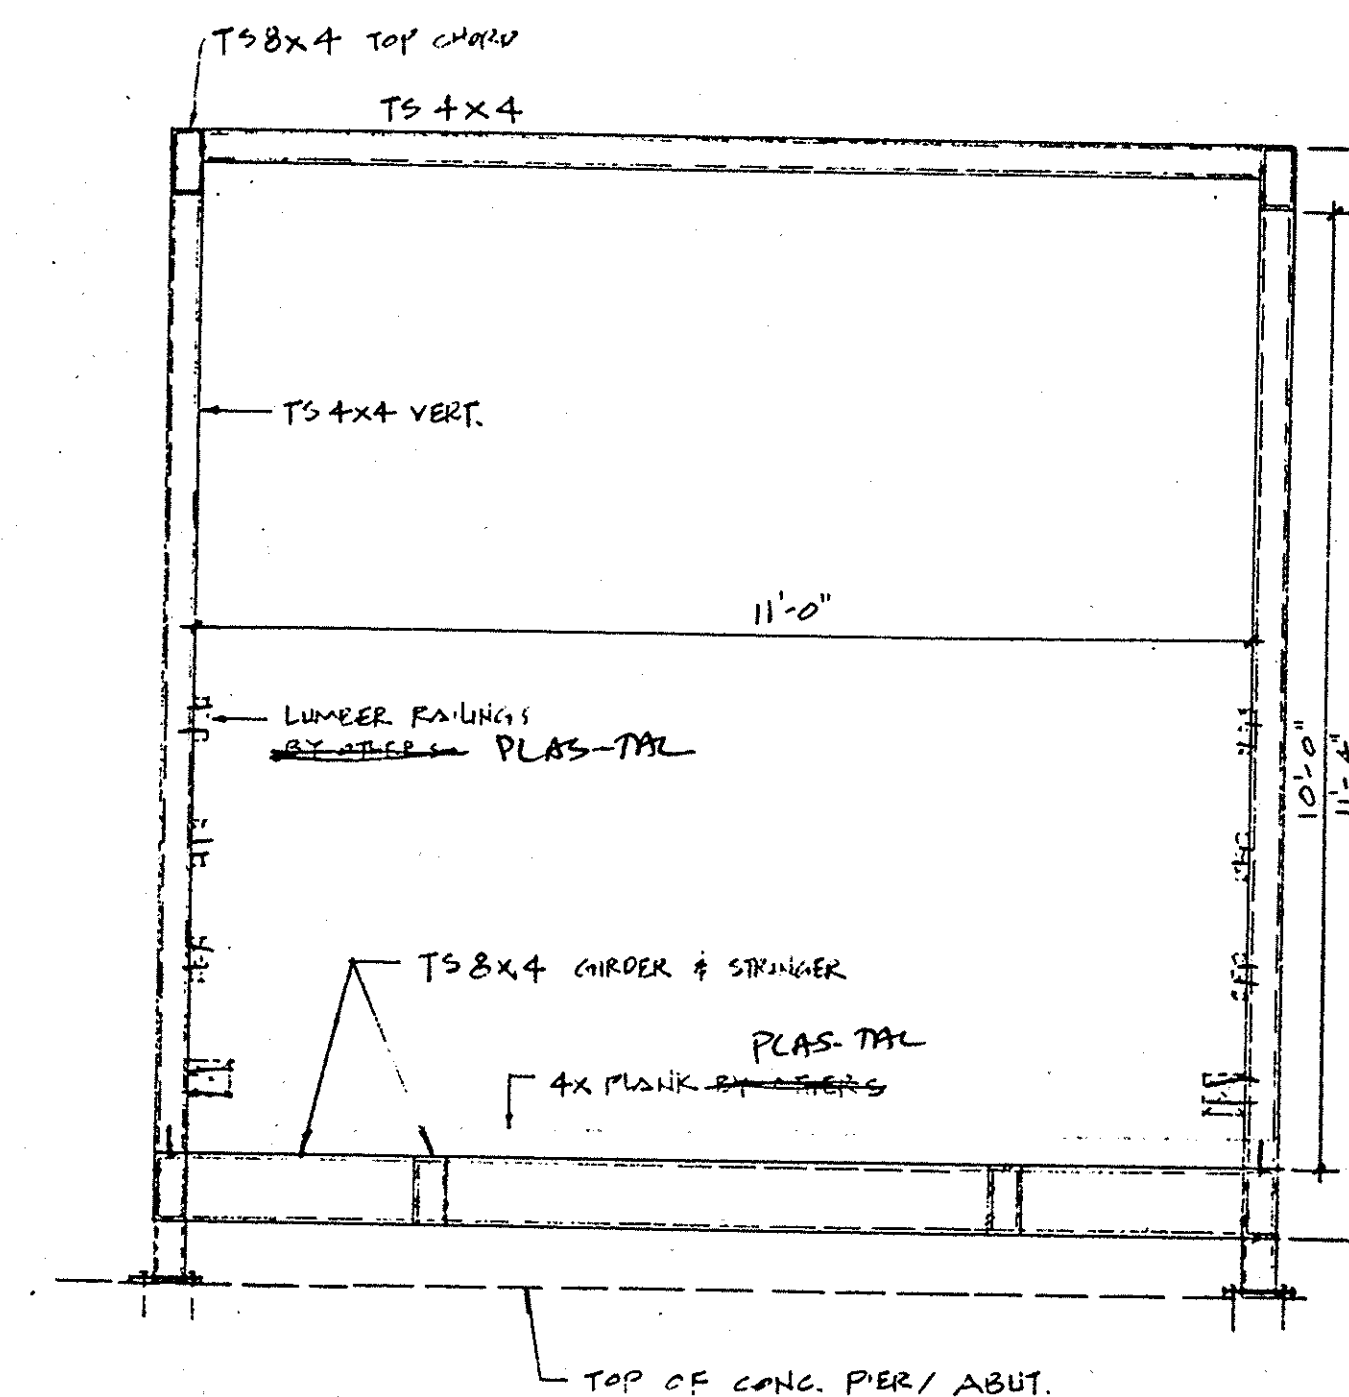

TYPICAL BRIDGE SECTION

PMC	PLAS-TAL MFG. CO., INC.	
	8815 SO. SORESENSEN AVE.	SANTA FE SPRINGS, CALIF.
	213 • 685-6874	213 • 691-0517
WORK ORDER NO.	DWG. NO.	REV.
J-4602	E3.	△

IMPERIAL HIGHWAY BIKE BRIDGE ACROSS SANTA ANA RIVER	
SIDNEY YUEN CONSULTING ENGINEER 1907 LERONA AVENUE ROWLAND HEIGHTS, CA 91748 (818) 912-0568	SHEET 5-2 S.A.R. BIKE TRAIL RR 425 U.S. OF IMPERIAL HWY 5192 SANT. 16