



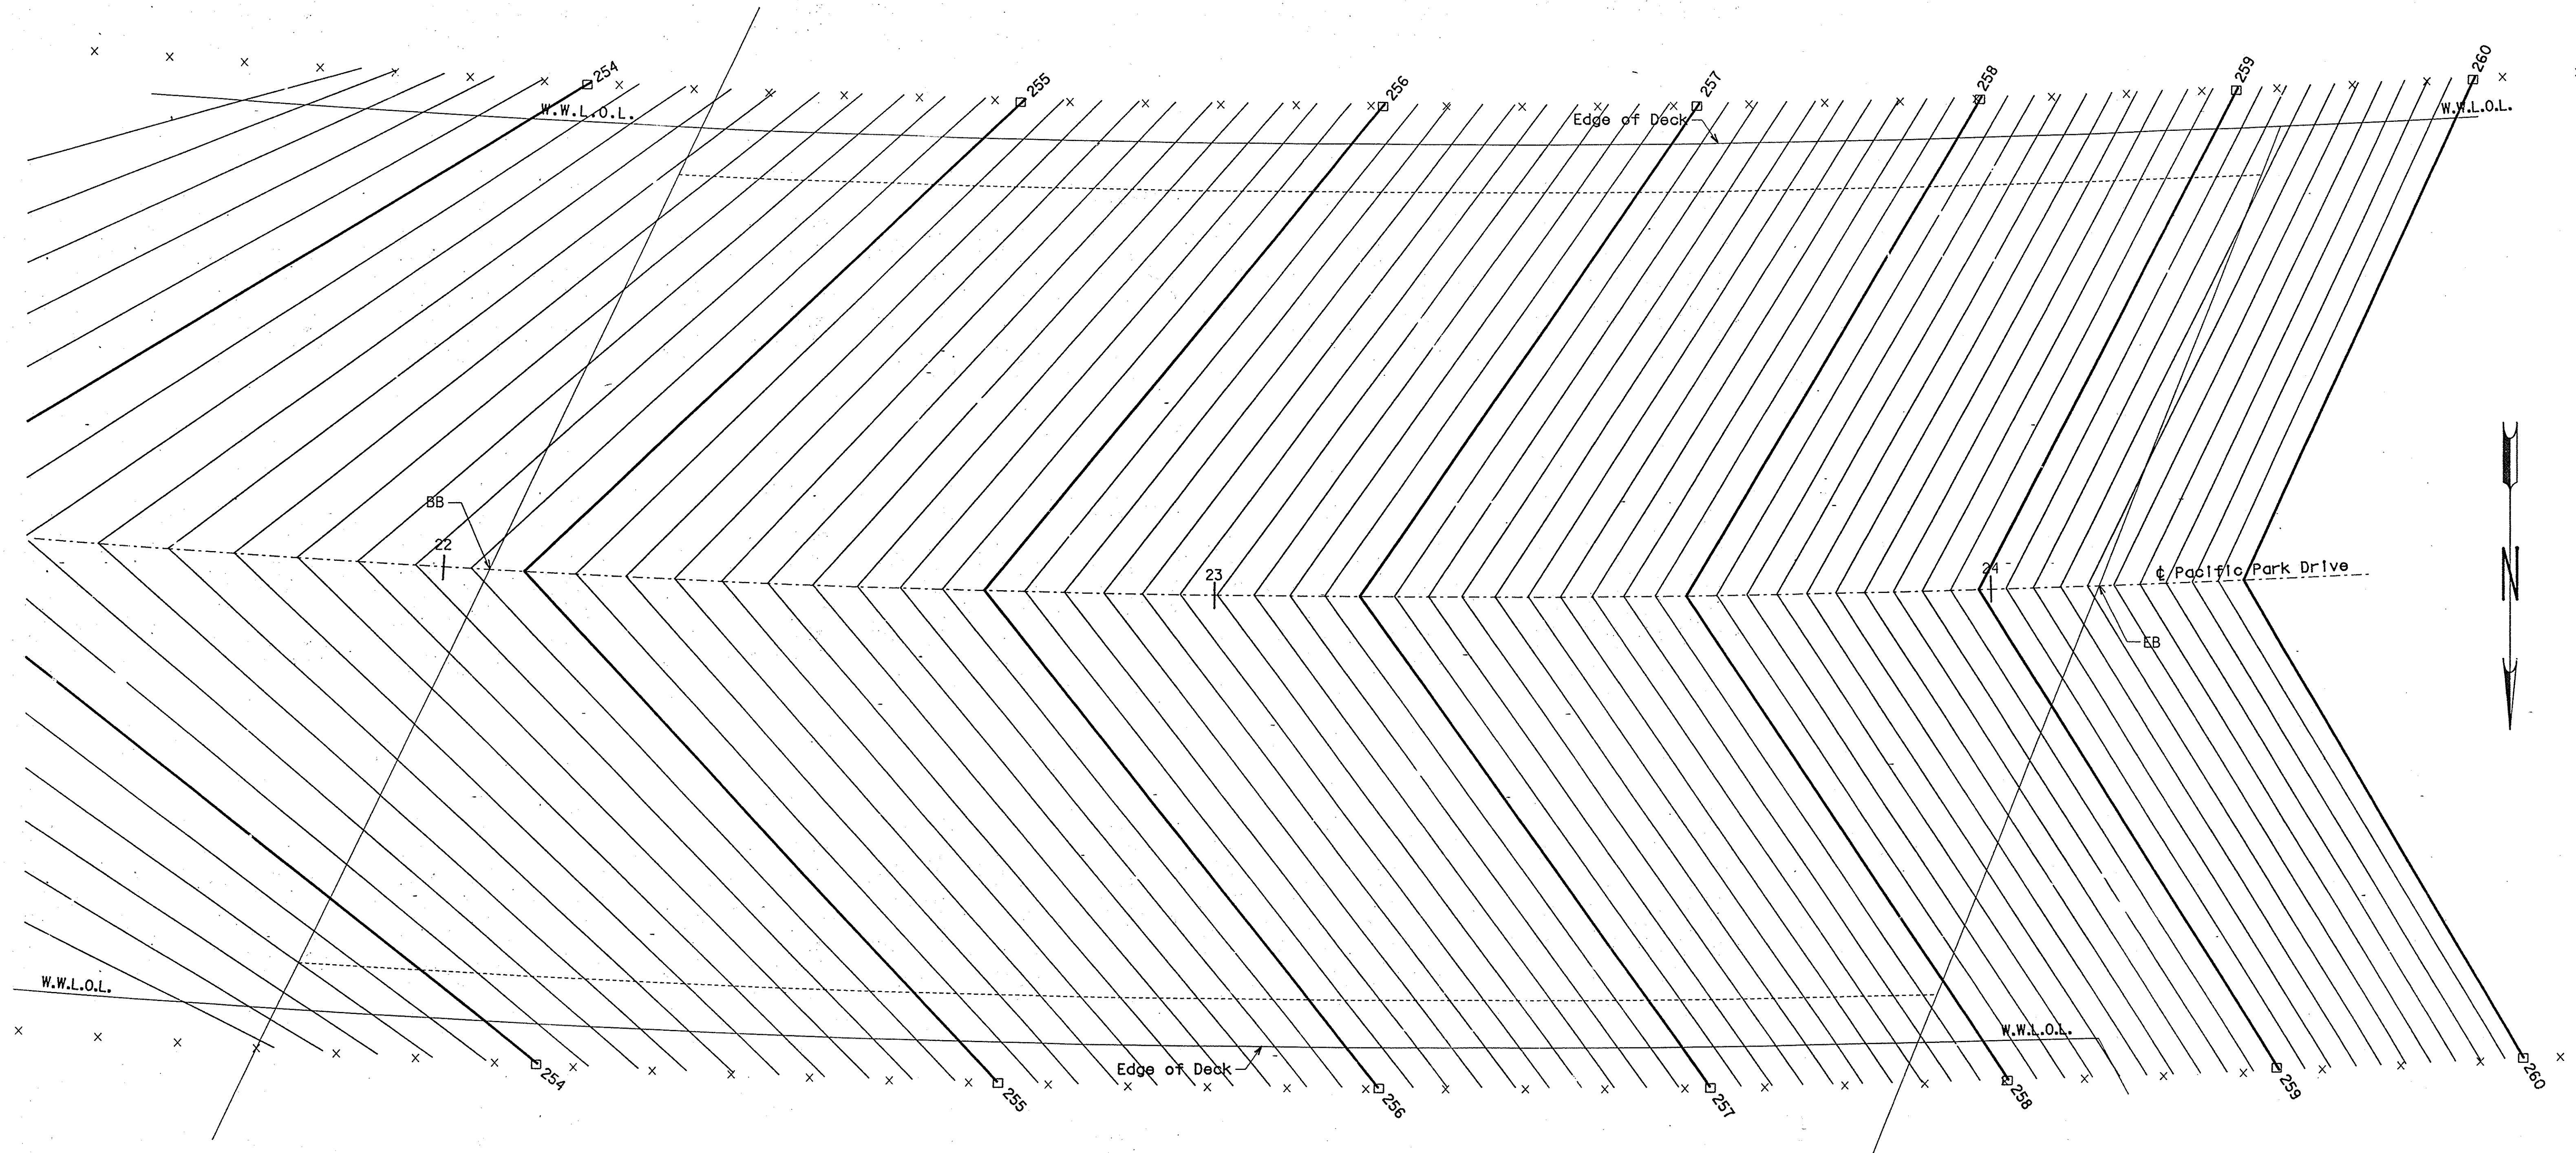

PLAN
1" = 10'-0"

NOTE:
 □ - Indicates even foot contours.
 x - 10' Intervals along "Pacific Park Drive" line.
 Contours do not include camber.
 Contours are for top of concrete deck.
 See Civil Plans for finish elevations.

LIBBY
STRUCTURAL
ENGINEERS
4452 GLACIER AVENUE
SAN DIEGO, CALIFORNIA 92120

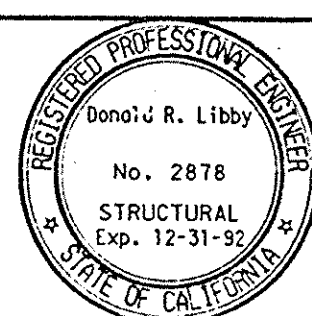

MISSION VIEJO COMPANY
26137 LA PAZ ROAD • MISSION VIEJO • CALIFORNIA 92691

DATE	BY	REVISION DESCRIPTION	APP'D	DATE	CHK	MC	DATE
11/92	NM	DECK CONTOURS SHEET REV'D			DES	BC	DWN NM

PACIFIC PARK DRIVE BRIDGE
OVER
BICYCLE AND EQUESTRIAN TRAILS, AND AWMA EASEMENT
1300 ft. WEST OF ALICIA PARKWAY
DECK CONTOURS

SHEET
3
OF 10
2721

DR3 15719