



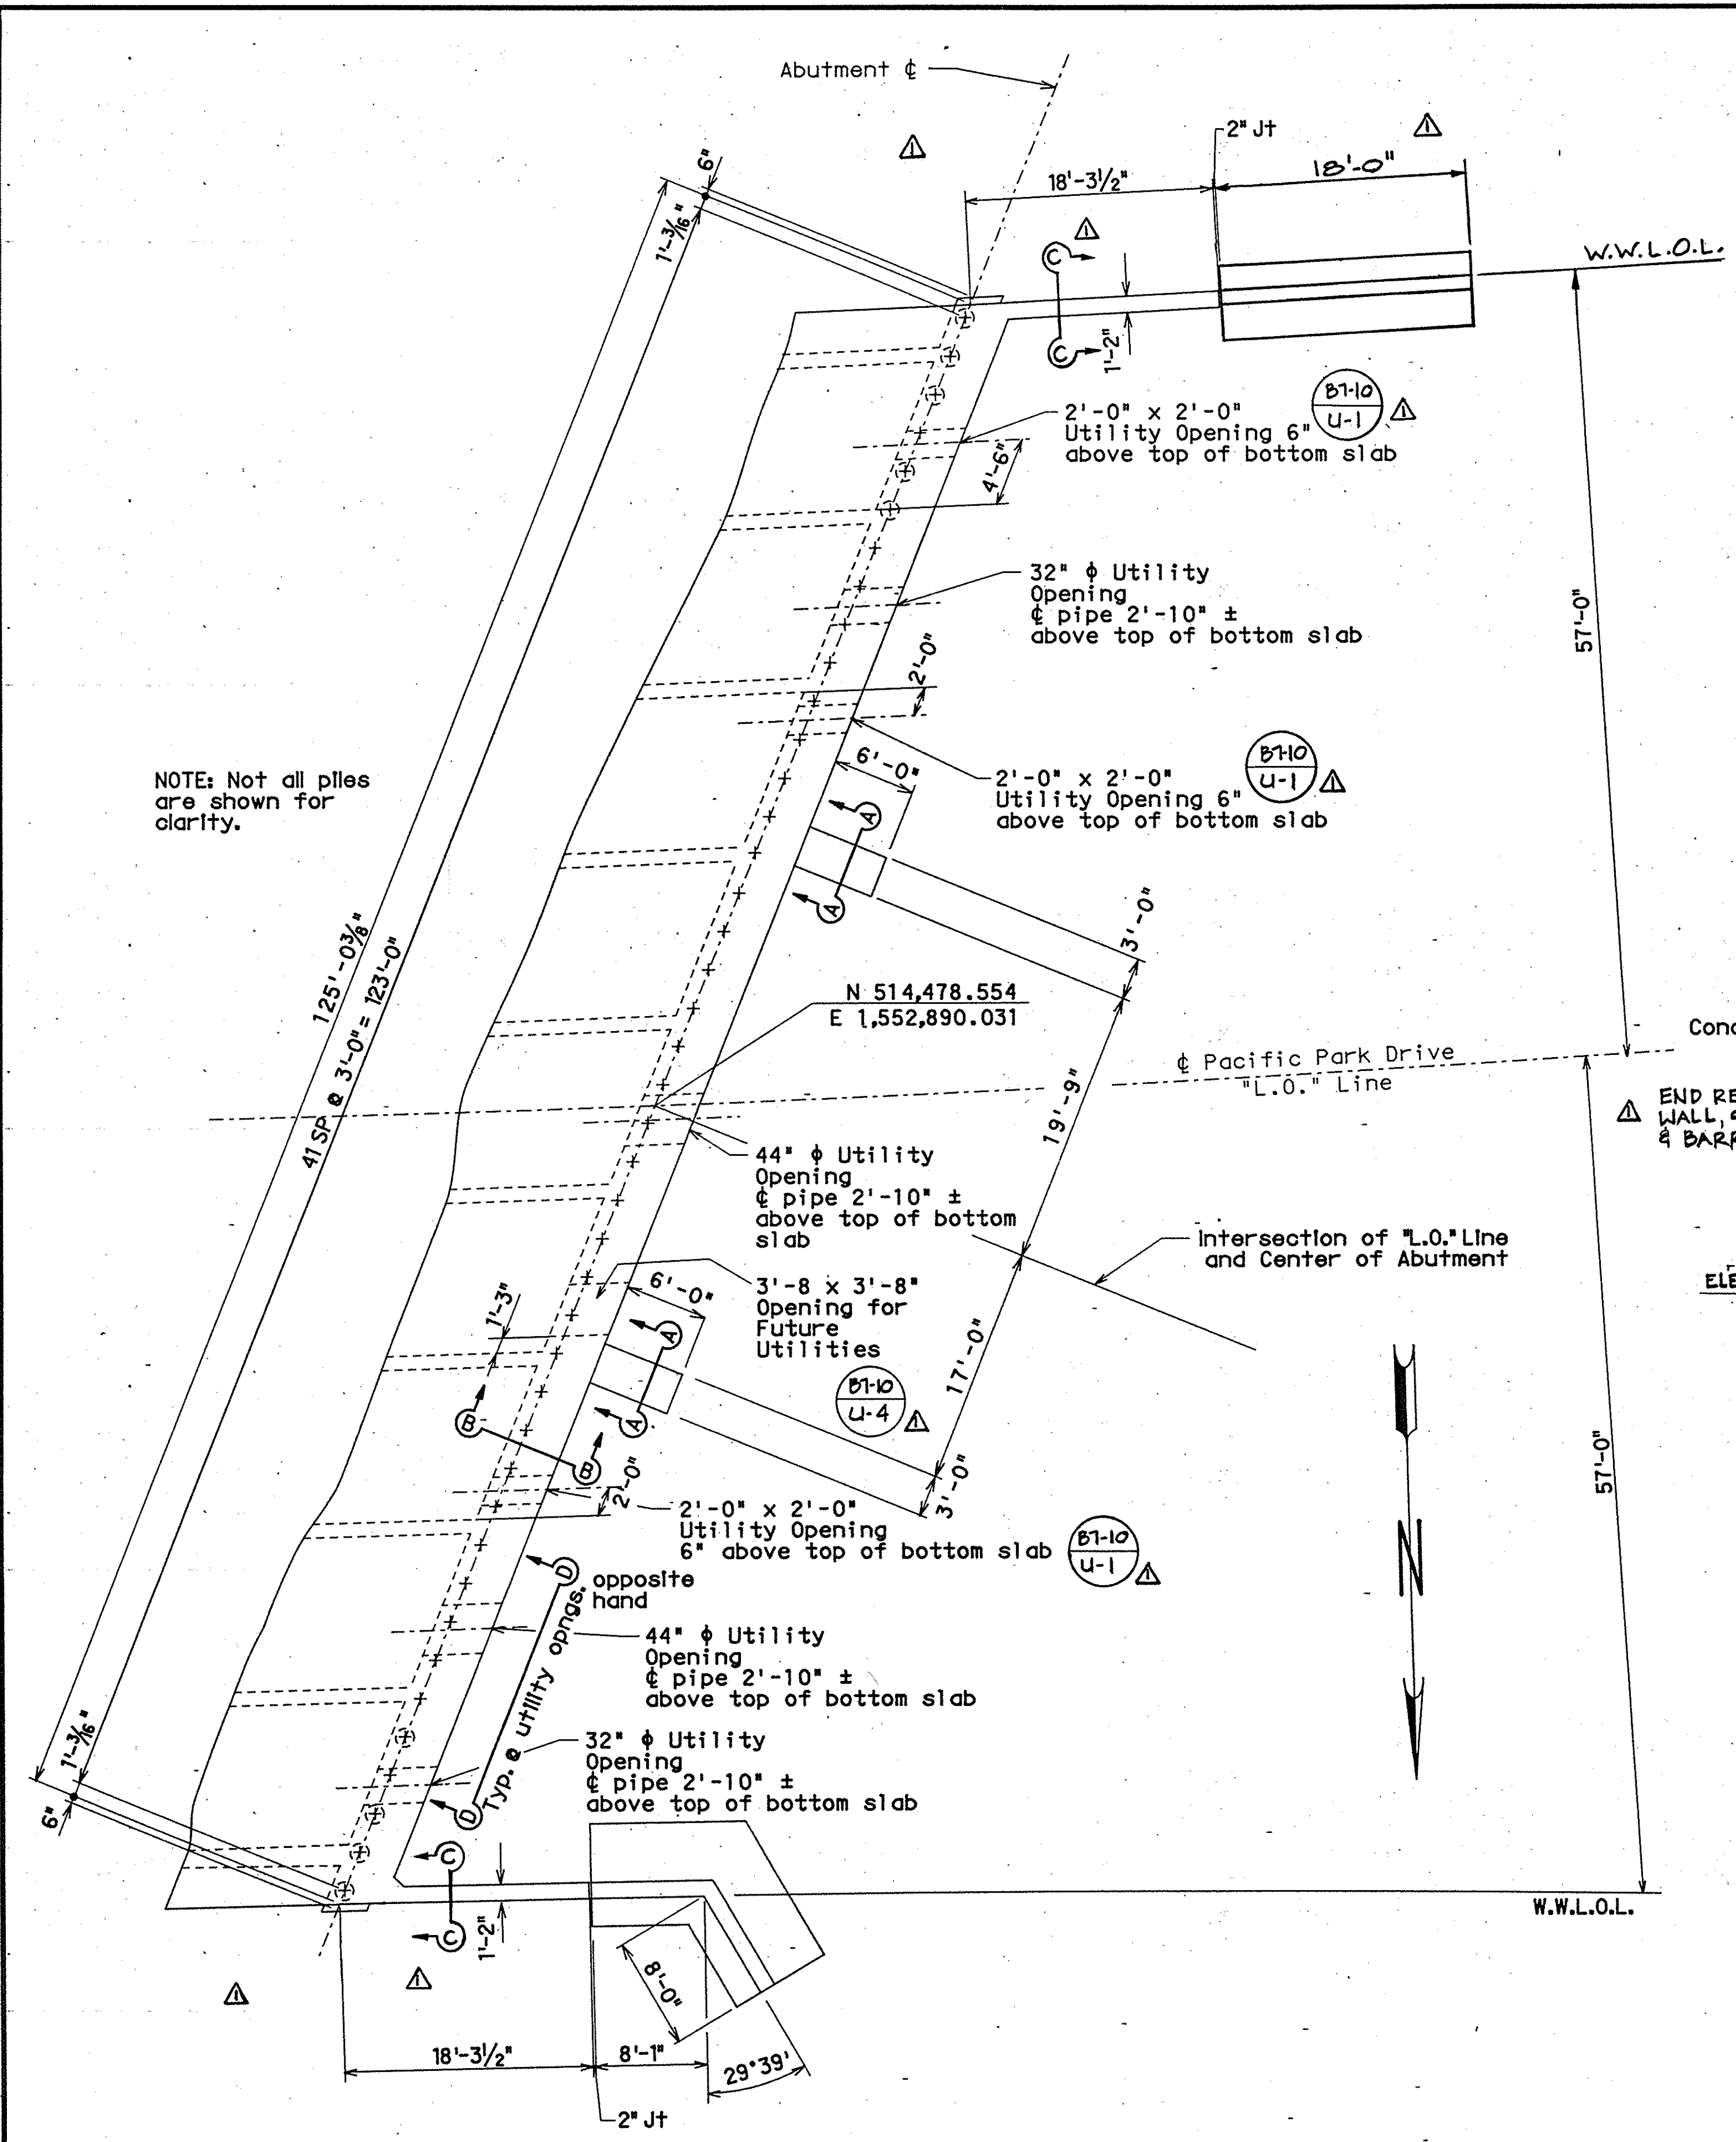


PLAN
1/8" = 1'-0"


- NOTES:
- For Sect A-A and B-B see ABUTMENT 1 DETAILS sheet.
 - For Utility Locations not noted, see GIRDER LAYOUT AND UTILITY PLAN sheet.
 - For TYPICAL CORNER DETAIL FOR SKEW OVER 20° see ABUTMENT 1 DETAILS sheet.

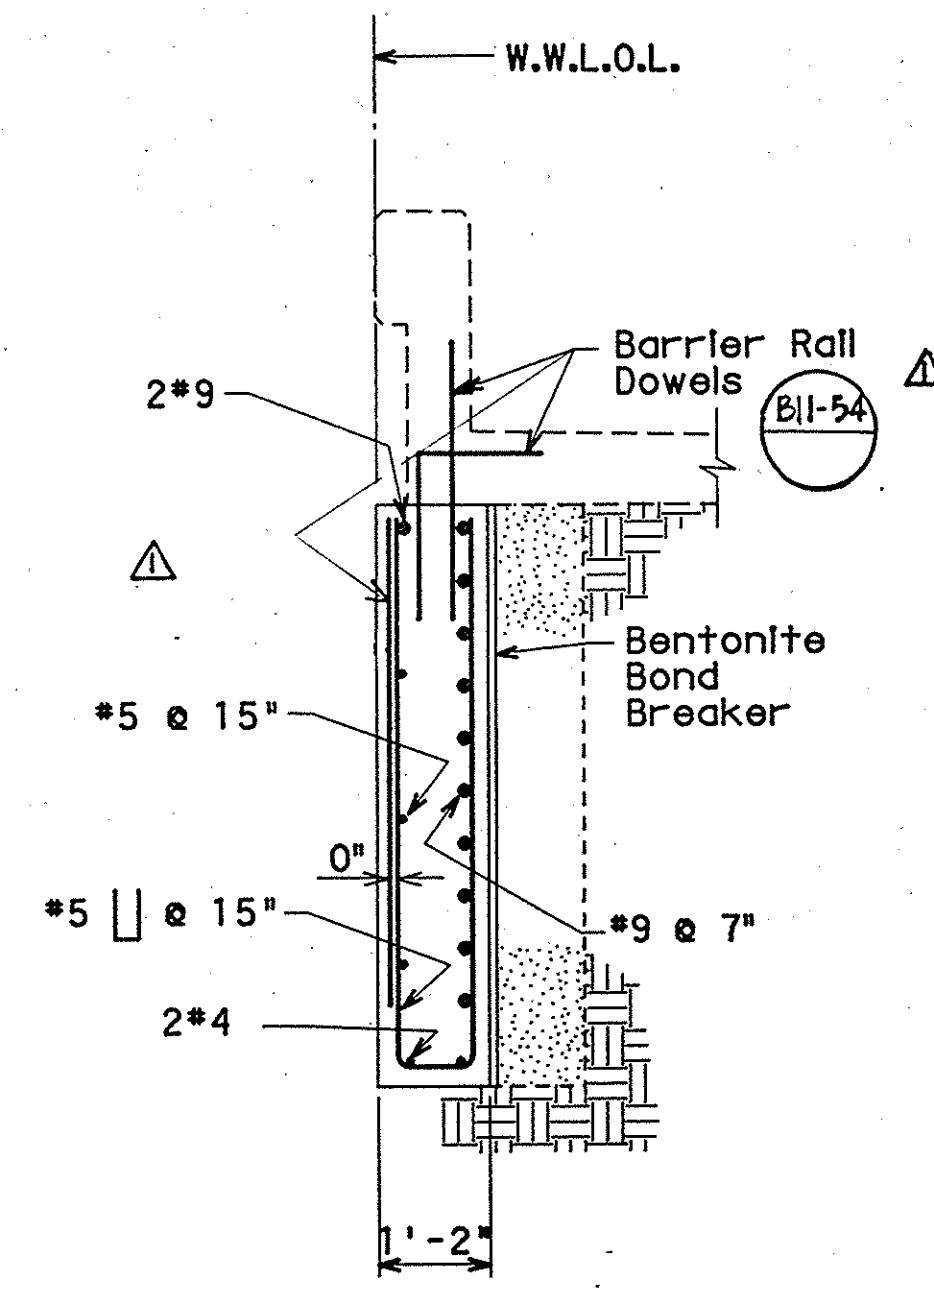


SECTION C-C
1/2" = 1'-0"

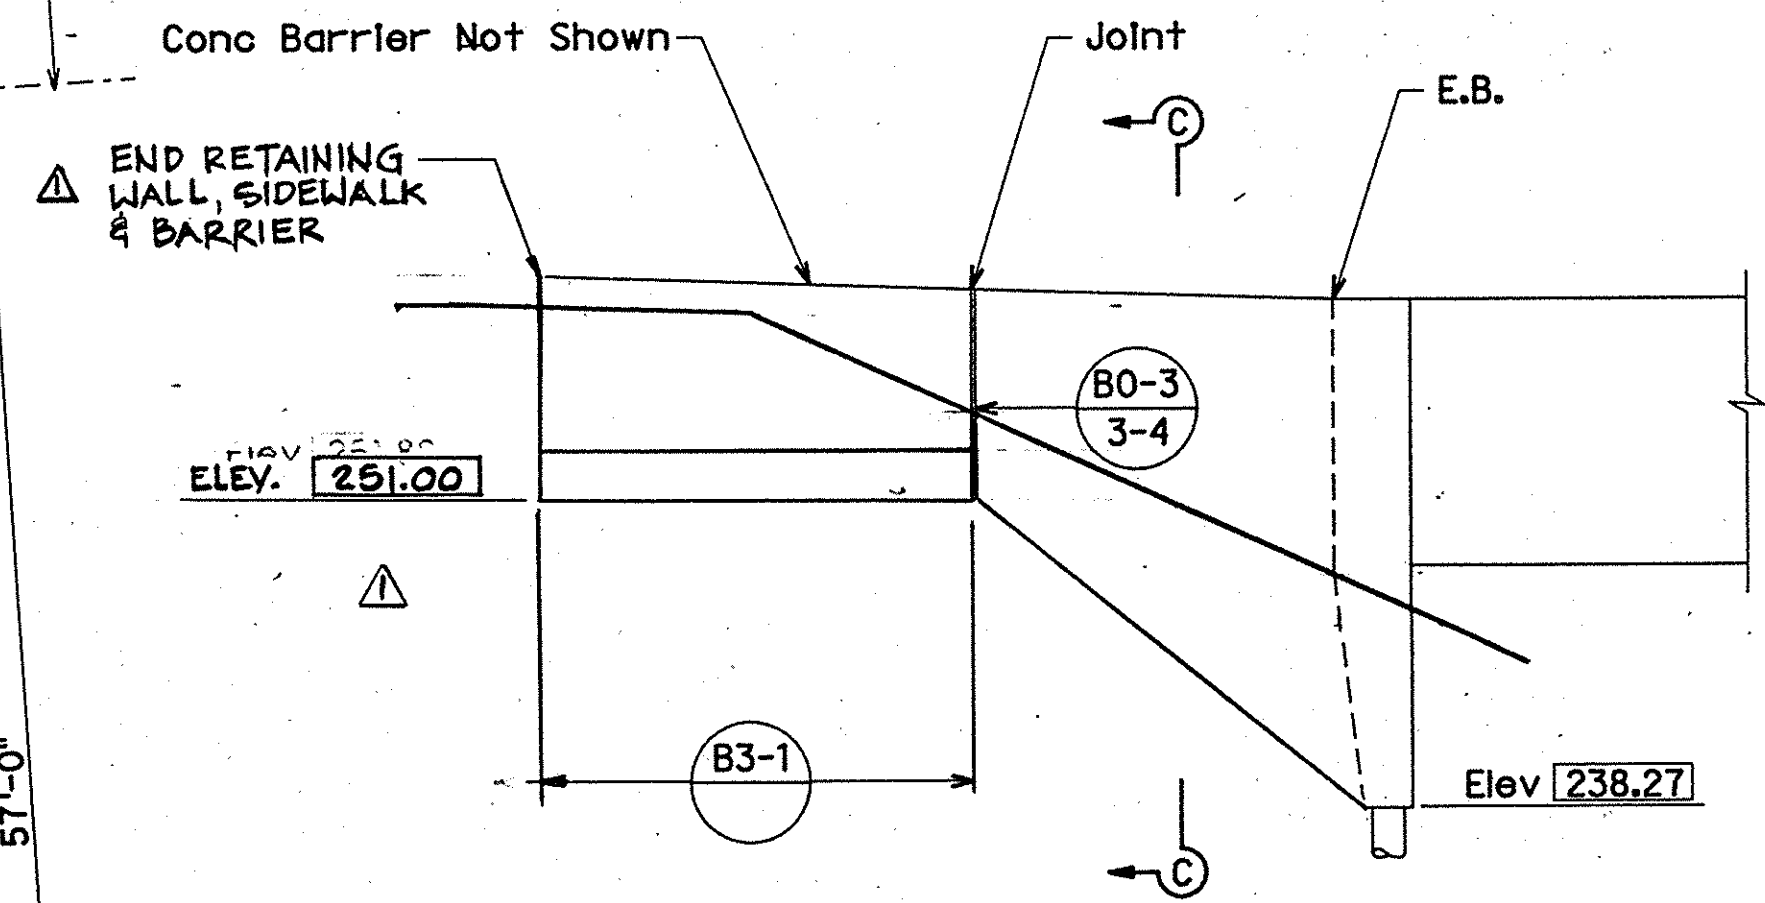


WEST ABUTMENT - SOUTH W.W.
1/8" = 1'-0"

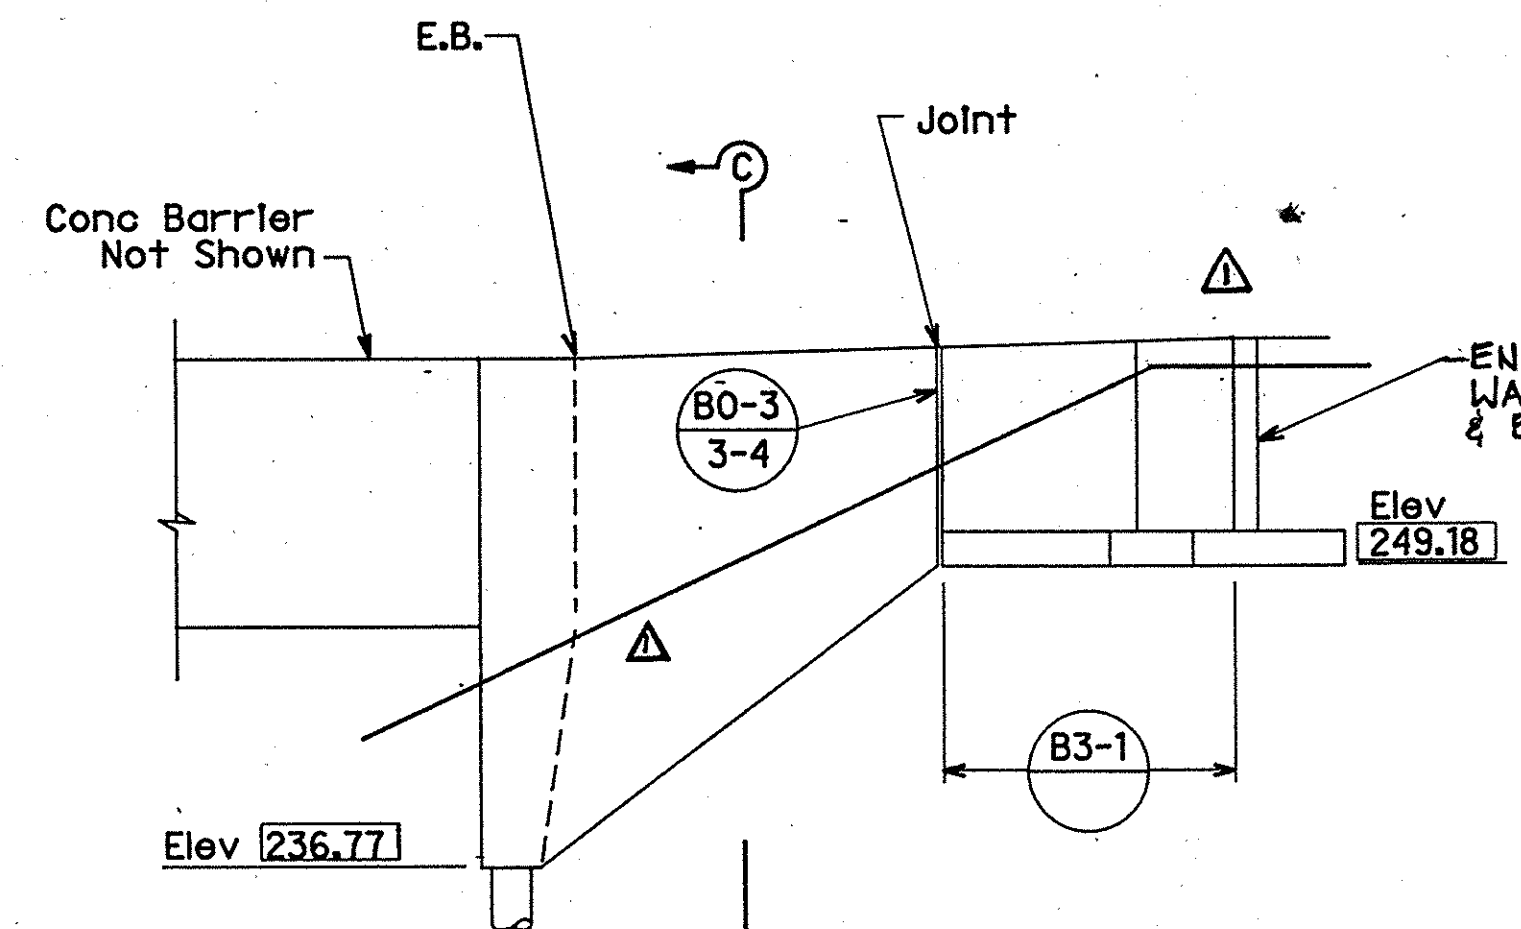


WEST ABUTMENT - NORTH W.W.
1/8" = 1'-0"

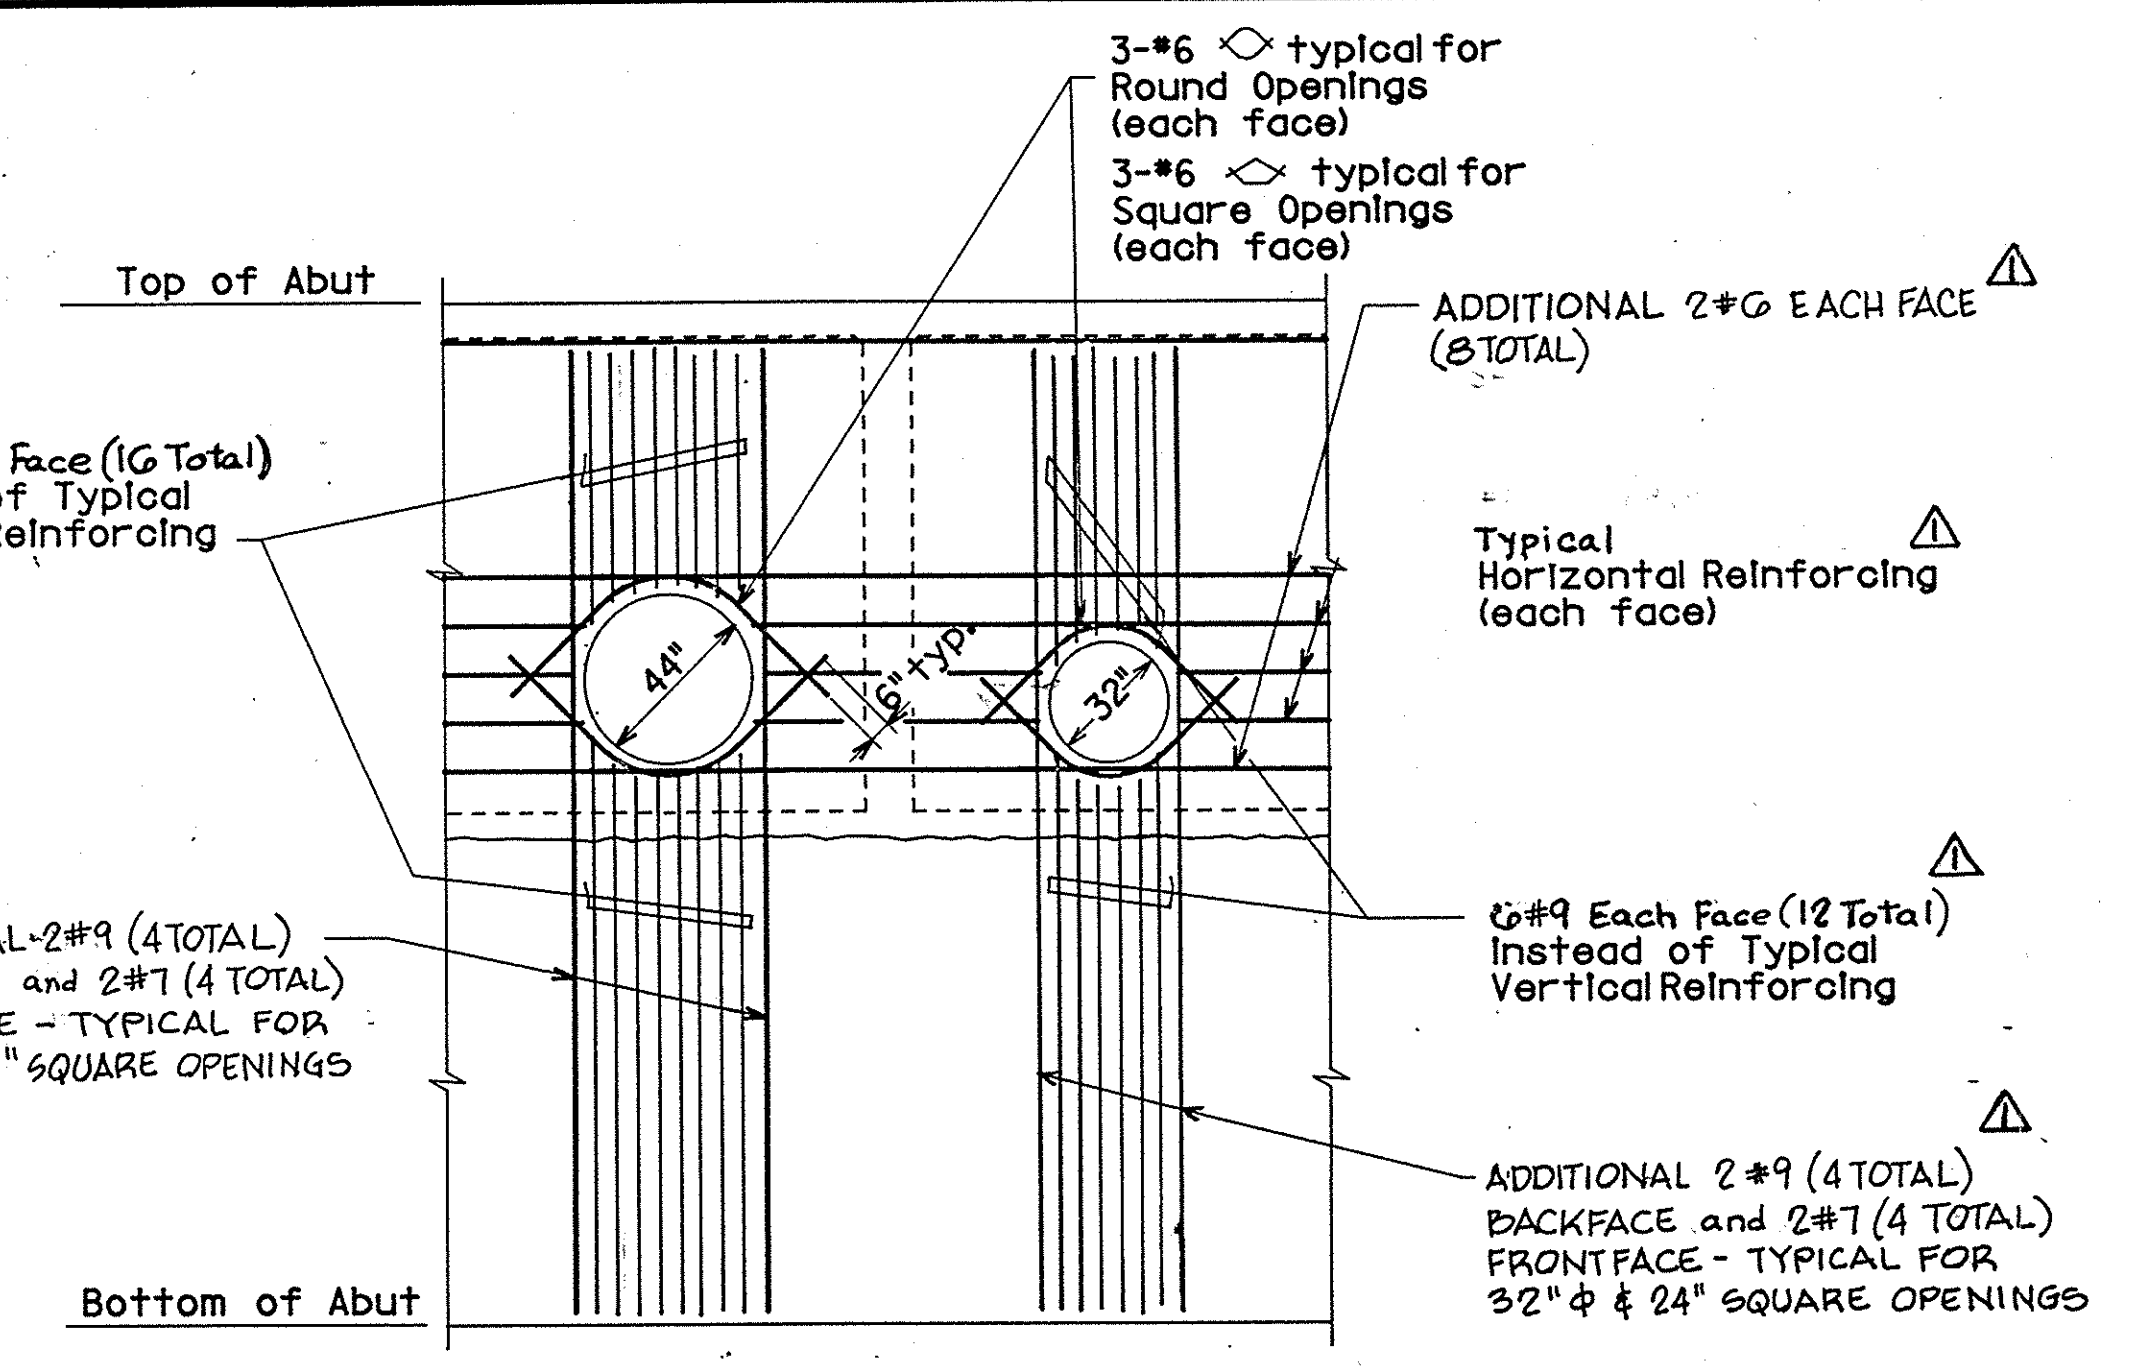


PARTIAL ELEVATION D-D
TYPICAL UTILITY OPENING
1/4" = 1'-0"

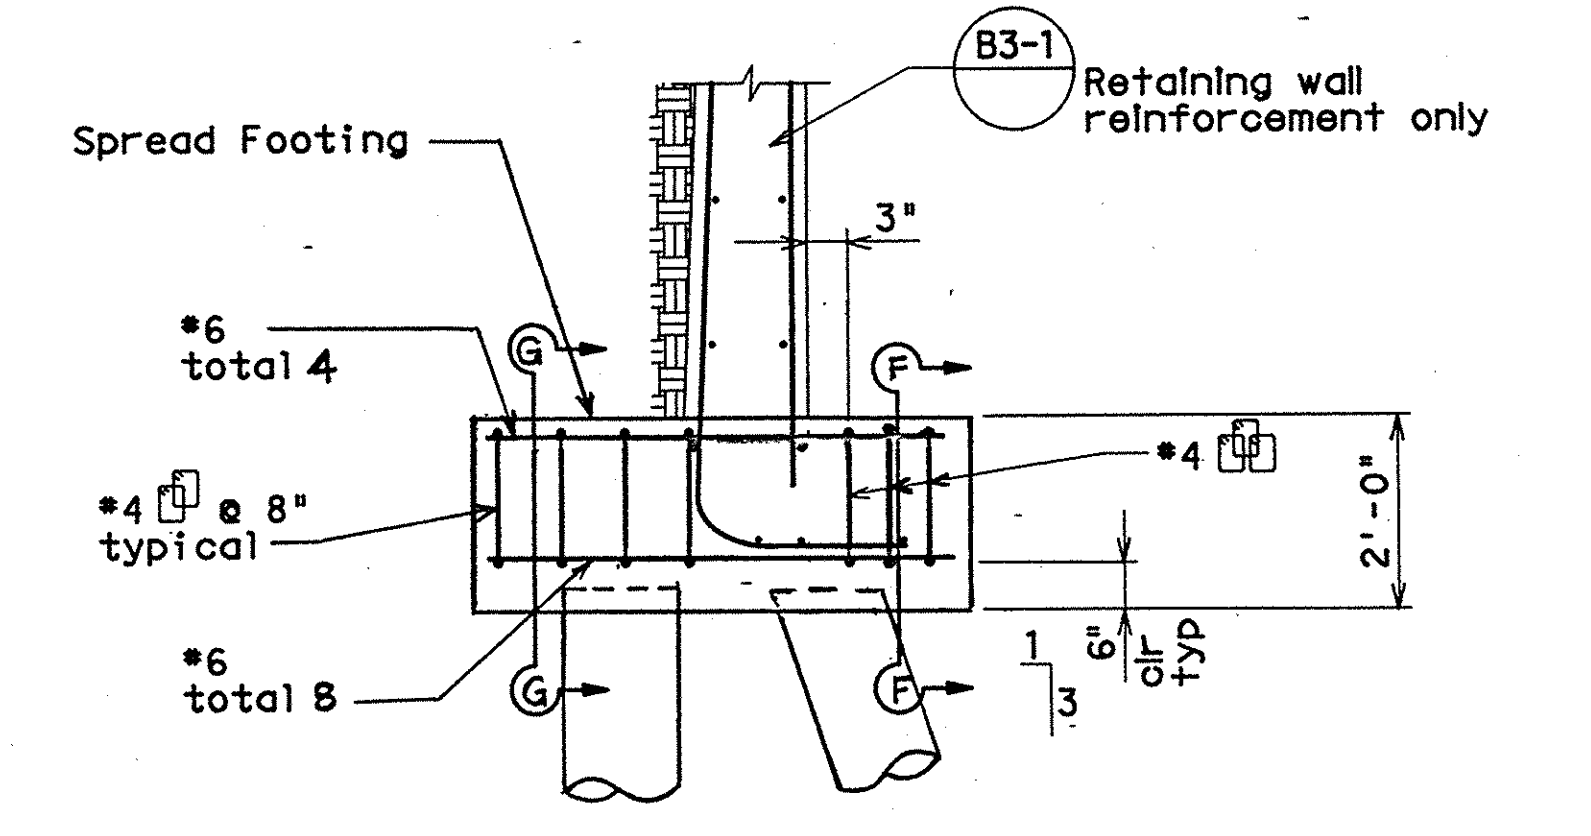

SECTION E-E
1/2" = 1'-0"

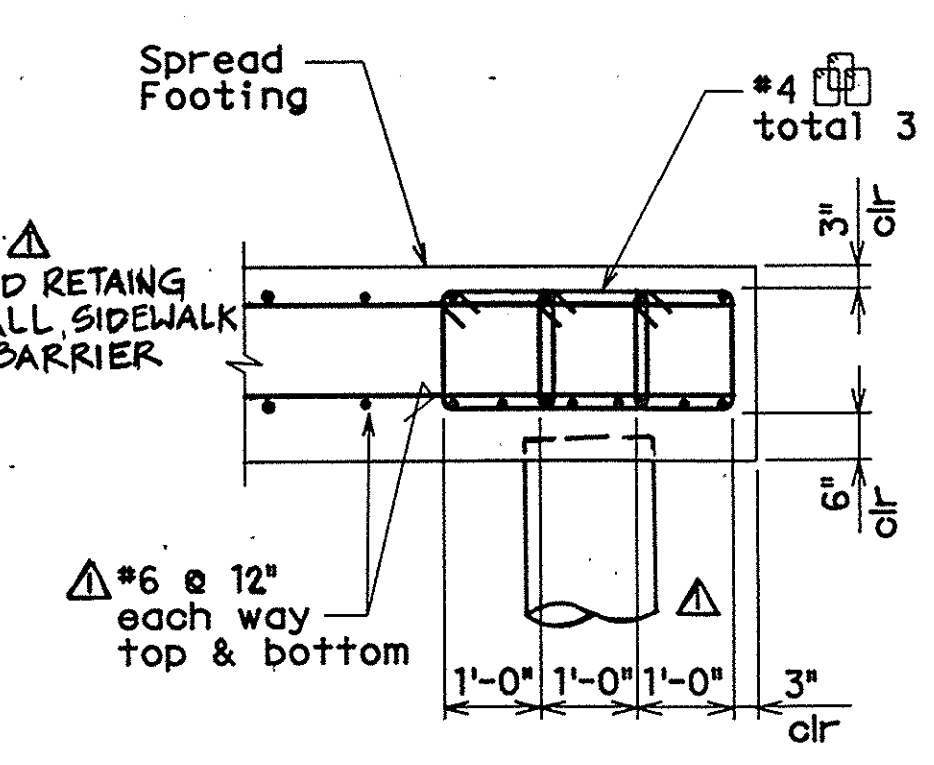

SECTION F-F
1/2" = 1'-0"

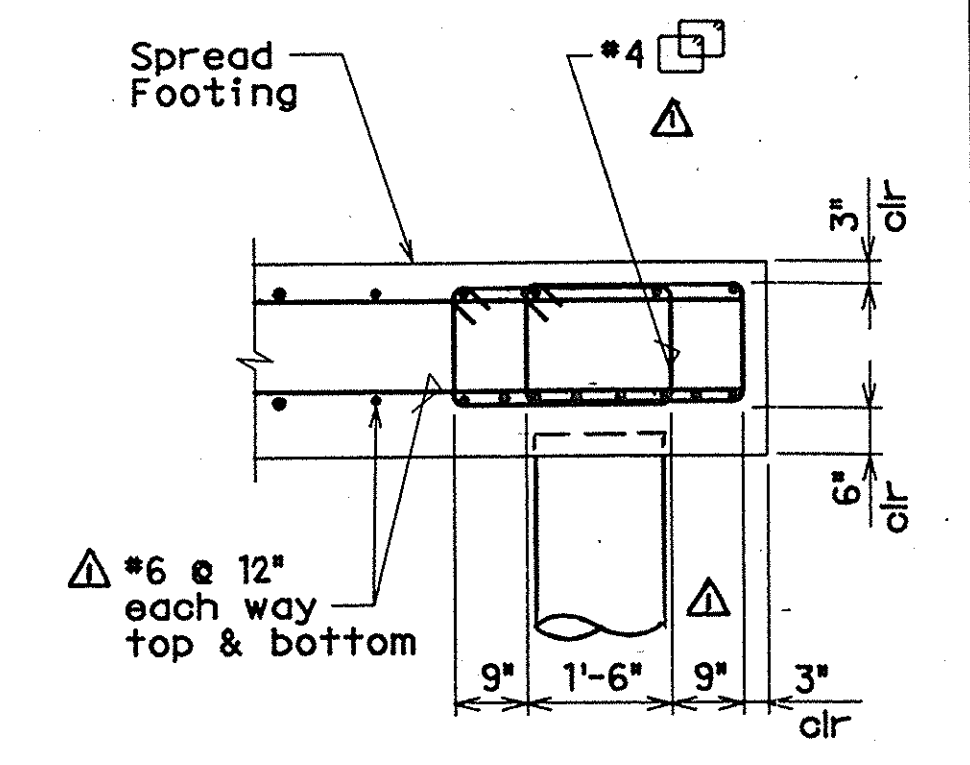

SECTION G-G
1/2" = 1'-0"

(619) 283-5424

LIBBY

STRUCTURAL ENGINEERS

4452 GLACIER AVENUE
SAN DIEGO, CALIFORNIA 92120

Professional Engineer
No. 2678
Structural
Exp. 12-31-92
State of California

MISSION VIEJO COMPANY

26137 LA PAZ ROAD • MISSION VIEJO • CALIFORNIA 92691

DATE	BY	REVISION DESCRIPTION	APP'D	DATE	CHK	MC	DATE	3-19-92
11/92	NM	AS NOTED	DES	BC	DN	NM		

PACIFIC PARK DRIVE BRIDGE

OVER
BICYCLE AND EQUESTRIAN TRAILS, AND AWMA EASEMENT
1300 ft. WEST OF ALICIA PARKWAY

ABUTMENT 2 DETAILS

DE 3 15719