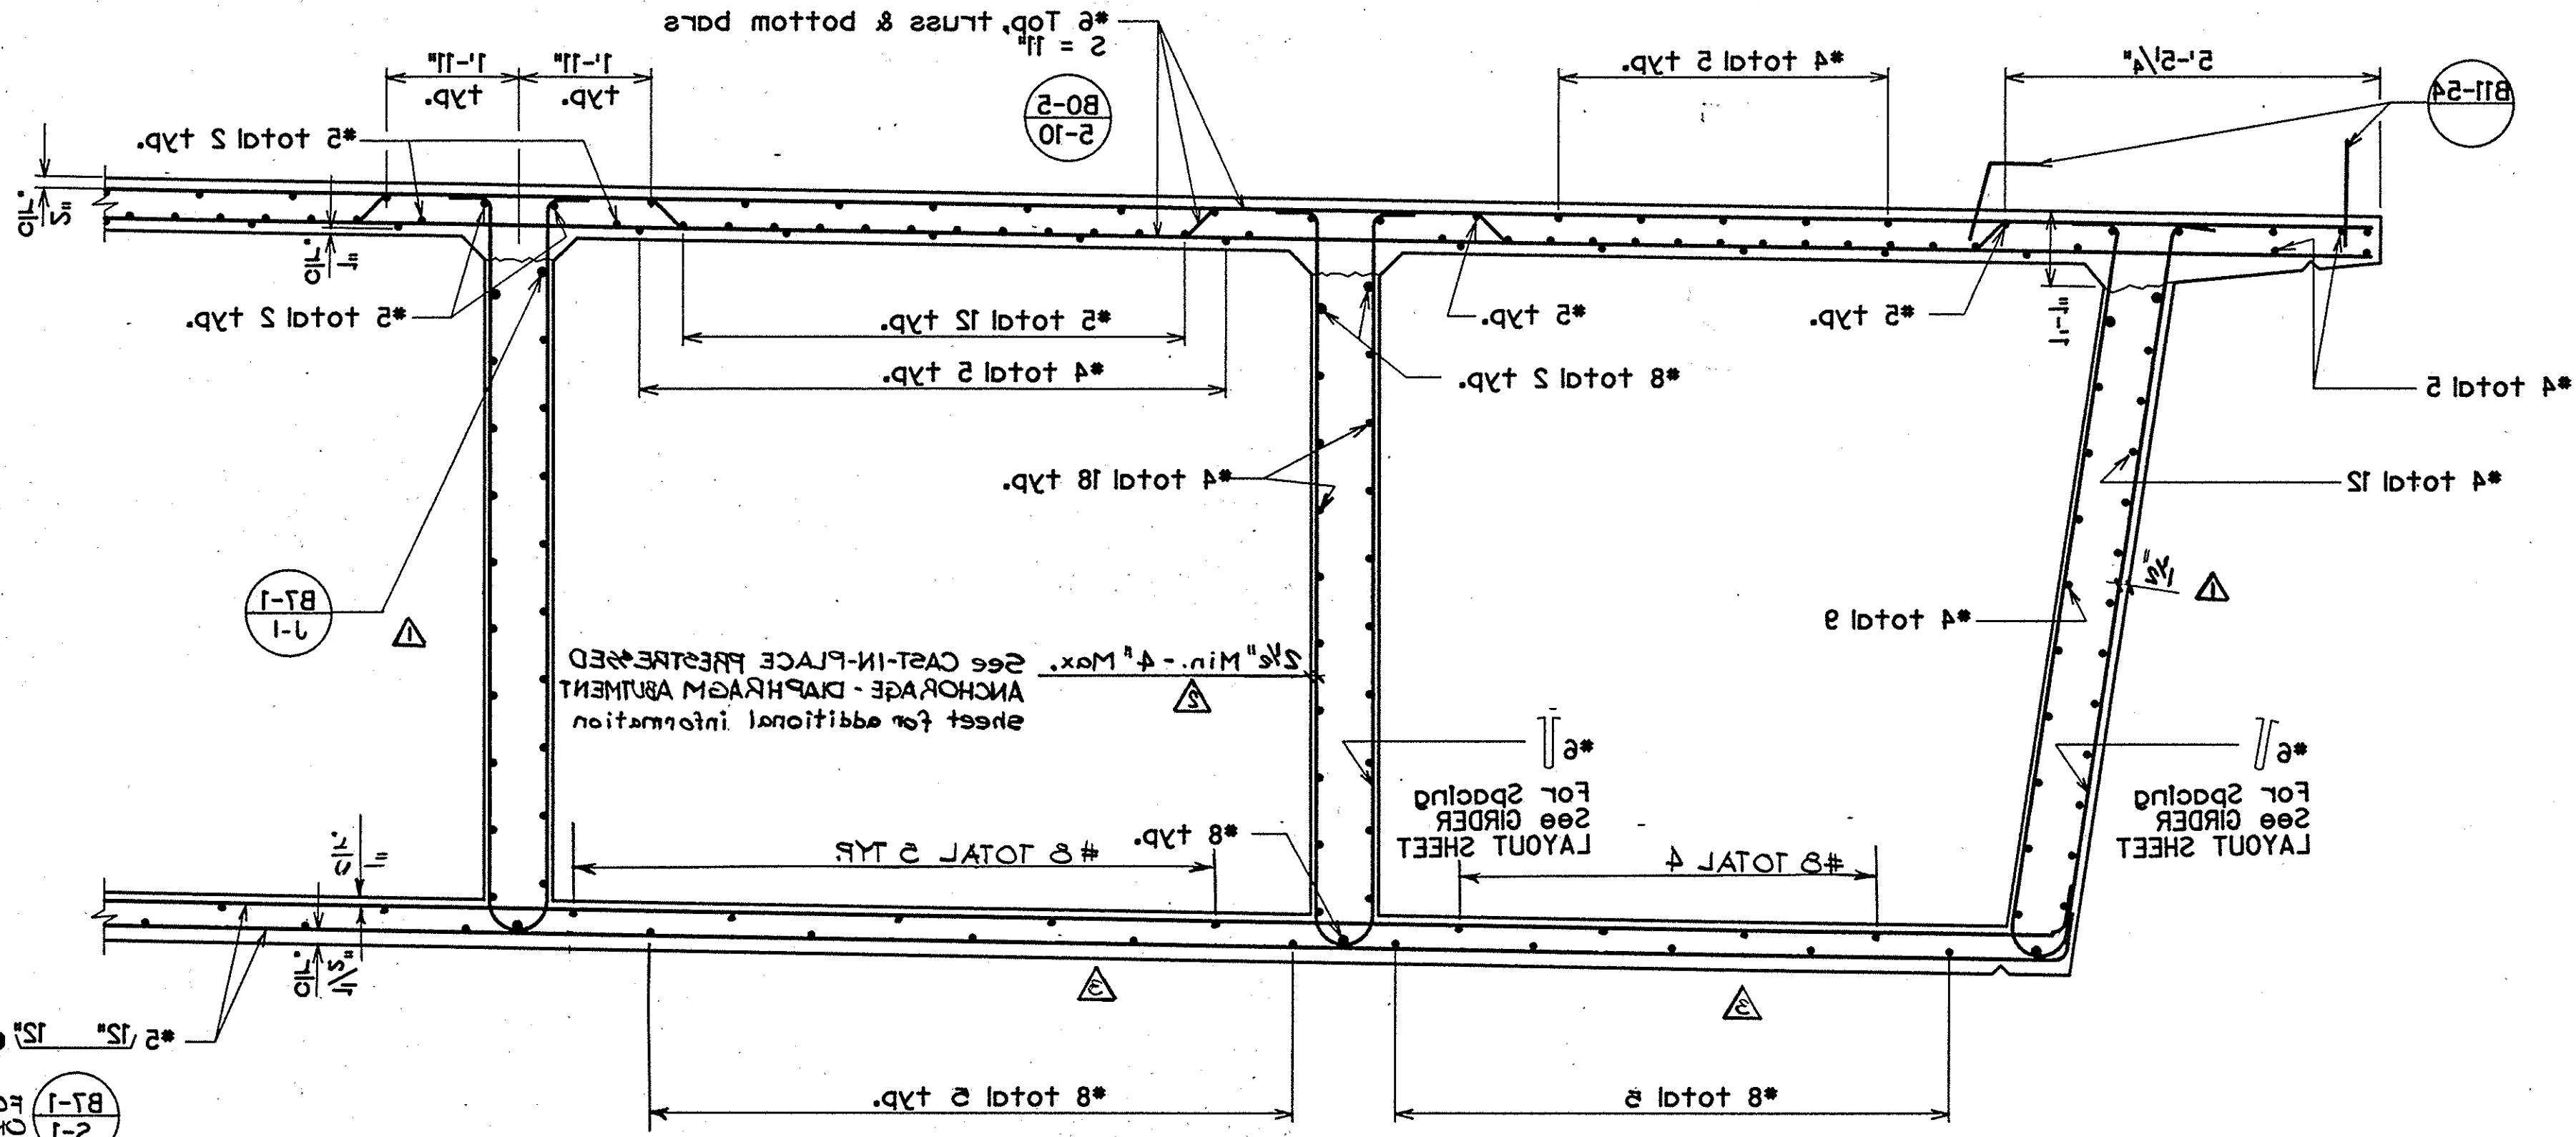


[illegible]

2521	TYPICAL SECTION AND DRAIN DETAILS	1200' ±± WEST OF ALICIA PARKWAY	BICYCLE AND EQUESTRIAN TRAILS, AND AMMA EASEMENT	OVER	PACIFIC PARK DRIVE BRIDGE	2521
10						

- Notes:
1. Horizontal dimensions are normal to § Pacific Park Drive.
 2. Transverse slab steel shall be placed perpendicular to the "qlers".
 3. See CAST-IN-PLACE PRESTRESSED ANCHORAGE - DIAPHRAGM ABUTMENT sheet for additional information.
 4. External longitudinal steel to within 6" of backface of abutment.


PARTIAL SECTION

$$1/s = 1 - 0$$


TYPICAL SECTION

$${}^{18}\text{O}-\text{C}=\text{N}-\text{P}=\text{N}$$

Note: Utilities not shown

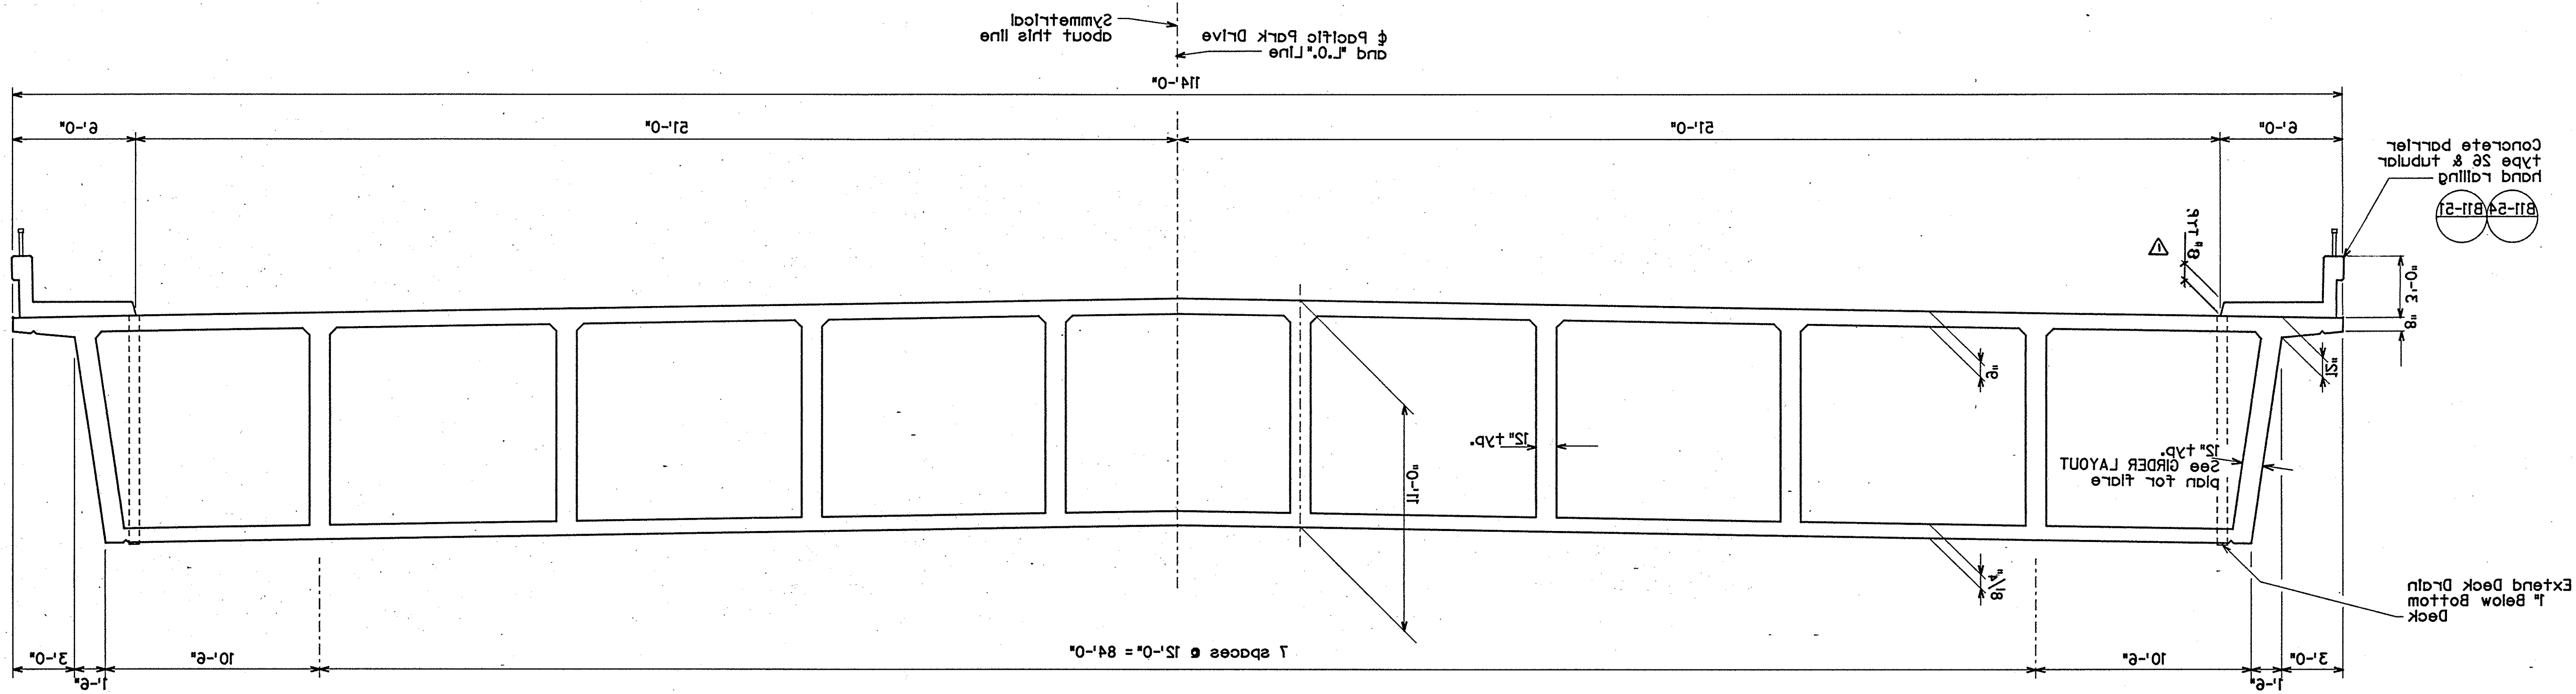

DRAIN DETAILS

"0-1" = "1"

SECTION Y-Y

