


EXACT

EXACT LEVEL & TYPICAL SECTION, N. J., U. S. A.

STRAIGHT EDGE RULE SE-48

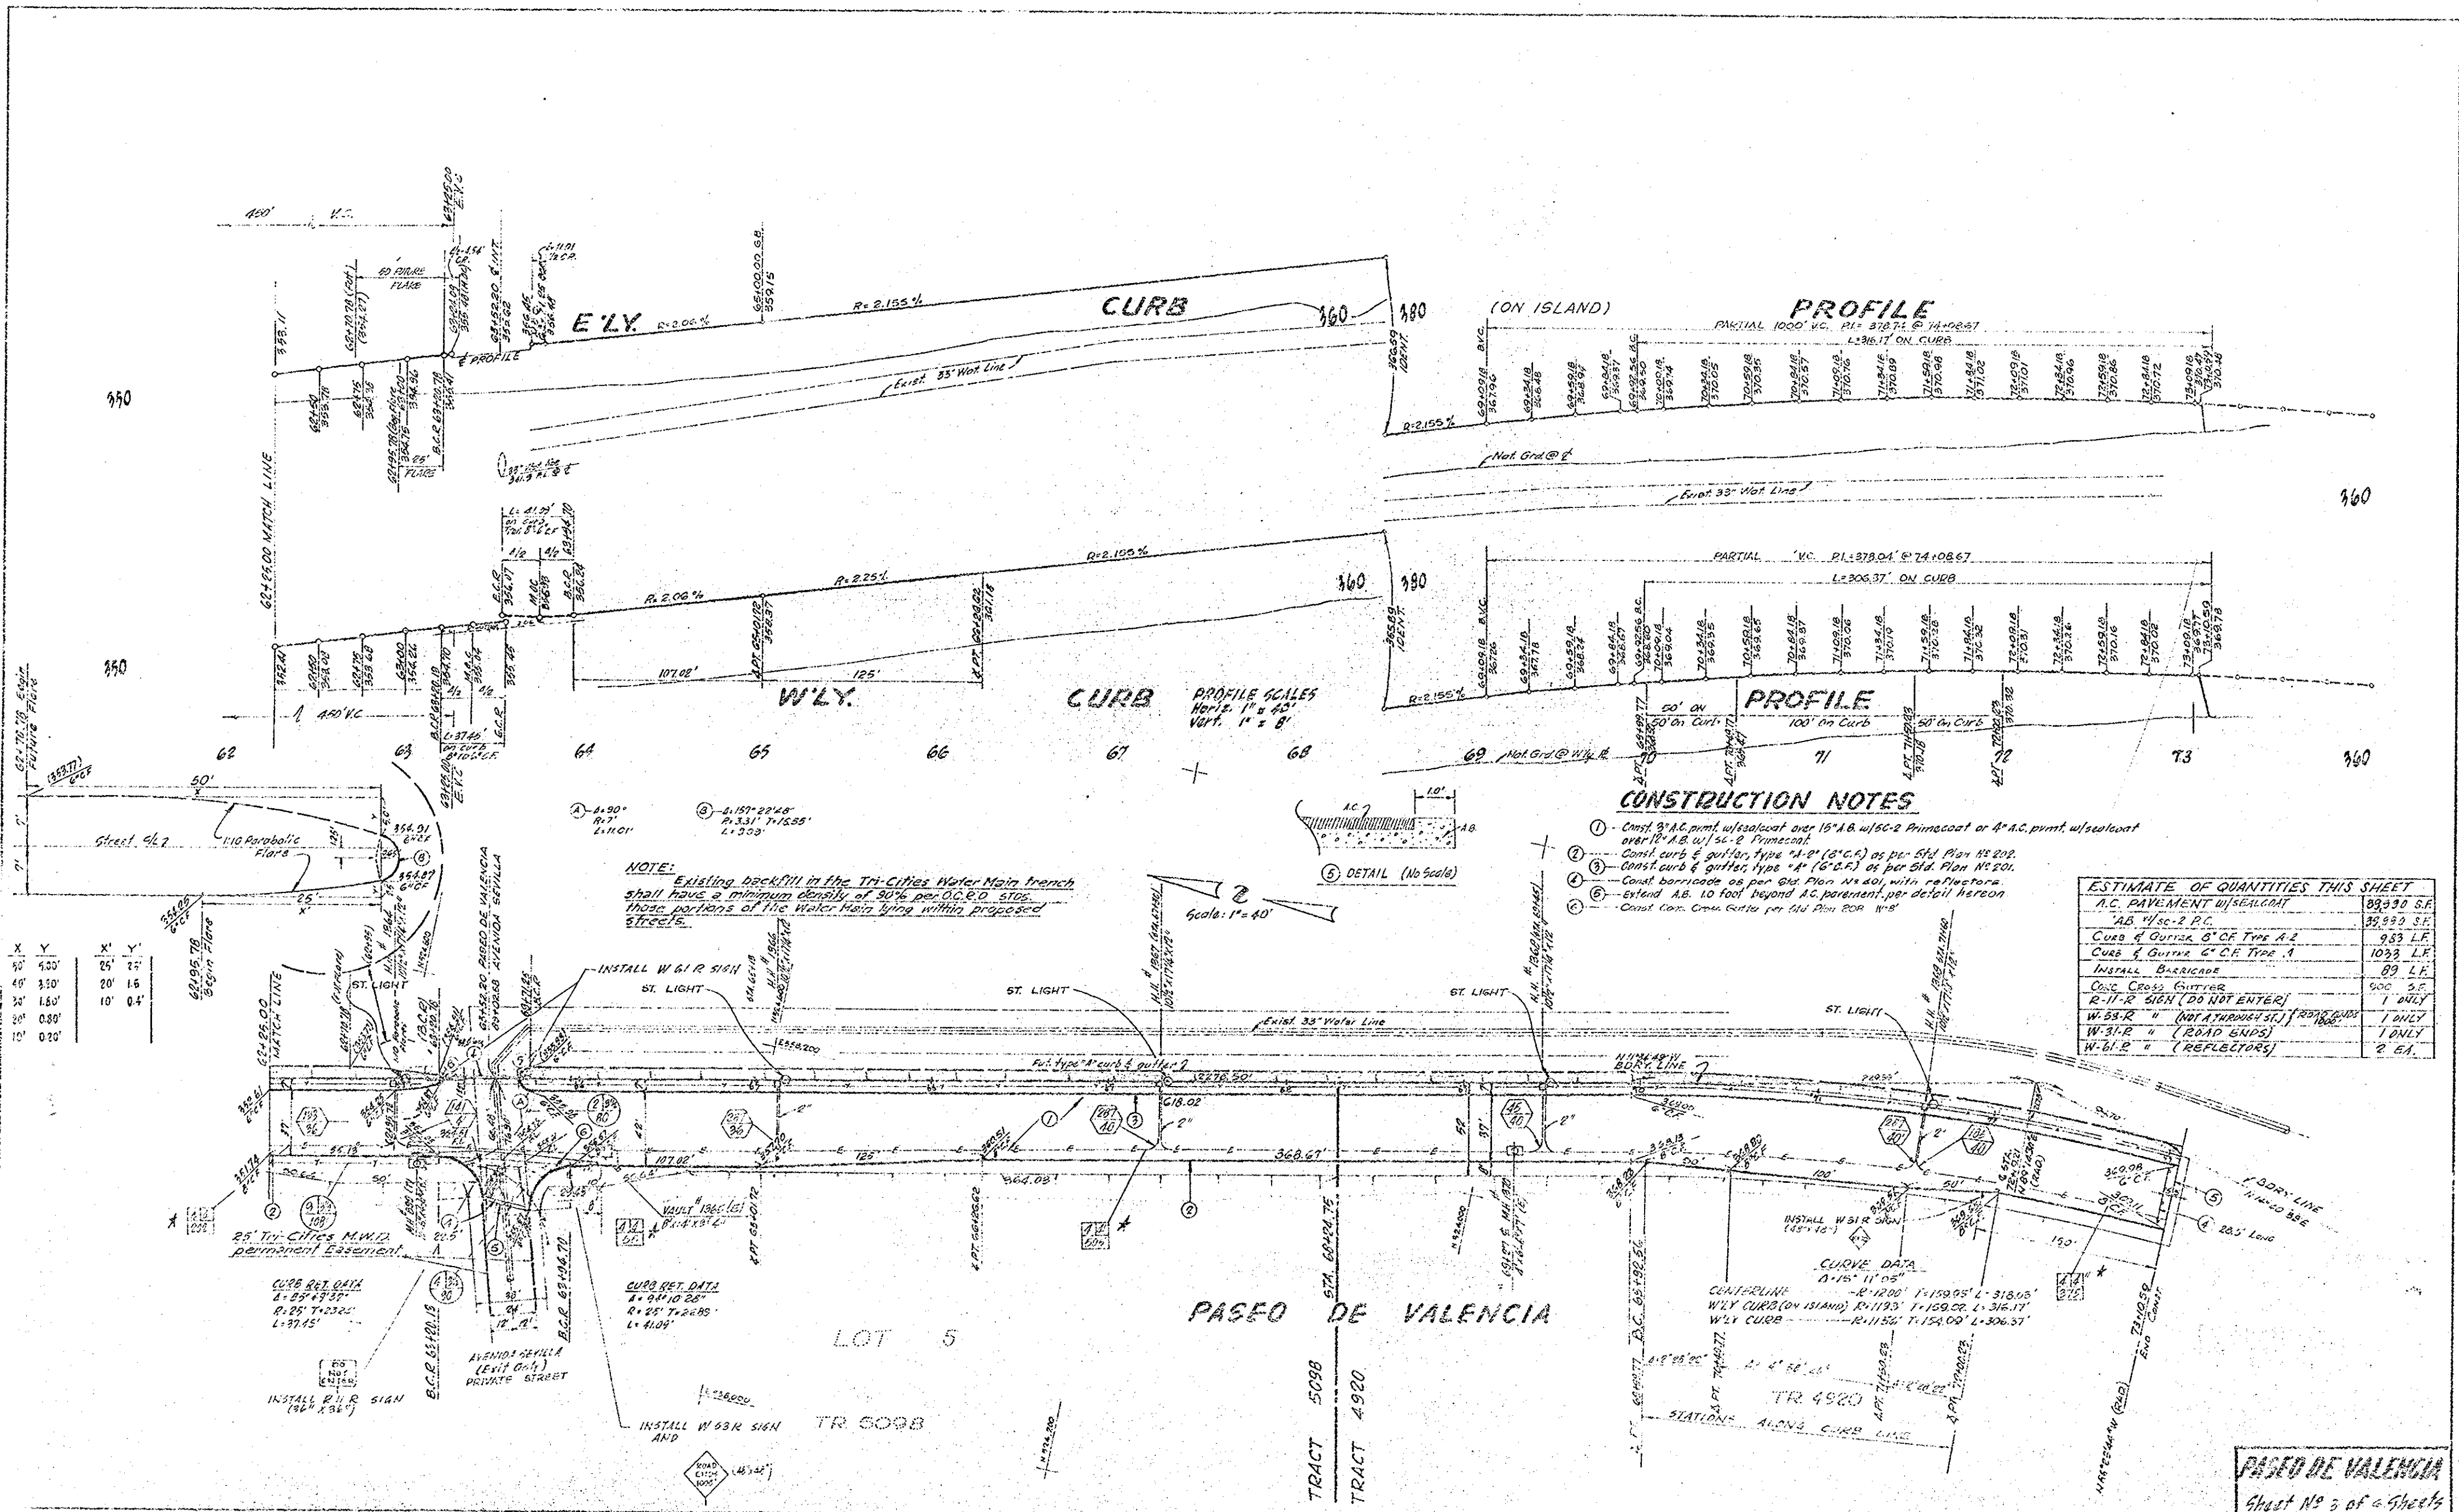

PASEO DE VALENCIA
Sheet No. 2 of 2 Sheets