
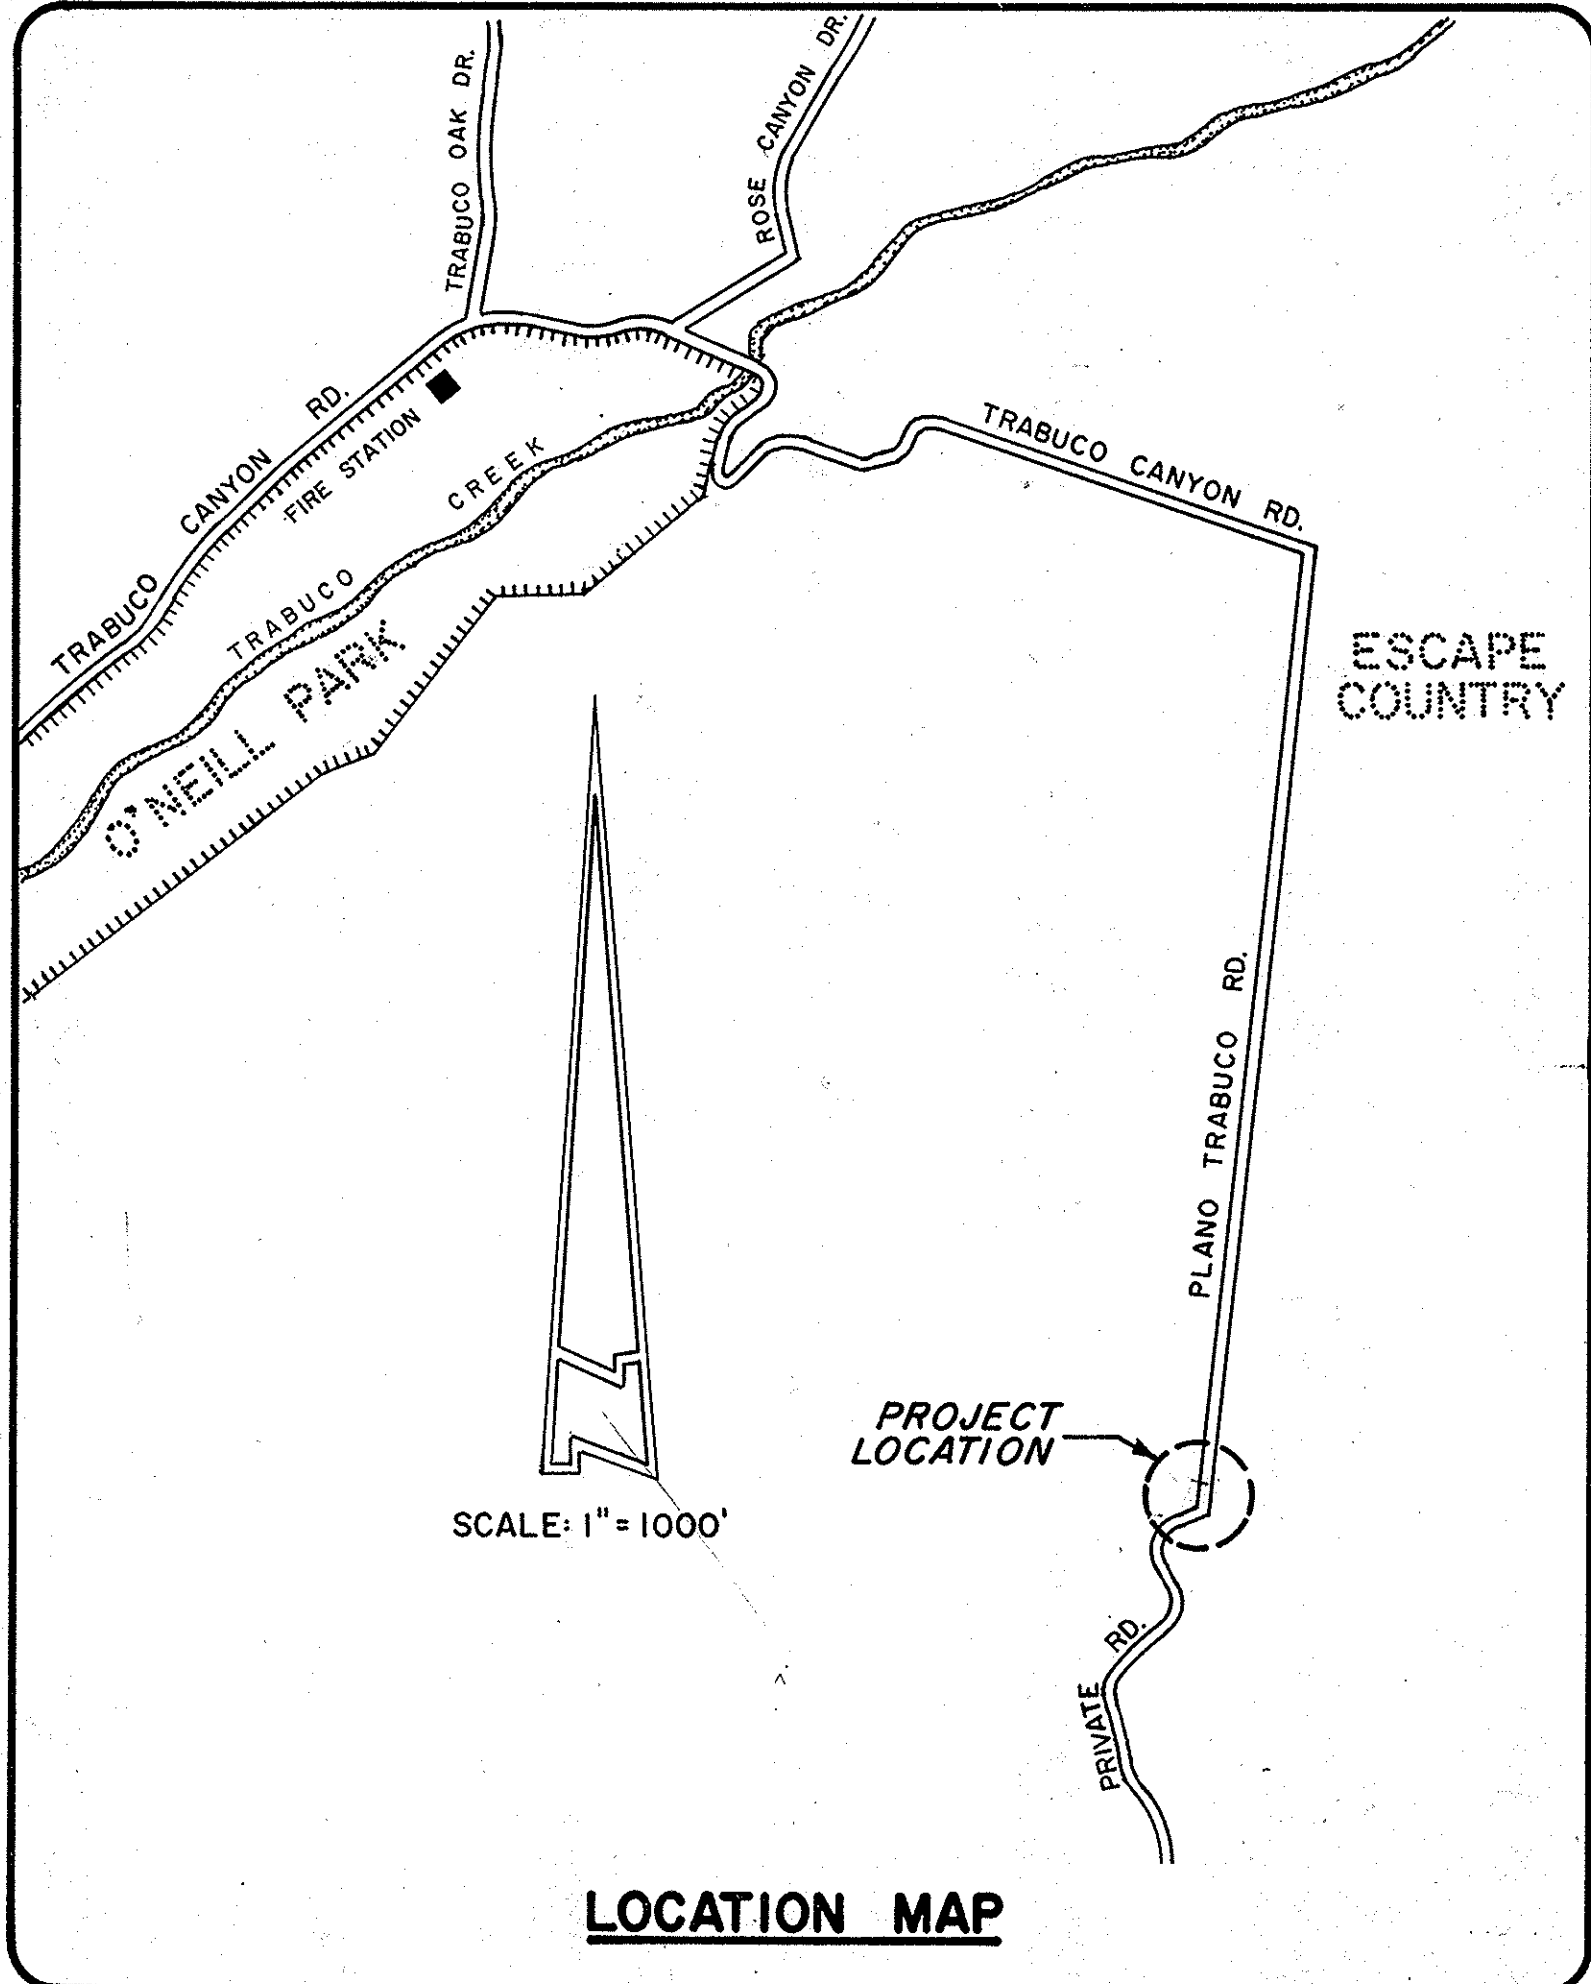


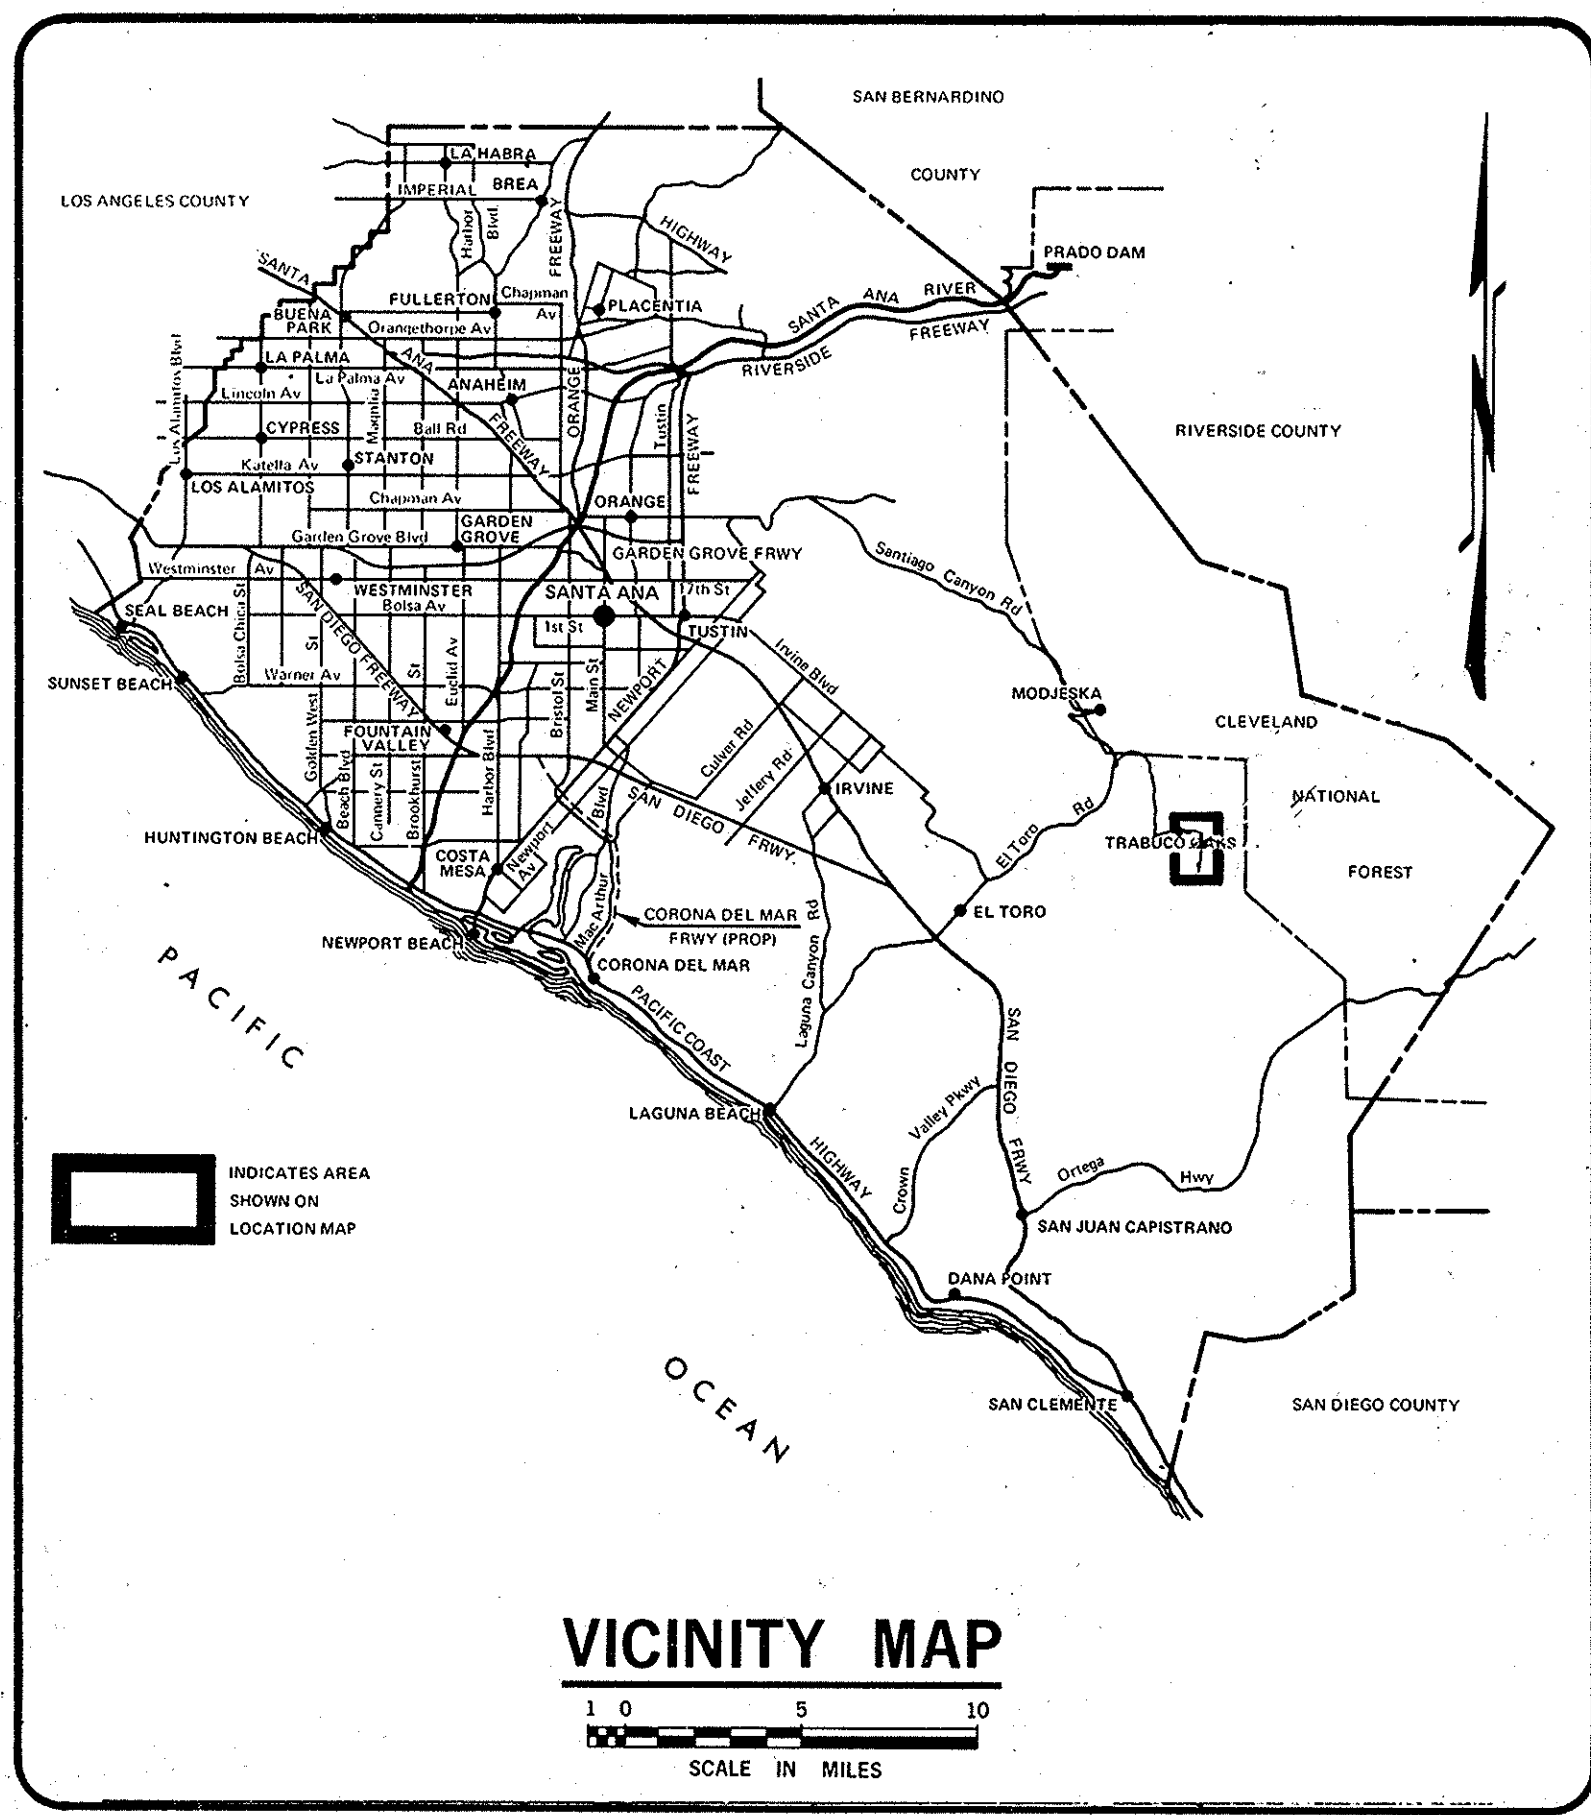

ORANGE COUNTY
ENVIRONMENTAL MANAGEMENT AGENCY
SANTA ANA, CALIFORNIA
H.G.OSBORNE, DIRECTOR
PLANS FOR REPLACEMENT OF
PLANO TRABUCO ROAD
BRIDGE S-III
AT
PAVEMENT END


INDEX OF SHEETS	
SHEET	DESCRIPTION
1	TITLE SHEET
2	GENERAL PLAN
3	MISCELLANEOUS DETAILS
4	MISCELLANEOUS DETAILS
5	DETOUR PLAN & CROSS SECTIONS
6	EXISTING TIMBER BRIDGE PLANS

UTILITY	PHONE NO.
COTO DE CAZA WATER LINE BOB WILHELM	586-0761
SOUTHERN CALIFORNIA EDISON COMPANY JIM NEUZIL	835-3833
PACIFIC TELEPHONE AND TELEGRAPH COMPANY E.A. WOLFF	837-0025
PRIVATE WATER LINE JAMES DAVIS (Owner)	832-7733
SANTA MARGARITA WATER DISTRICT LEONARD FORD	586-1750


BENCH MARK: 3W-43-72
LOCATED AT THE END OF PLANO TRABUCO ROAD (2.3 MILES FROM TRABUCO FIRE STATION) AT THE MAIN ENTRANCE TO COTO DE CAZA; THE MARK IS 120 FEET EAST OF THE EAST-ERLY CORNER OF THE SECURITY BUILDING, 20 FEET WEST OF THE CENTERLINE OF PLANO TRABUCO ROAD, 100 FEET SOUTH OF THE SOUTH EDGE OF THE PAVED ENTRANCE ROAD, 3 FEET NORTH OF THE NORTH EDGE OF THE PAVED EXIT ROAD, 2 FEET SOUTH OF A STEEL WITNESS POST SET IN THE TOP OF A CON-CRETE POST, 0.3 FOOT ABOVE THE GROUND.
ELEV: 1091.225 1970 ADJUSTMENT
ALUMINUM CAP STAMPED 3W-43-72

BASIS OF BEARING:
N 05° 34' 43" E FOR THE E OF PLANO TRABUCO ROAD AS SHOWN ON RECORD OF SURVEY 72/4-6 RECORDS OF ORANGE COUNTY.

FUNDED BY: COUNTY of ORANGE HIGHWAY USERS TAXES
FHWA / FEDERAL AID FOR OFF-SYSTEM ROADS (FAOS) PROGRAM ORA-DOT-(H)-12-77-010

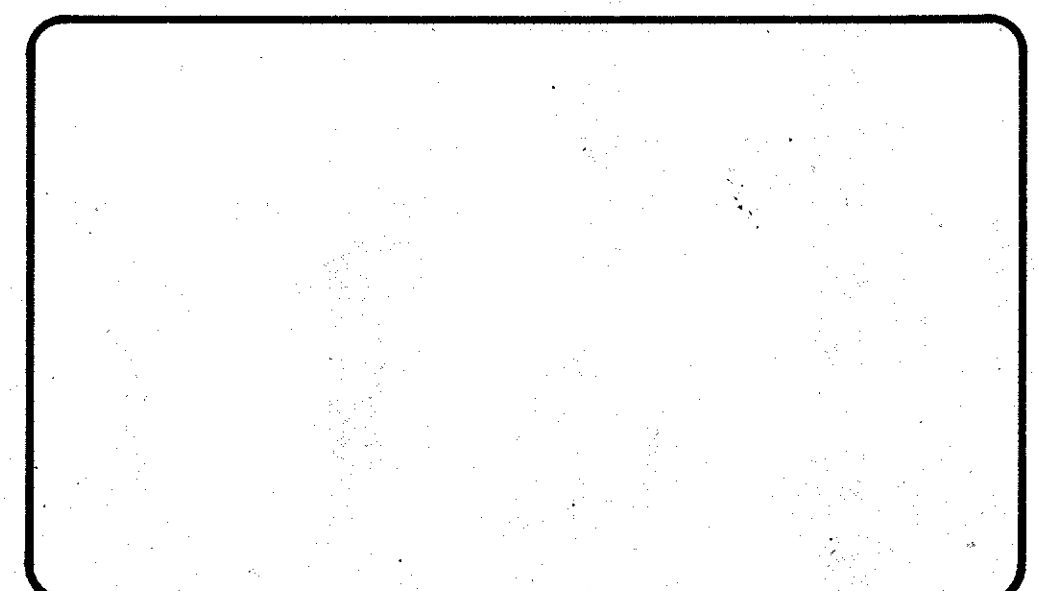

EMA-DEVELOPMENT
SUBMITTED: *Wendell P. Hartman* 6-22-77
SECTION CHIEF RCE 13941
RECOMMENDED: *J.W. Williams* 7/6/77
DIVISION MANAGER RCE 13154
APPROVED: *C.R. Nelson* 7-6-77
ASSISTANT DIRECTOR RCE 13142

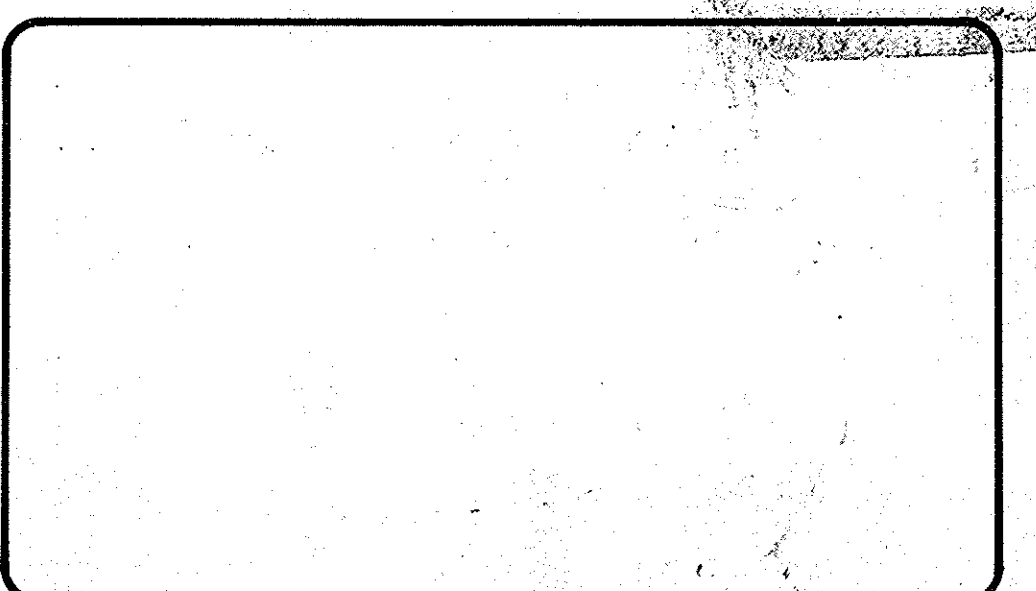

NO.	DESCRIPTION	SHT.	APPROVED	DATE
	AS BUILT	1	V.S.	7/10/77
REVISIONS				

W.O. NO. R12026
DWG. NO. _____
SHEET 1 OF 6