



CONSTRUCTION NOTES:

- 1 REMOVE TIMBER BRIDGE
- 2 CONSTRUCT 8" A.C. WITH .55-1H SEALCOAT OVER
COMPACTED N.S. WITH S.C. 250 PRIME COAT.
- 3 REMOVE
- 4 PROTECT IN PLACE
- 5 CONSTRUCT 14' x 7' R.C.B. L=44.68'
- 6 PAINT DOUBLE 4" YELLOW LINE AND PLACE "TYPE D"
PAVEMENT MARKERS PER DETAIL THIS SHEET.
- 7 PAINT 4" WIDE EDGE STRIPE.
- 8 STENCIL "S-III 1977" ON GUARD RAIL.
- 9 PLACE "F-1" GUIDE MARKER
- 10 CONSTRUCT ROCK SLOPE PROTECTION (FACING
CLASS - METHOD B) PER DETAILS THIS SHEET.
- 11 CONSTRUCT 116 L.F. METAL BEAM GUARD RAIL
PER DETAILS SHEET 4.

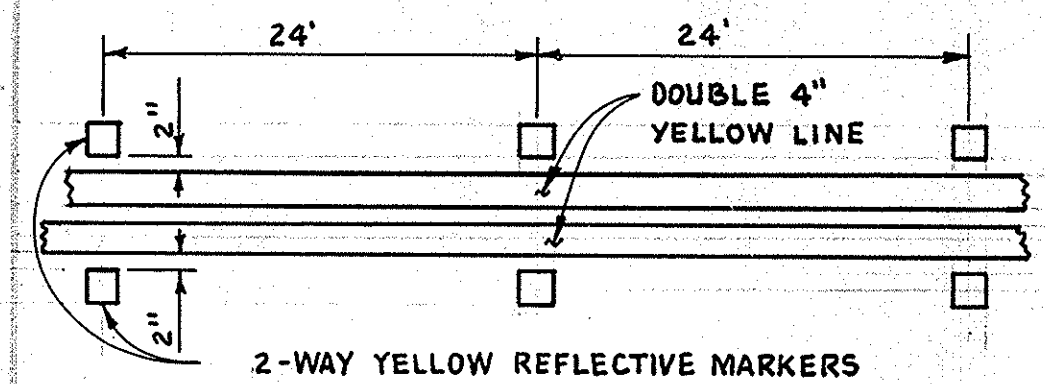


PAVEMENT MARKER DETAIL "TYPE D"

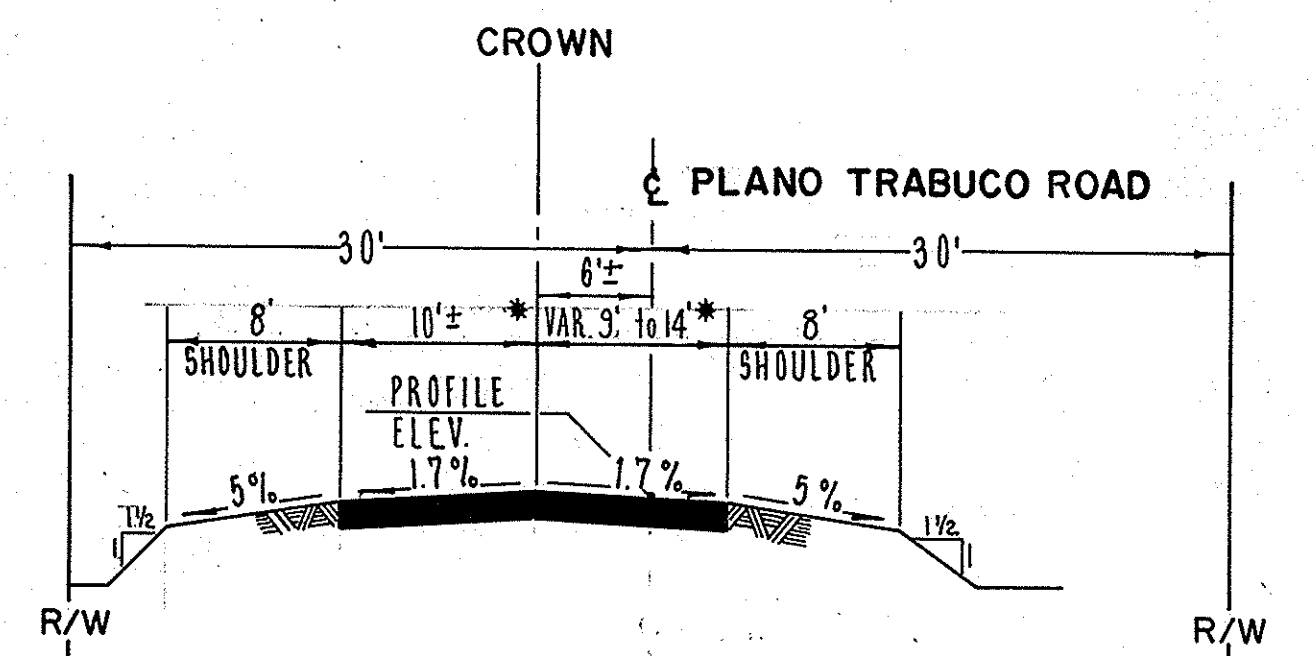


TYPICAL SECTION
PLANO TRABUCO ROAD
STA. 8+90 TO STA. 11+15

*24' PAVEMENT - STA. 9+90 TO STA. 10+15.

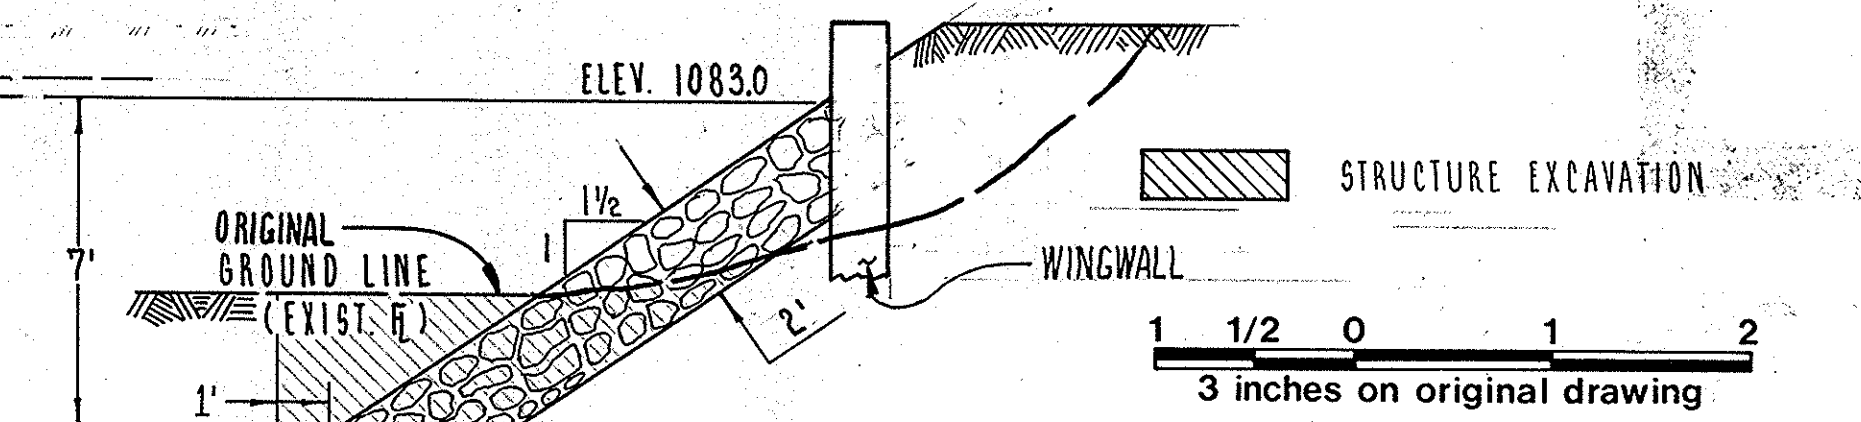


SECTION A-A
NO SCALE

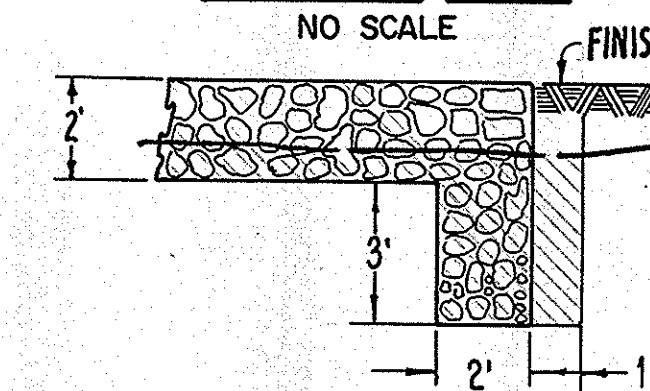

SECTION B-B
CUT-OFF WALL
NO SCALE

ORANGE COUNTY ENVIRONMENTAL MANAGEMENT AGENCY			
PLANO TRABUCO ROAD BRIDGE S-III REPLACEMENT AT PAVEMENT END			
GENERAL PLAN			
DATE	DESCRIPTION	PREPARED UNDER SUPERVISION OF	SHEET
REVISIONS			2/6
DESIGNED S. VANDER MEY	SCALE	DATE	DWG. NO.
DRAWN PJS	CHECKED J.R.J.	AS SHOWN	

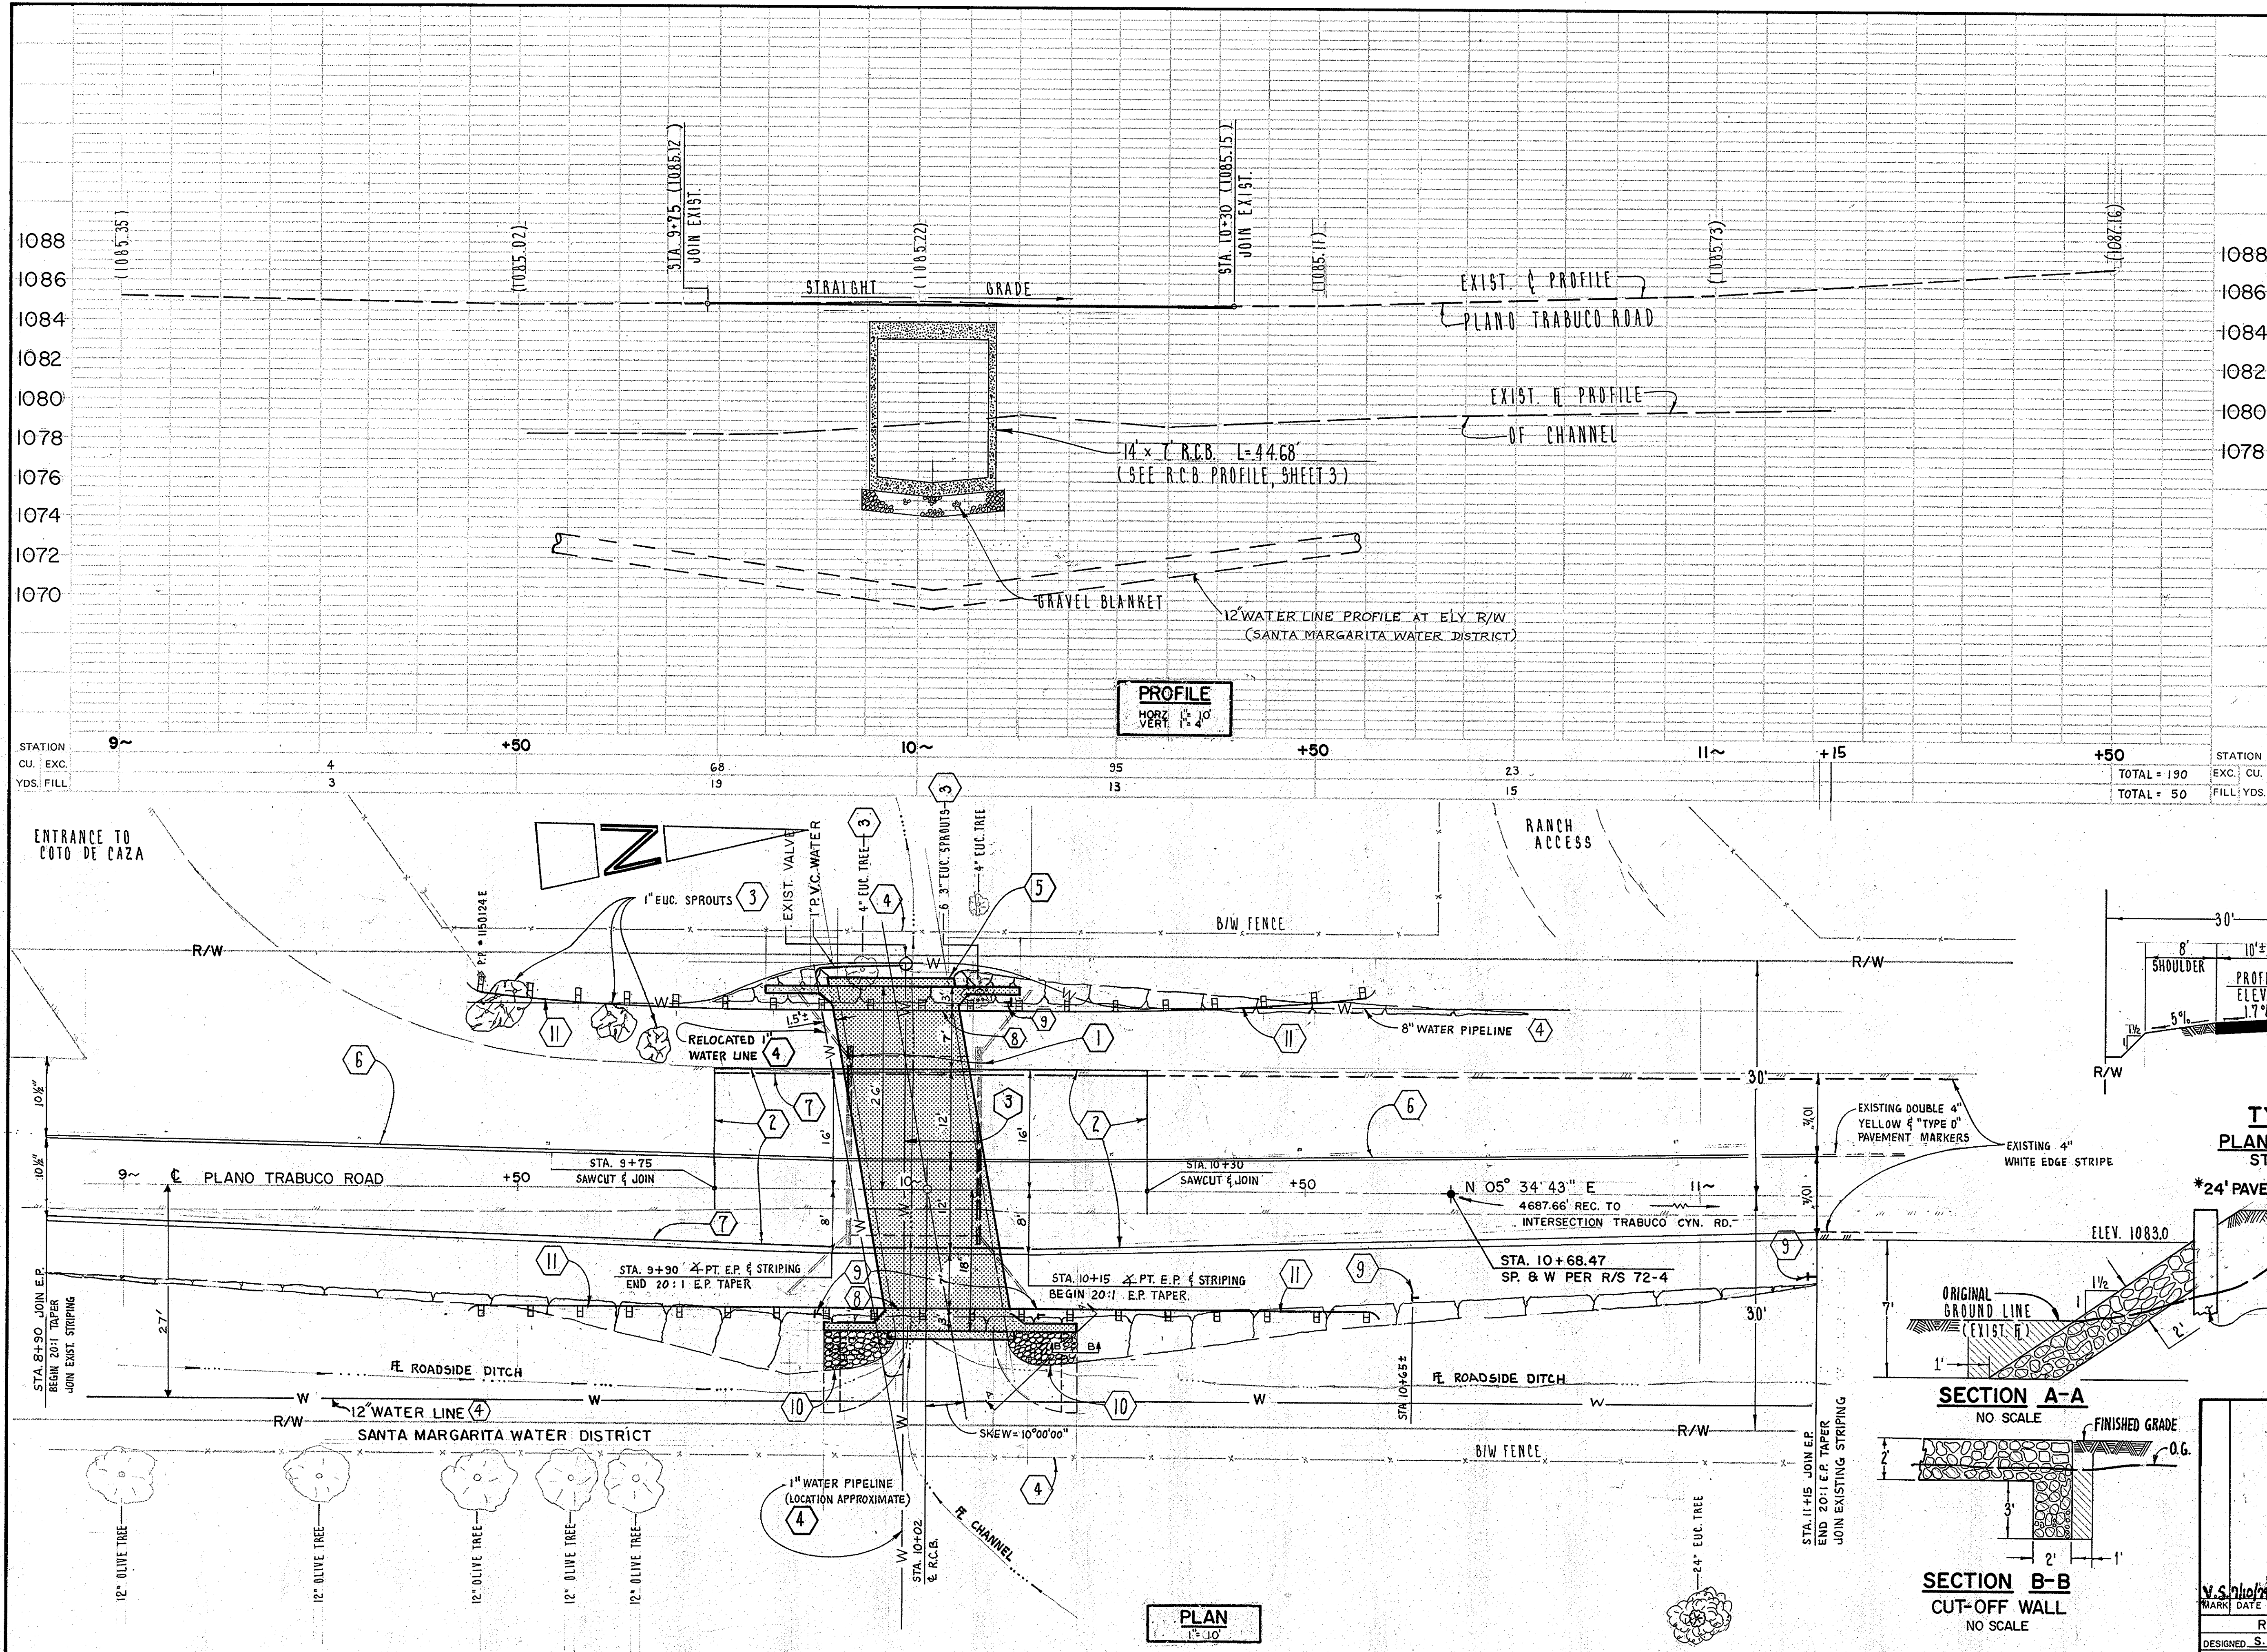

PLAN
1"=10'