

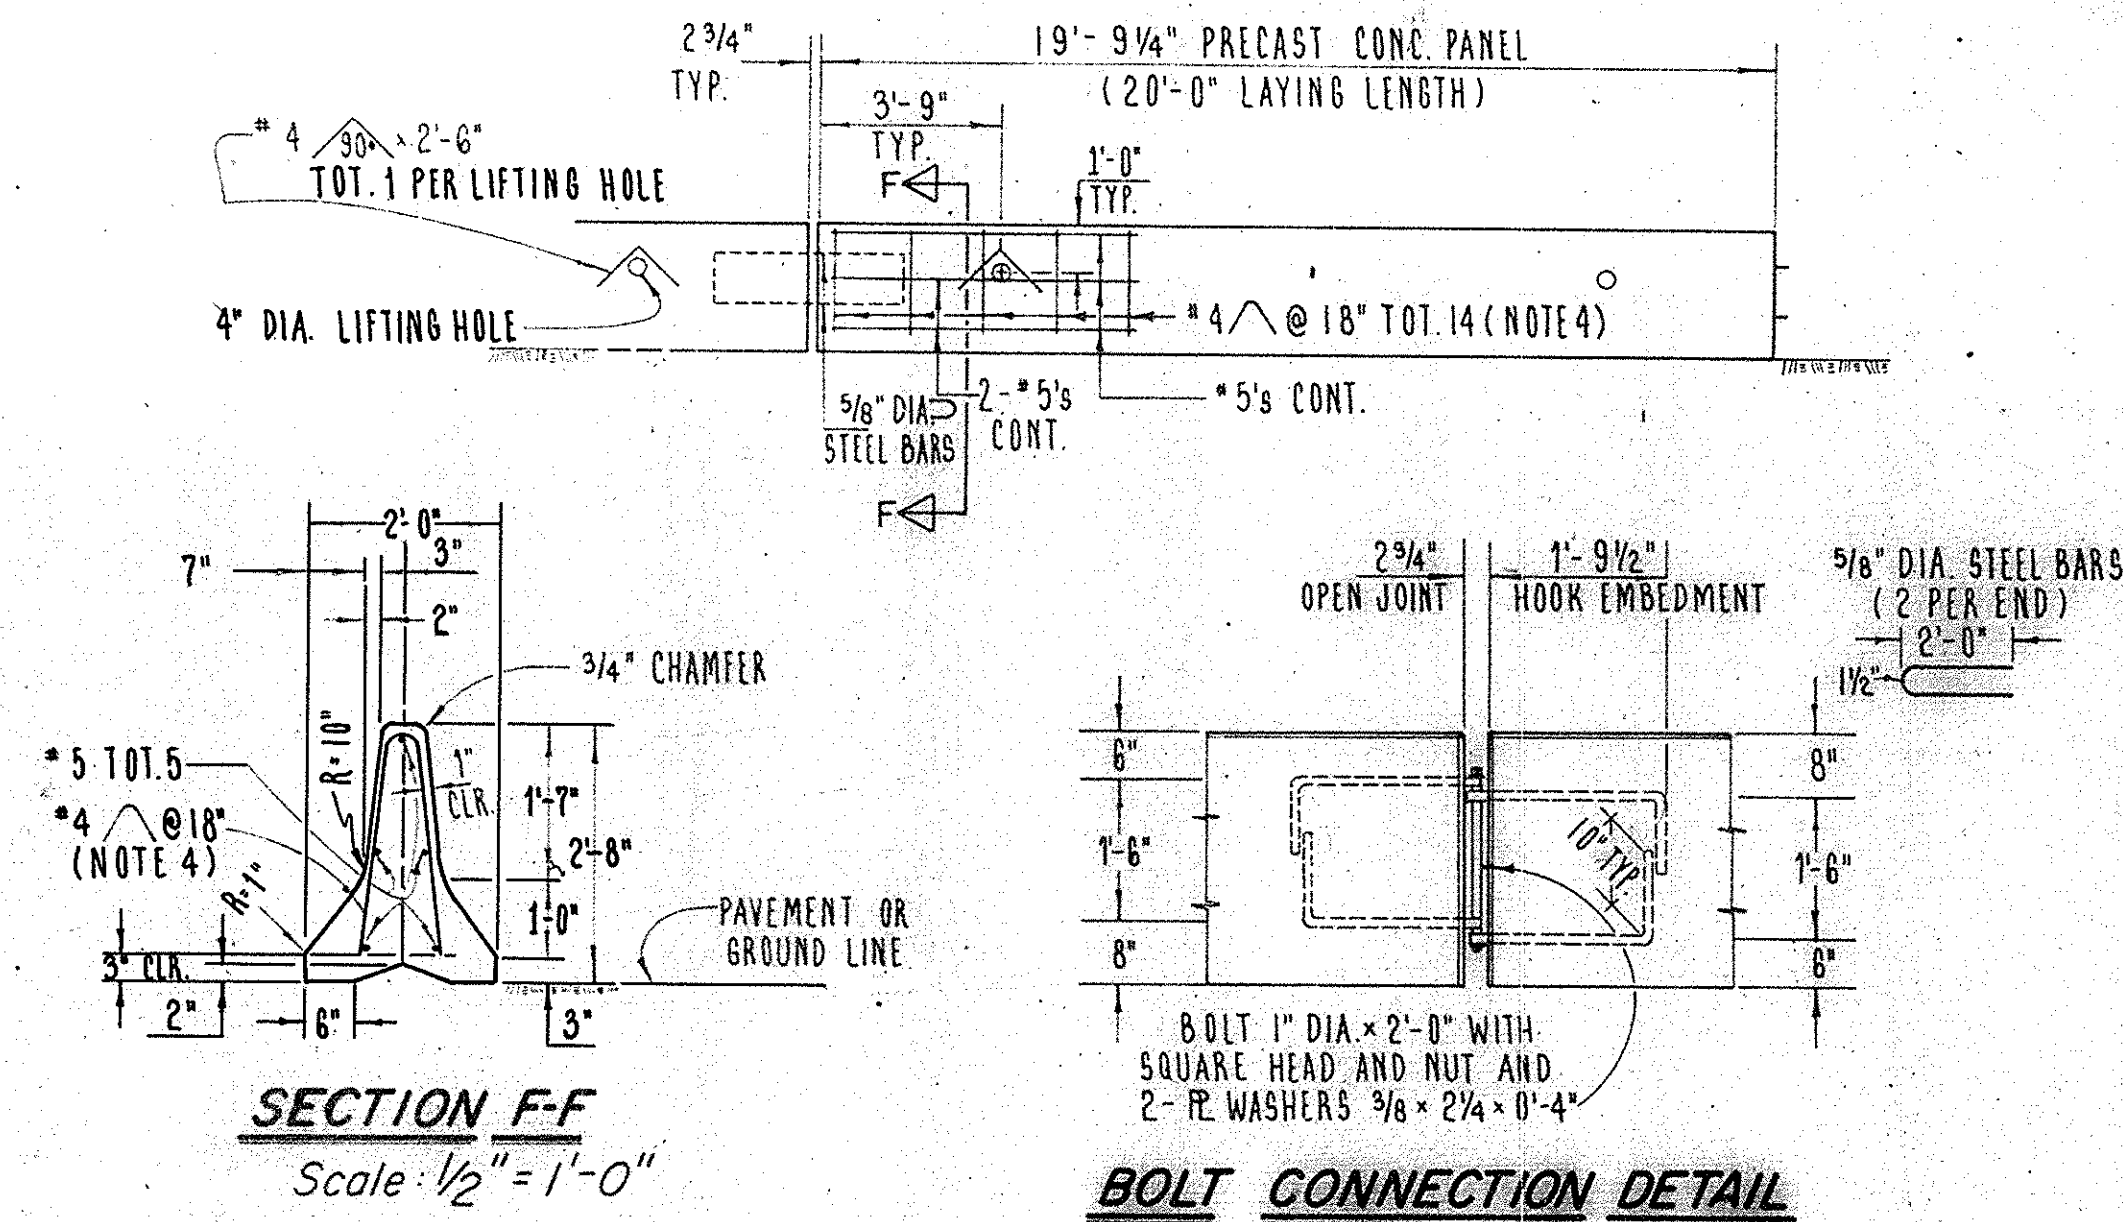
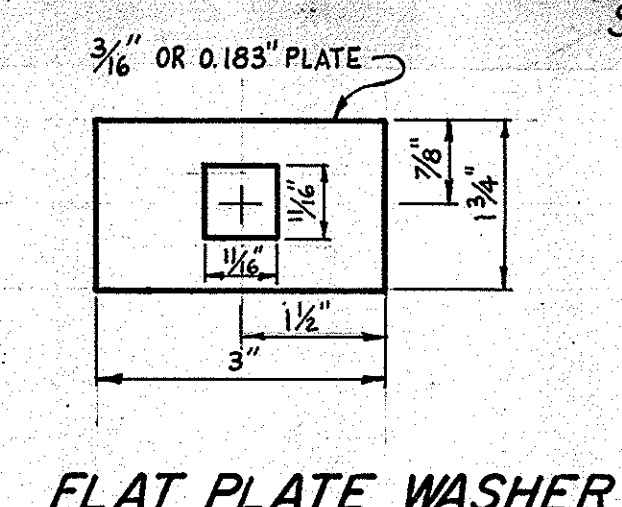
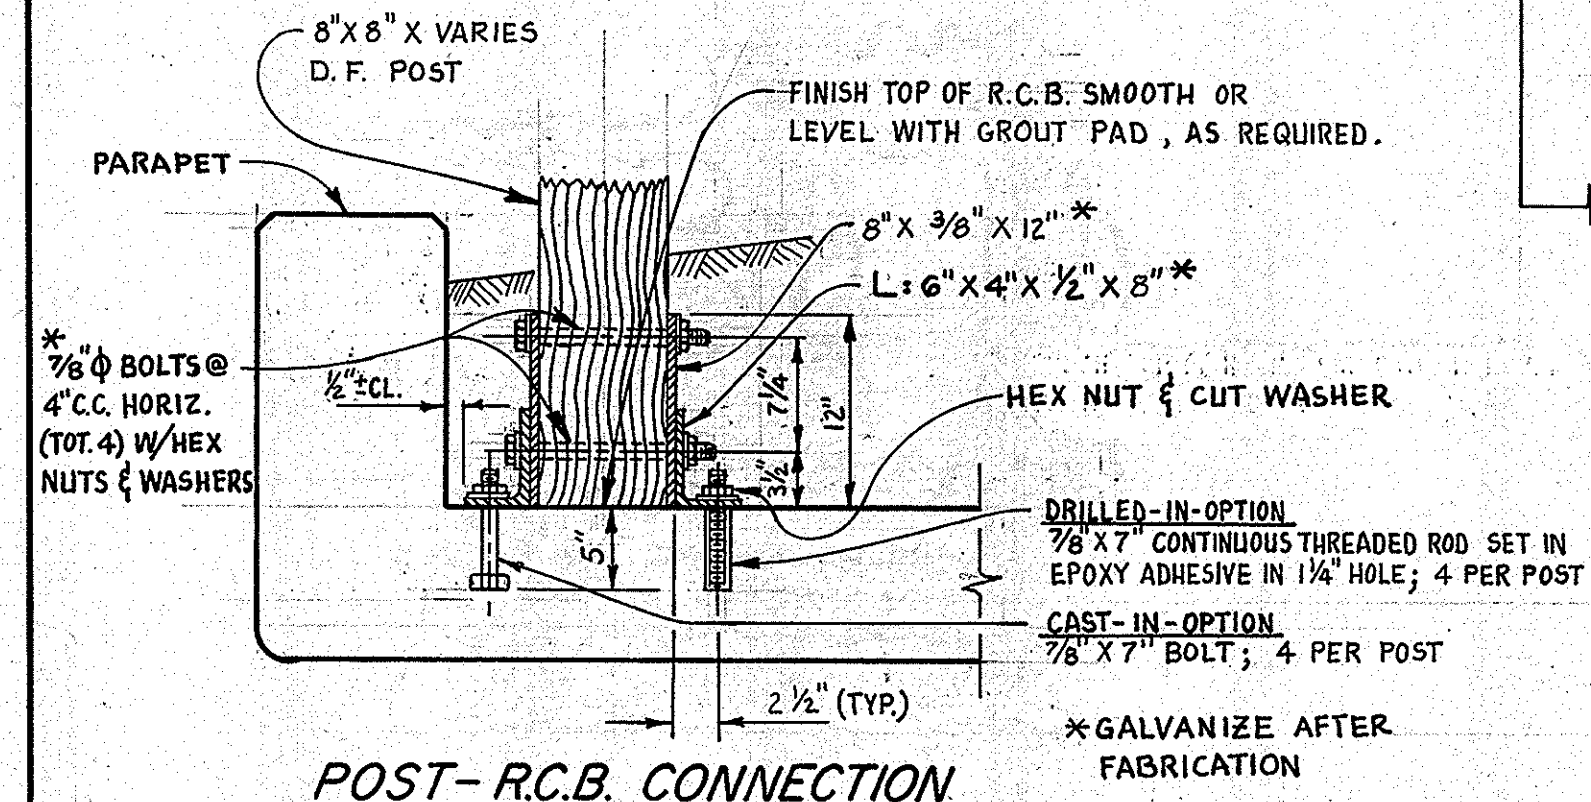
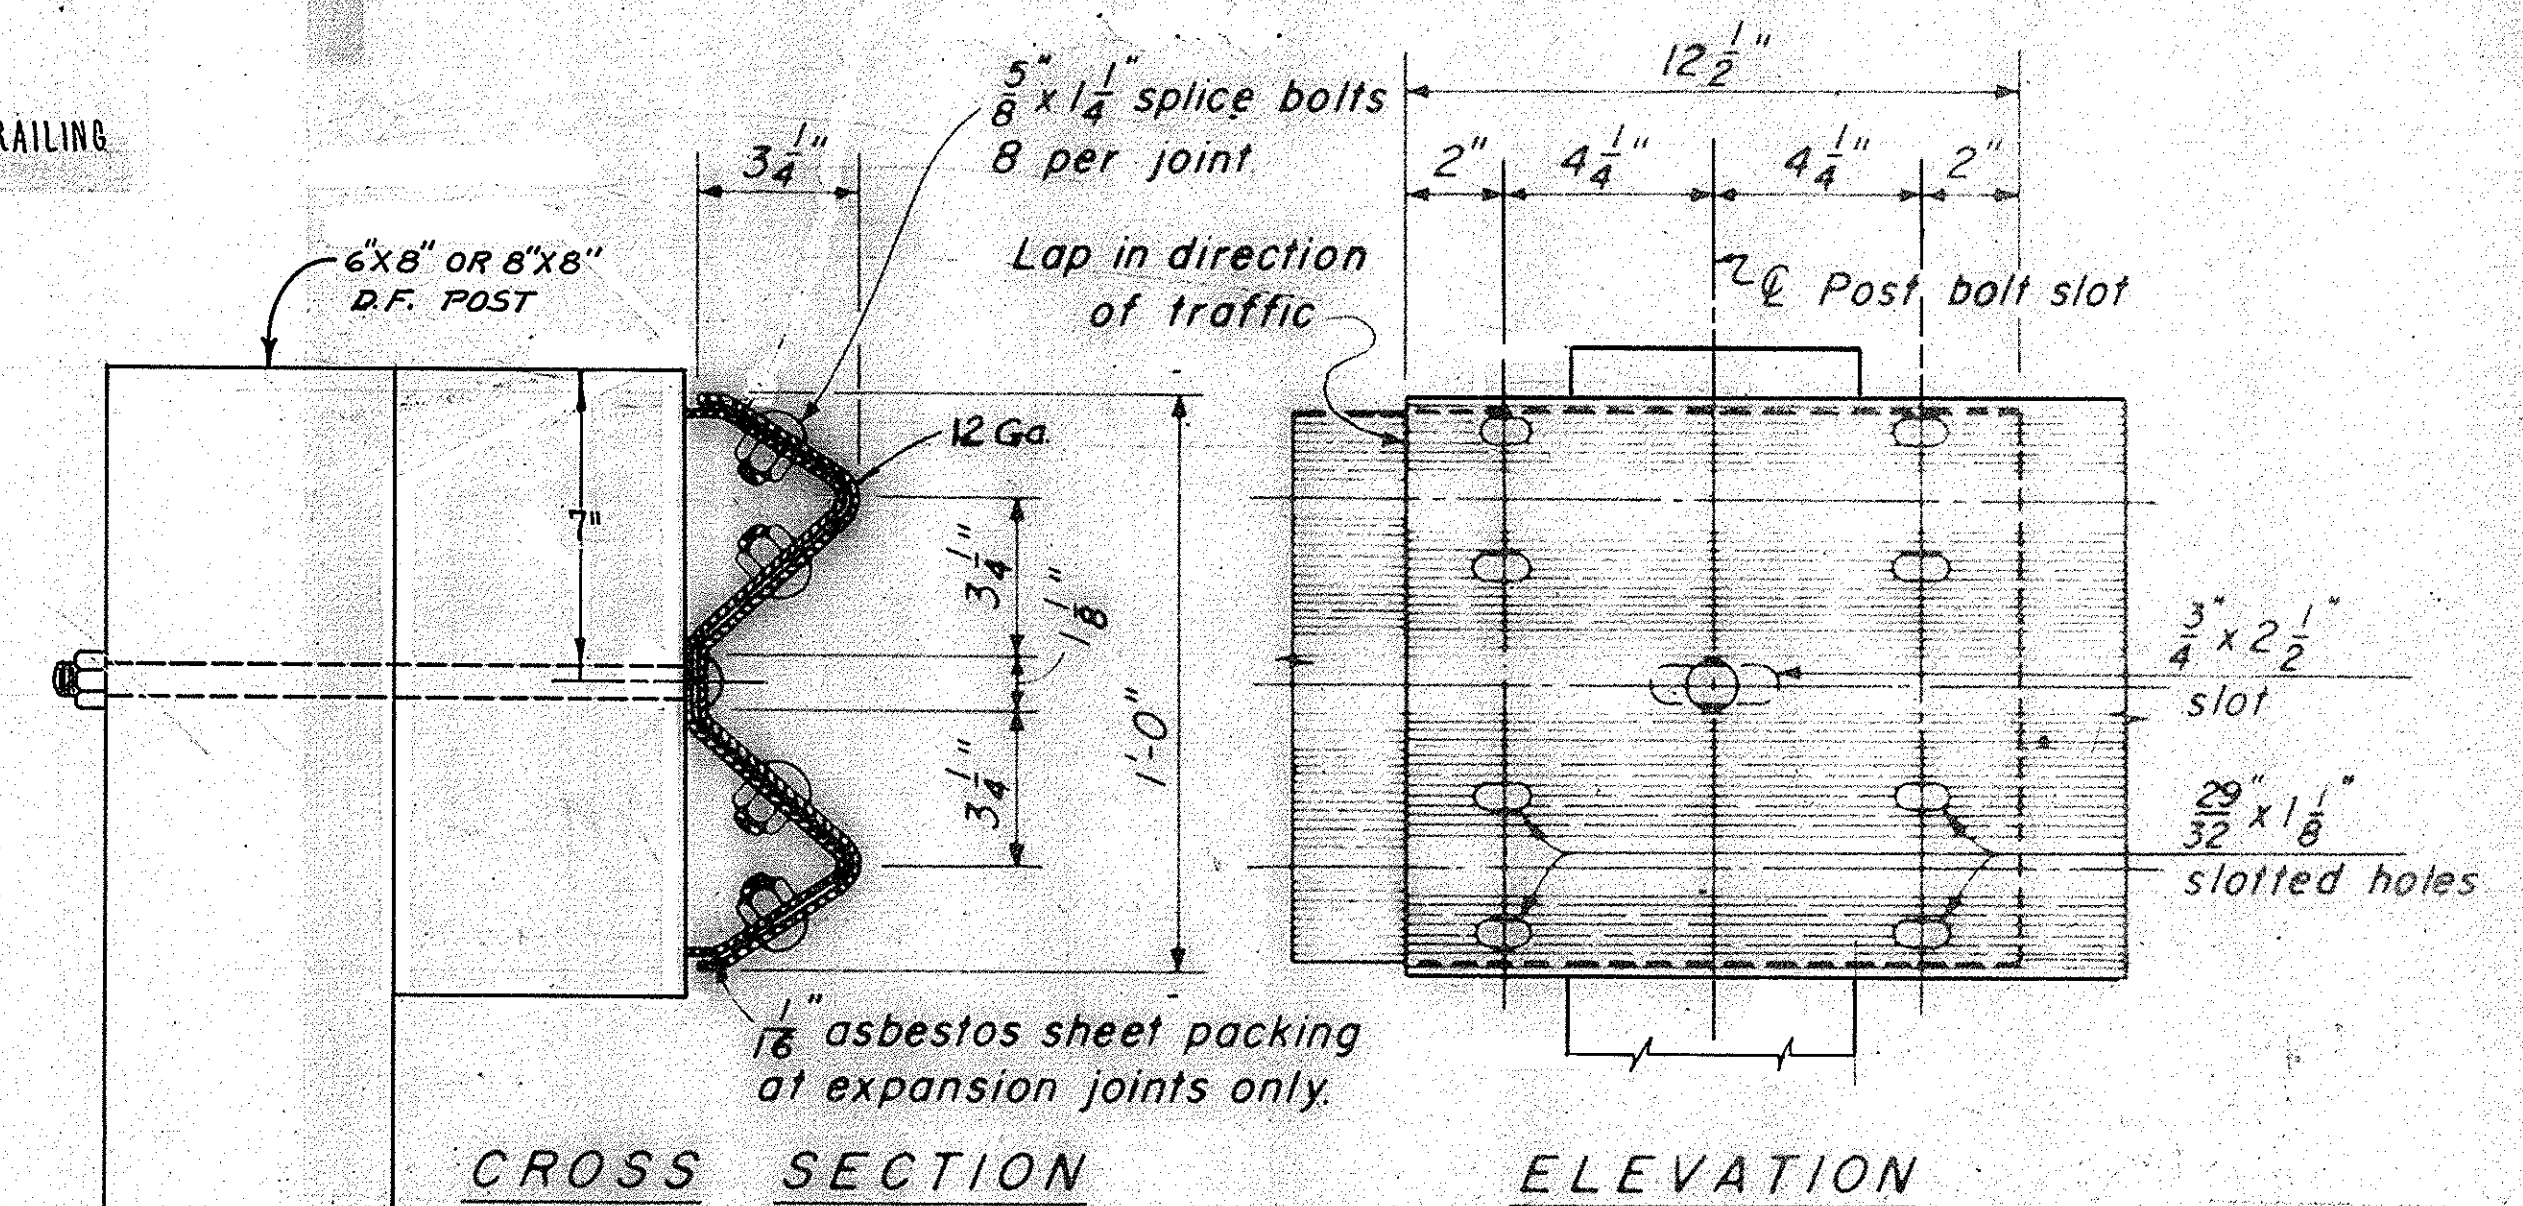
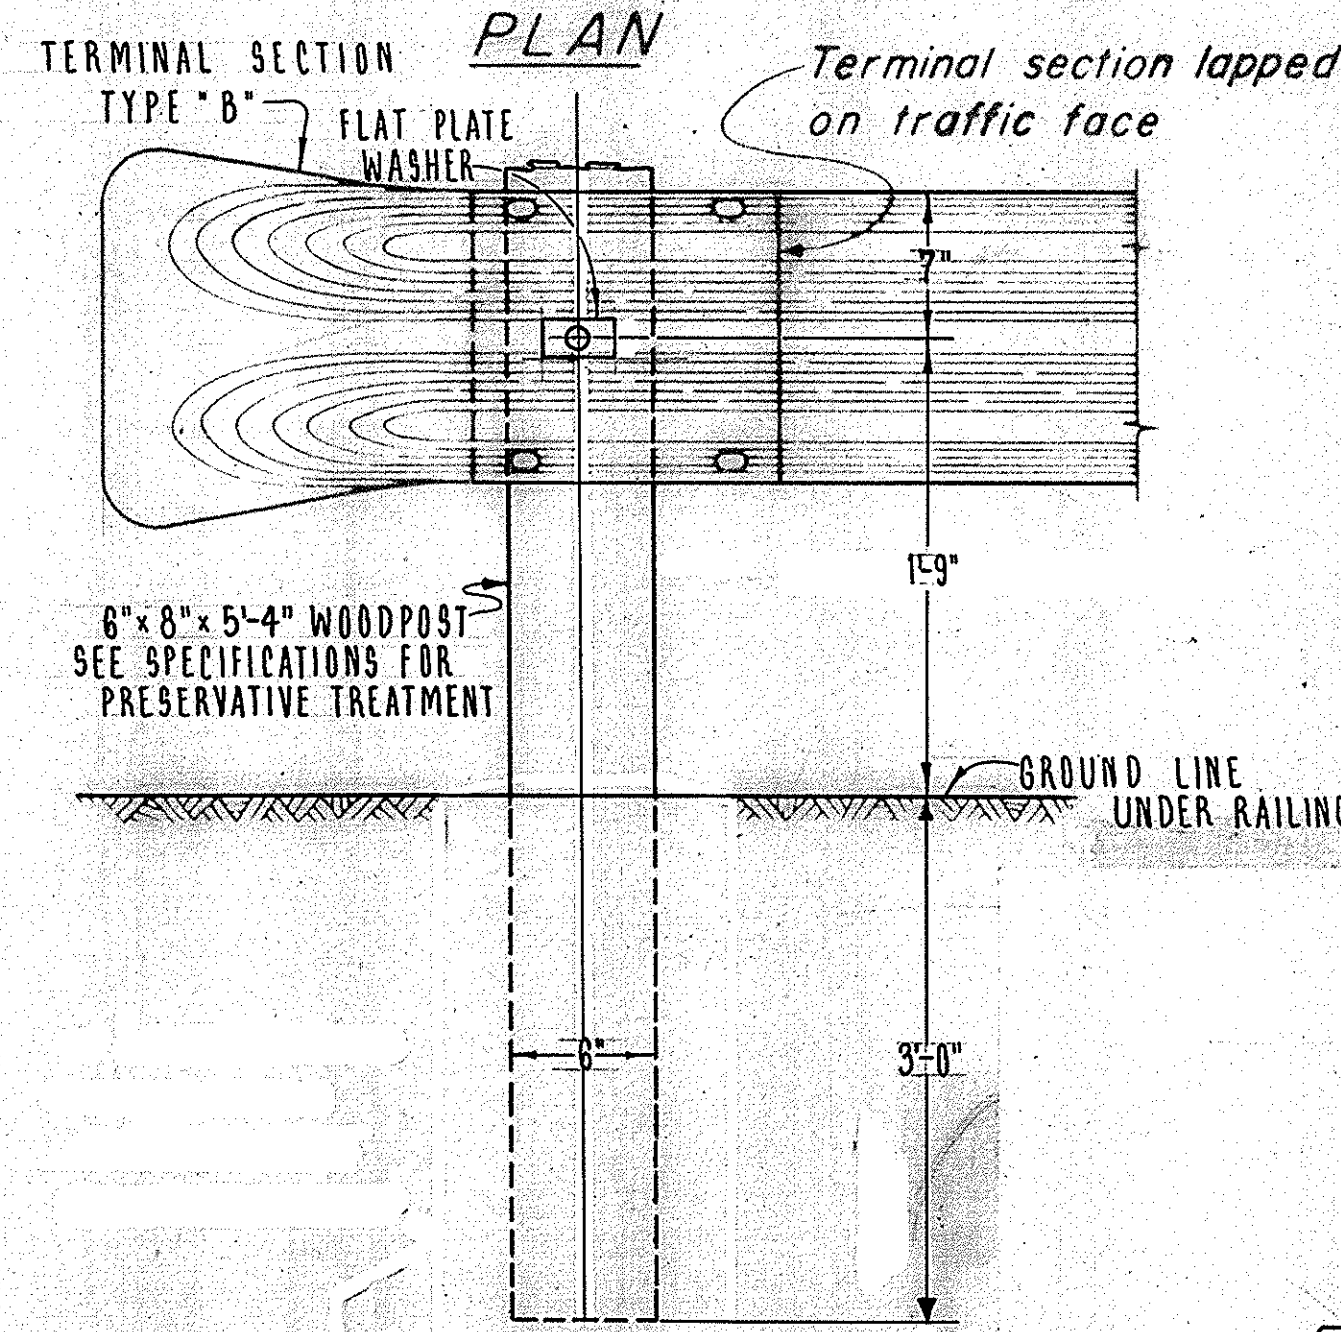


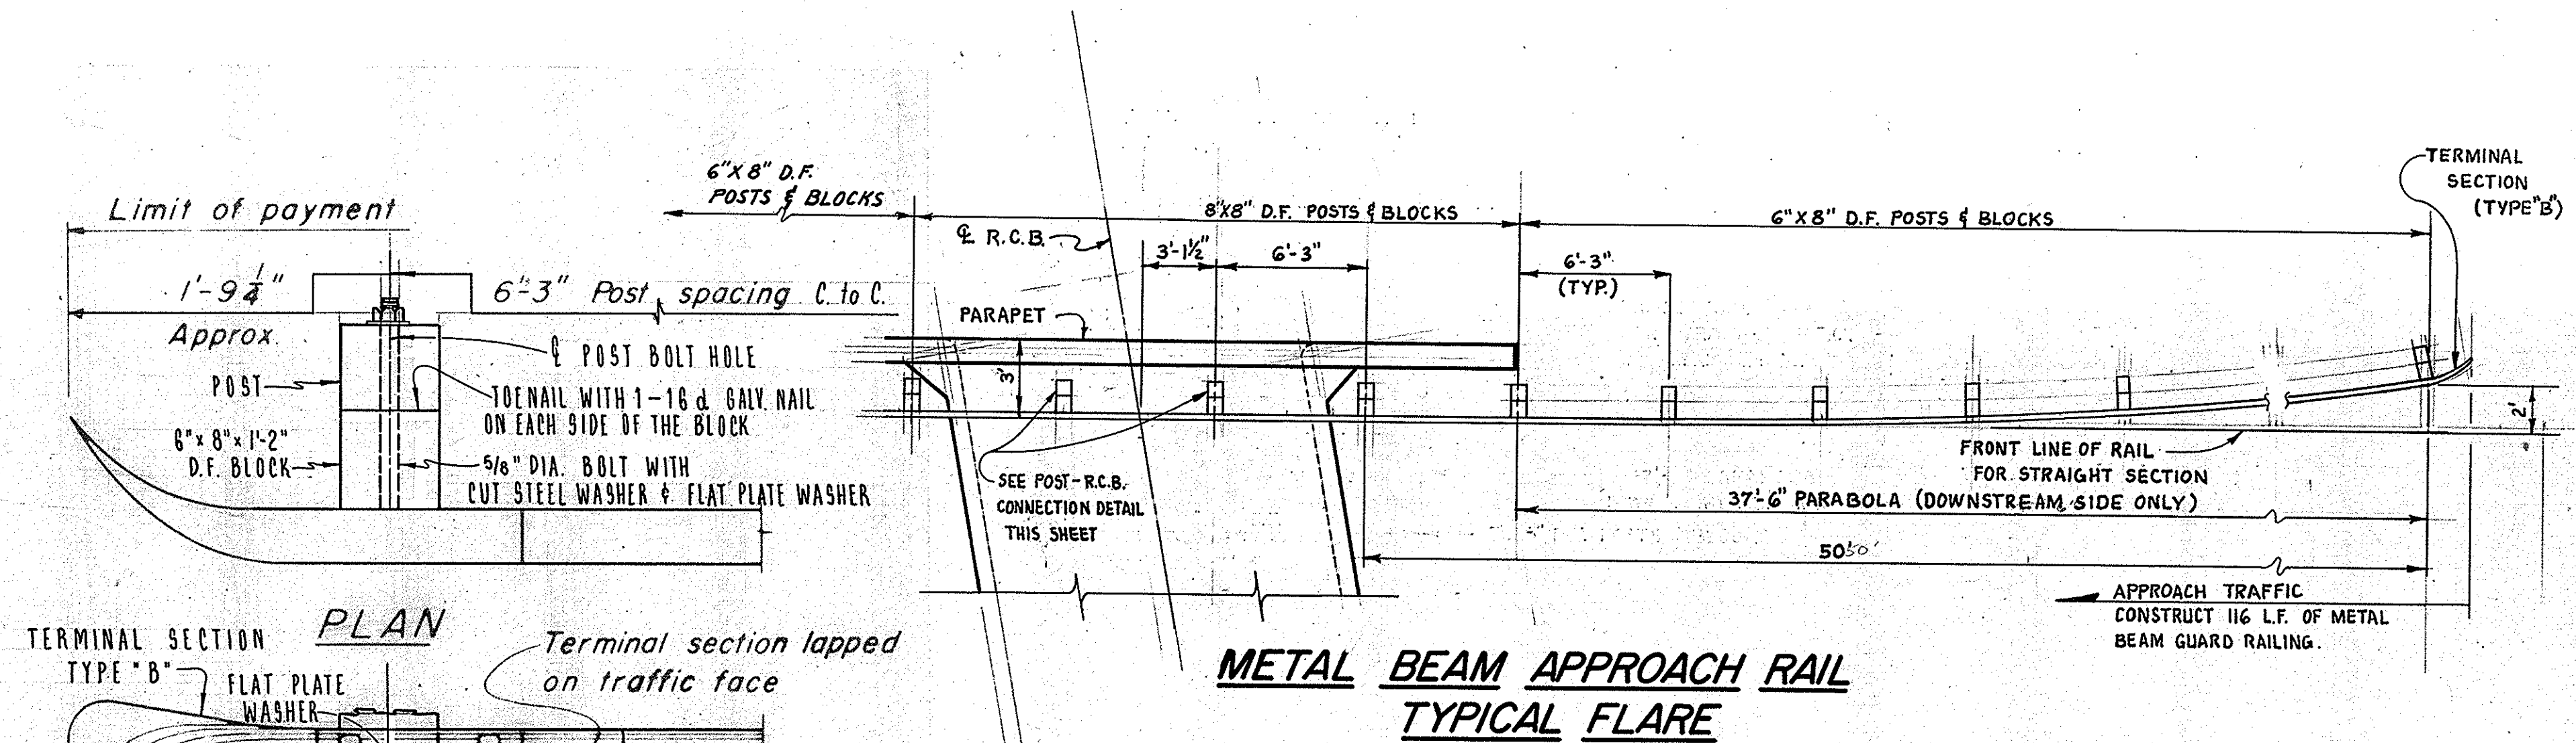

NOTES FOR RAILING:

1. ALL BOLTS TO HAVE CUT WASHERS UNLESS OTHERWISE STATED.
2. PAINT ENTIRE UNIT WHITE.
3. ALTERNATIVE DETAILS FOR LIFTING THE PRECAST CONCRETE PANELS OF THE TEMPORARY RAILING TYPE K MAY BE SUBMITTED BY THE CONTRACTOR FOR THE ENGINEERS APPROVAL.
4. *4" @ 18" MAY BE REPLACED BY WELDED WIRE FABRIC OR EQUIVALENT CROSS SECTIONAL AREA.

**TEMPORARY RAILING
TYPE K**

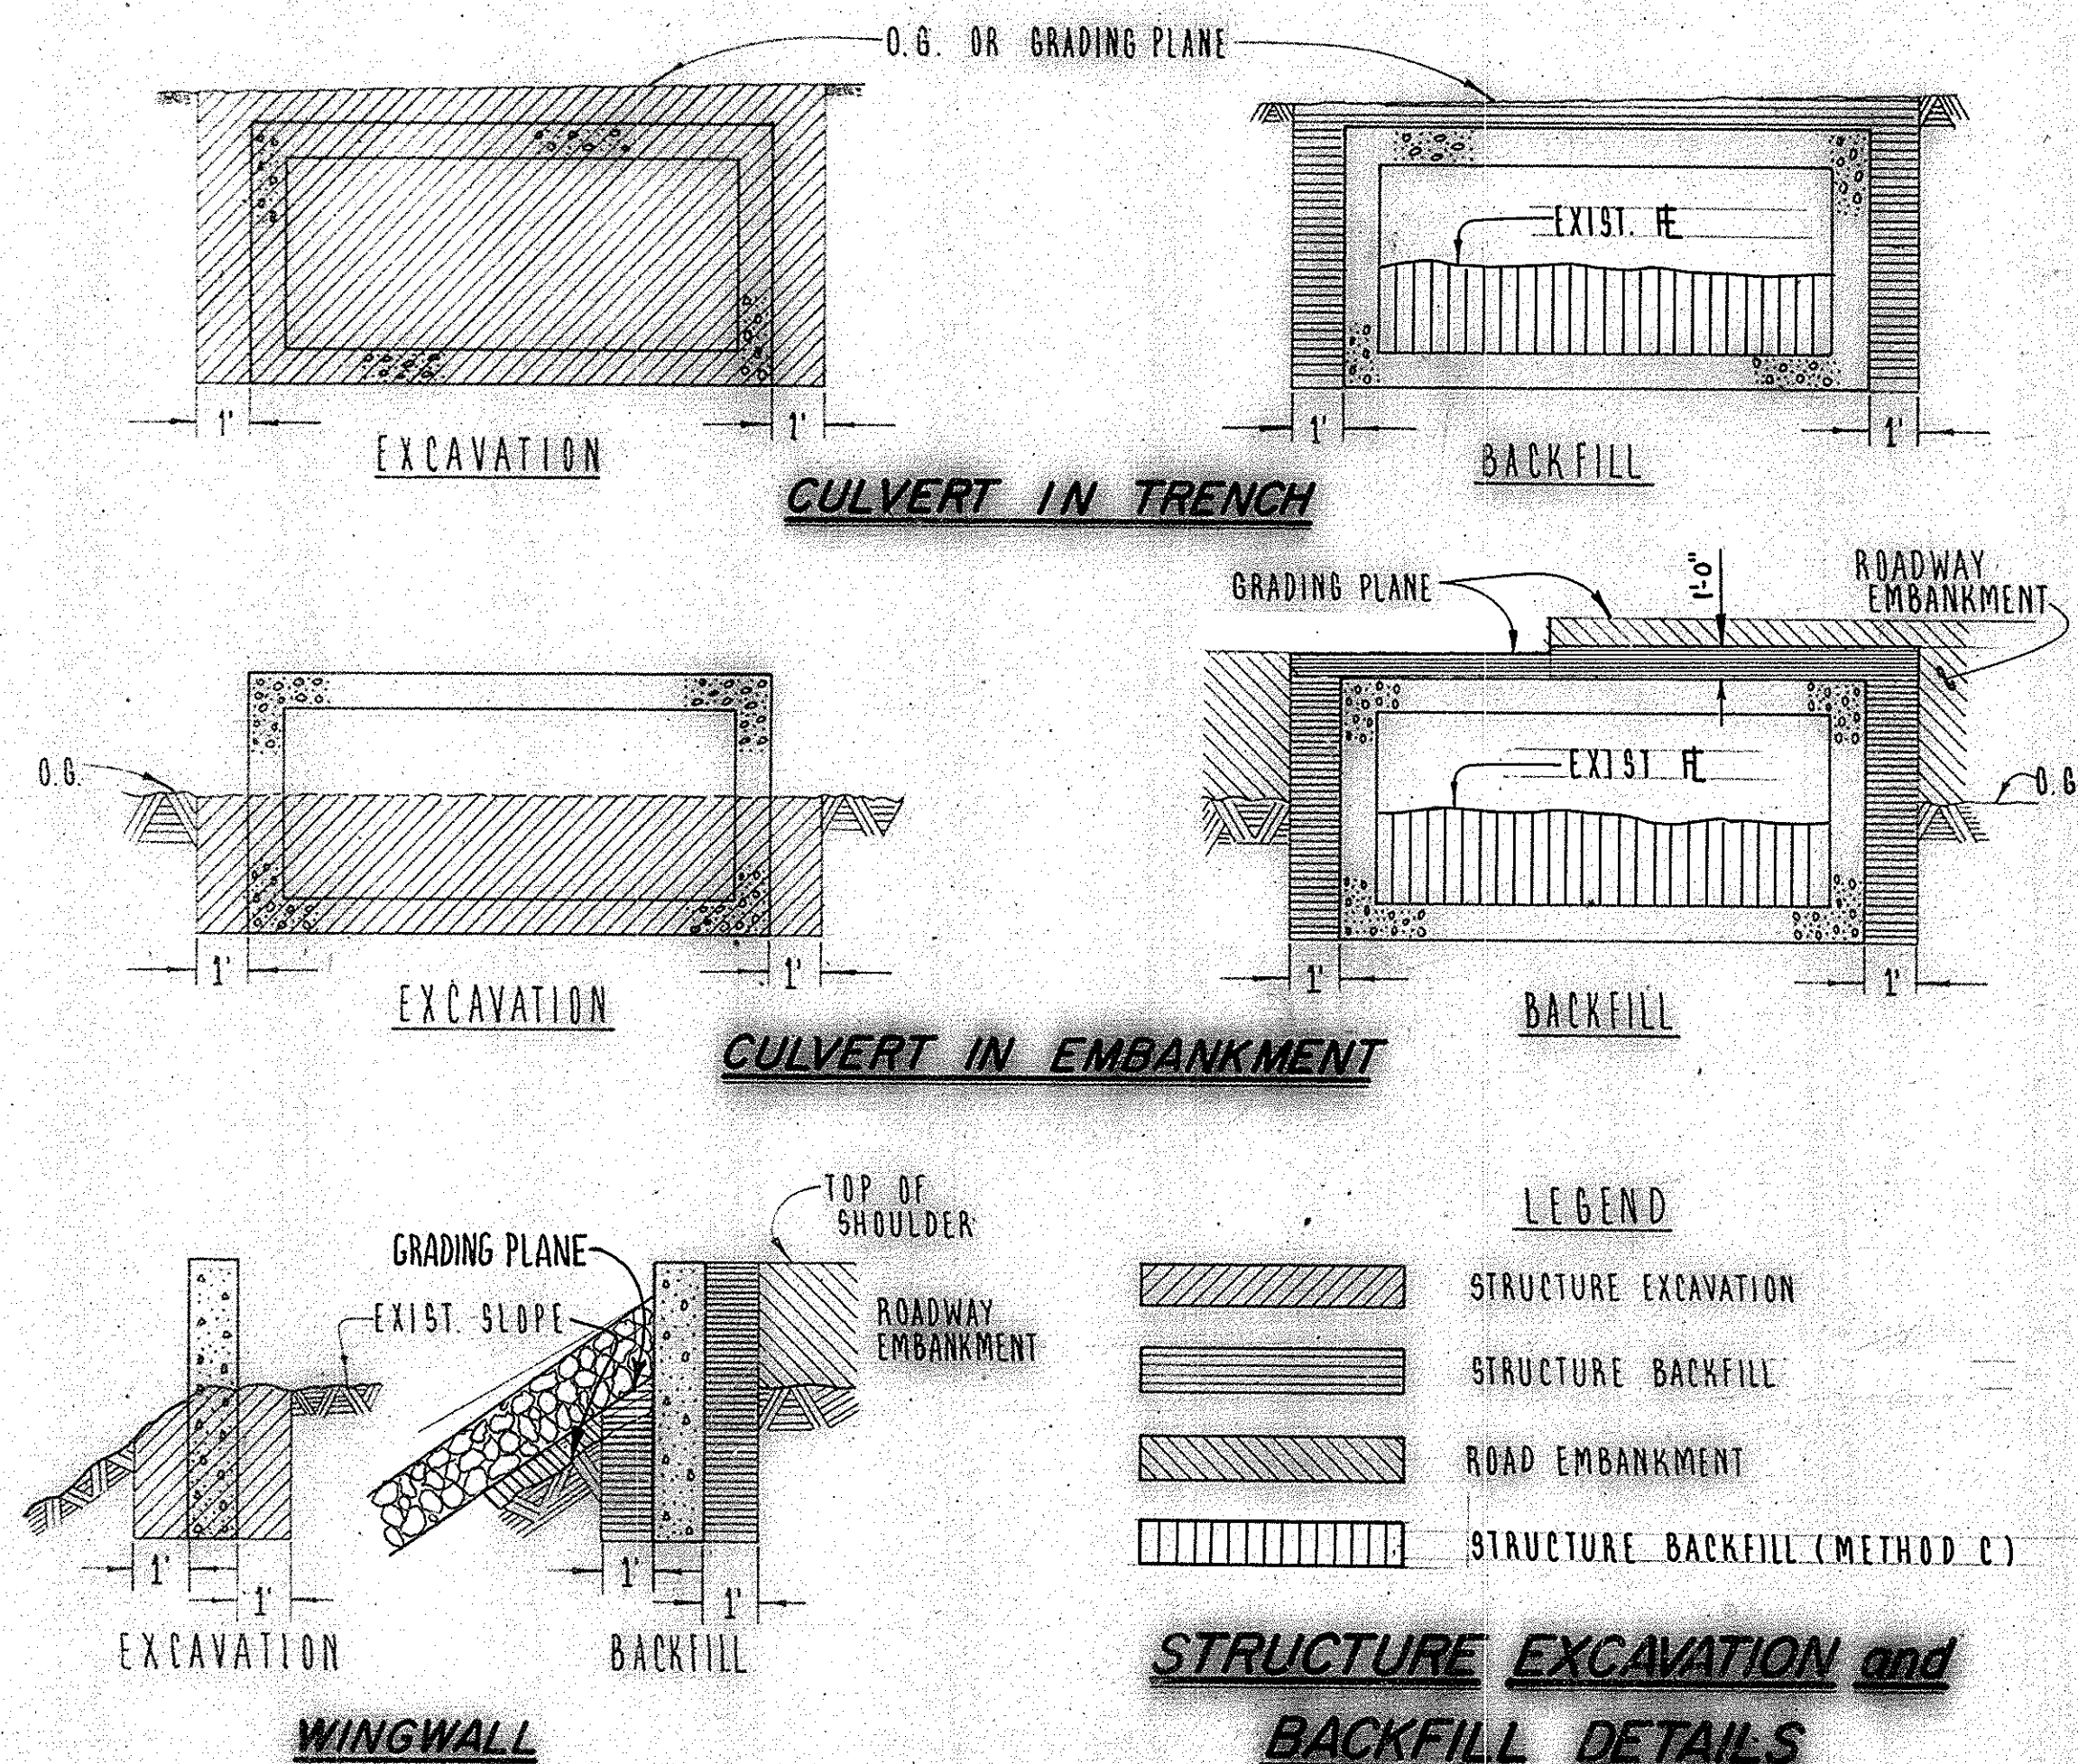

METAL BEAM GUARD RAIL DETAILS

FOR DETAILS NOT SHOWN SEE
CALTRANS STD. PLAN A77-C.8W

ORANGE COUNTY ENVIRONMENTAL MANAGEMENT AGENCY			
PLANO TRABUCO ROAD BRIDGE S-III REPLACEMENT AT PAVEMENT END			
MISCELLANEOUS DETAILS			
VS. 1-10-77 AS BUILT	DATE	DESCRIPTION	PREPARED UNDER SUPERVISION OF
DESIGNED	S. VANDER MEY	SCALE	DATE
DRAWN	P.S.	CHECKED	J.R.J.
AS SHOWN			DWG. NO.
			4/6