
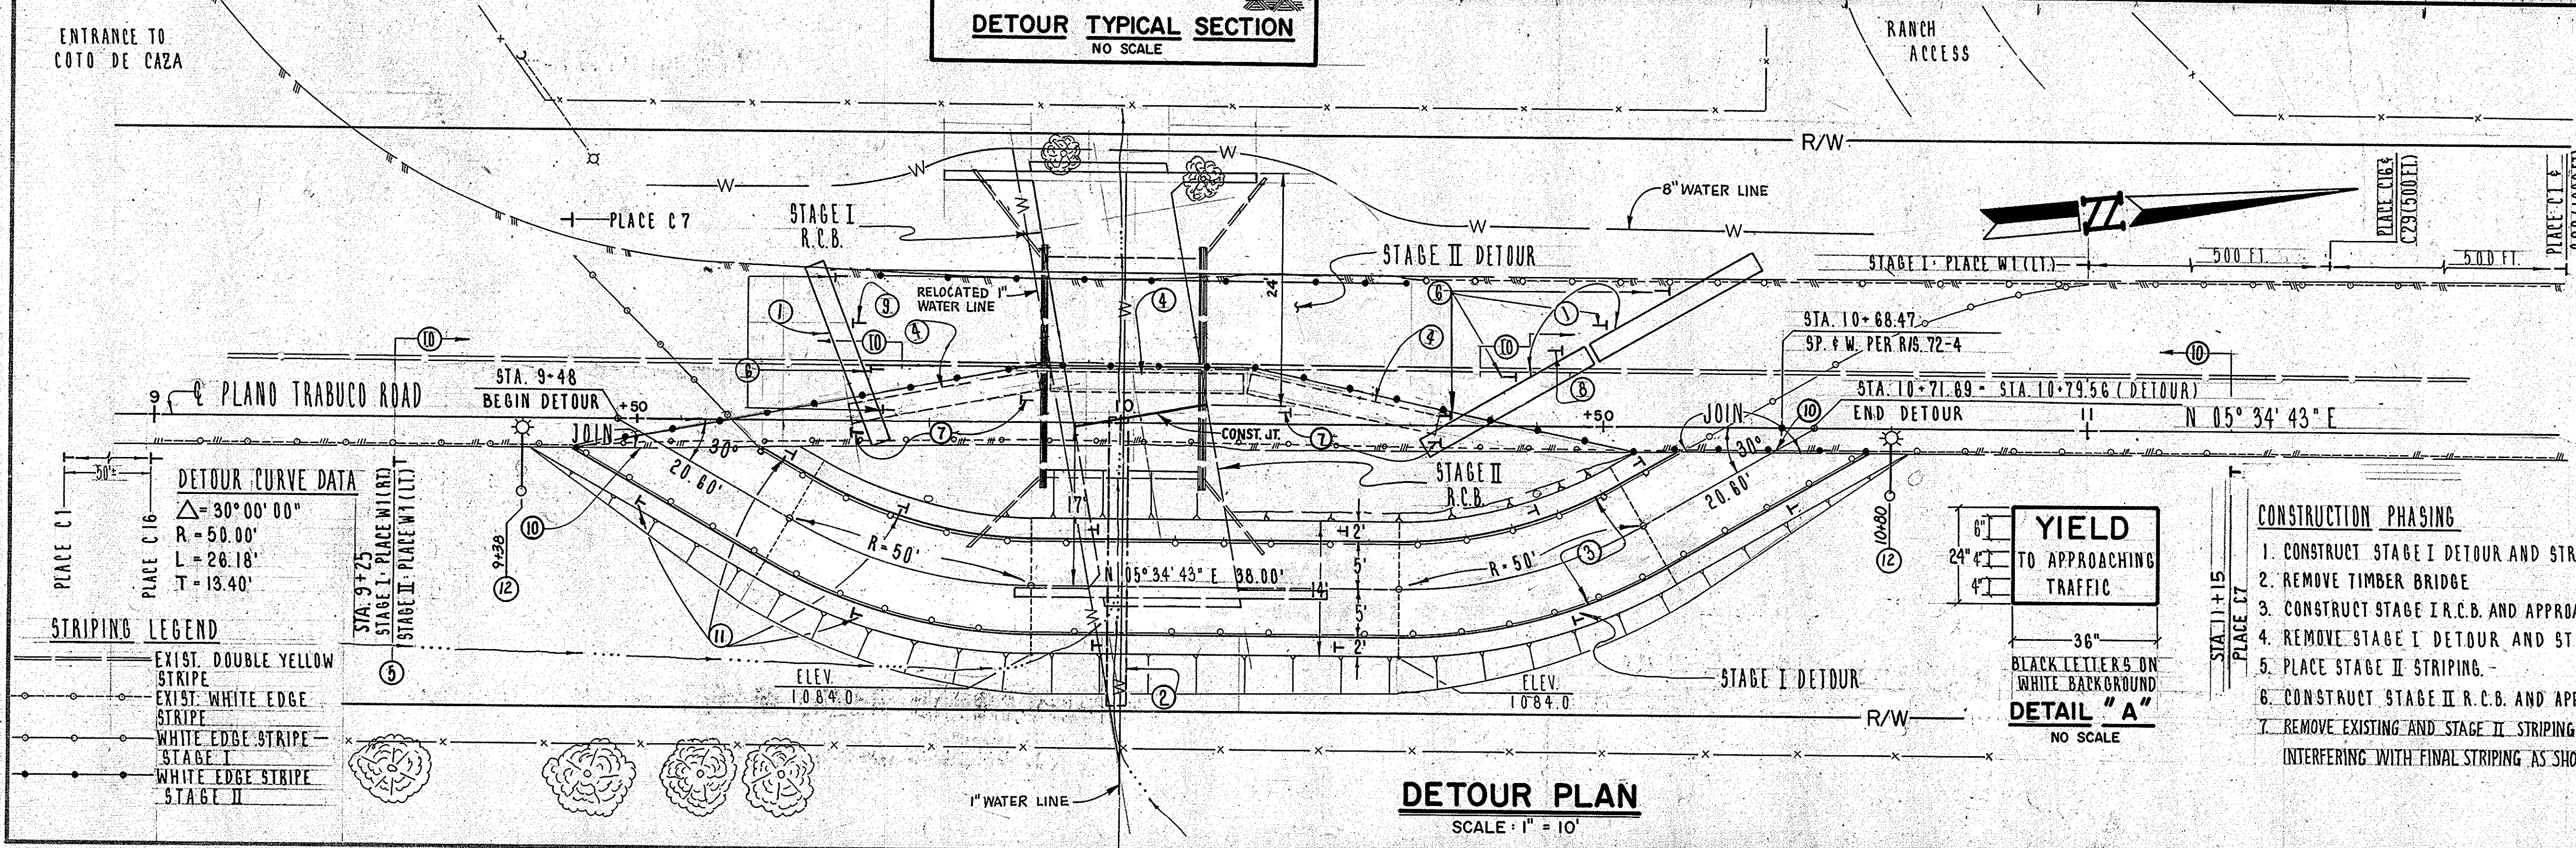


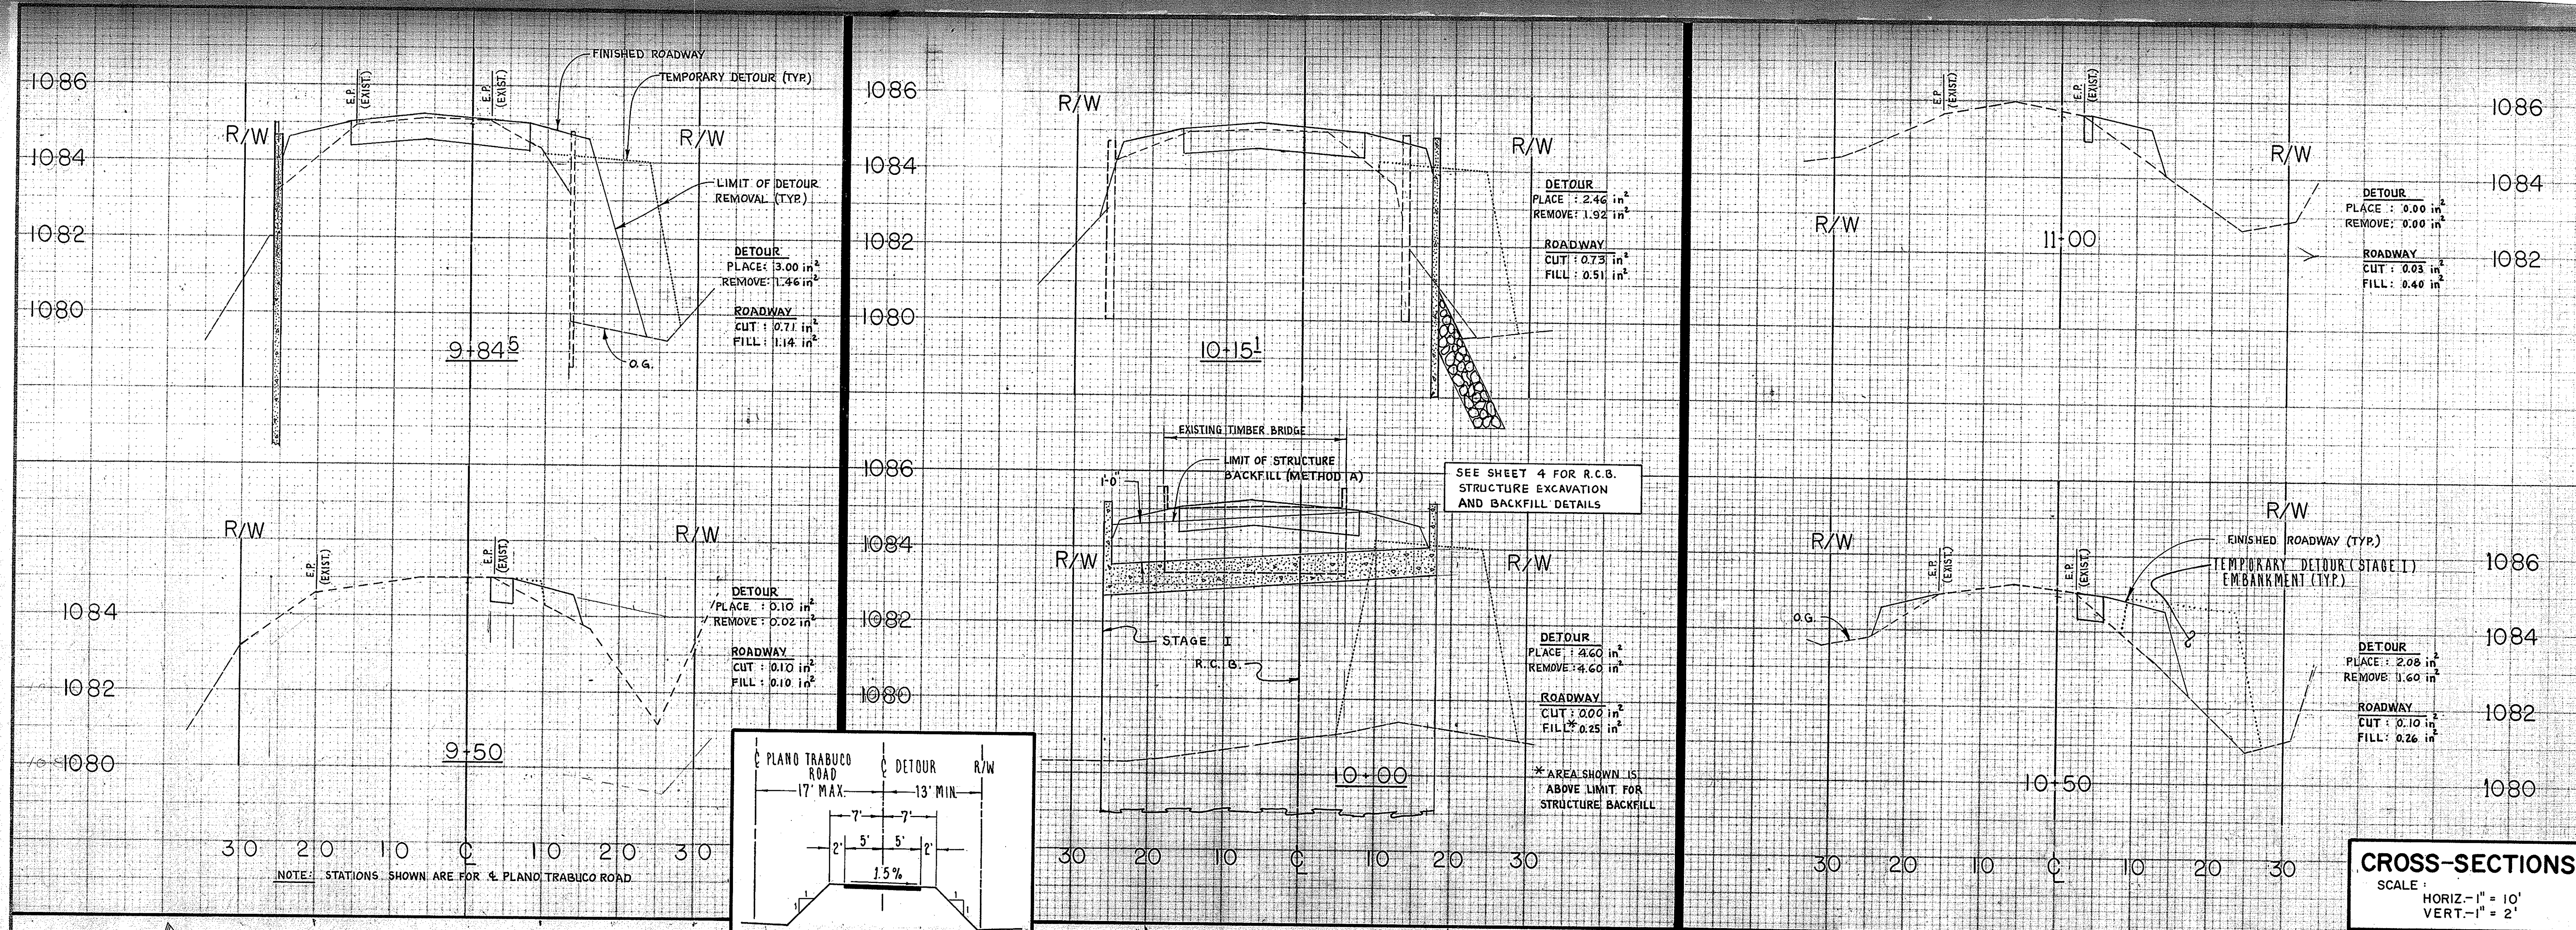

ORANGE COUNTY ENVIRONMENTAL MANAGEMENT AGENCY

PLANO TRABUCO ROAD BRIDGE S-III REPLACEMENT AT PAVEMENT END

DETOUR: PLAN & CROSS SECTIONS

V.S. 7-10-24 AS BUILT

MARK DATE DESCRIPTION

REVISIONS

DESIGNED S. VANDER MEY SCALE DATE DWG. NO.

DRAWN P.J.S. CHECKED J.R.U. AS SHOWN

SHEET 5/6