



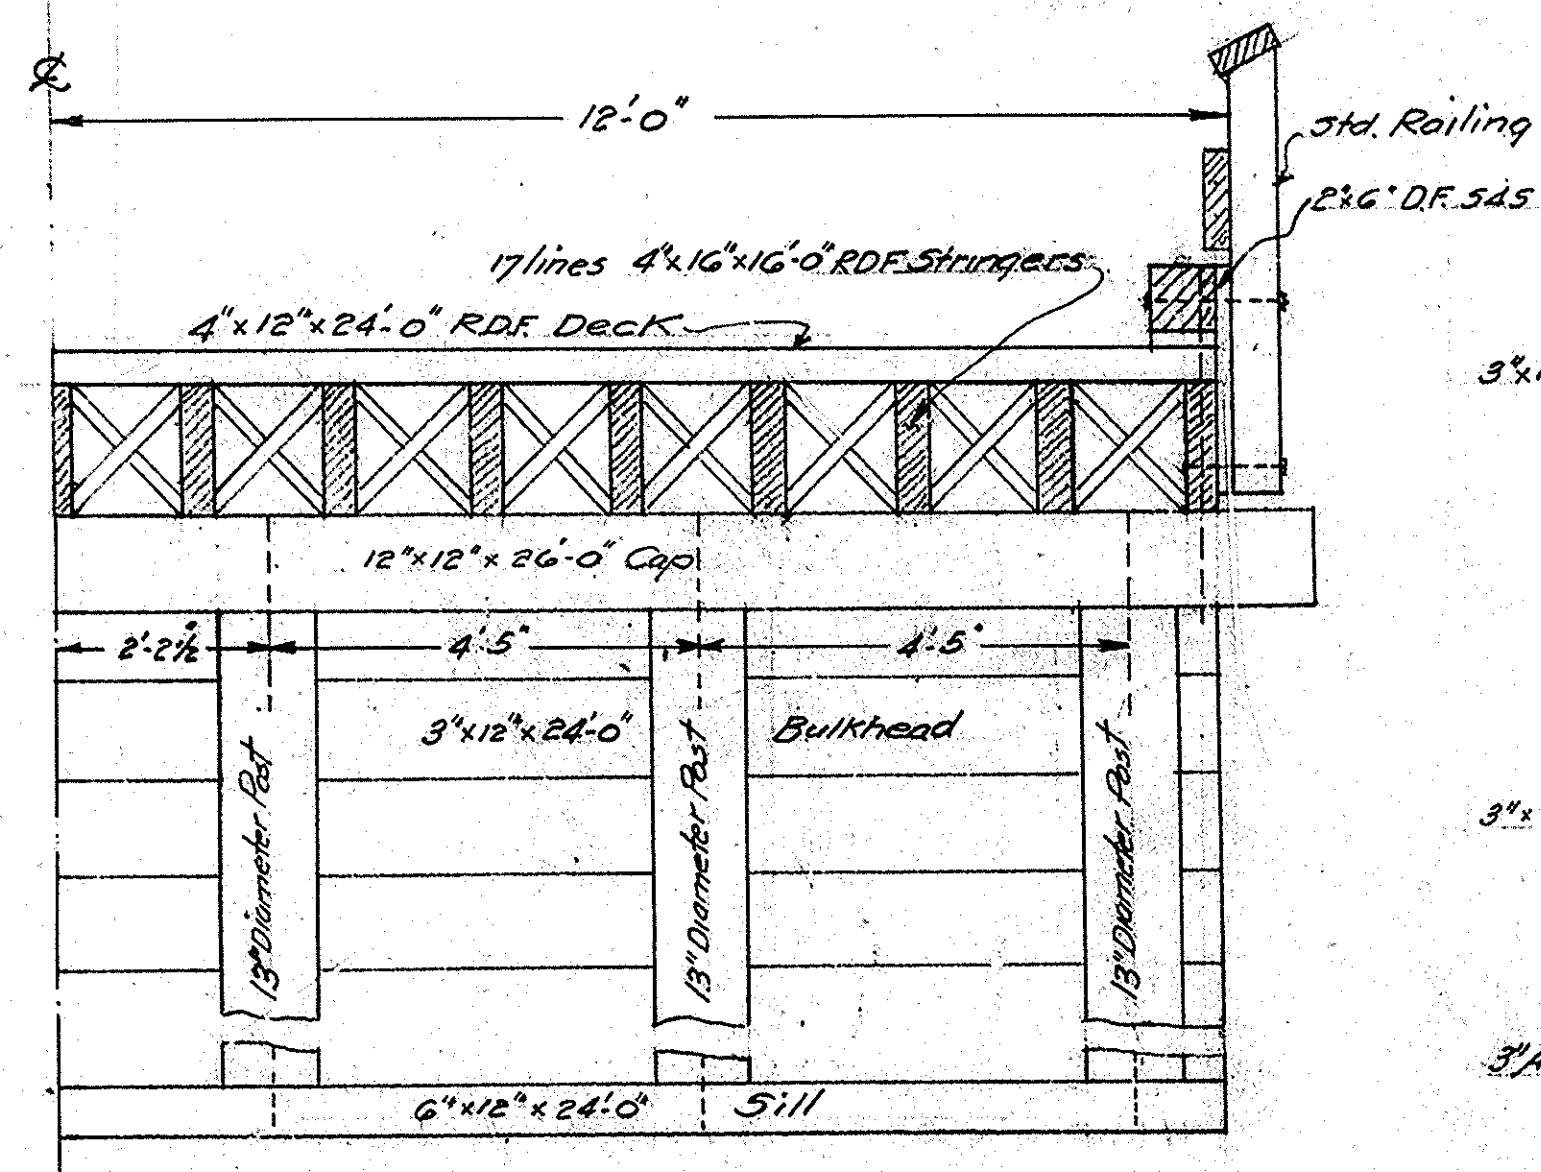


1/2 CROSS SECTION
Scale 1/2" = 1'

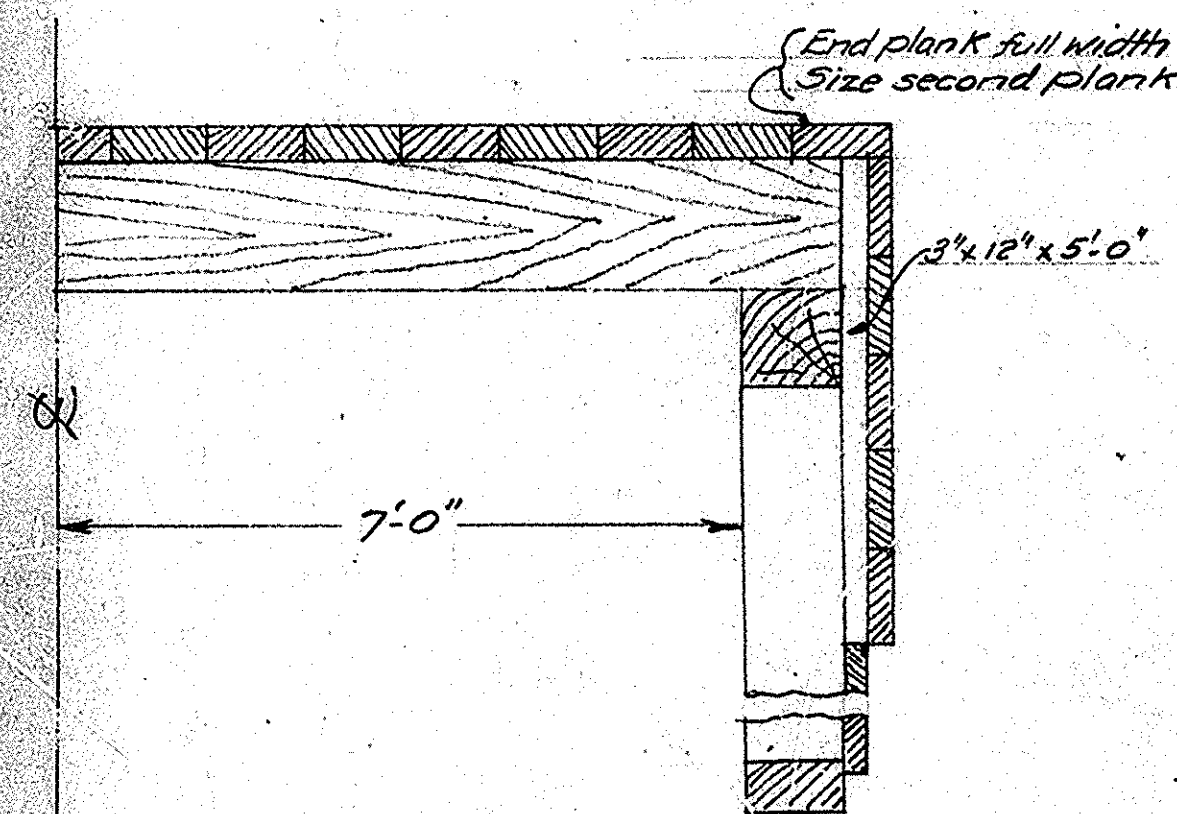


BULKHEAD SECTION
Scale 1/2" = 1'

NOTE

Piers, Sills, Caps, Bulkheads, and Air Space Cleats
to be Structural Grade Douglas Fir, Rough
Joists to be select Structural Stringer Grade Douglas Fir S.I.E.
Bridging to be No. 1 Common Douglas Fir, Rough
Deck to be Douglas Fir
All the above to be creosoted, 8% empty cell treatment
Wheel guards, Rails and Rail posts to be select Structural
grade Douglas Fir S.I.E.

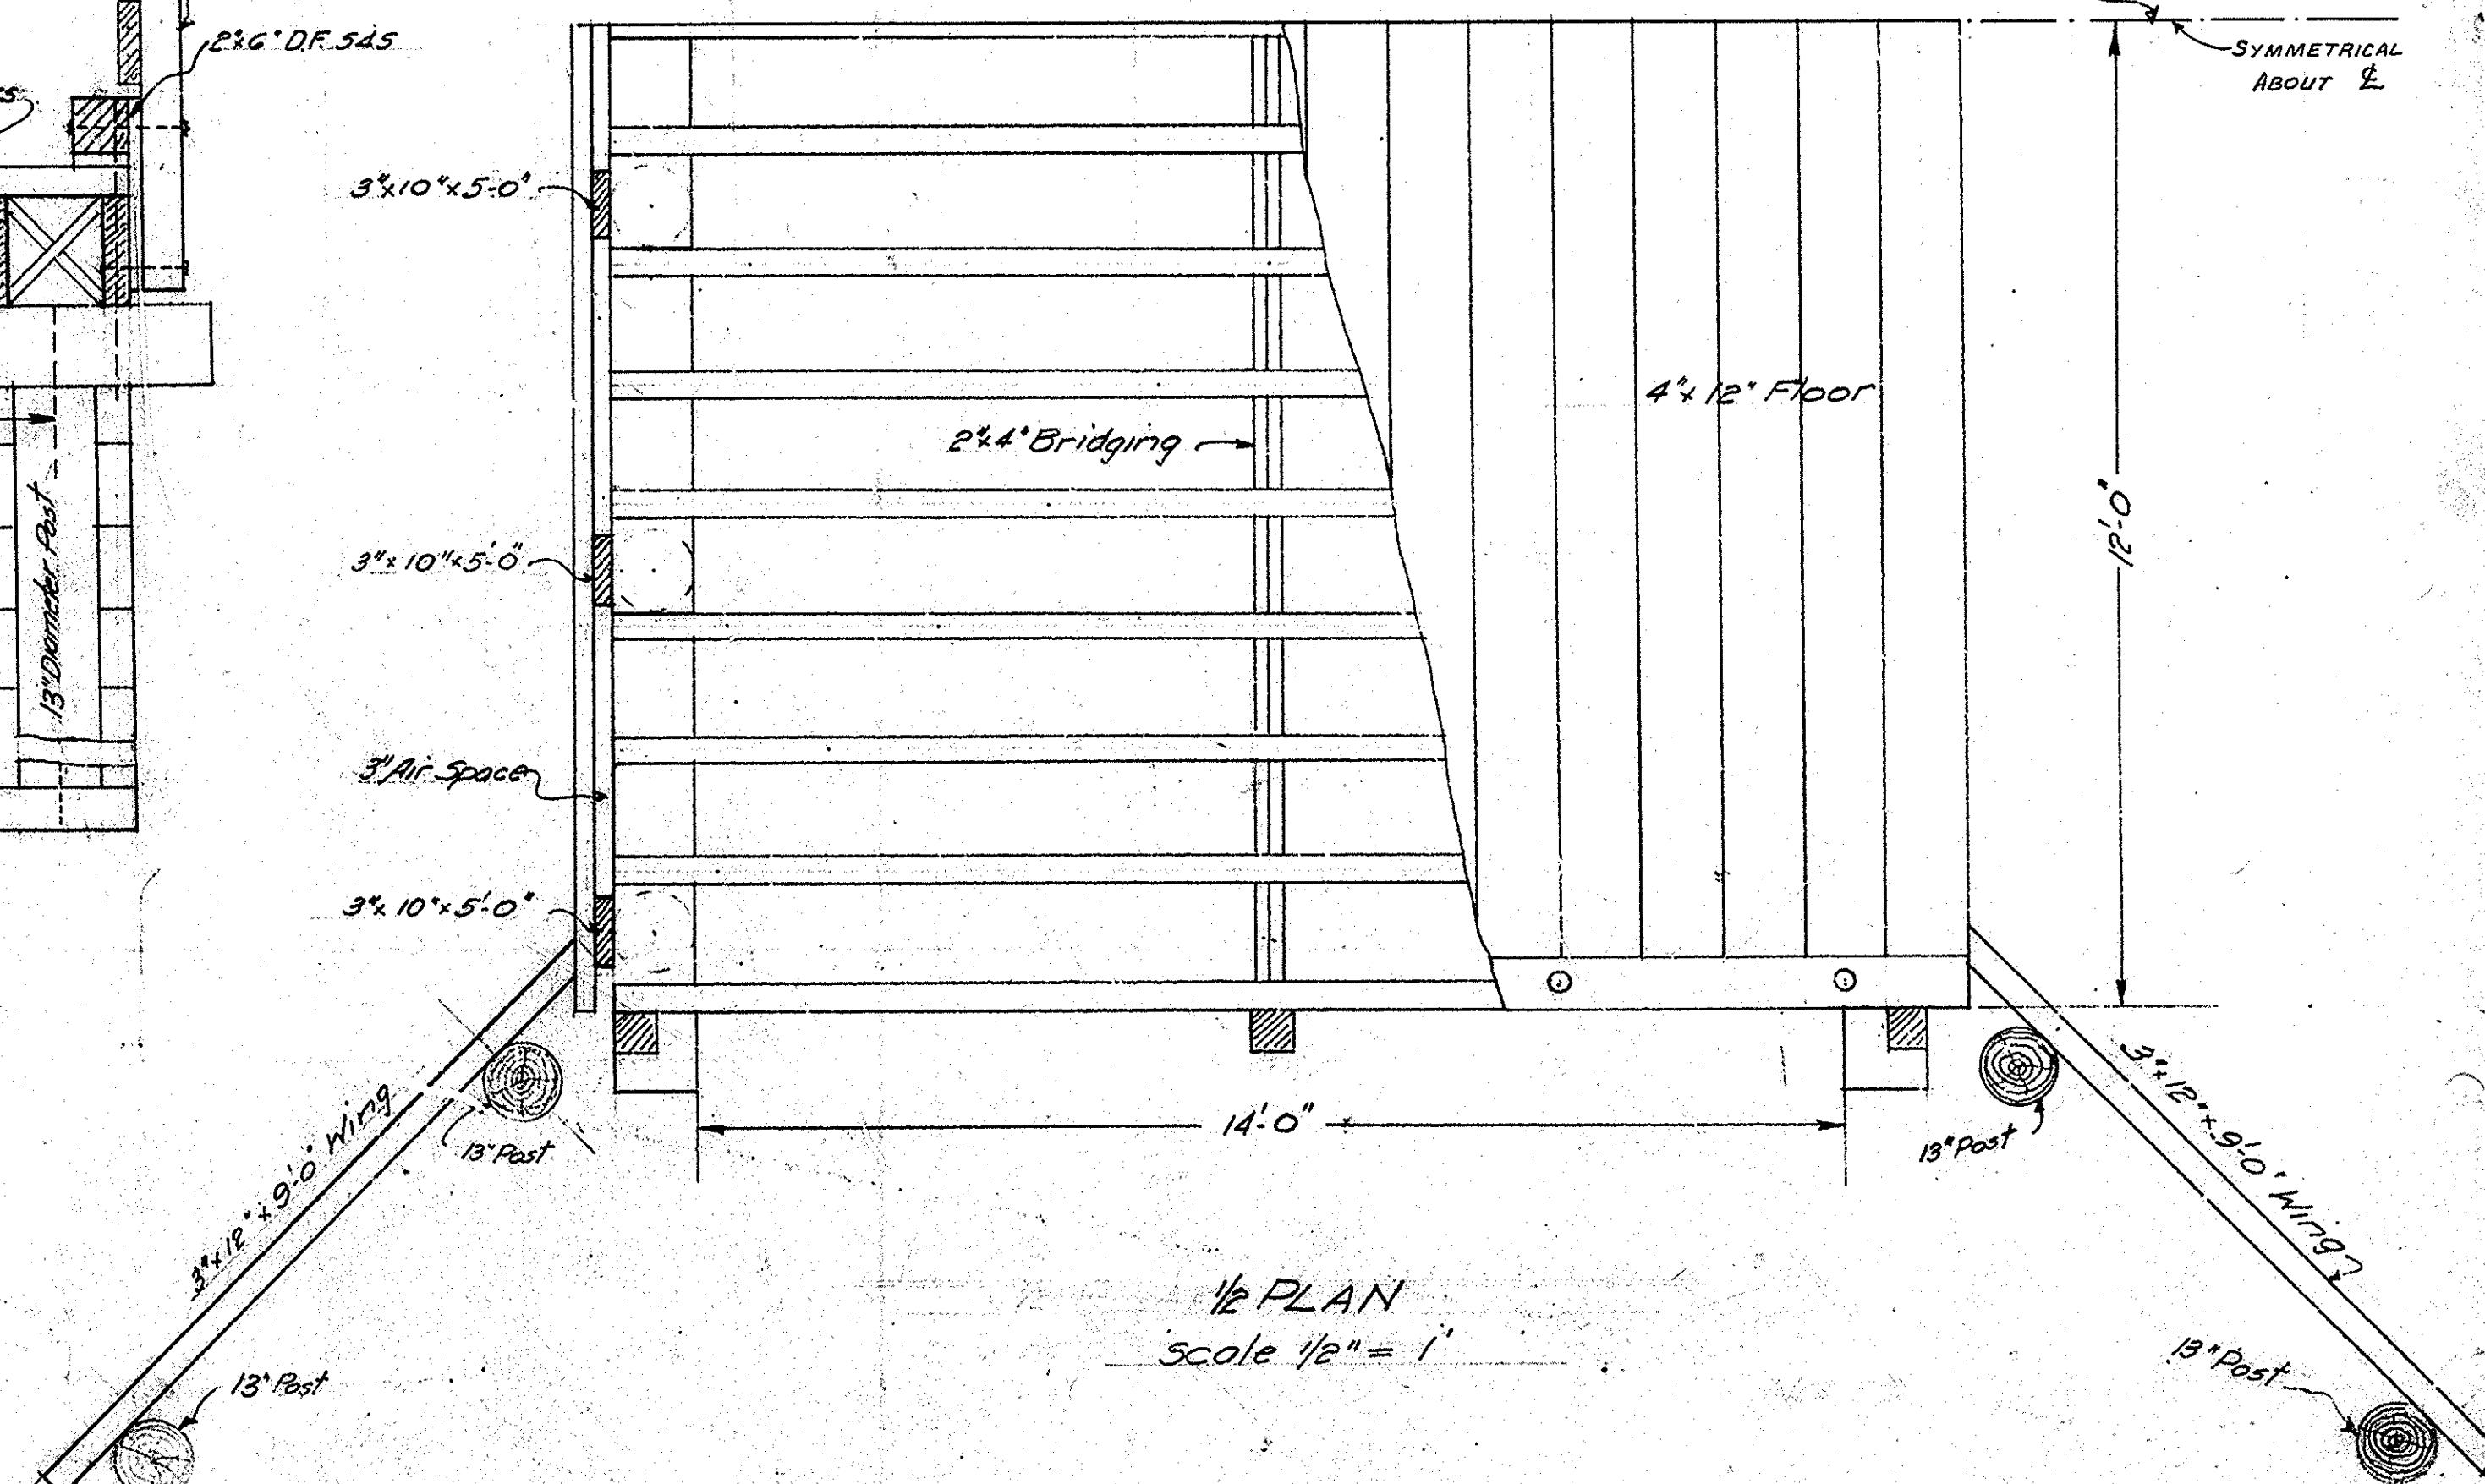

1/2 PLAN
Scale 1/2" = 1'

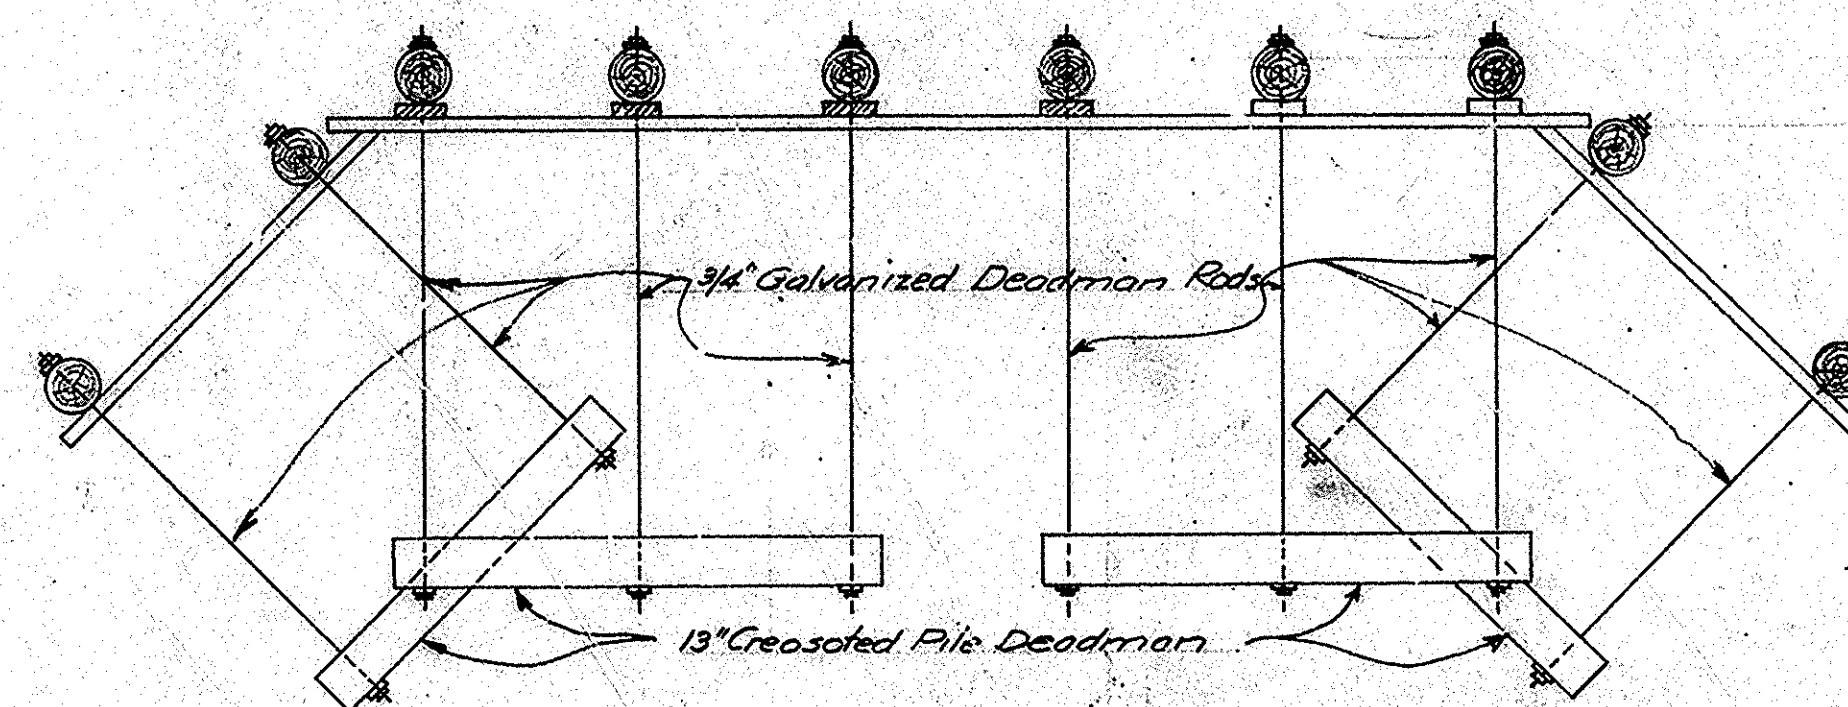

BULKHEAD AND WINGWALL ANCHORAGE
Scale 1/4" = 1'

Culvert #8-111
Wooden Culvert
Trabuco Canyon Rd.
Sheet 1 of 1
Red: 22.5' Scale as shown
Yellow

ORANGE COUNTY ROAD DEPARTMENT
WOODEN CULVERT
TRABUCO CANYON ROAD

SCALES AS SHOWN NOVEMBER 1961

STRUCTURE No. S-111
-(ORA-DOT-(H)-12-77-D10)

MICROFILMED
JUL 6 1960

SHEET 6/6

DR# 16 (12643)
PLANO TRABUCO RD BRIDGE S-111
@ PAVEMENT END 7/77