


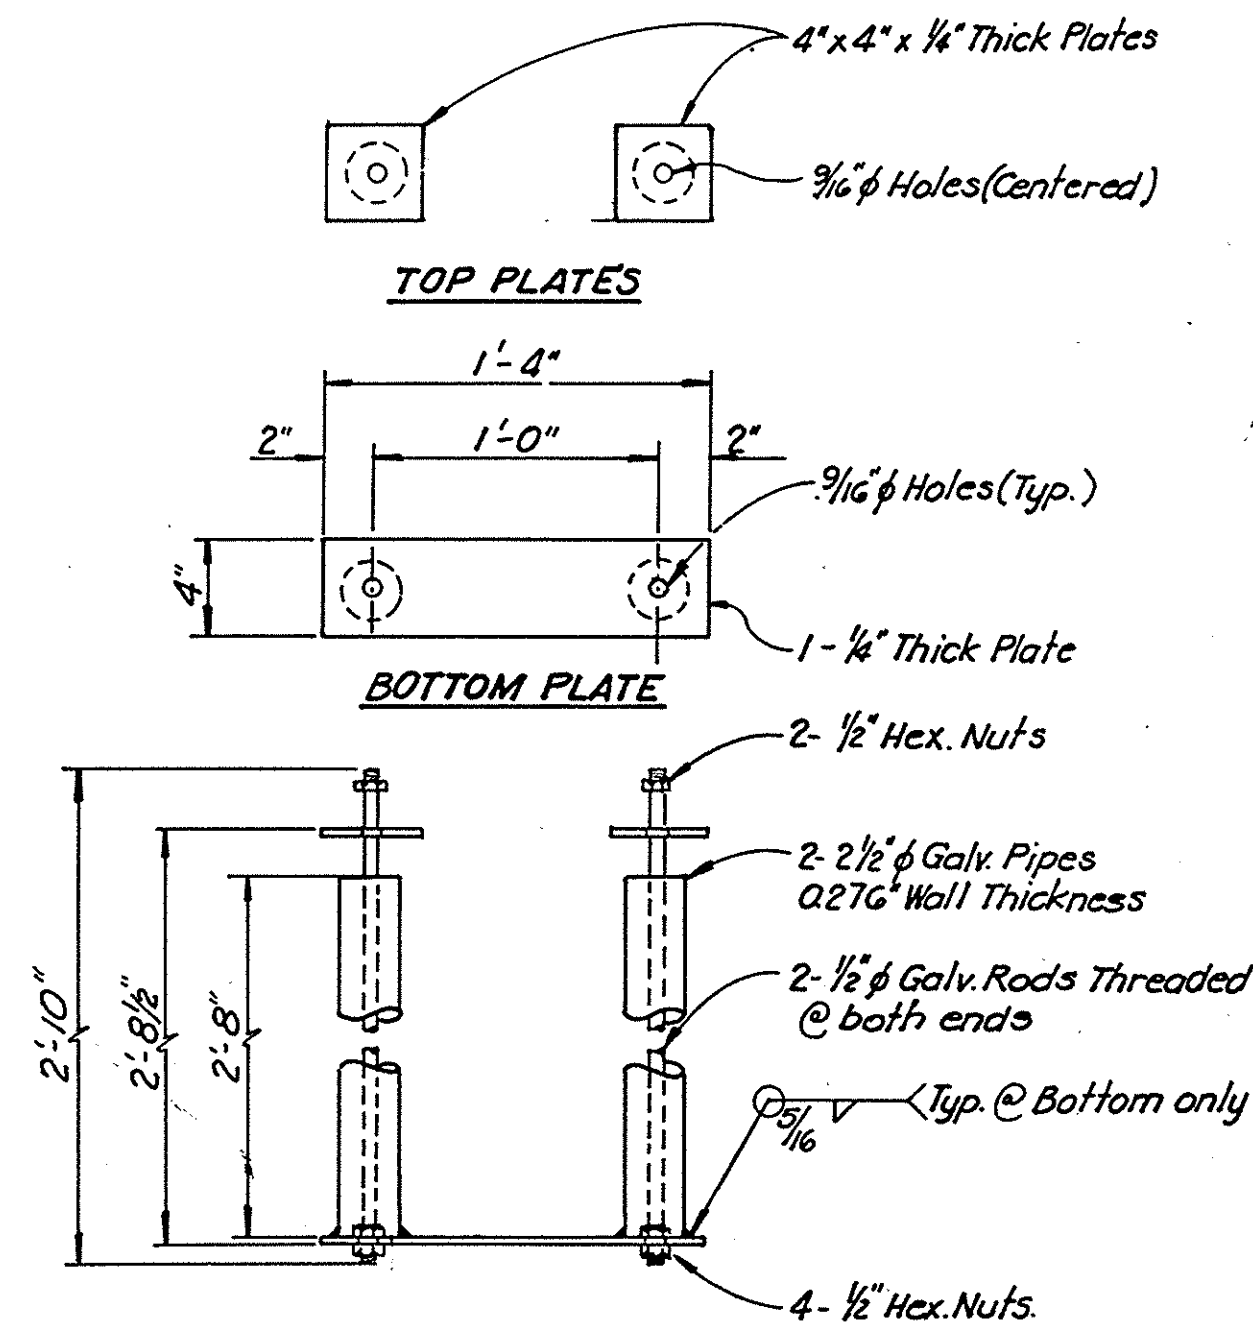

MARK	DATE	DESCRIPTION	PREPARED UNDER SUPERVISION OF	<i>Paul R. Young 4-12-91</i> PAUL R. YOUNG DATE		SHEET B8 OF 13
REVISIONS						
DESIGNED BY R. RESHAD			SCALE	DATE	DWG. NO.	
DRAWN J. SALDANA		CHECKED S. SHEIKH	AS SHOWN			

DR. 14 (16108)