

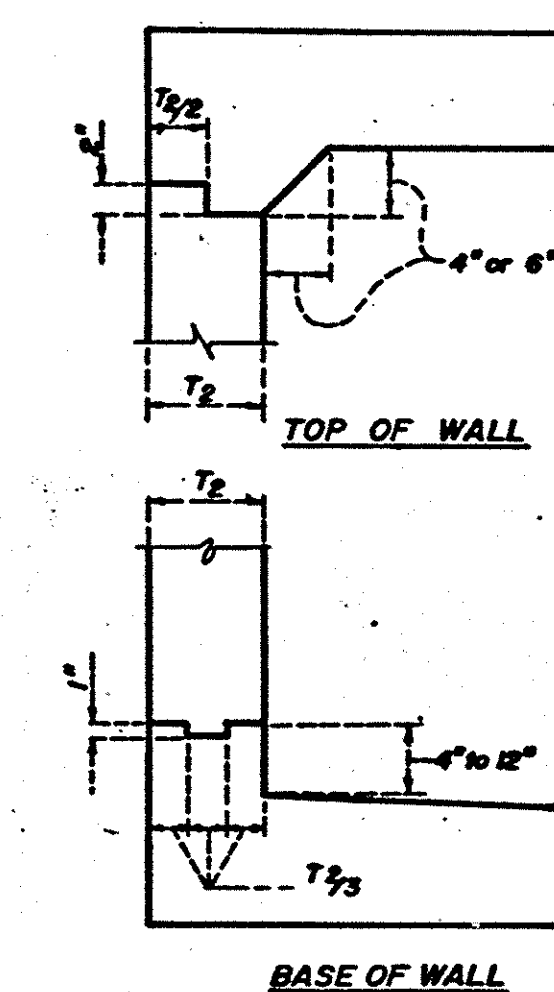


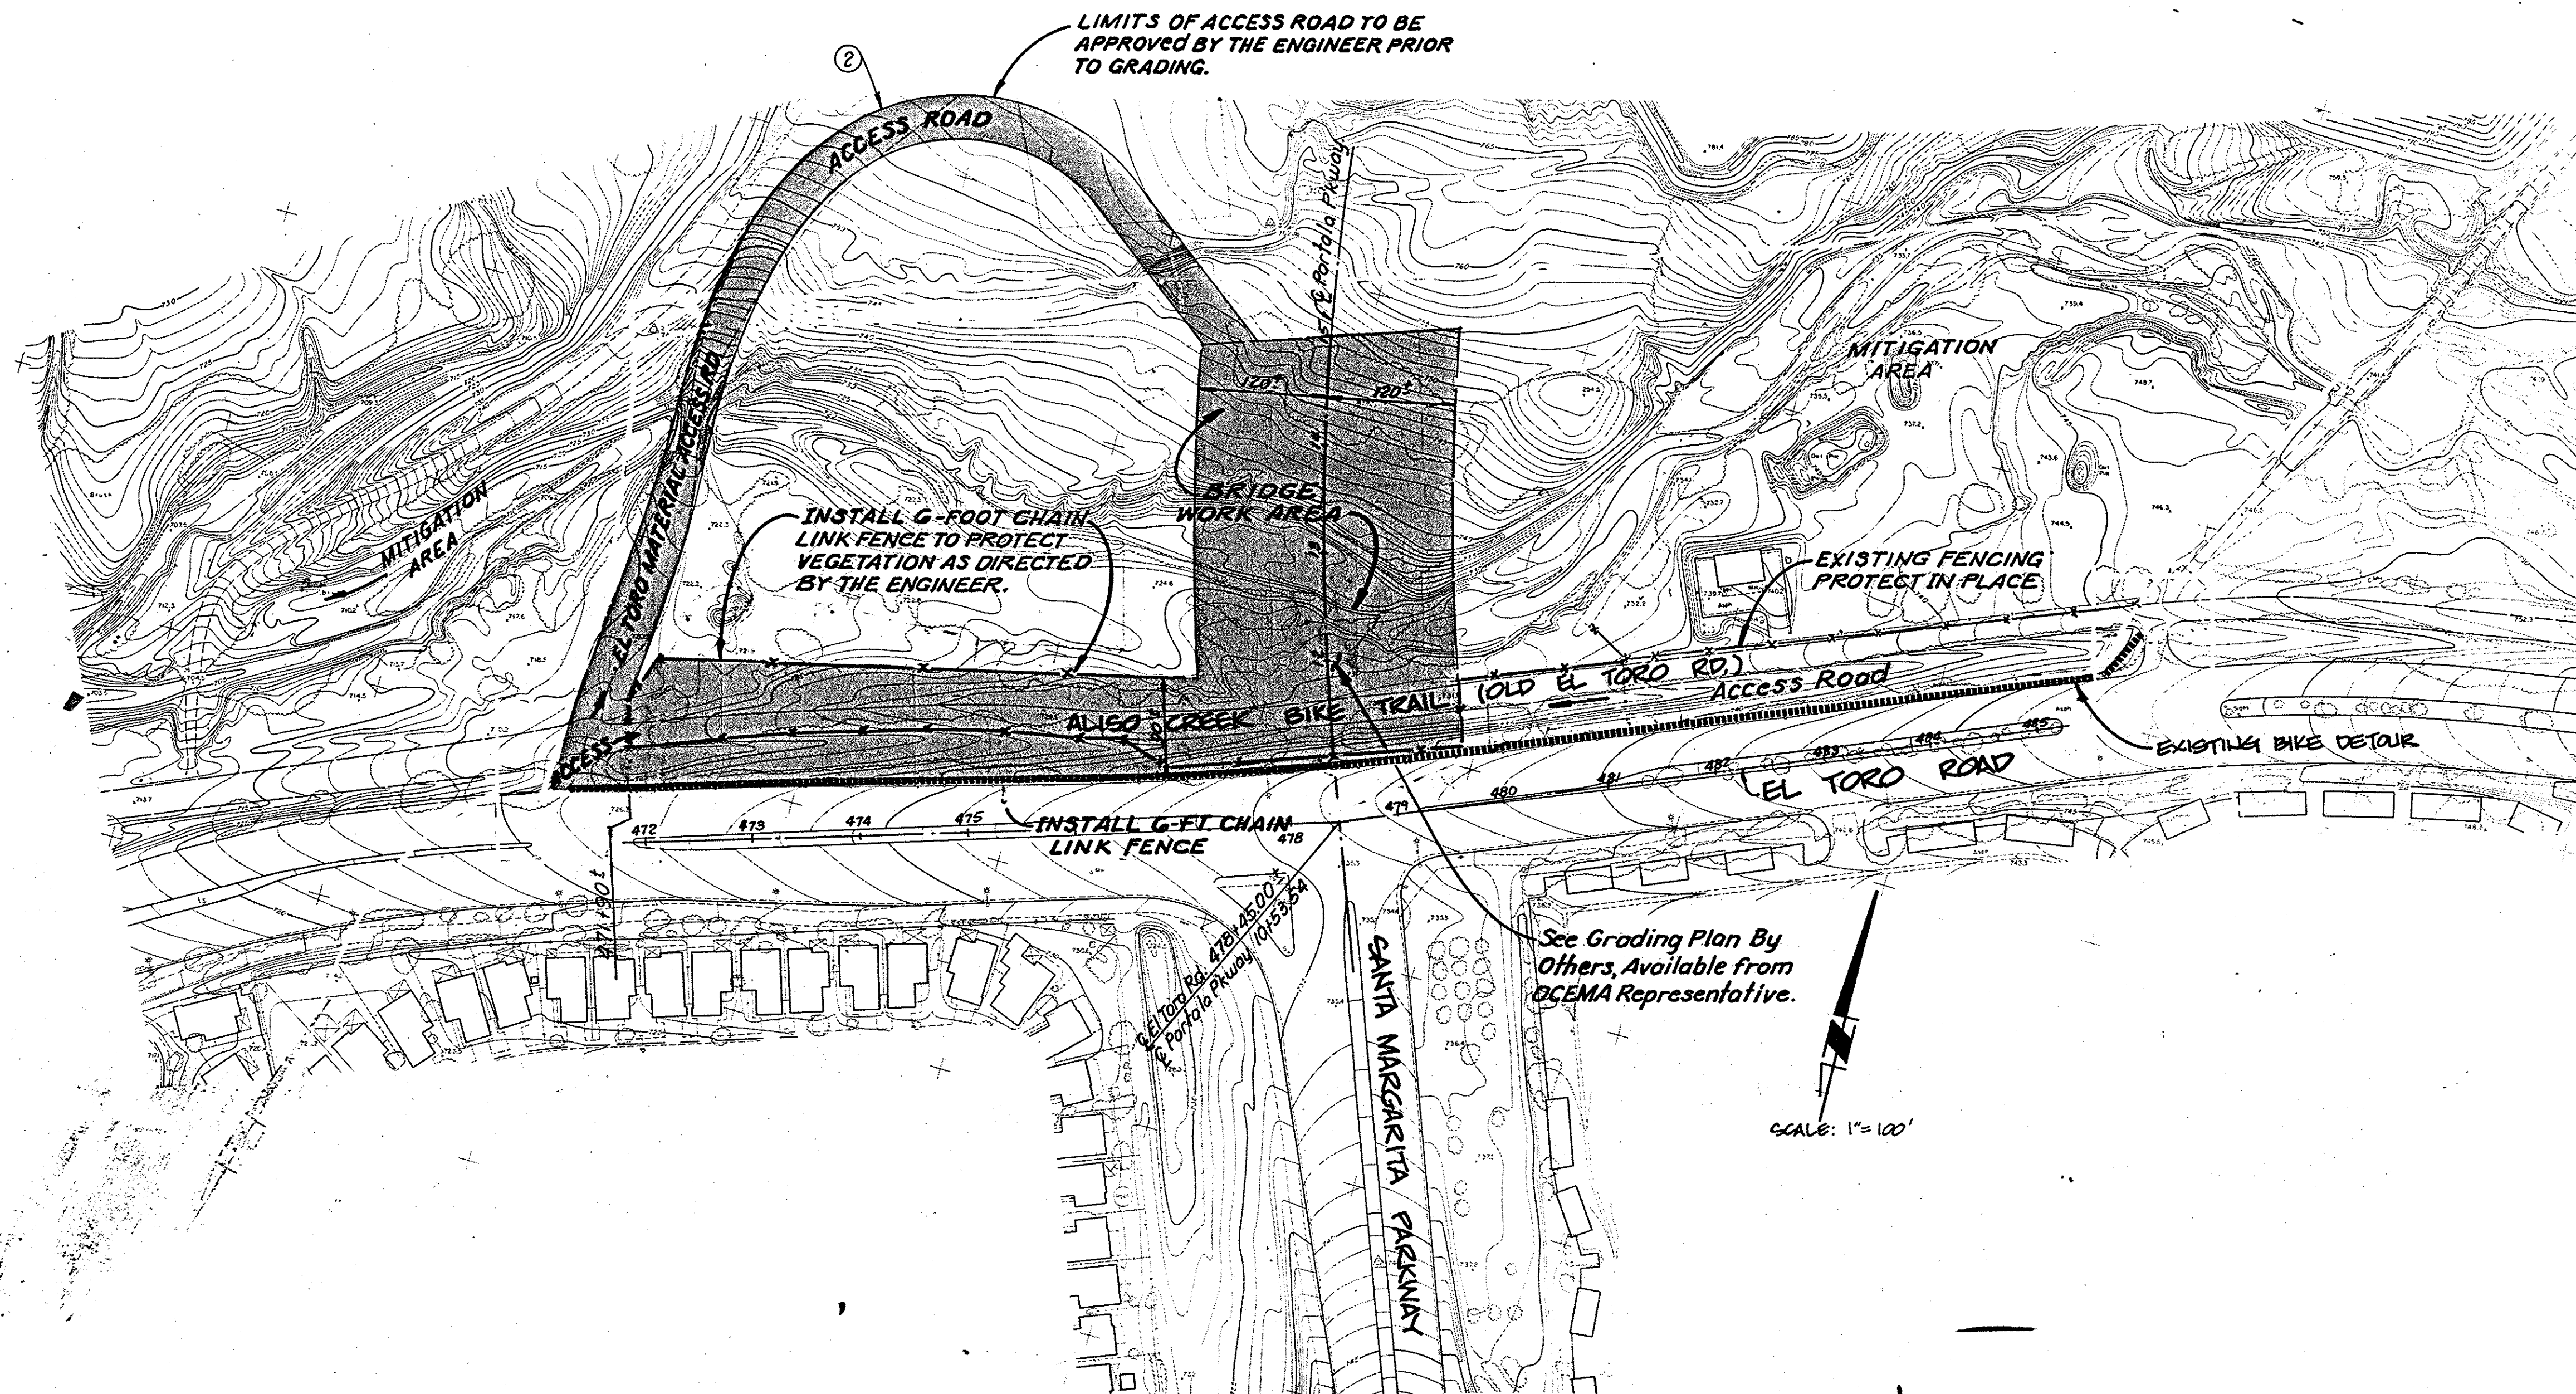

LONGITUDINAL JOINT

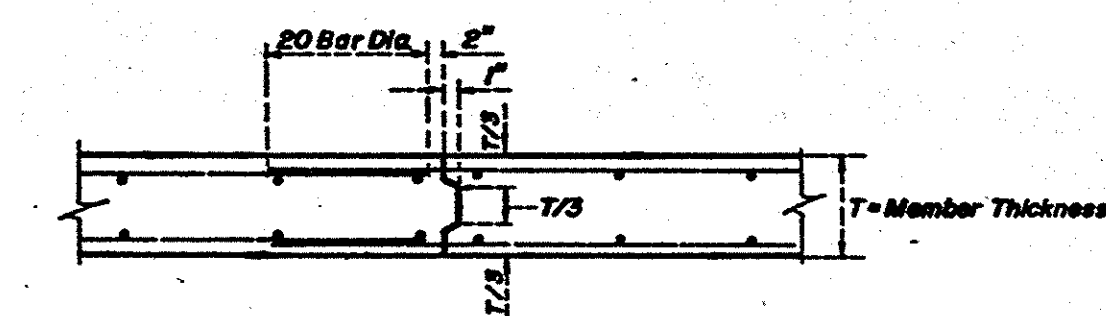

TRANSVERSE JOINT

CONSTRUCTION JOINT DETAILS
NOT TO SCALE

NOTES:

- ① - The Contractor is responsible for protecting all paved surfaces in place and repairing any damage that may occur because of related construction work.
- ② - The areas graded by the contractor to get access around the construction site shall be restored to the original condition or as required by the Engineer after completion of the bridge contract work.
- ③ - Contractor shall install chain link fence & gates prior to commencing any work on the bridge.
- ④ - Locate all utilities prior installing fence.



Robert Bein, William Frost & Associates
PROFESSIONAL ENGINEERS, PLANNERS & SURVEYORS
P.O. BOX 19739 • 14725 ALTON PARKWAY, IRVINE, CALIFORNIA 92718
(714) 472-3505
DR. 14 (16108)
Sheet 10 of 13

ORANGE COUNTY ENVIRONMENTAL MANAGEMENT AGENCY			
PORTOLA BRIDGE OVER ALISO CREEK CONSTRUCTION ACCESS AND STORAGE PLAN			
MARK	DATE	DESCRIPTION	PREPARED UNDER SUPERVISION OF
			Paul R. Young 4-12-91
REVISIONS		DATE	DATE
DESIGNED P.V.		SCALE	DWG. NO.
DRAWN R.O.B. J.S.	CHECKED M.W.	AS SHOWN	