



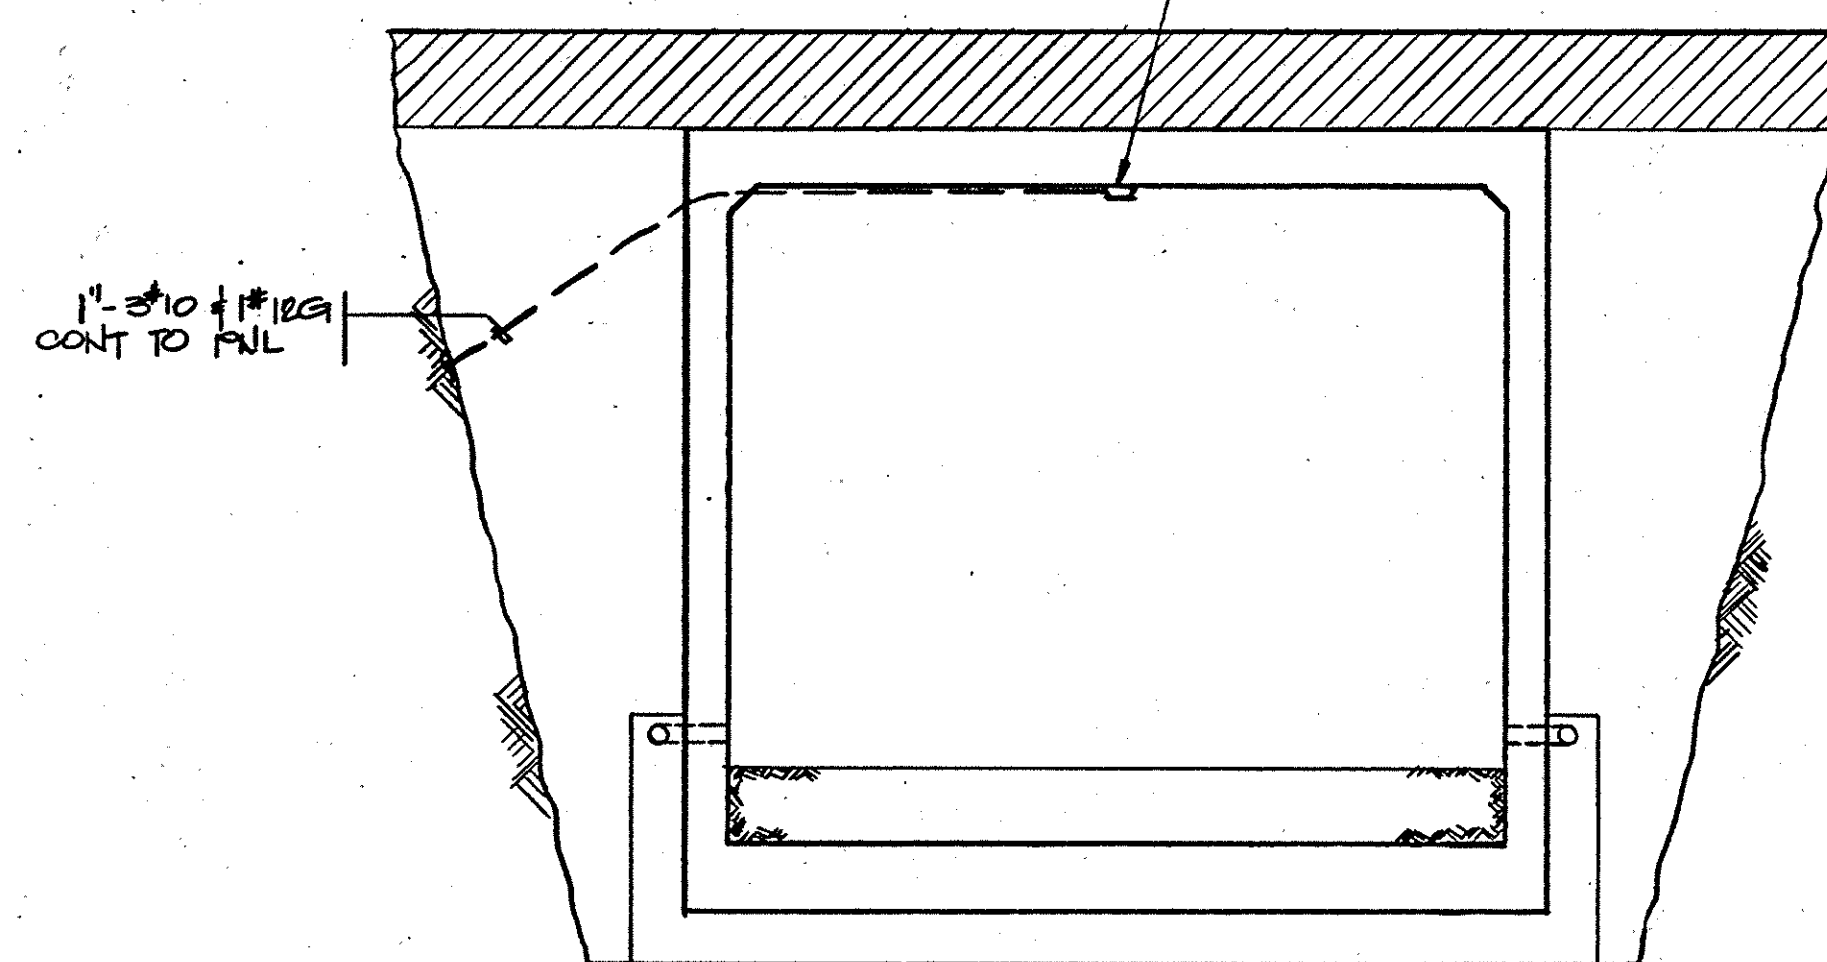

1. The Electrical Contractor (E.C.) shall contact utility companies before commencing work to coordinate scheduling and inspection of equipment installation.
2. All wiring design is based on 75 degree C. conditions for copper conductors of type THHN (walls and overhead) or THWN (underground) unless otherwise noted. The E.C. shall size all wiring not explicitly shown on drawings according to the requirements of National Electrical Code (NEC) for the specific application and conditions.
3. Minimum conduit size shall be 1". Use PVC SCH. 40 underground with RGS PVC COATED ELBOWS and risers. ALL EXPOSED CONDUIT SHALL BE (RGS) RIGID STEEL
~~GALVANIZED~~
4. The E.C. shall be responsible for conformity to all local codes and ordinances, the State of California Electrical Safety Orders, the NEC and any additional jurisdictions relating to the work.
5. N/A
6. The E.C. shall include in his bid all connection fees and charges assessed by the serving electrical utility so that electrical bid shall represent the complete and total cost of the completed electrical system for the project (excluding any owner-supplied items).
7. Verify existing site conditions, service requirements and exact locations of service facilities before submitting bid.
8. All electrical equipment shall be anchored for seismic loading.
9. ELECTRICAL UTILITY IS: SOE LARRY SOVERN
(714) 458-4410

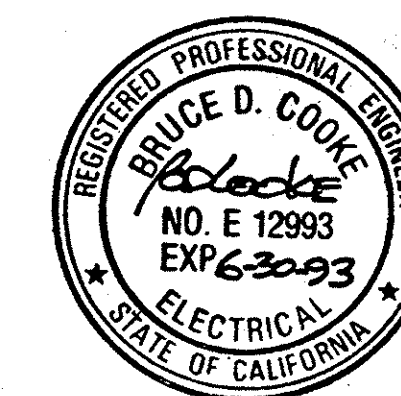

1 1/2 0 1
3 inches on original drawing

			ORANGE COUNTY ENVIRONMENTAL MANAGEMENT AGENCY		SHEET B13 OF 13
			PORTOLA BRIDGE OVER ALISO CREEK		
			EQUESTRIAN TRAIL UNDERCROSSING PLAN, ELECTRICAL		
MARK	DATE	DESCRIPTION	PREPARED UNDER SUPERVISION OF		DATE
REVISIONS					
DESIGNED	FVR		SCALE	DATE	DWG. NO.
DRAWN	FVR		AS SHOWN	8-7-91	
		CHECKED	BOC		

Robert Bein, William Frost & Associates
PROFESSIONAL ENGINEERS, PLANNERS & SURVEYORS
P.O. BOX 19739 • 14725 ALTON PARKWAY, IRVINE, CALIFORNIA 92718
(714) 472-3505

DR. 14 (16108)
Sheet 13 Of 13

DR. 14 U 6108