
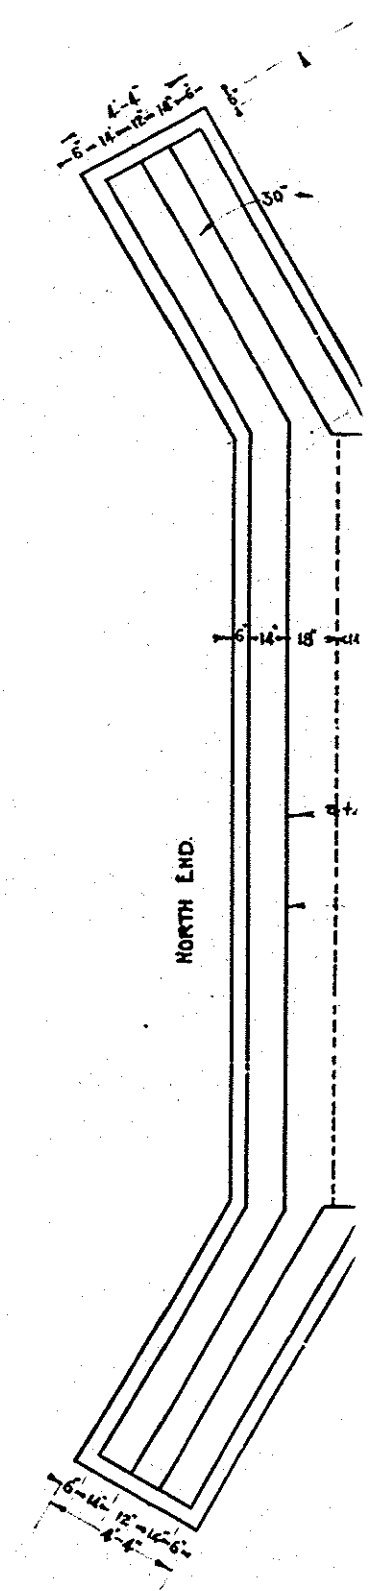
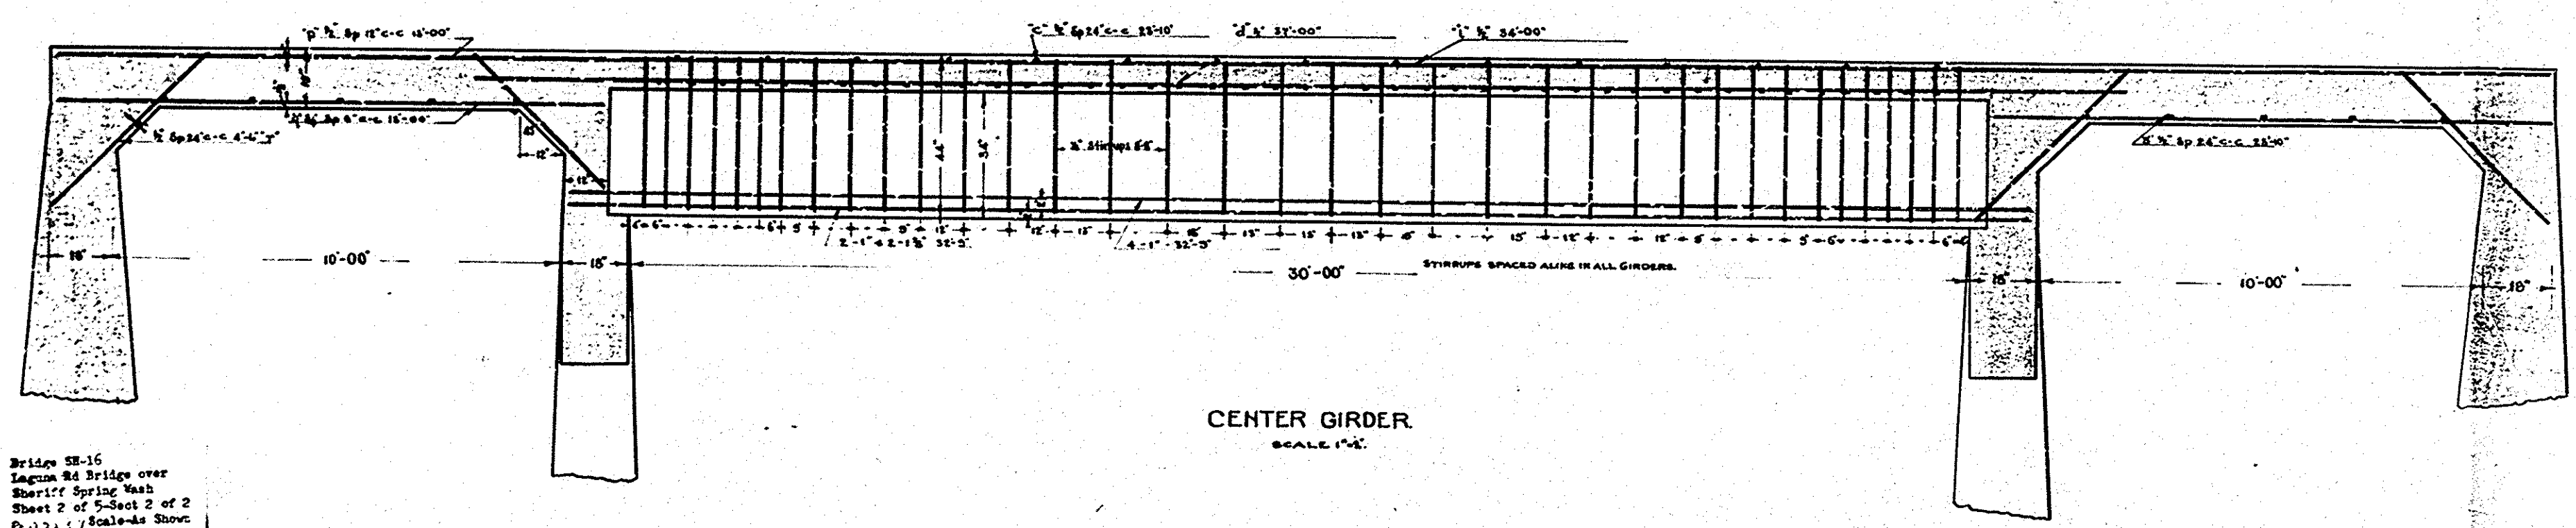
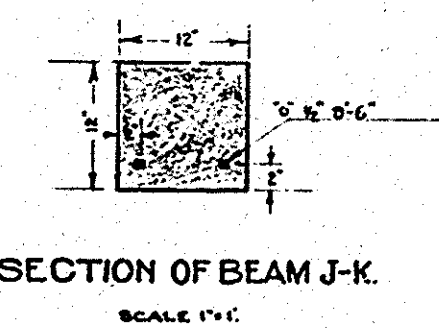
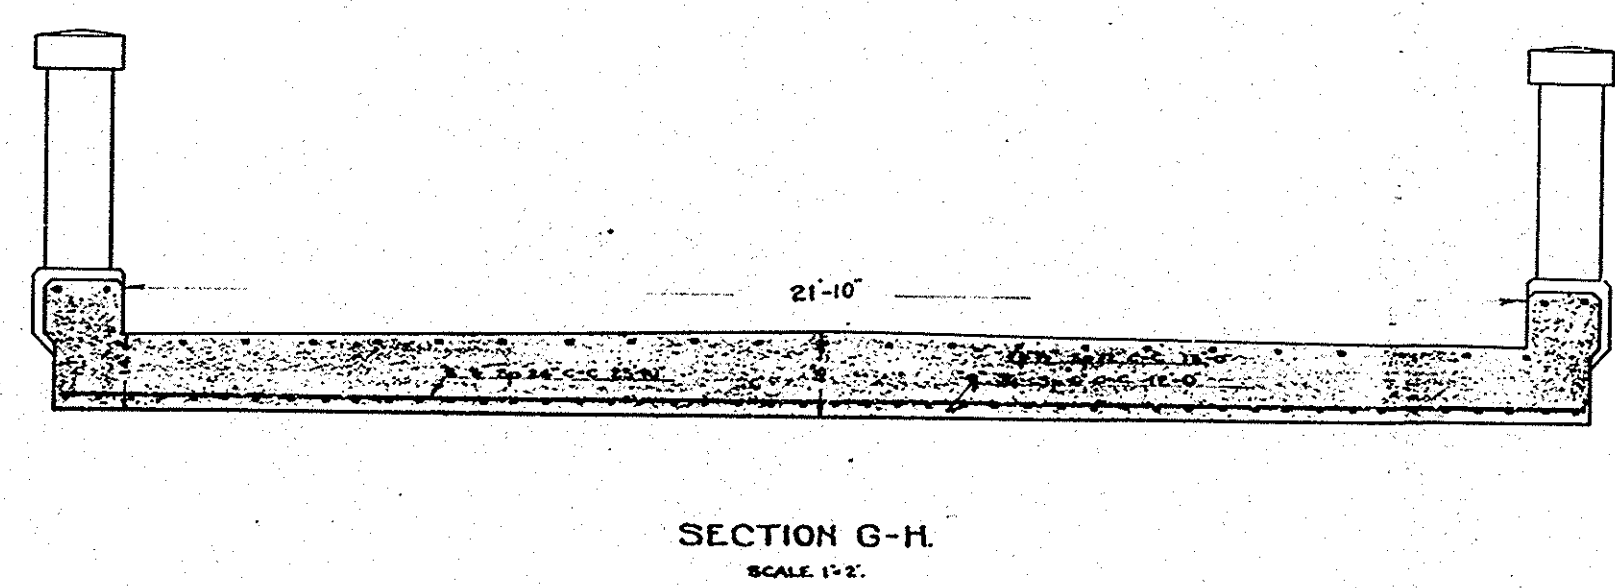
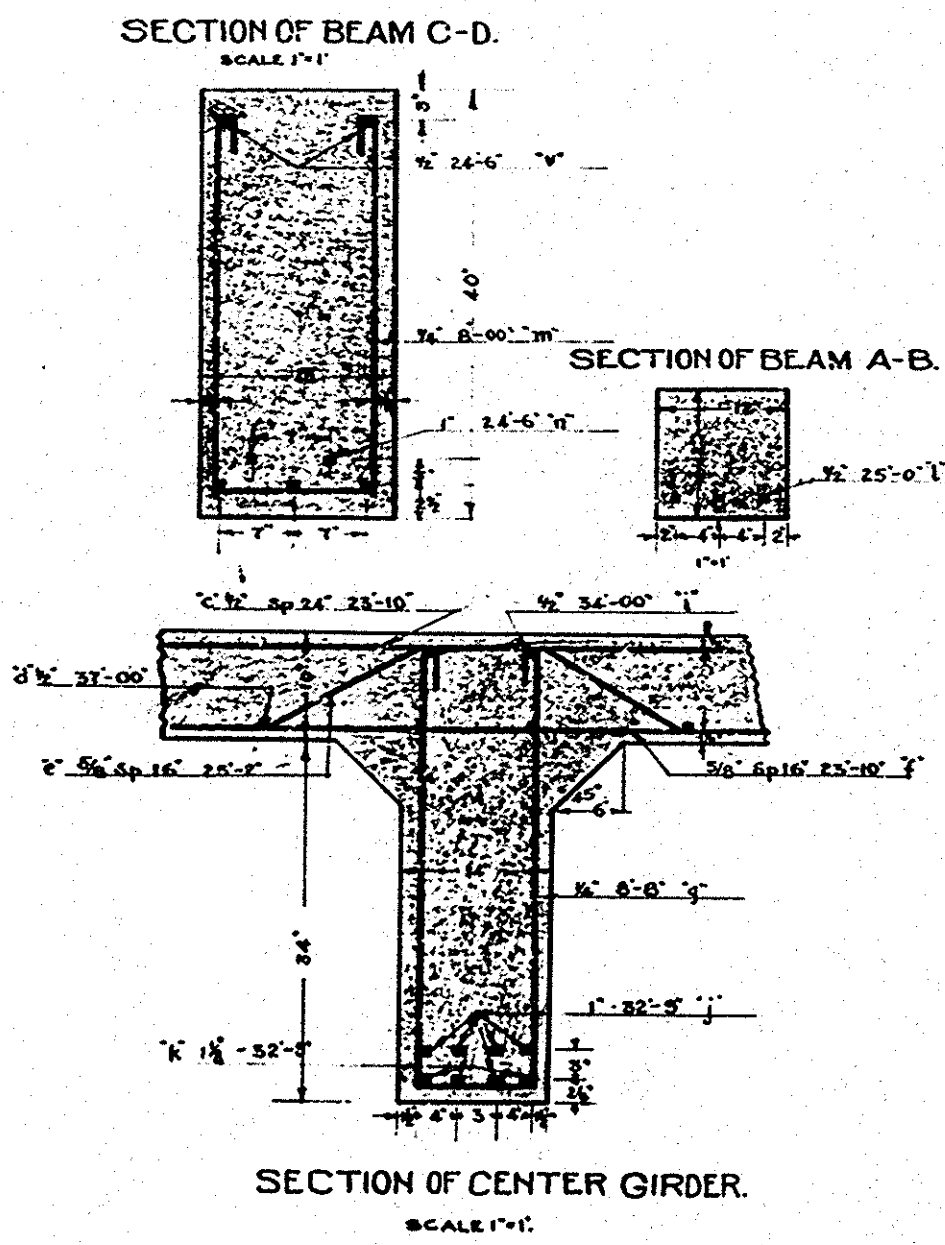
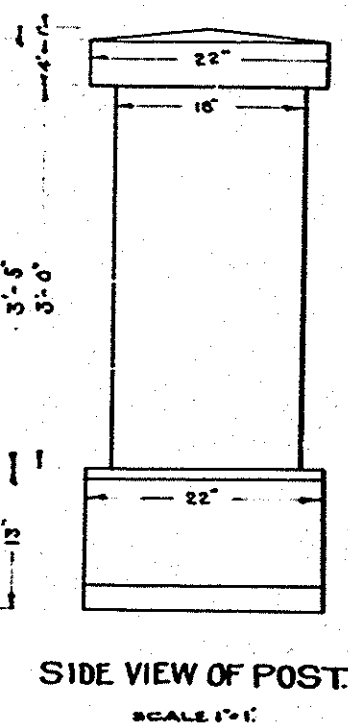


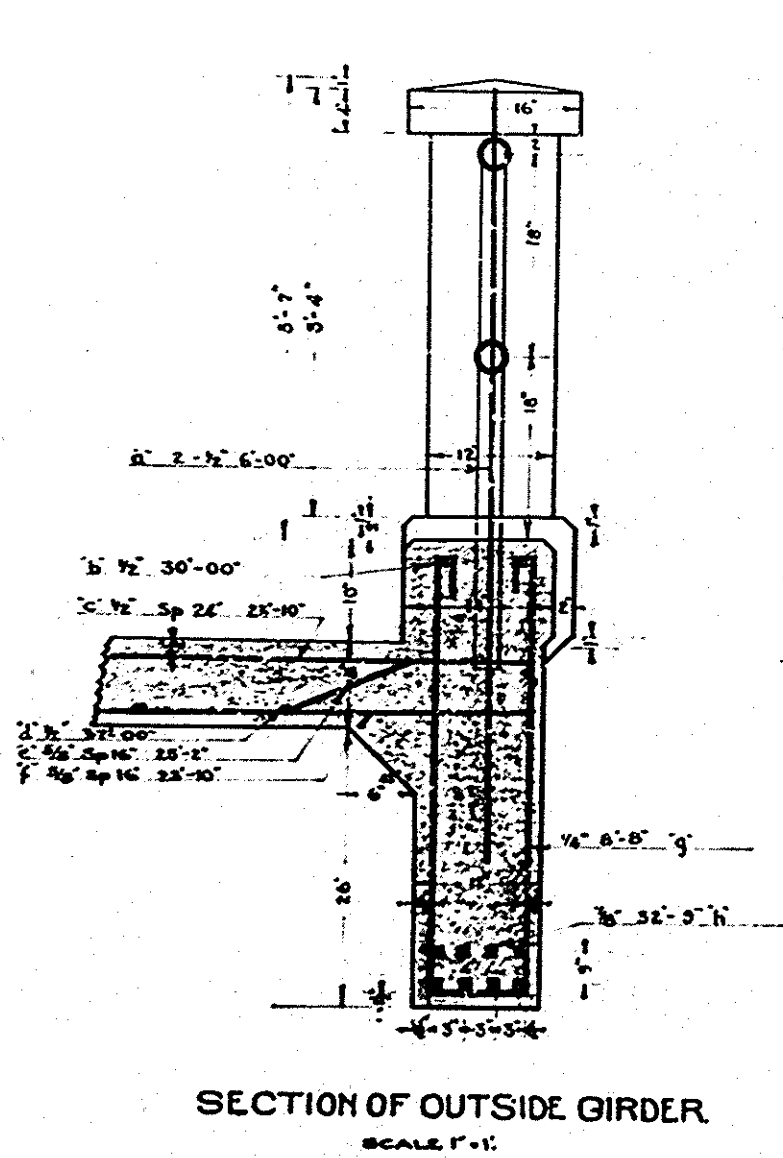

Bridge 58-16
Laguna Rd Bridge over
Sheriff Spring Wash
Sheet 2 of 5-Set 2 of 2
P.L. 11/1/77 Scale-as Shown
Lines