
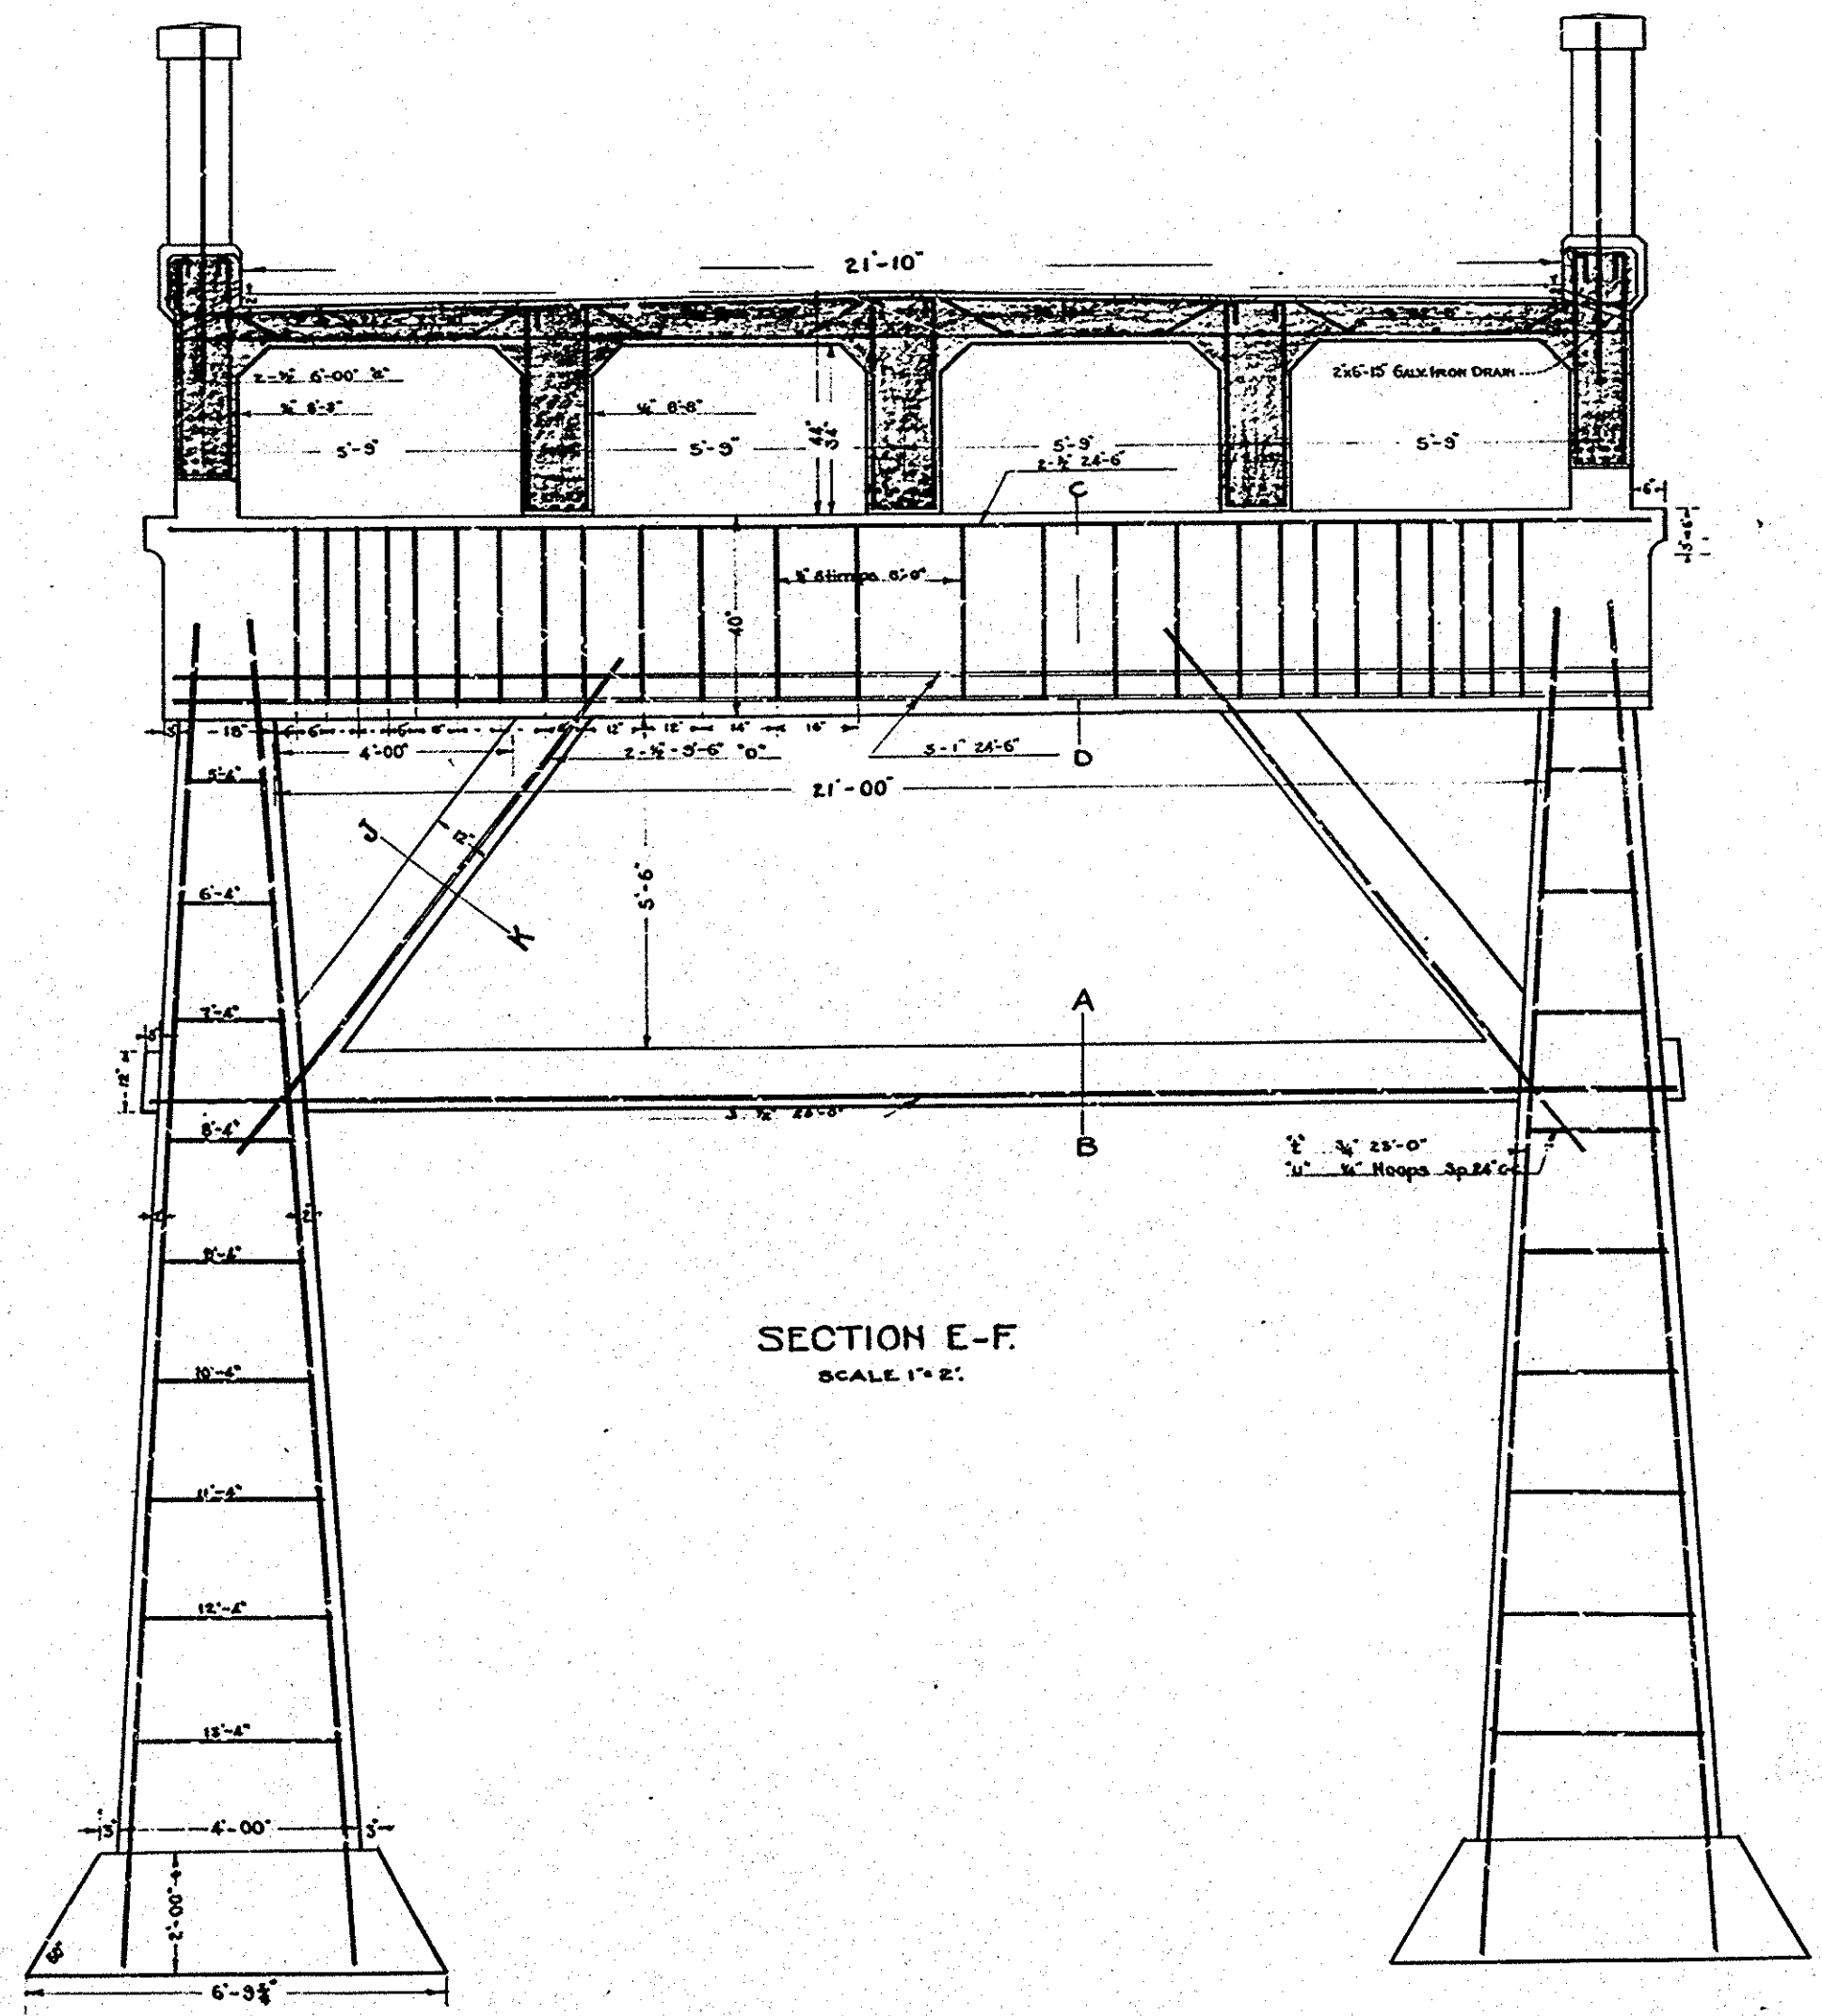


Bridge, Laguna Rd at Sheriff Spring Wash. (233)

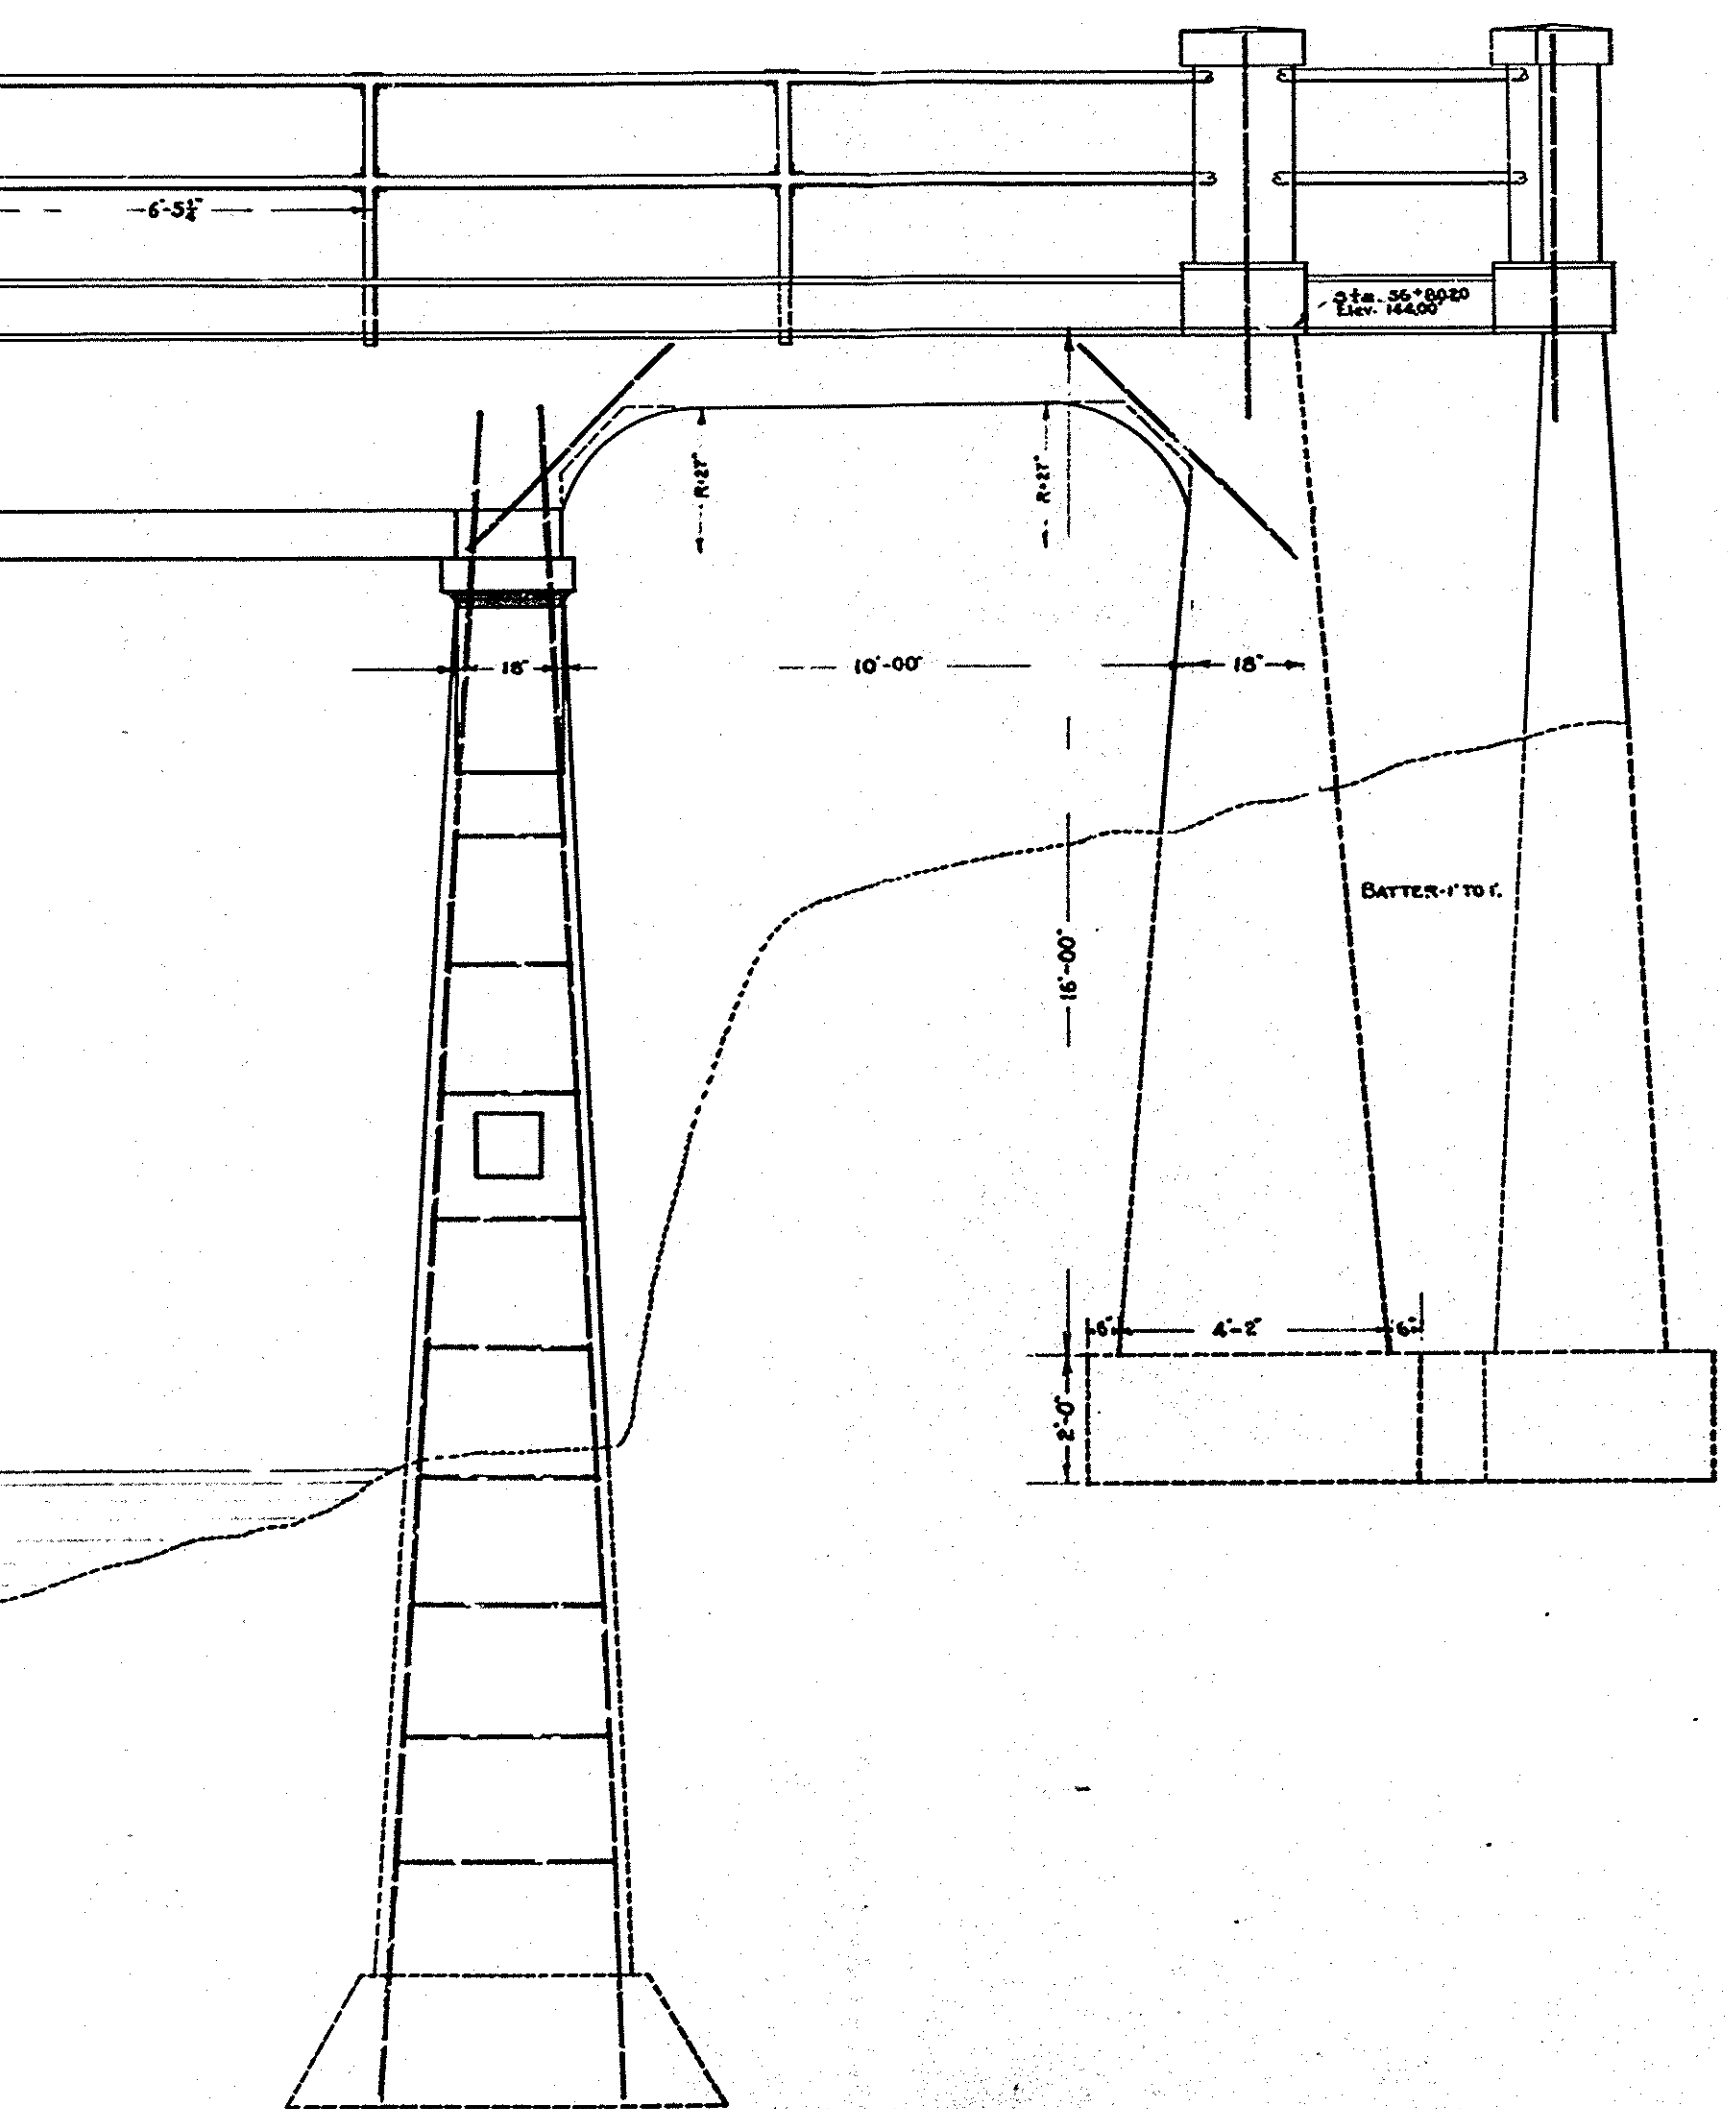

Bridge SB-16
Laguna Rd Bridge over
Sheriff Spring Wash
Sheet 3 of 5-Sub 1 of 2
RCD 2-2-51 Scale-As Shown
Linen

MICROFILMED
JUL 8 1964

SH-16