



LAGUNA CUTOFF ROAD
ORANGE COUNTY, CALIFORNIA.
SHEET 4 OF 5 SHEETS.
SCALE 1"=4'-0"

Approved: *Mark Kelly*
Supt. of Highways

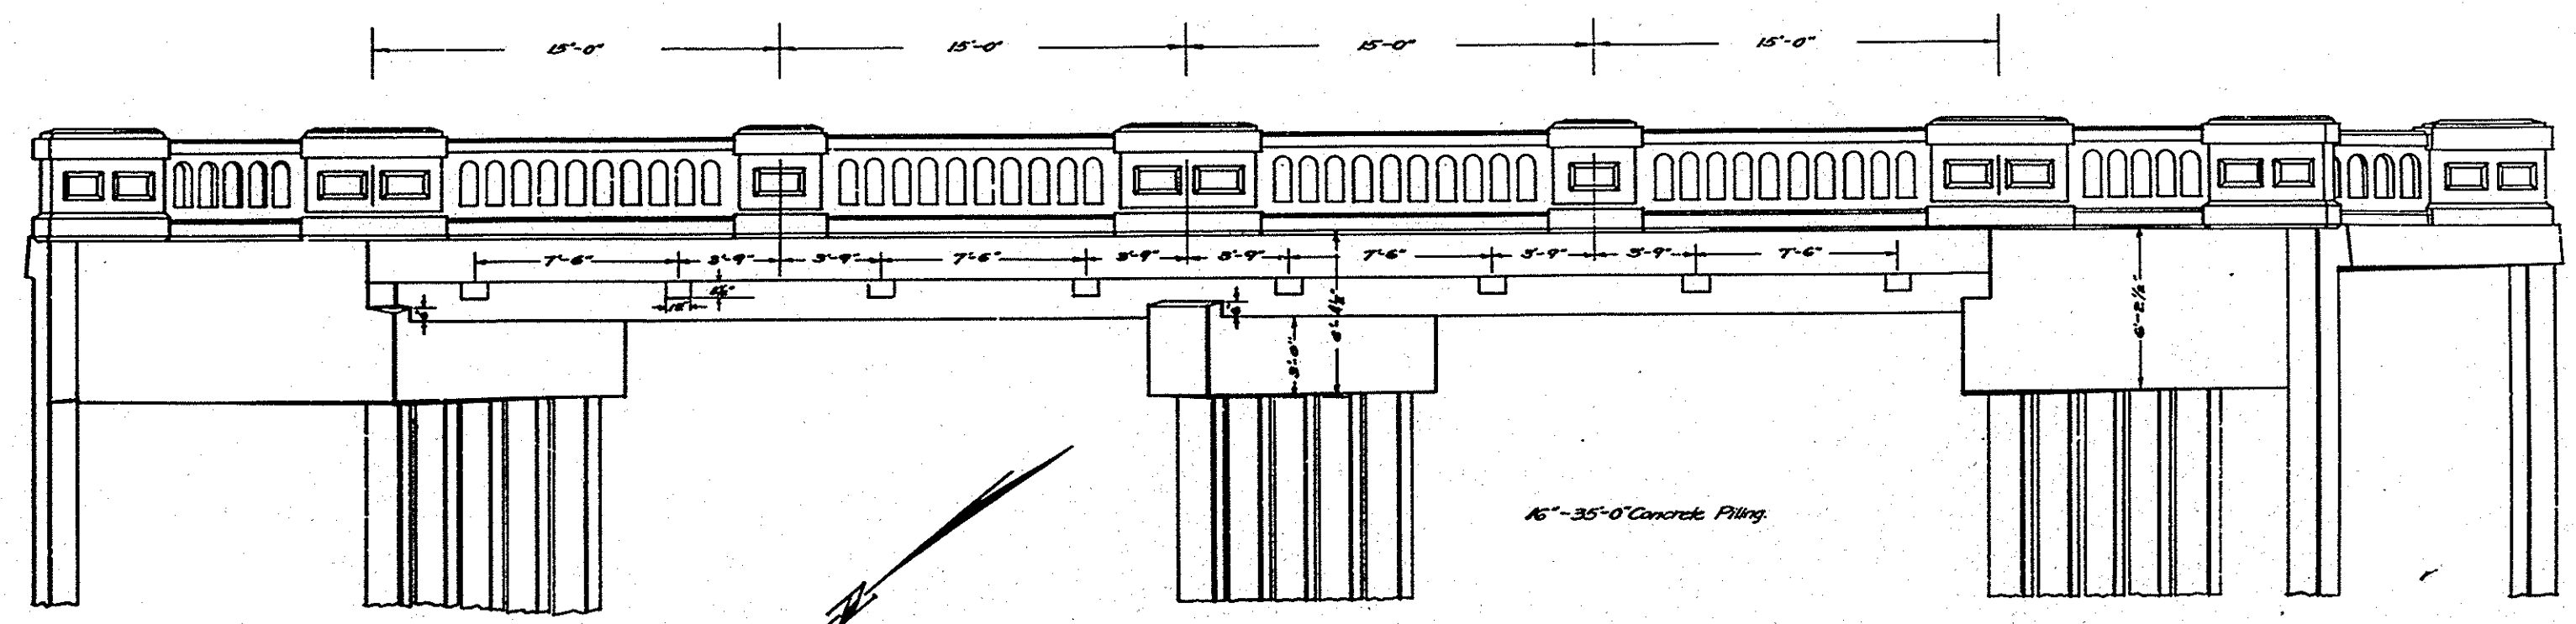


ELEVATION

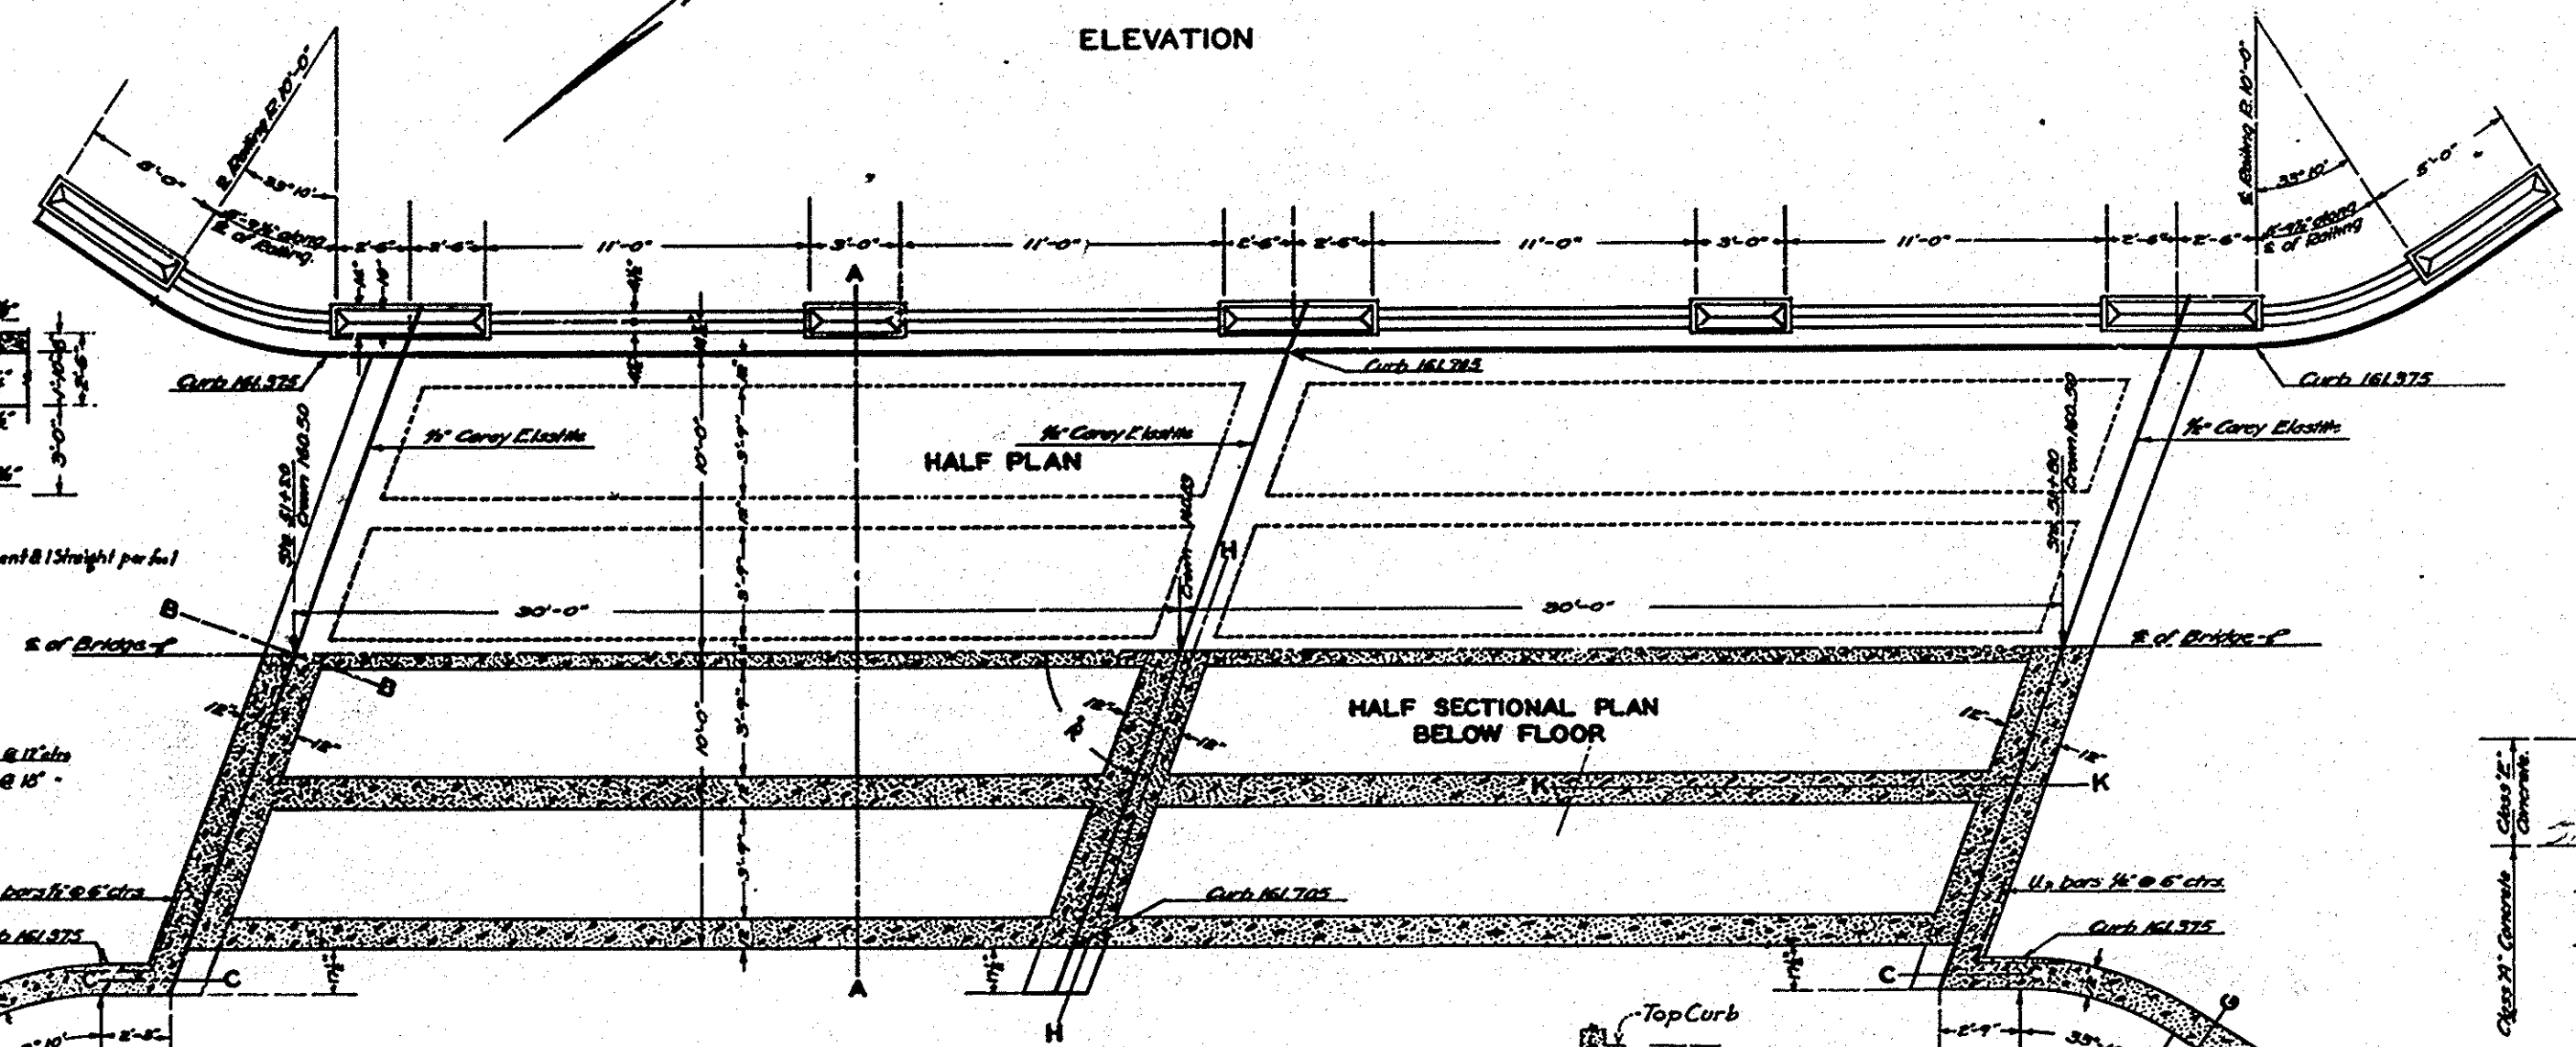


HALF PLAN


HALF SECTIONAL PLAN
BELOW FLOOR

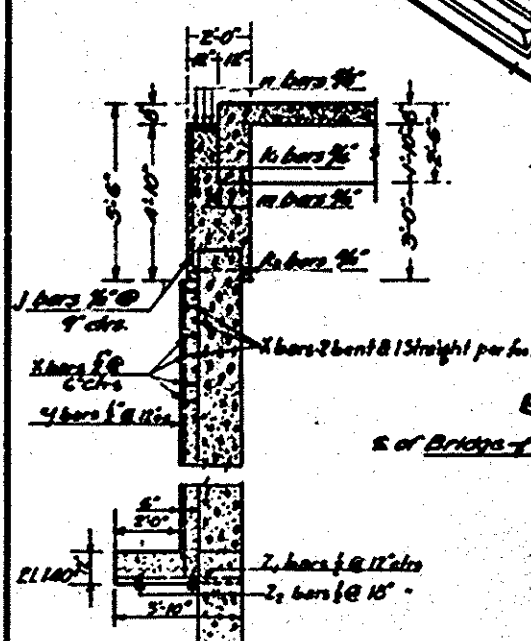


SECTION B-B

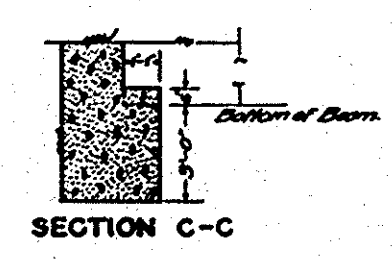


SECTION C-C

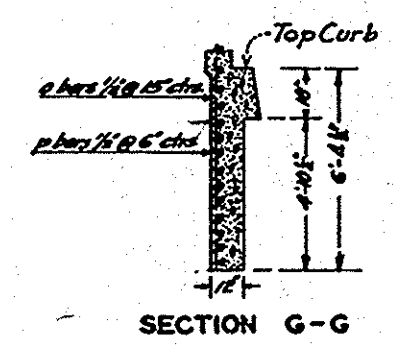


SECTION G-G

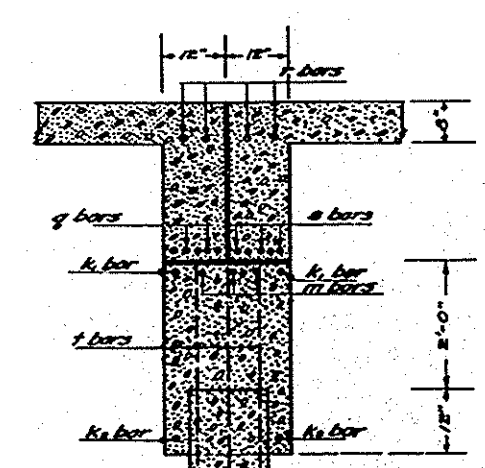

SECTION J-J
1"=2'-0"

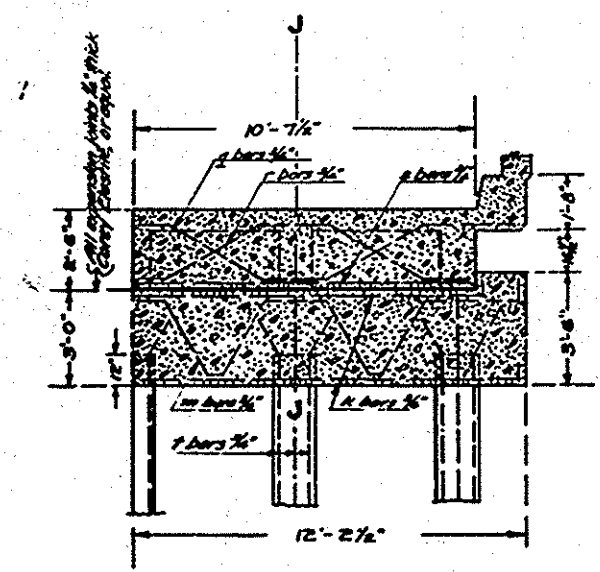

SECTION H-H

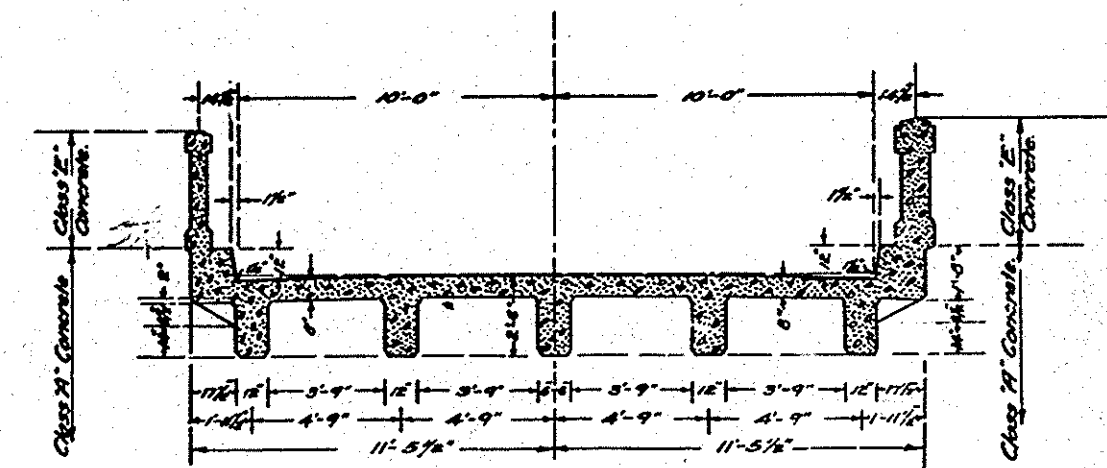

SECTION A-A

Bridge SR-15
Laguna Rd Bridge over
Sheriff Spring Wash
Sheet 4 of 5
Scale-As Shown
Linen

4 MICROFILMED
JUL -8 1960

Designed by F.O.B. 27

495