


# ORANGE COUNTY ROAD DEPT.


STATE OF CALIFORNIA

## PLANS FOR WIDENING OF SANTA ANA AVE. BRIDGE


DE - 12  $\Rightarrow$  ~~DE - 12A~~  
ACROSS FLOOD CONTROL CHANNEL FO I

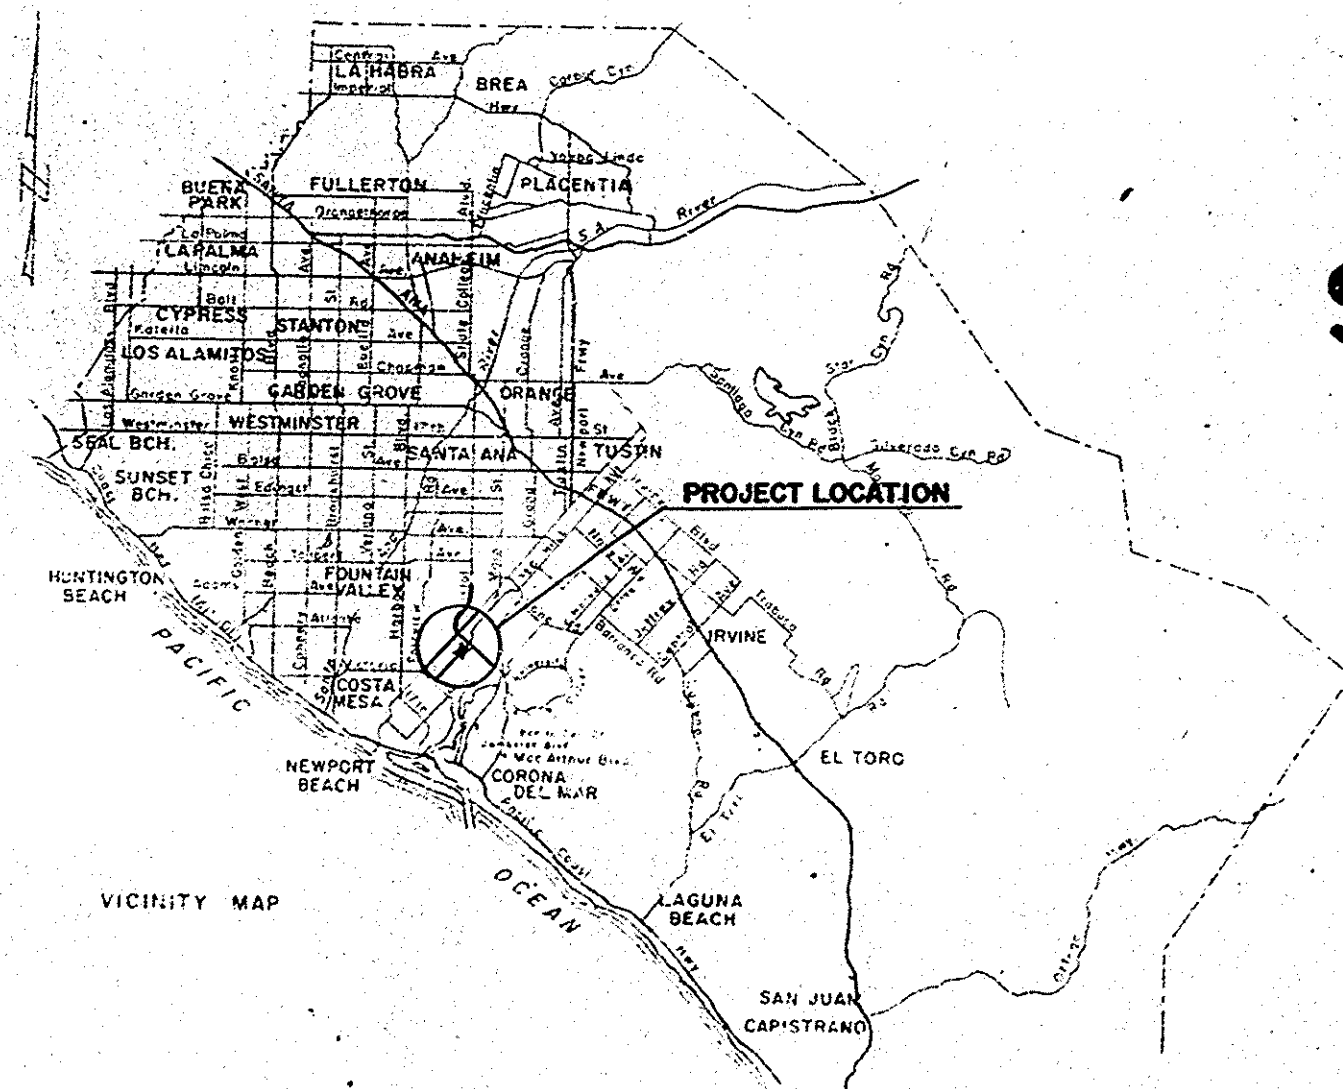

| Sheet No | Description                |
|----------|----------------------------|
| 1        | TITLE SHEET                |
| 2        | GENERAL PLAN               |
| 3        | BRIDGE PLAN                |
| 4        | MISCELLANEOUS DETAILS      |
| 5        | GUARD RAIL & FENCE DETAILS |
| 6        | PILE DETAILS               |

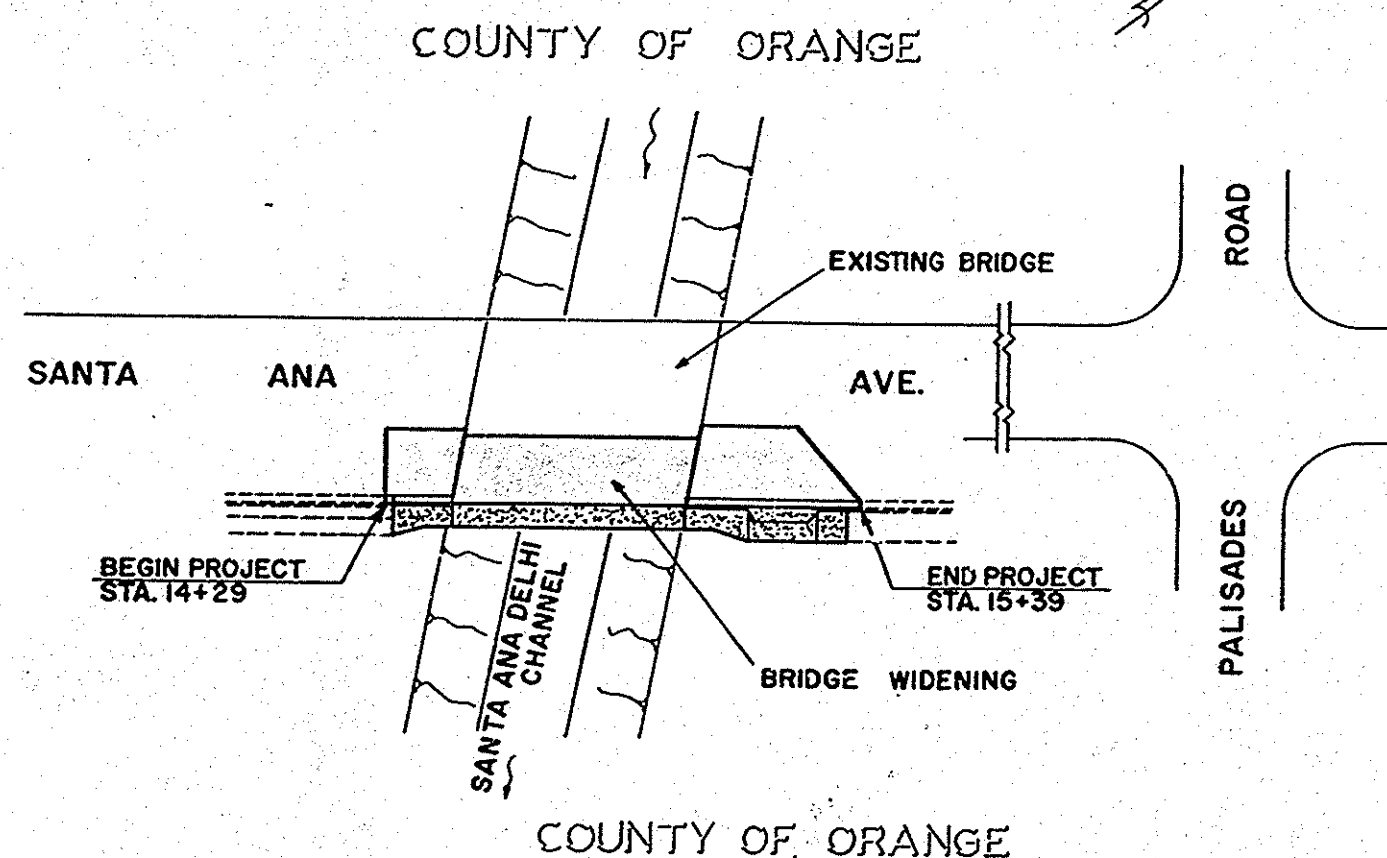

ALL WORK WITHIN THE FLOOD CONTROL DISTRICT RIGHT OF WAY SHALL BE PERFORMED IN ACCORDANCE WITH THE PROVISIONS OF THE CONSTRUCTION PERMIT GRANTED BY ORANGE COUNTY FLOOD CONTROL DISTRICT AND THE PLANS STAMPED WITH THE APPROVAL OF ORANGE COUNTY FLOOD CONTROL DISTRICT. CONTRACTOR SHALL HAVE A COPY OF SAID PERMIT AND STAMPED PLANS ON THE JOB SITE.

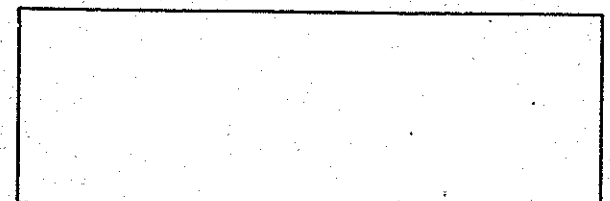

CONVENTIONAL SIGNS

|               |                |
|---------------|----------------|
| 1. ROAD NAME  | 2. ROAD NAME   |
| 3. ROAD NAME  | 4. ROAD NAME   |
| 5. ROAD NAME  | 6. ROAD NAME   |
| 7. ROAD NAME  | 8. ROAD NAME   |
| 9. ROAD NAME  | 10. ROAD NAME  |
| 11. ROAD NAME | 12. ROAD NAME  |
| 13. ROAD NAME | 14. ROAD NAME  |
| 15. ROAD NAME | 16. ROAD NAME  |
| 97. ROAD NAME | 98. ROAD NAME  |
| 99. ROAD NAME | 100. ROAD NAME |

AS BUILT

MICROFILMED  
JUN 1 2 1968

APPROVED: *[Signature]* 5-24-67  
ROAD COMMISSIONER R.G.E. 7872 DATE

9247  
Santa Ana Ave. Bridge  
Sheet 1 of 6  
Scale as shown  
Date

Rev. 17 (9247) # 9247; 1968  
SANTA ANA AVE BR. WIDENING  
DE-12A over Santa Ana Del Norte  
55C-205, Thomas 859-D2