




DETAIL M-1
SLIDING JOINT

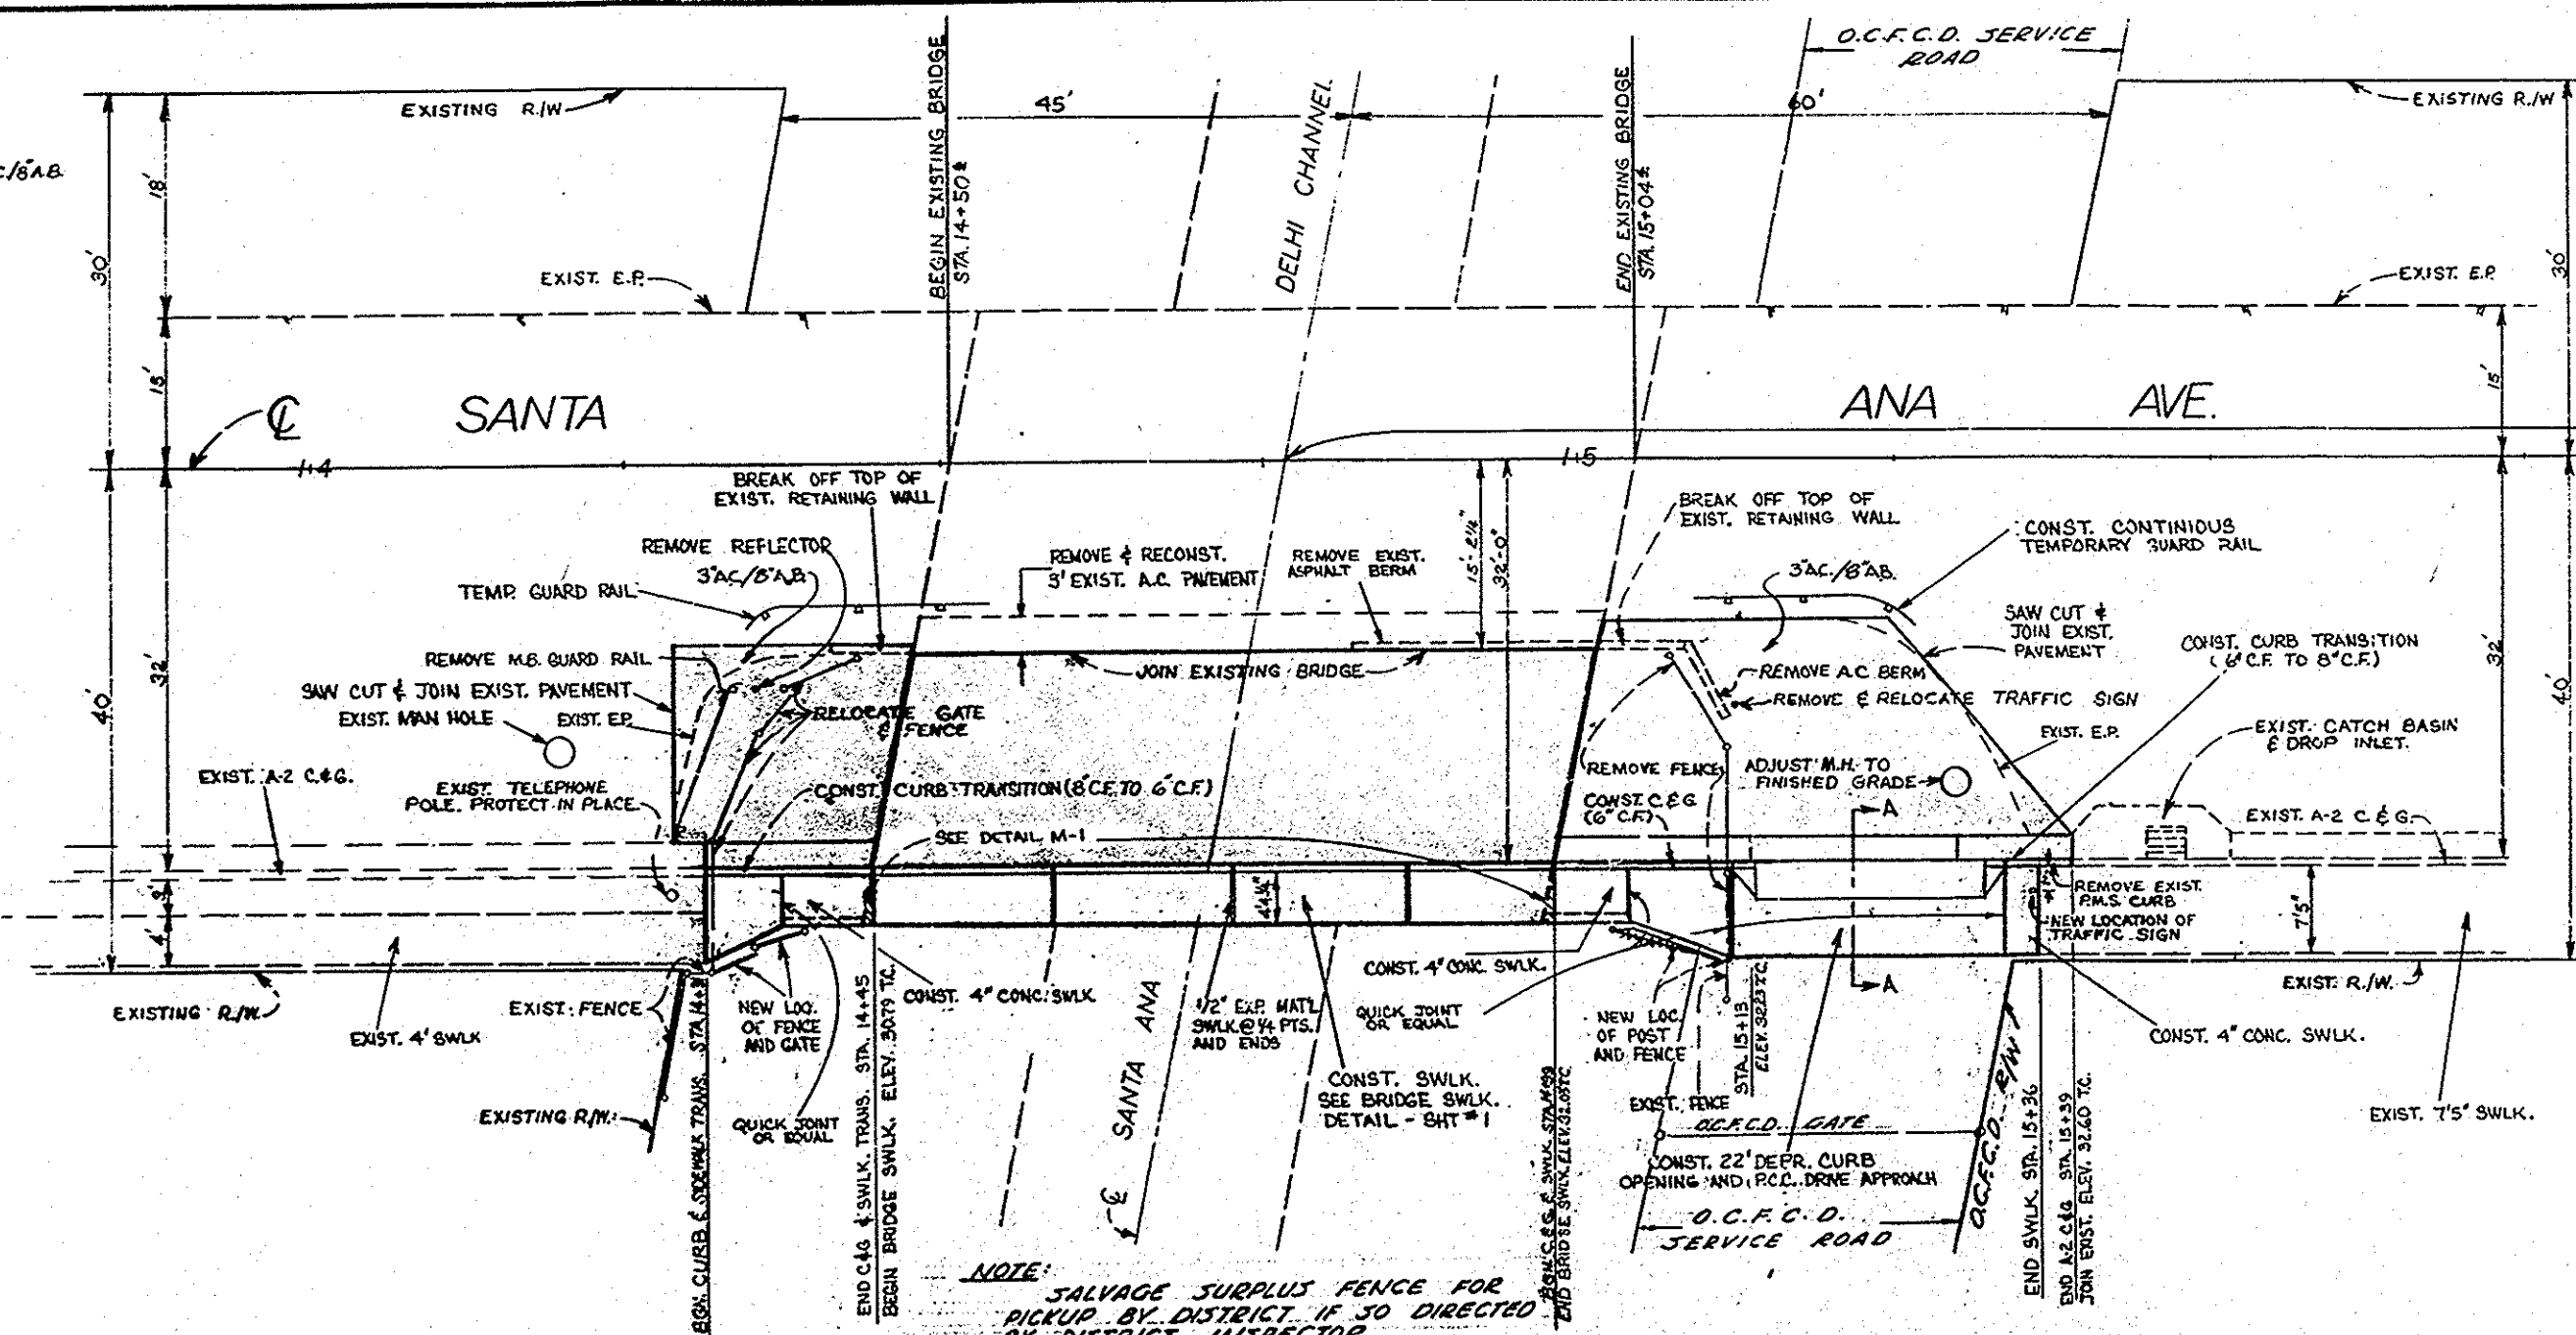

ORANGE COUNTY HIGHWAY DEPARTMENT	
PROJECT	S.A. AVE. BRIDGE WIDEN.
LIMITS	
SCALE	1"=10'
	SHEET 2 OF 6

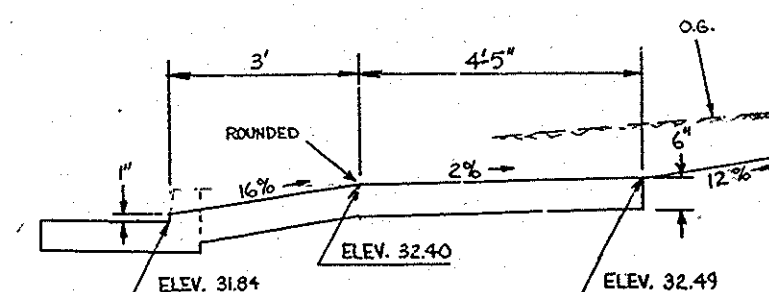

SECT AA - DRIVE APPROACH
STA - 15+21
1"=2'

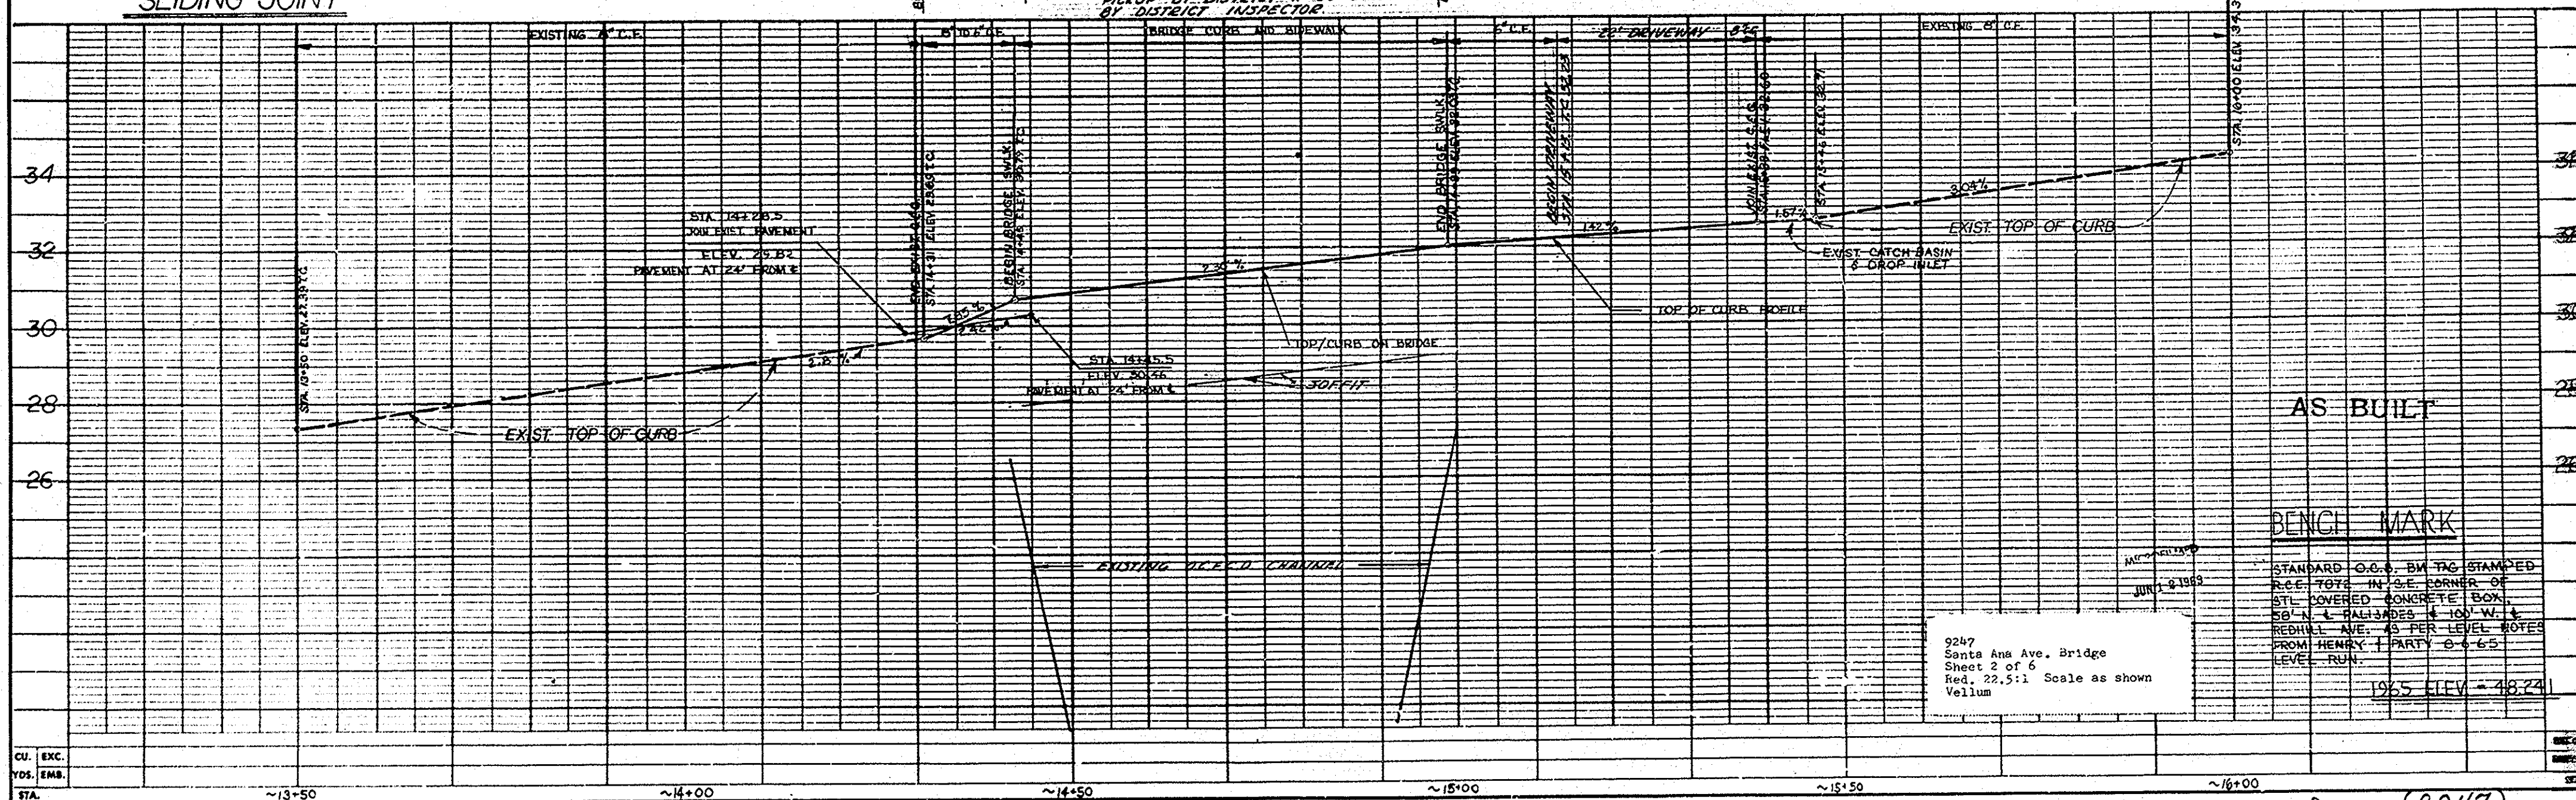

AS BUILT

BENCH MARK

STANDARD O.C.B. BM TAG STAMPED
R.C.E. TOTAL IN S.E. CORNER OF
STL COVERED CONCRETE BOX.
50 N. & PALM JADES & 100 W. &
REDHILL AVE. AS PER LEVEL NOTES
FROM HENRY J. PARTY O.C.B.
LEVEL RUN.

1965 ELEV = 48.22

9247
Santa Ana Ave. Bridge
Sheet 2 of 6
Red. 22.5:1 Scale as shown
Vellum

Dr. 17 (9247)