
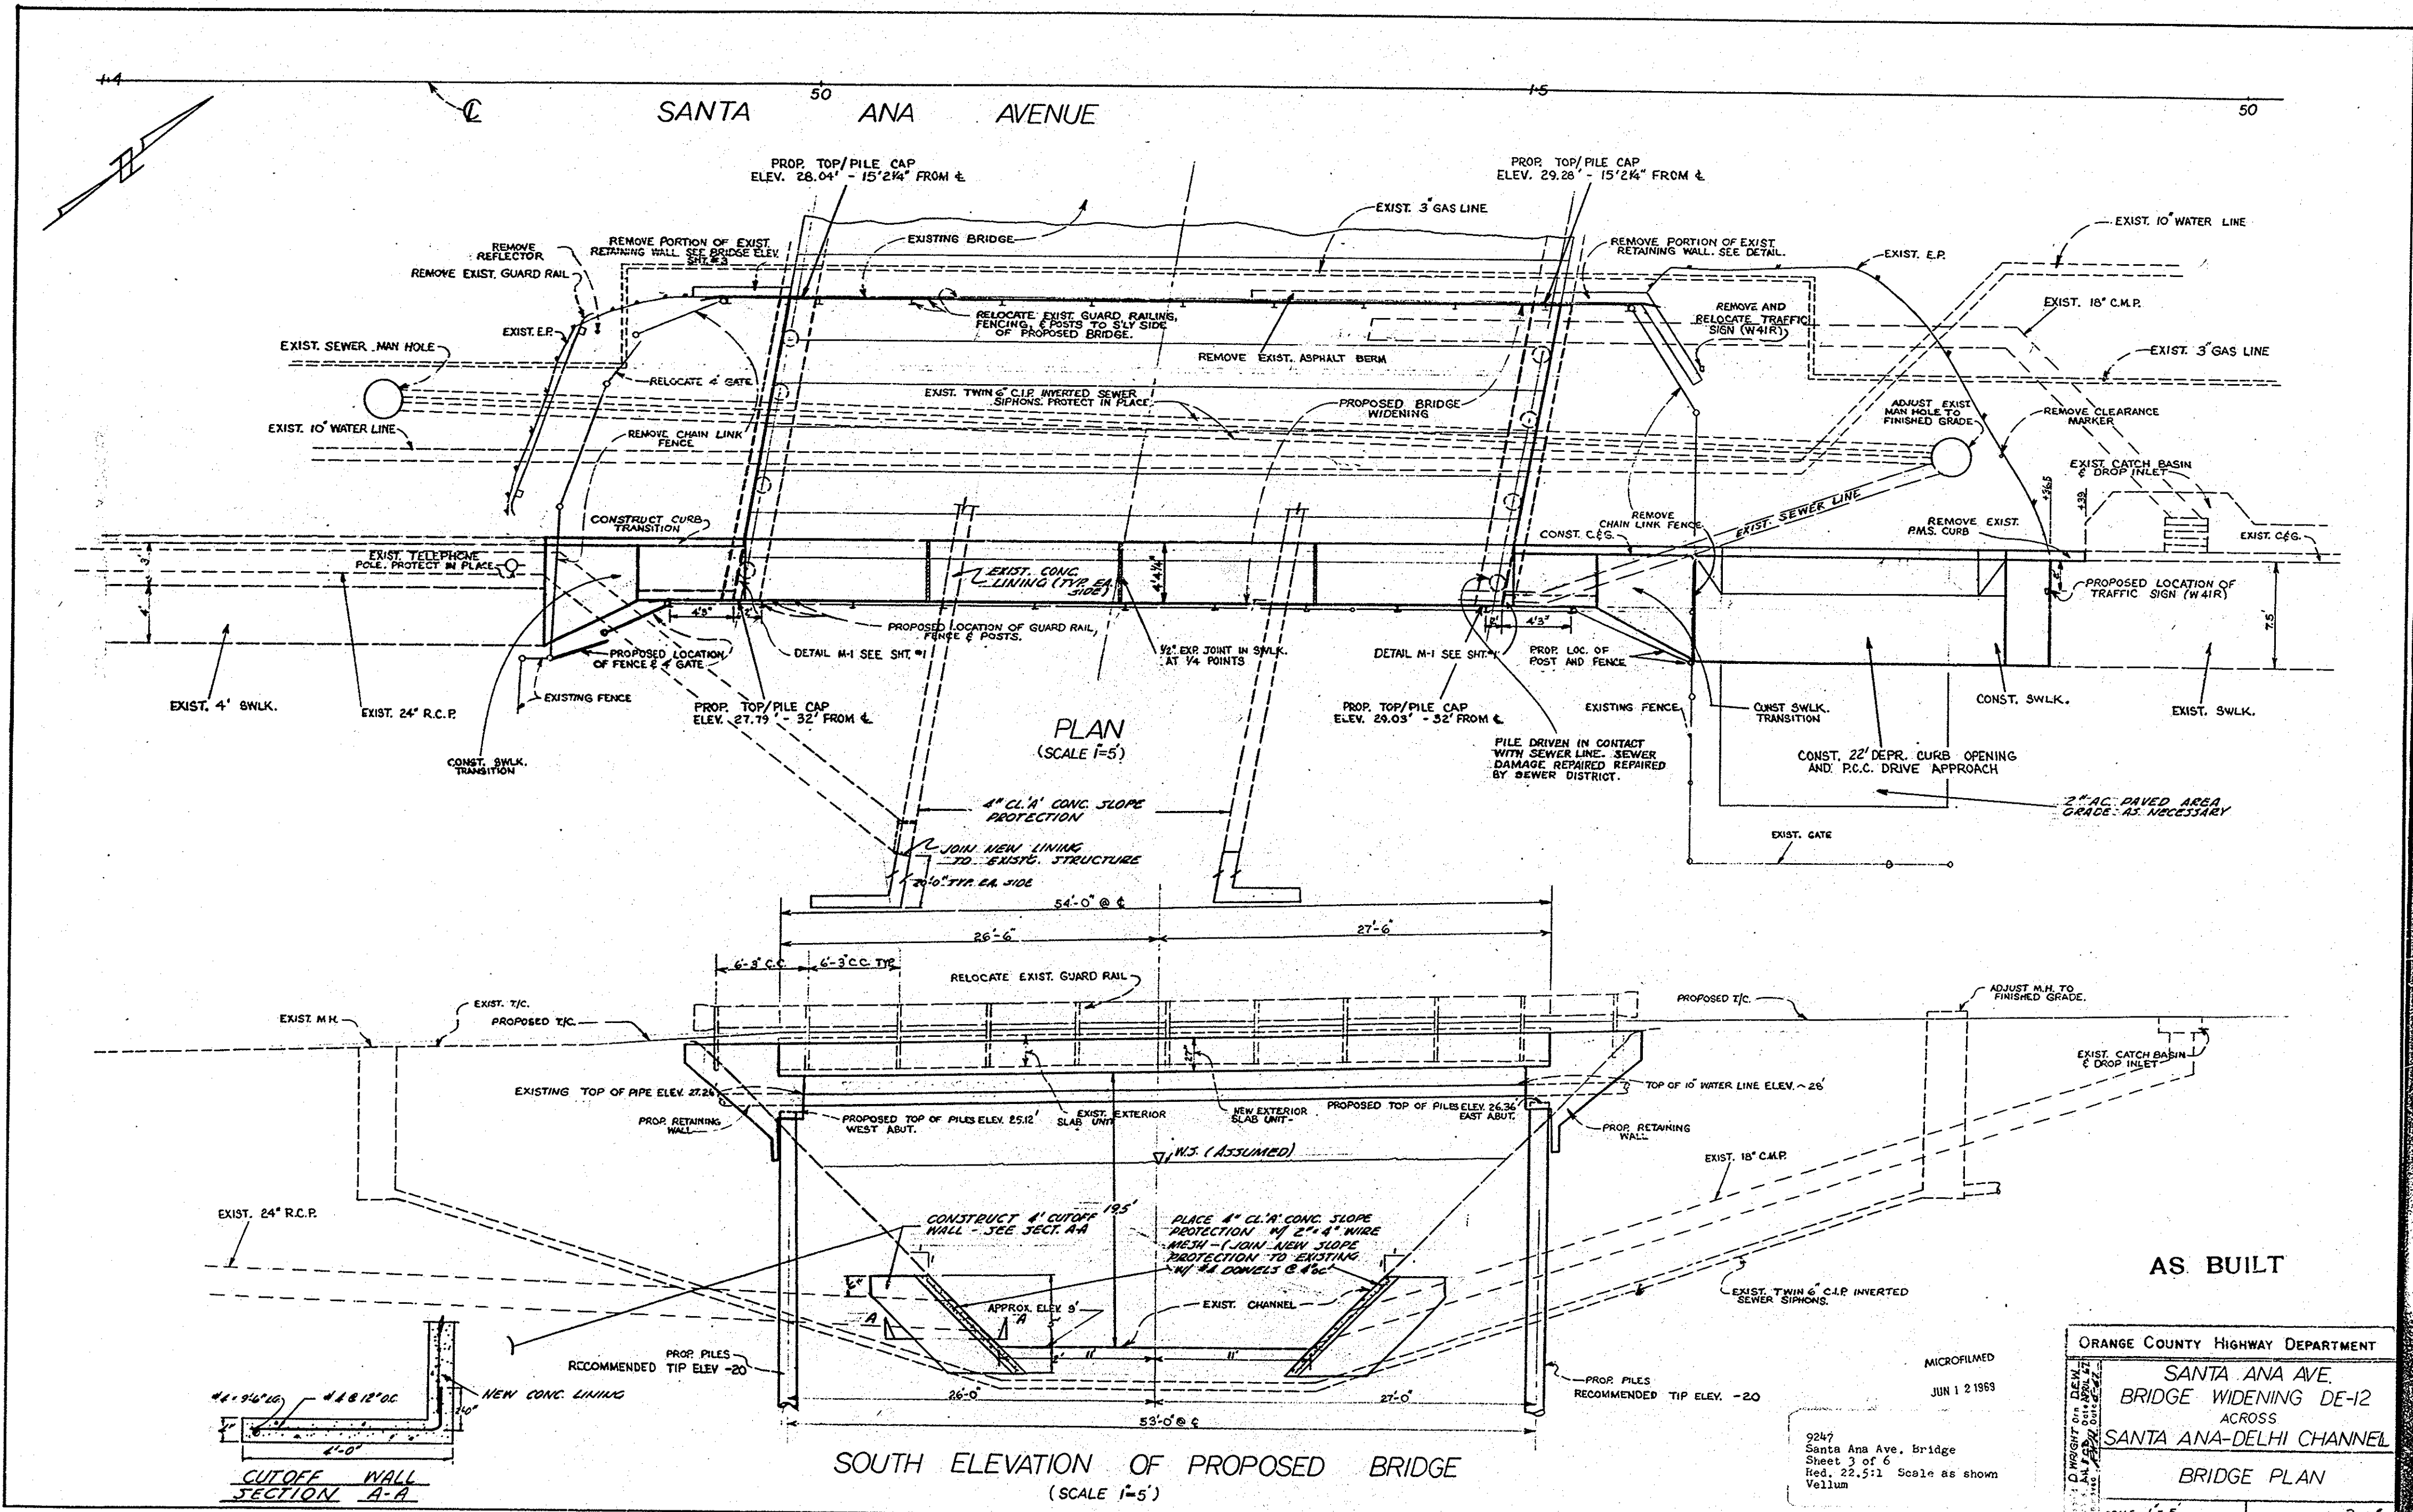


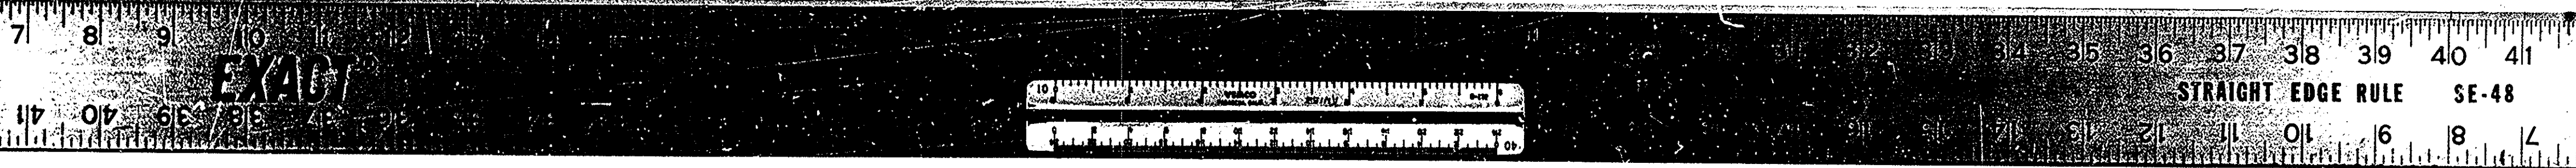

AS BUILT

ORANGE COUNTY HIGHWAY DEPARTMENT
SANTA ANA AVE.
BRIDGE WIDENING DE-12
ACROSS
SANTA ANA-DELHI CHANNEL
BRIDGE PLAN
SCALE 1"=5'
SHEET 3 OF 6

9247
Santa Ana Ave. Bridge
Sheet 3 of 6
Red. 22.5:1 Scale as shown
Vellum

MICROFILMED
JUN 12 1989

Rev. 17 (9247)