


ORANGE COUNTY ROAD DEPT.


STATE OF CALIFORNIA

PLANS FOR WIDENING OF SANTA ANA AVE. BRIDGE


DE - 12 \Rightarrow ~~DE - 12A~~
ACROSS FLOOD CONTROL CHANNEL FO I

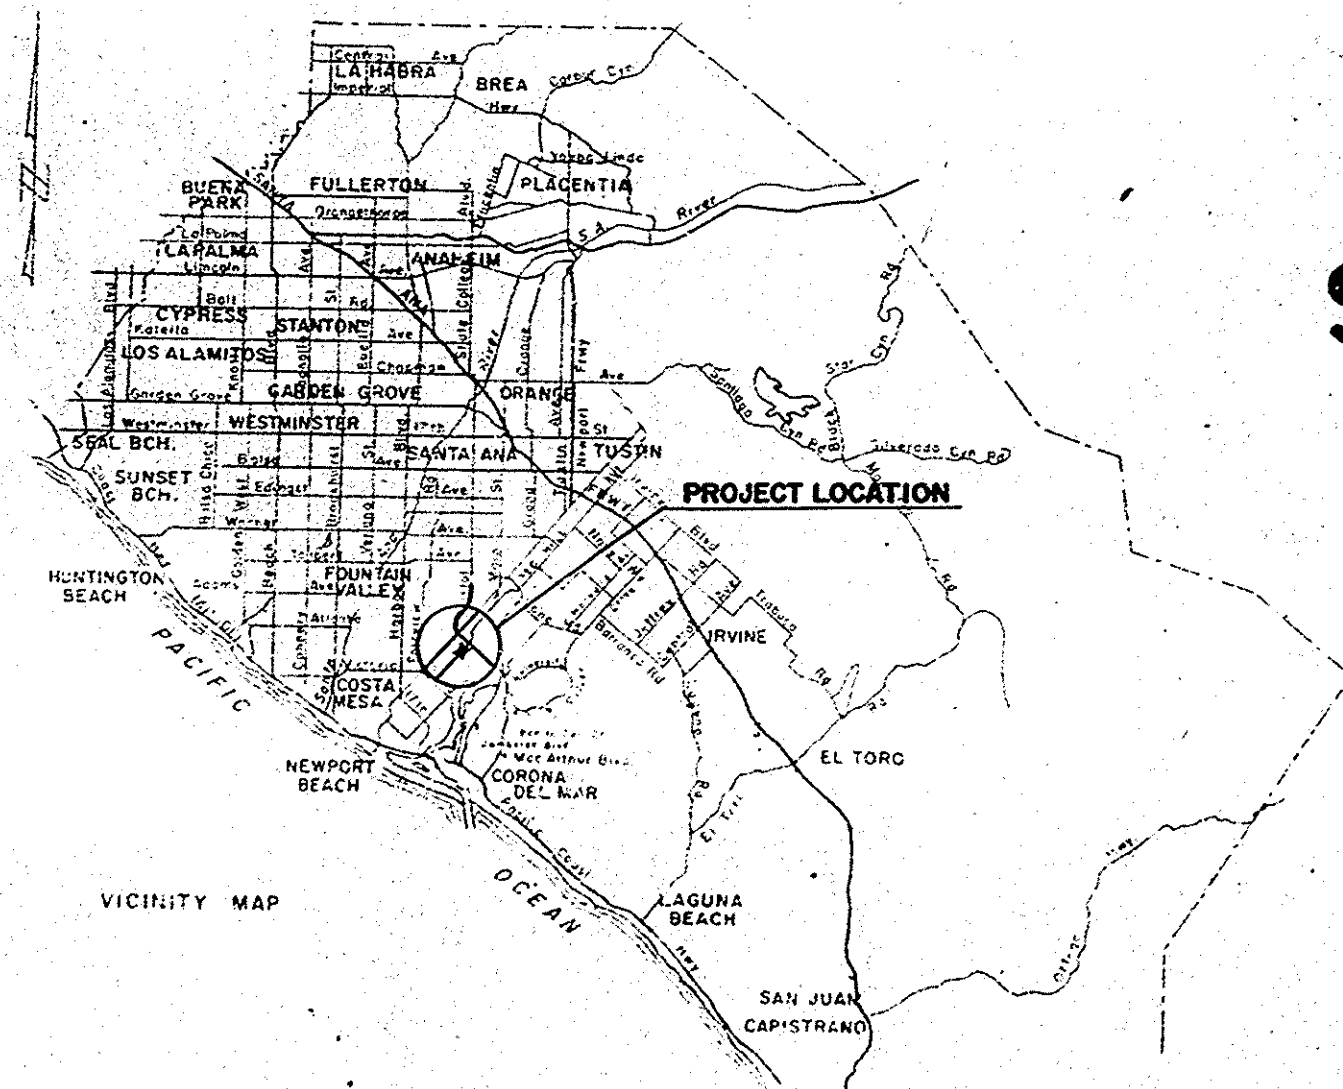

Sheet No	Description
1	TITLE SHEET
2	GENERAL PLAN
3	BRIDGE PLAN
4	MISCELLANEOUS DETAILS
5	GUARD RAIL & FENCE DETAILS
6	PILE DETAILS

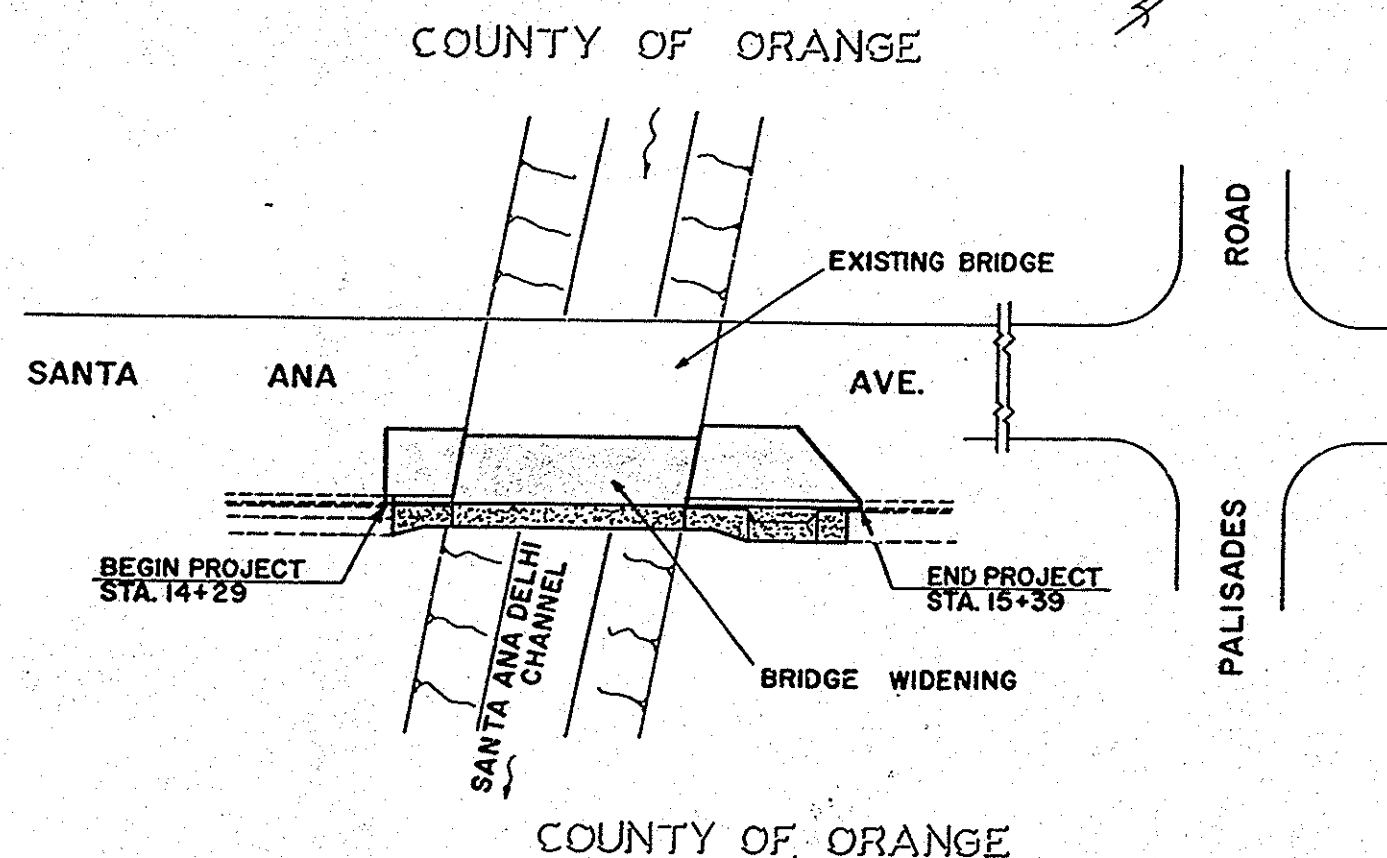

ALL WORK WITHIN THE FLOOD CONTROL DISTRICT RIGHT OF WAY SHALL BE PERFORMED IN ACCORDANCE WITH THE PROVISIONS OF THE CONSTRUCTION PERMIT GRANTED BY ORANGE COUNTY FLOOD CONTROL DISTRICT AND THE PLANS STAMPED WITH THE APPROVAL OF ORANGE COUNTY FLOOD CONTROL DISTRICT. CONTRACTOR SHALL HAVE A COPY OF SAID PERMIT AND STAMPED PLANS ON THE JOB SITE.

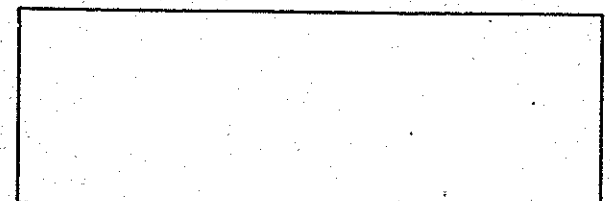

CONVENTIONAL SIGNS

1. 10' X 10' SIGN	2. 10' X 10' SIGN
3. 10' X 10' SIGN	4. 10' X 10' SIGN
5. 10' X 10' SIGN	6. 10' X 10' SIGN
99. 10' X 10' SIGN	100. 10' X 10' SIGN



AS BUILT

MICROFILMED
JUN 1 2 1968


9247
Santa Ana Ave. Bridge
Sheet 1 of 6
Std. 22.511 Scale as shown
Date

APPROVED: *[Signature]* 5-24-67
ROAD COMMISSIONER R.G.E. 7872 DATE


Rev. 17 (9247) # 9247; 1968
SANTA ANA AVE BR. WIDENING
DE-12A over Santa Ana Delhi
55C-205, Thomas 859-D2

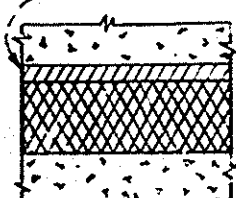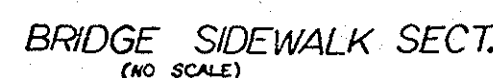

DETAIL M-1
SLIDING JOINT

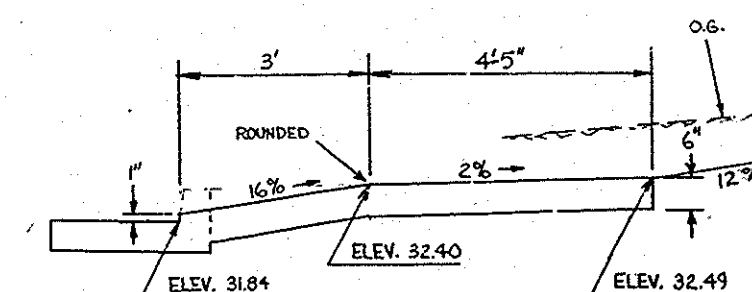

SECT AA - DRIVE APPROACH
STA - 15+21
(SCALE 1"=2')

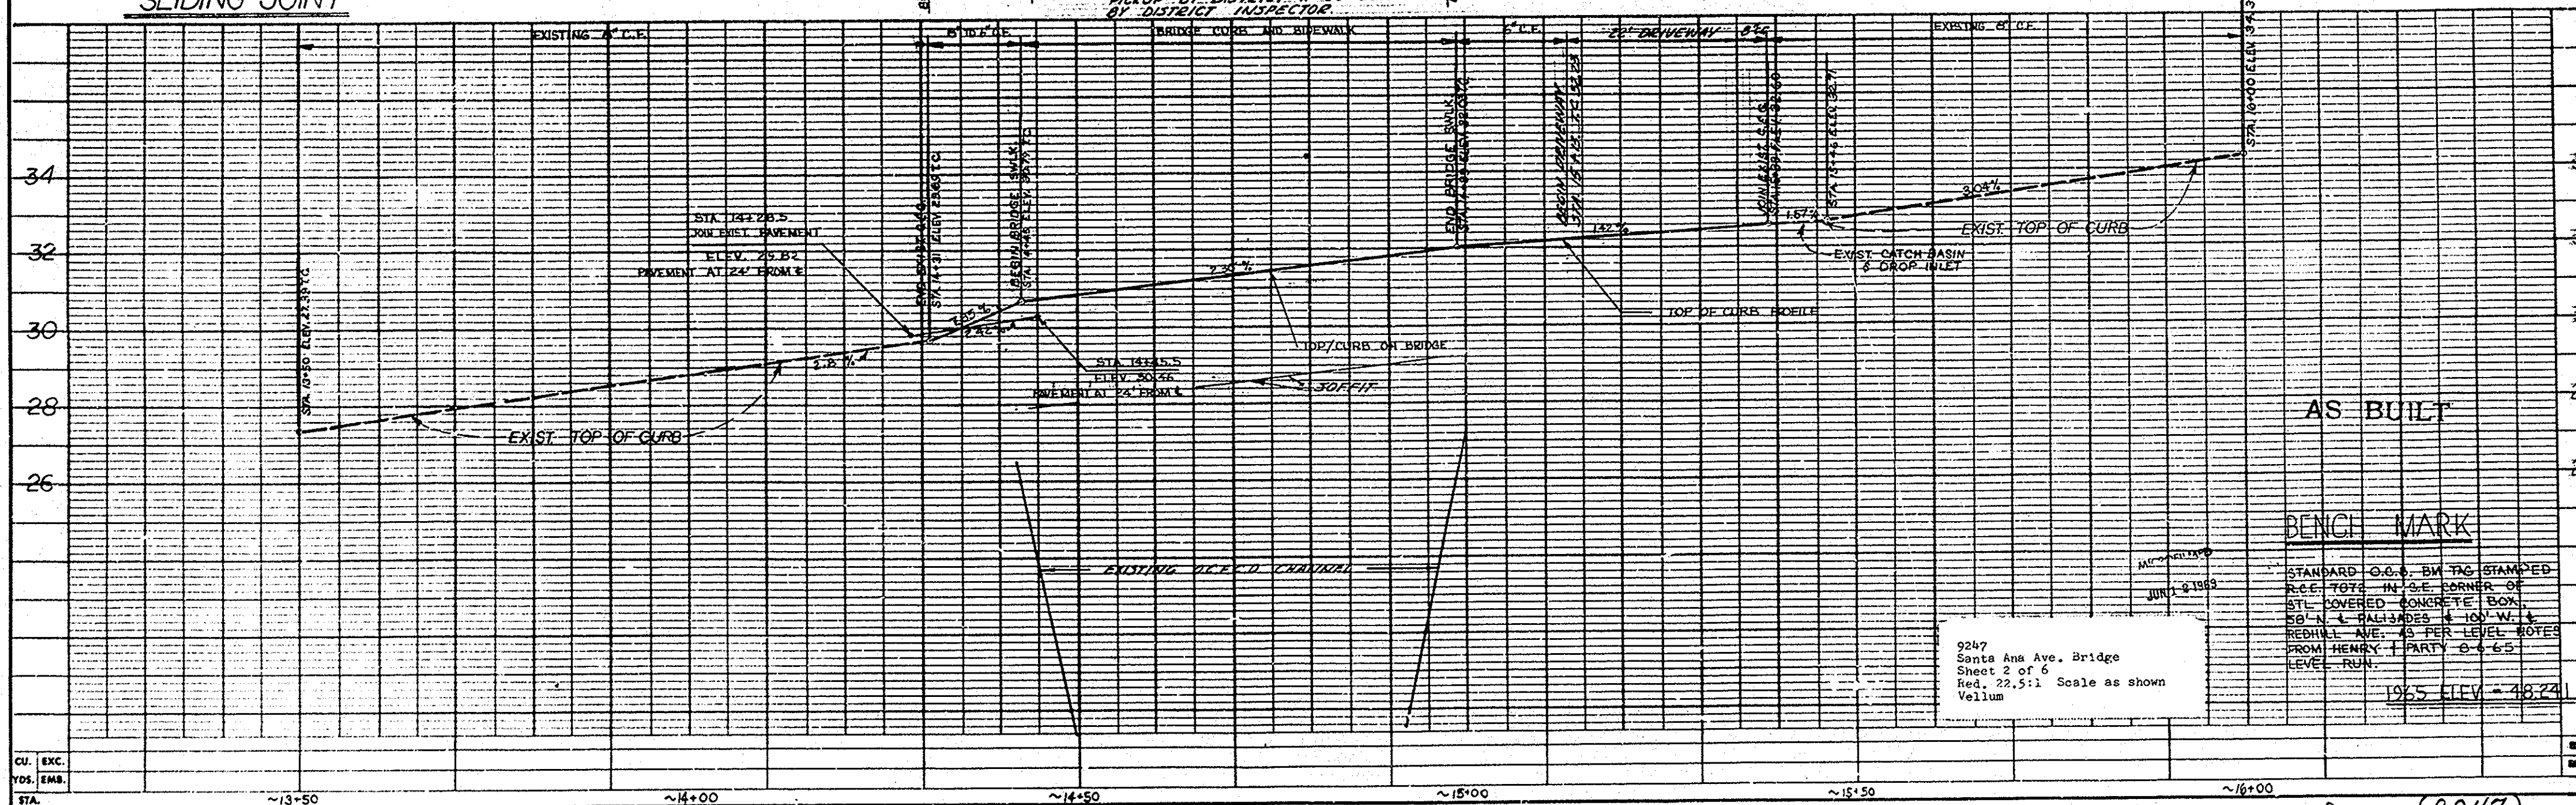

AS BUIL



BENCE MARI

STANDARD O.C.O. BM TAG STAMP EE
R.C.C. TOTE IN S.E. CORNER OF
STL COVERED CONCRETE BOX.
58' N. + 14134DES + 100' W. +
REDHILL AVE. AS PER LEVEL NOTE
FROM HENRY + PARTY O-6-65
LEVEL RUN.

F9%5 ELEV = 418.2

9247
Santa Ana Ave. Bridge
Sheet 2 of 6
Red. 22.5:1 Scale as shown
Vellum

Dr. 17 (9247)

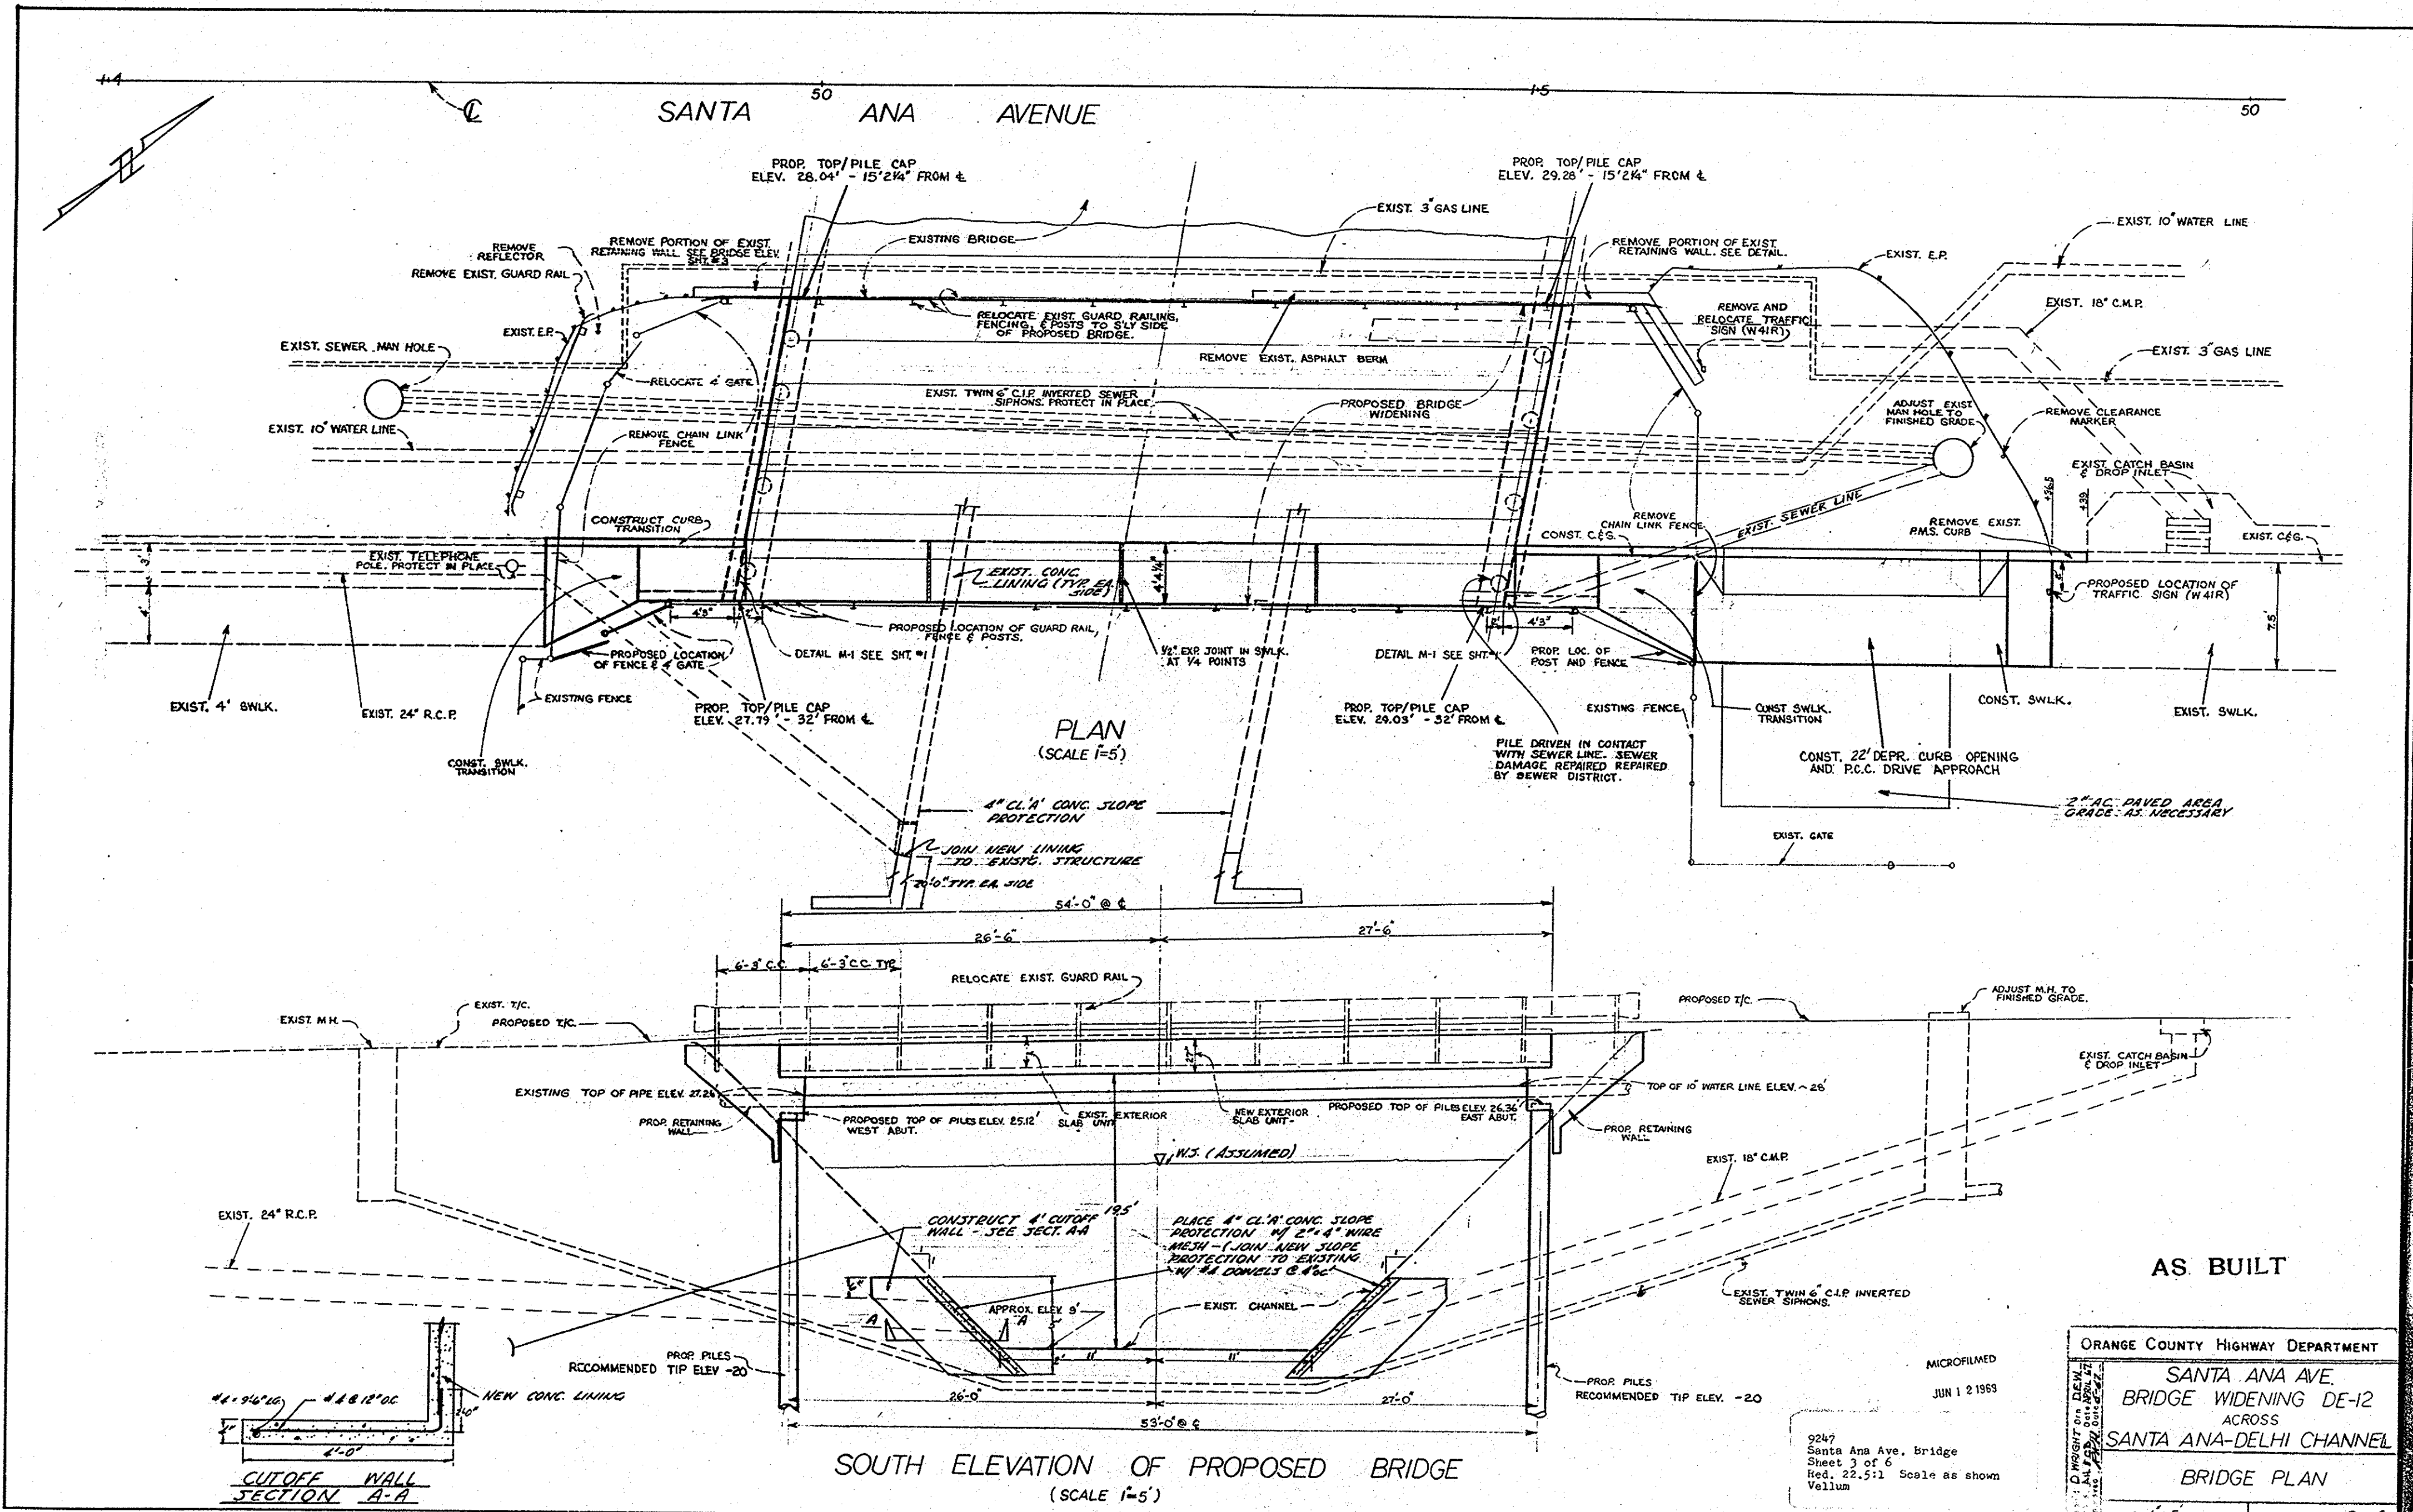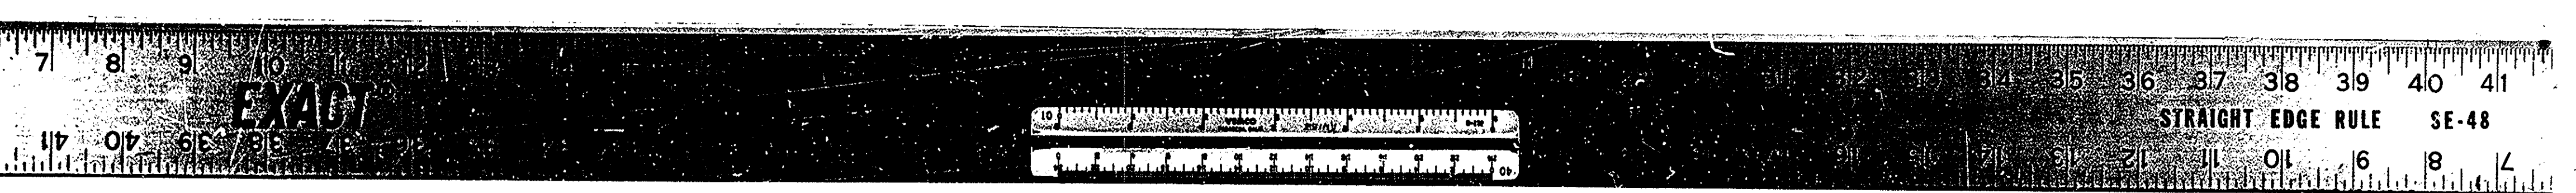

AS BUILT

ORANGE COUNTY HIGHWAY DEPARTMENT
SANTA ANA AVE.
BRIDGE WIDENING DE-12
ACROSS
SANTA ANA-DELHI CHANNEL
BRIDGE PLAN

MICROFILMED
JUN 12 1989














9247
Santa Ana Ave. Bridge
Sheet 3 of 6
Red. 22.5:1 Scale as shown
Vellum

SCALE 1"=5' SHEET 3 OF 6

Rev. 17 (9247)

EXACT

STRAIGHT EDGE RULE SE-48

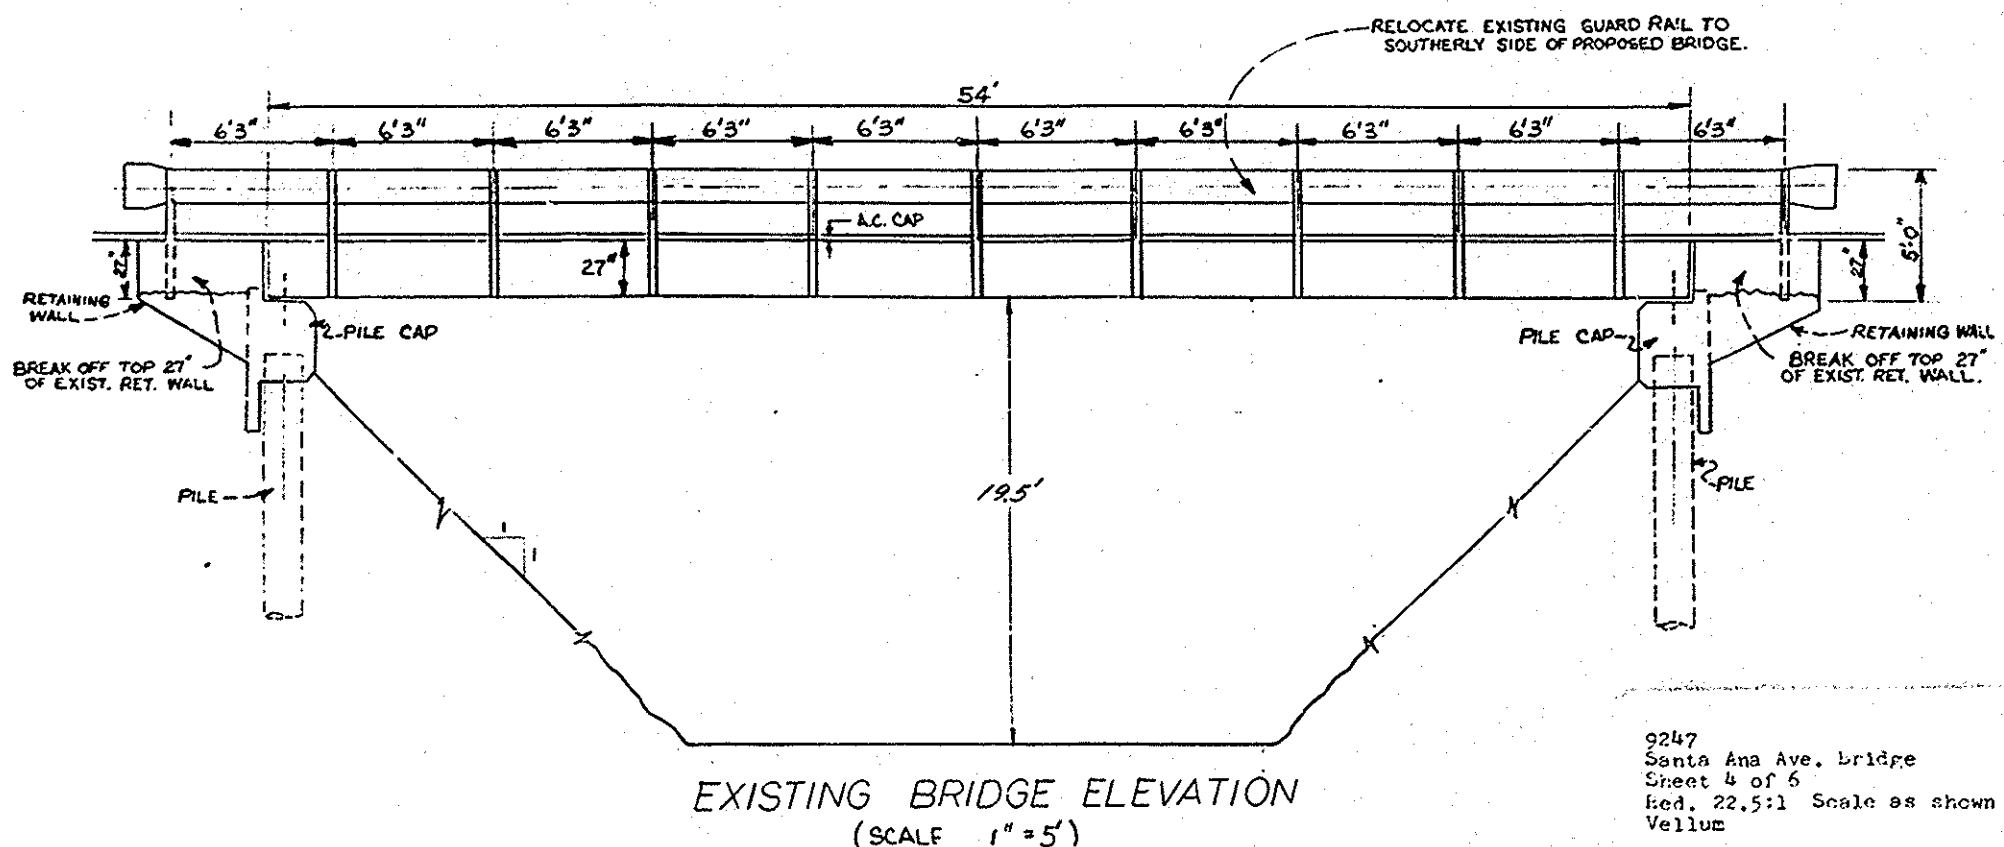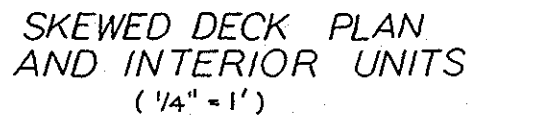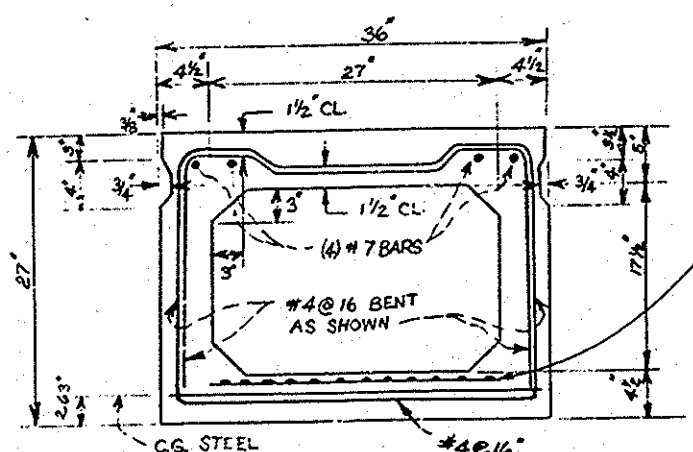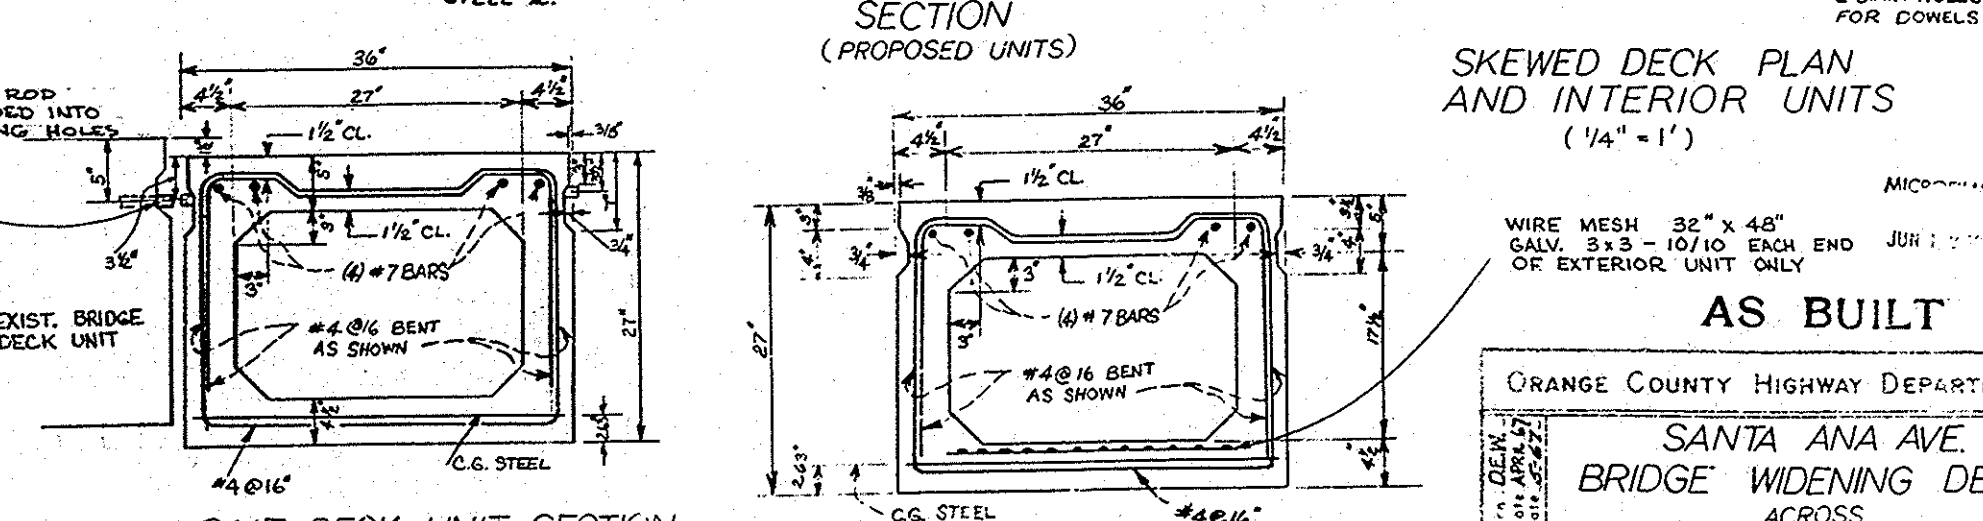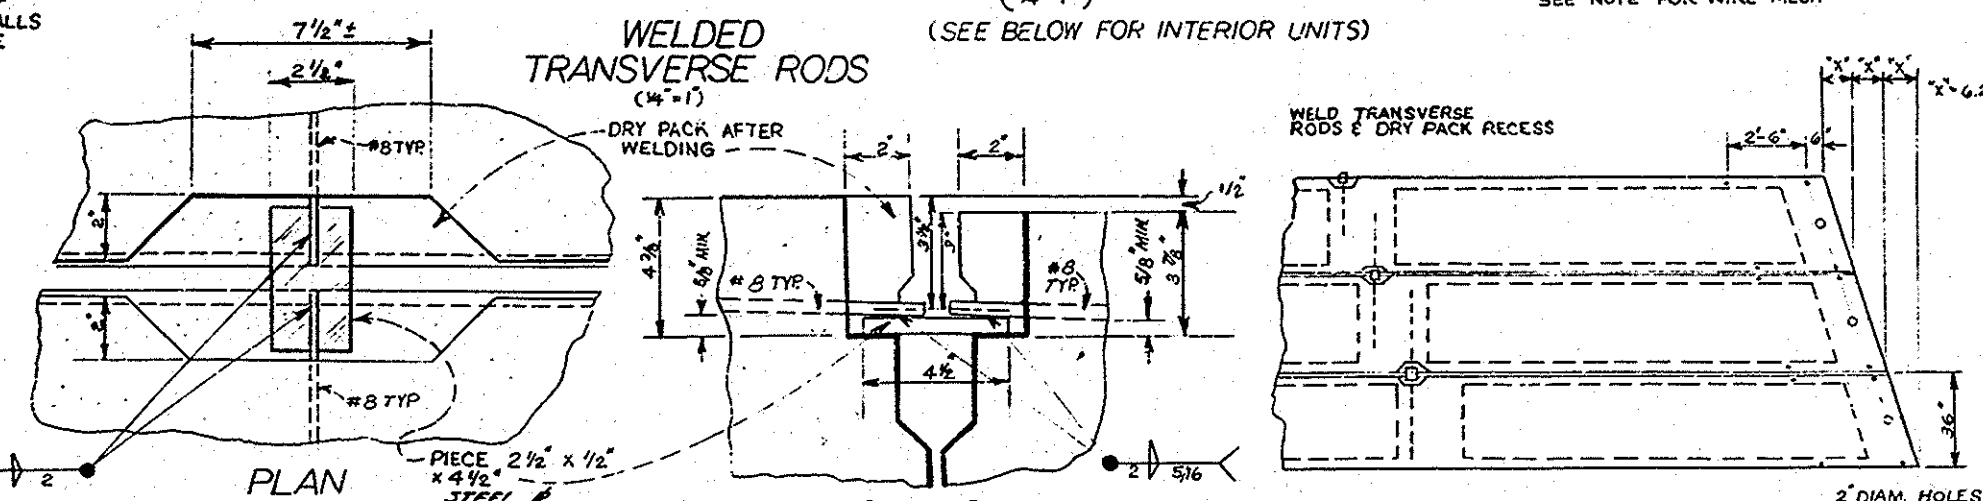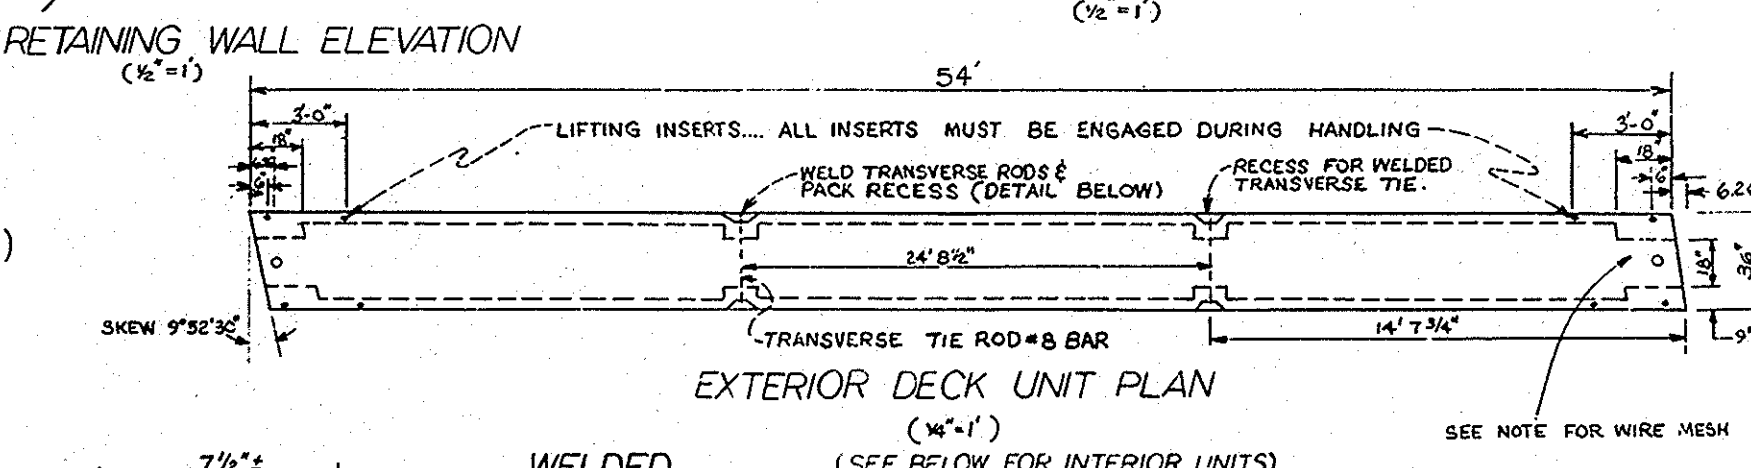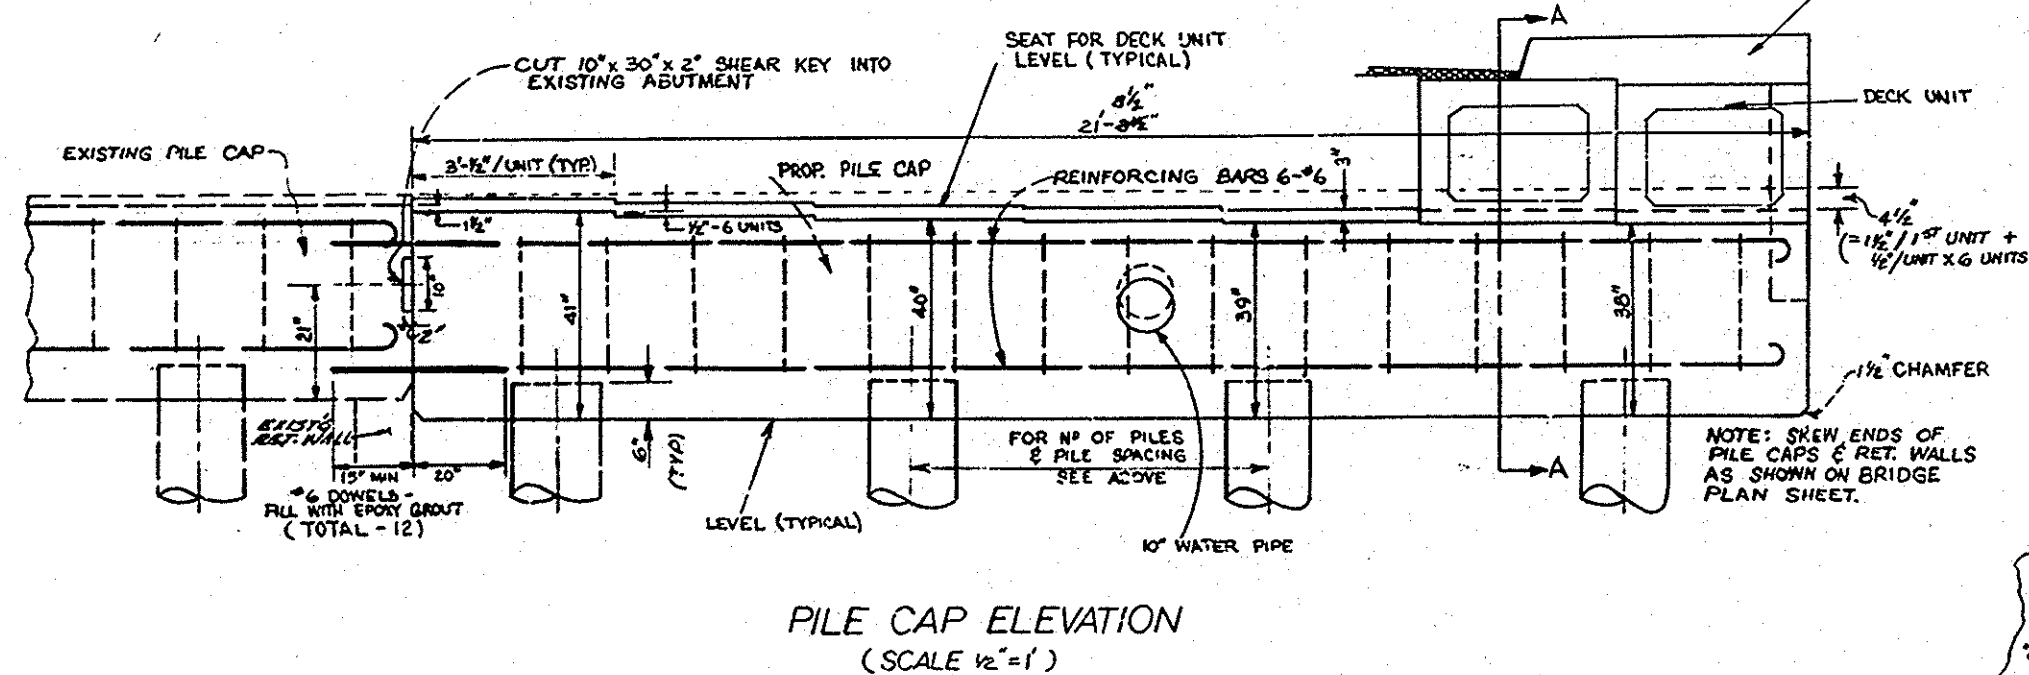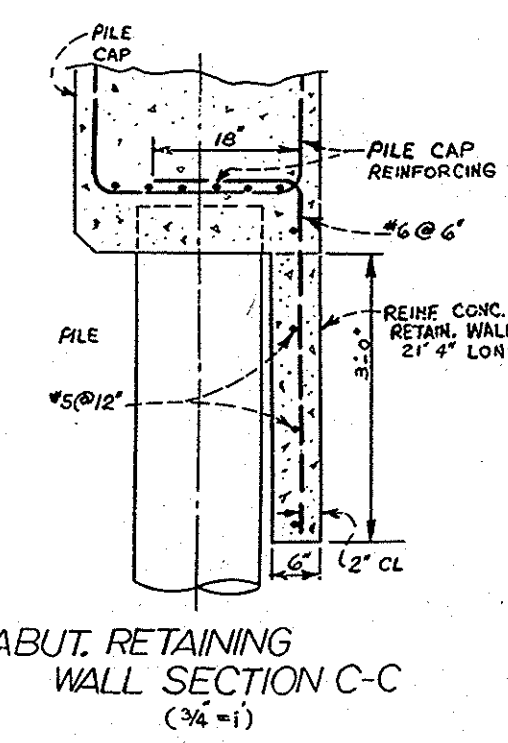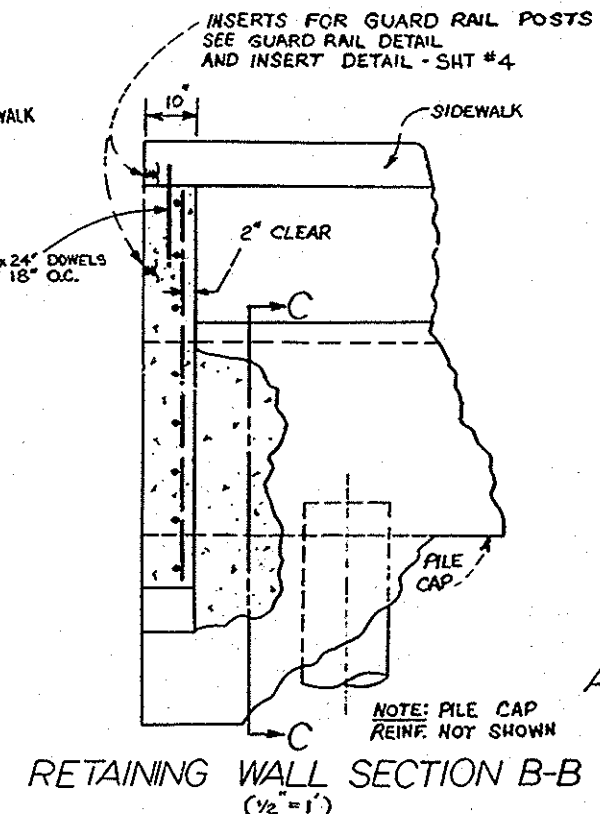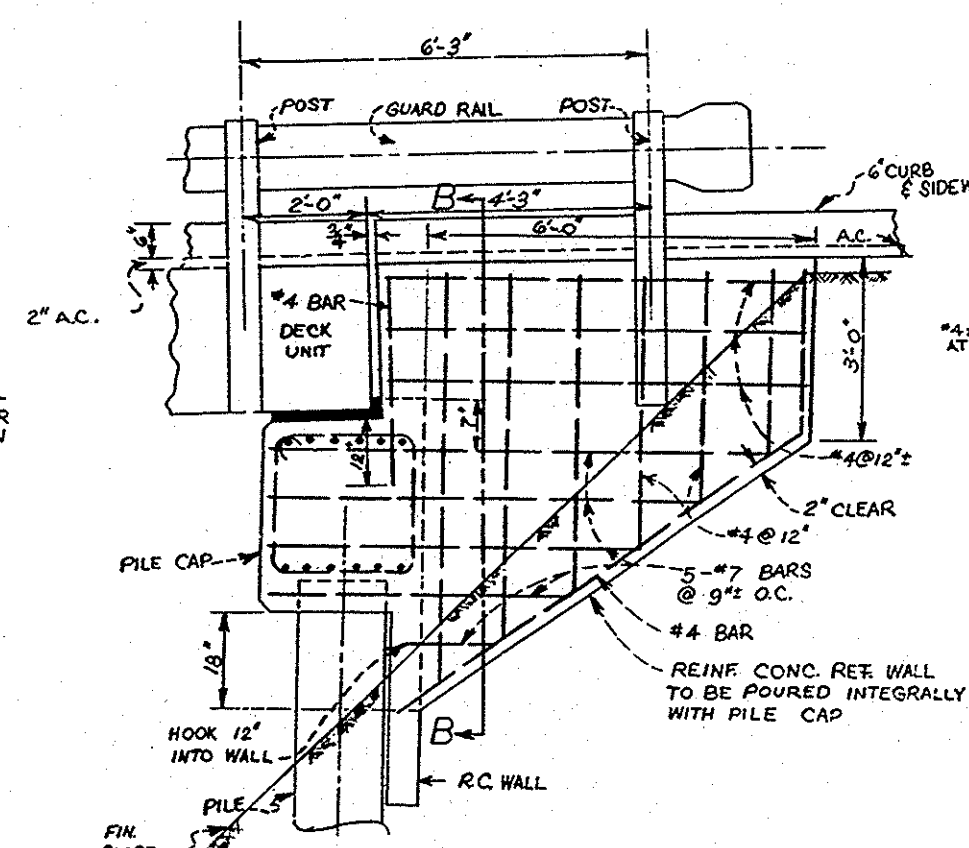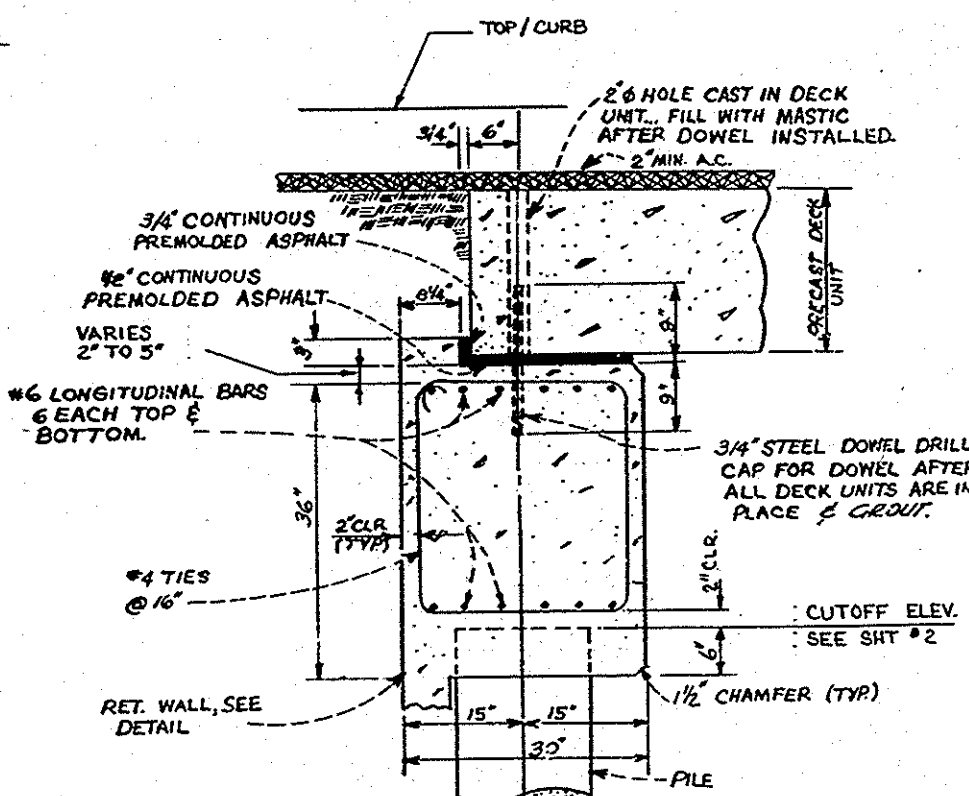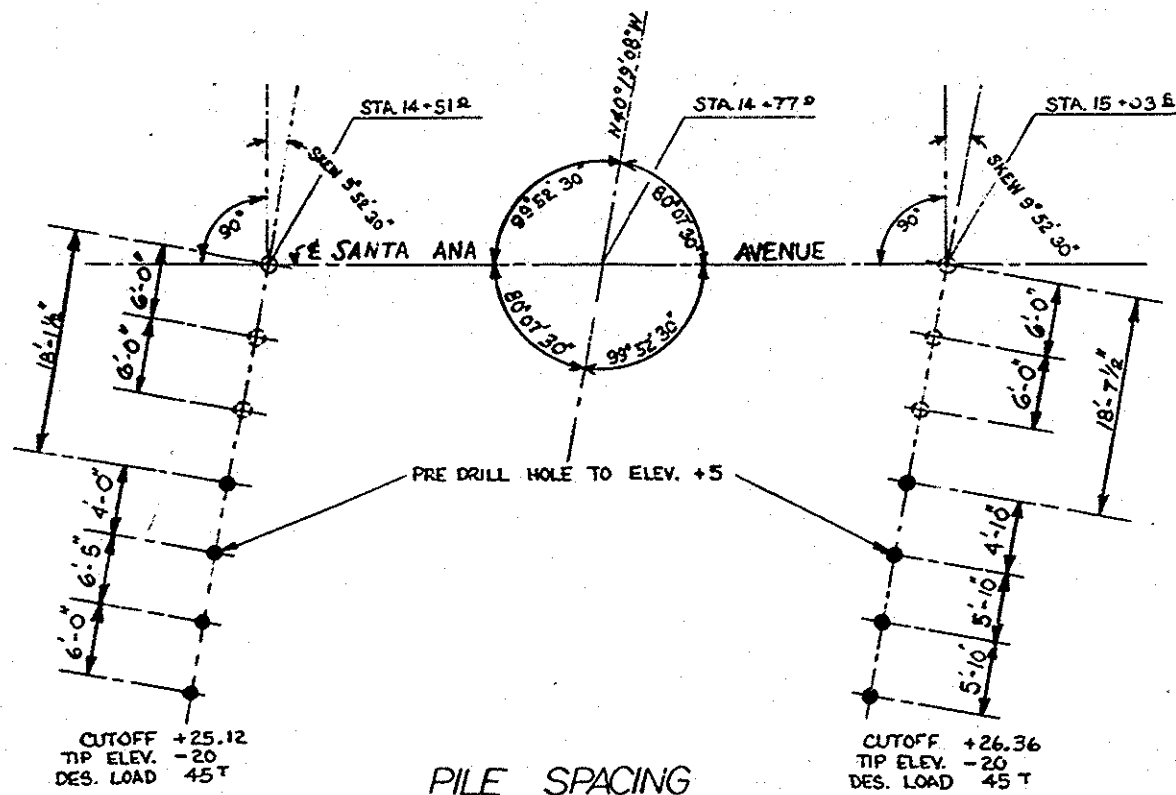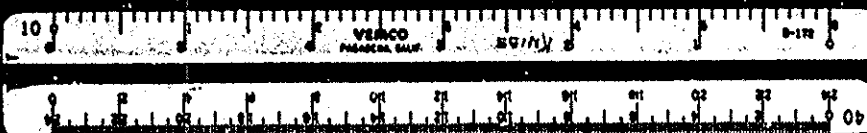

PRETENSIONED - PRESTRESSED - PRECAST DECK UNITS							
TOTAL NO. DECK UNITS	LENGTH L	DEPTH d	DIST. A TO CGS	DESIGN MOMENT	PRESTRESS DESIGN FORCE	BASIC WEIGHT	CONCRETE COMP. STRENGTH
7	54'	27"	2.63	6264 K'	353 K	3,600"	5000 psi

9247
Santa Ana Ave. Bridge
Sheet 4 of 6
Feb. 22, 1971 Scale as shown
Vellum

NOTE: 7 DECK UNITS ARE REQUIRED FOR THE WIDENING - 6 UNITS HAVE SHEAR KEY DETAILS AS SHOWN TO THE RIGHT AND ONE UNIT IS DETAILED AS SHOWN ABOVE.


WIRE MESH 32" x 48" GALV. 3x3 - 10/10 EACH END OF EXTERIOR UNIT ONLY

AS BUILT

ORANGE COUNTY HIGHWAY DEPARTMENT
SANTA ANA AVE.
BRIDGE WIDENING DE-12
ACROSS
SANTA ANA-DELHI CHANNEL
MISCELLANEOUS DETAILS

SCALE AS SHOWN SHEET 4 OF 6

Rev. 17 (9247)

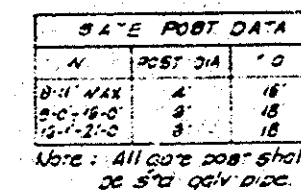


All bolts to have cut washers unless otherwise noted.

Paint entire unit white. See Special Provisions.


All timber to be S4S.

Remove bolts and fill holes with grout when railing is no longer needed.

TEMPORARY GUARD RAIL EXTENDS FROM
STA. 14+36 TO STA. 15+24

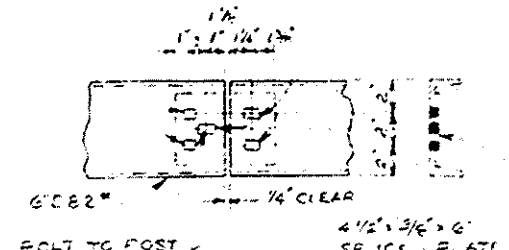


EXISTING CHANNEL SLOPE

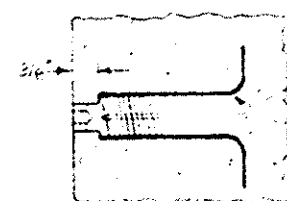


2-3/4" SINGLE SPIDER INSERTS
FOR EACH POST SAFE TENSION
RATING TO BE 6000* FOR 3/4"
SPIDER
INSERTS TO BE RICHMOND AS SOLD
BY W. J. E. RICE & CO OR APPROVED EQ. AL

USE ON APPROACHES

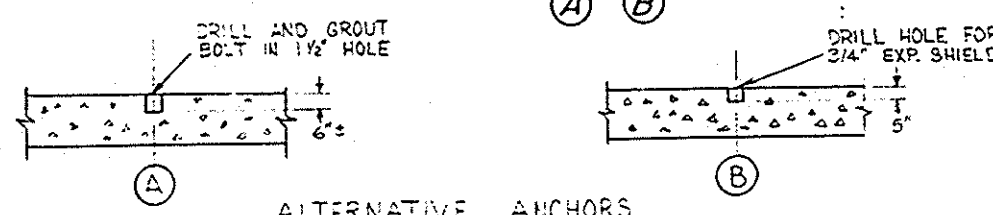


ALTERNATIVE ANCHORS

TEMPORARY RAILING (METAL BEAM)

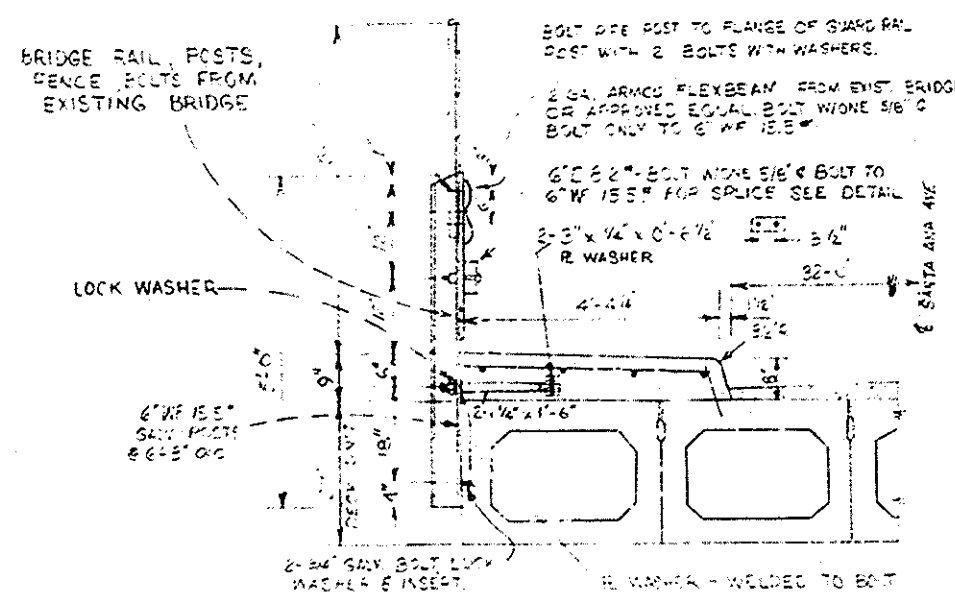

GUARD RAIL OF TAIL
(S&W)

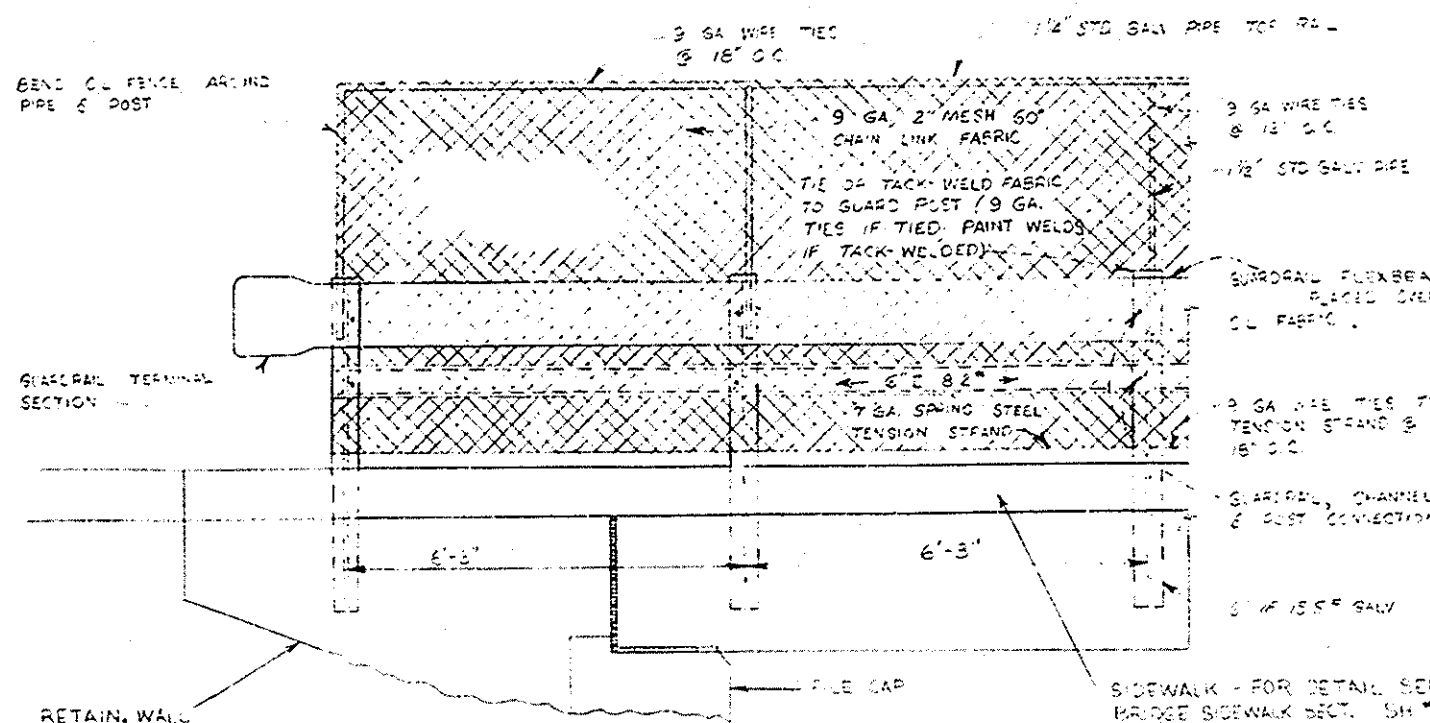

EPISODE FOUR: ALL E FIVE LEFT

GENERAL NOTES

1. All metal parts of all type fences and gates, including fences, fabric and barbed wire shall be new, hot material.
2. See list pipe shall be of following min. weights to be galv.

No. Dia.	Wt./ft.	No. Dia.	Wt./ft.
1 1/2"	165#	2 1/2"	575#
1 1/4"	224#	4"	1075#
1 1/2"	272#	6"	1897#
3"	365#		

3. THE FENCING ON BRIDGES, SIDEWALLS, AND KICKWALLS SHALL BE INSTALLED IN SUCH A MANNER THAT THERE ARE NO OPENINGS OR GAPS WHICH IN THE OPINION OF THE ENGINEER, COULD BE HAZARDOUS.
4. All gate hinges are of heavy duty malleable iron or steel, industrial service type, 180 degree swing, of approved quality and design.
5. Ground shall be graded before fence construction begins. Bottom of fence shall be heaviest and above ground surface. Excess of 3 inches above ground depressions properly placed compacted fill, by placing additional fabric or by installation of additional posts as directed by the Engineer.
6. Unless otherwise shown on the plans, Contractors shall construct fence with fabric 0.2' inside of R/W Line.

AS BUILT


JUN 1 2 1969

DELA
ANNA
BRIDGE WIDEWAY DEL
ACROSS
SANTA ANA-DELHI CHANNEL
GUARD RAIL
AND FENCE SET


100.17 (9241)

EXACT®


STRAIGHT EDGE RULE SE-48

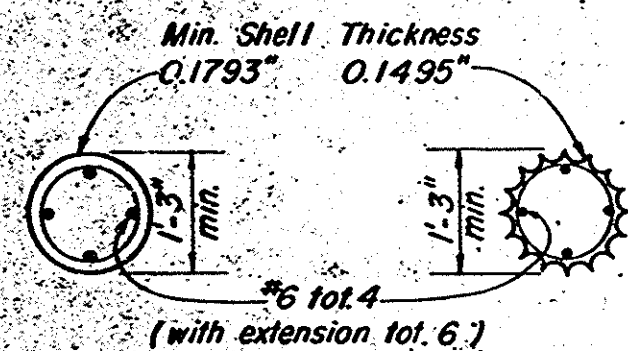


U-U

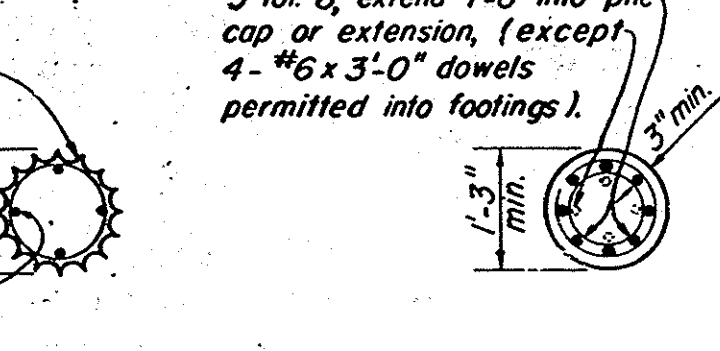

V-V

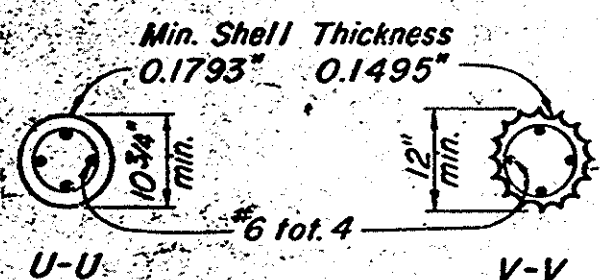

U-U

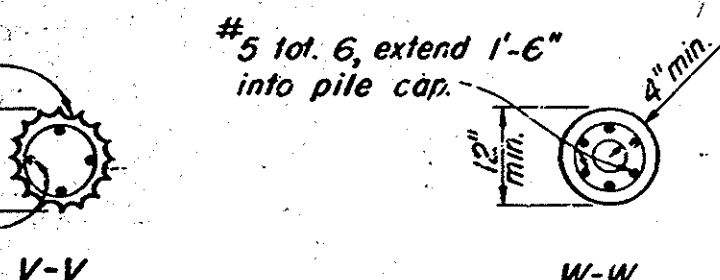


V-V

#5 tot. 8, extend 1'-6" into pile cap or extension, (except 4- #6 x 3'-0" dowels permitted into footings).

#5 tot. 6, extend 1'-6" into pile cap.


W-W

W-W

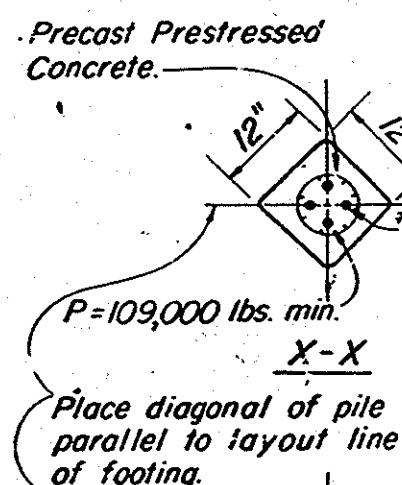


X-X

X-X

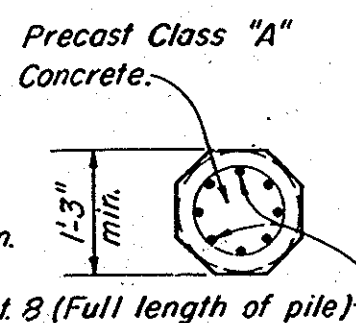


Y-Y


CLASS I PILES

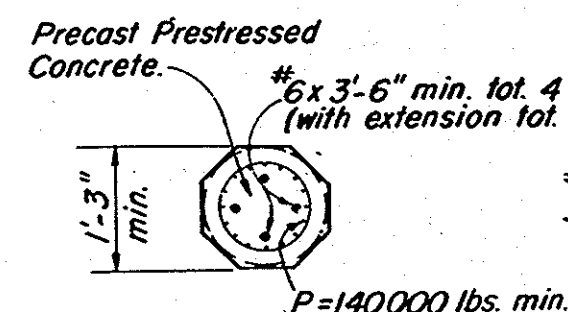

Y-Y

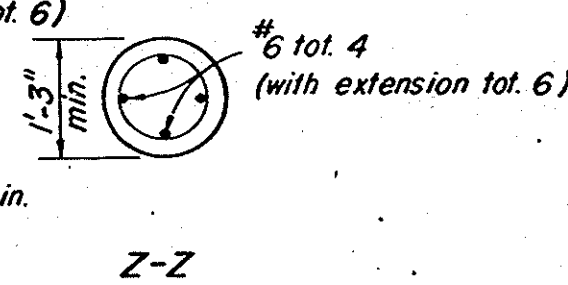


Z-Z

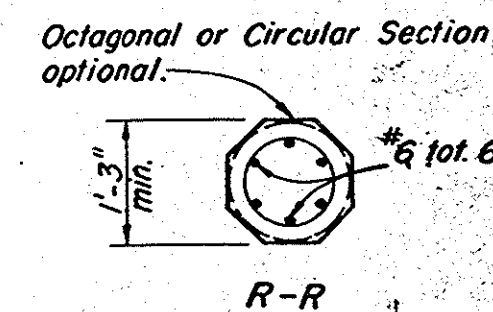


R-R


NOTE: When "ALTERNATIVE U" is driven with mandrel, shell thickness may be reduced to 0.1196"

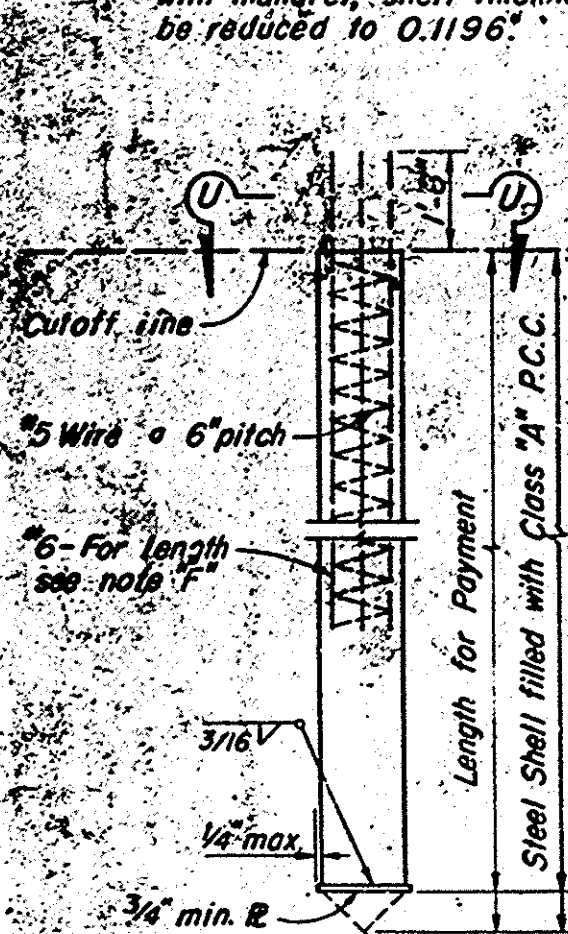


ALTERNATIVE "U"

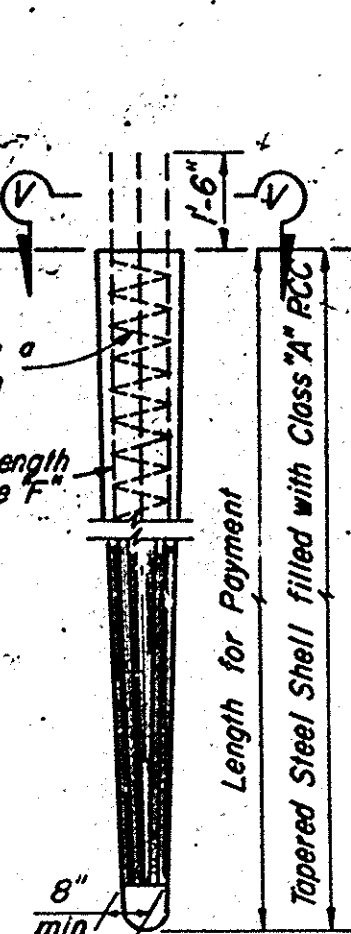


ALTERNATIVE "V"

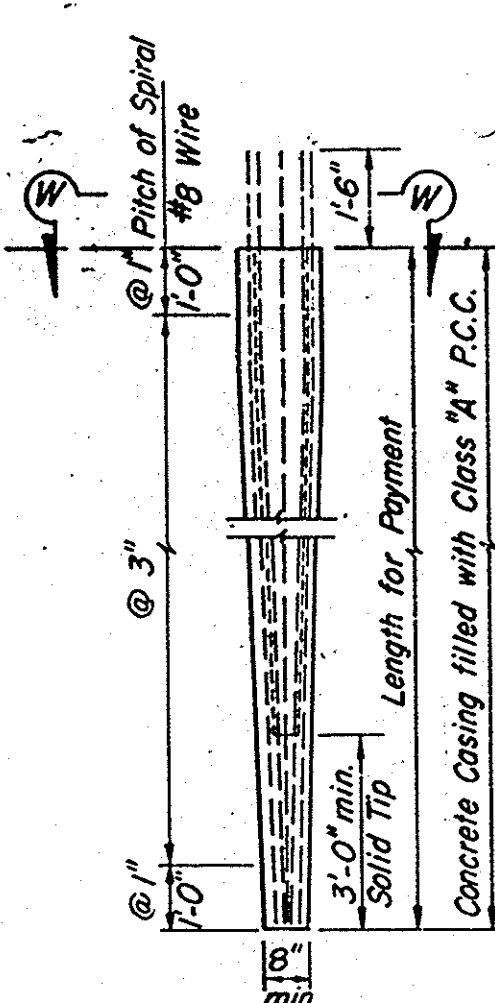

ALTERNATIVE "W"

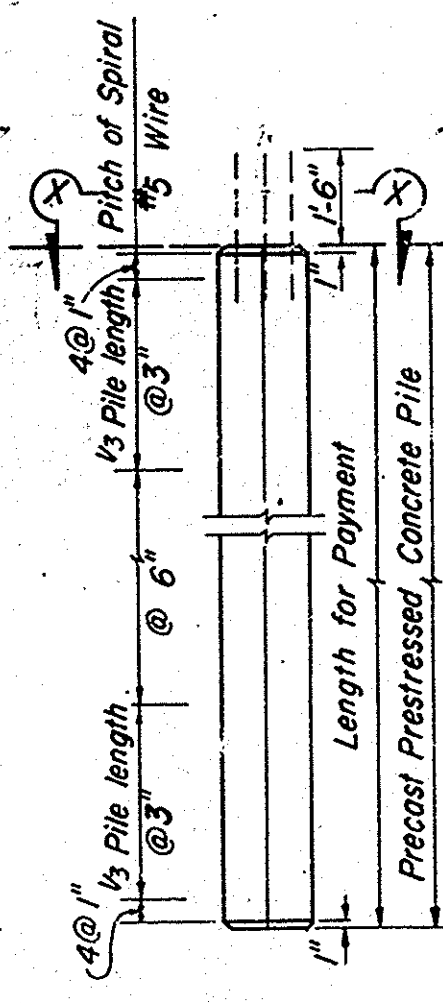


ALTERNATIVE "X"

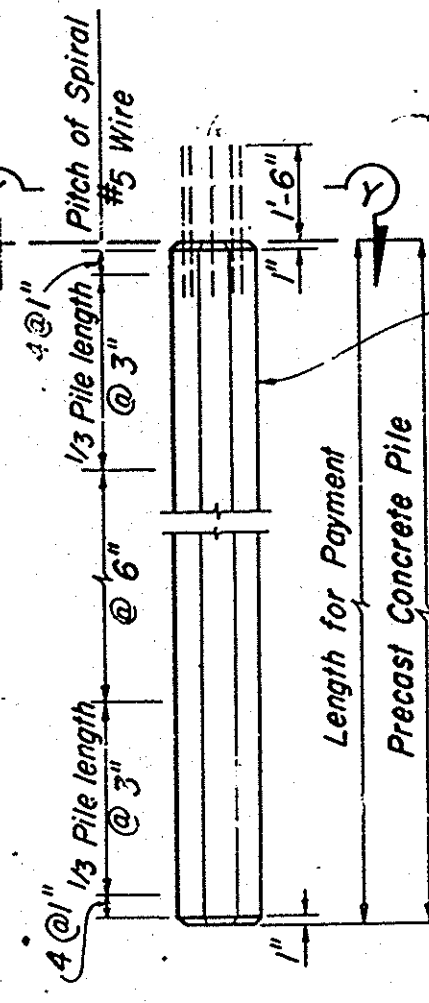

ALTERNATIVE "Y"


Octagonal or Circular Section, Optional.

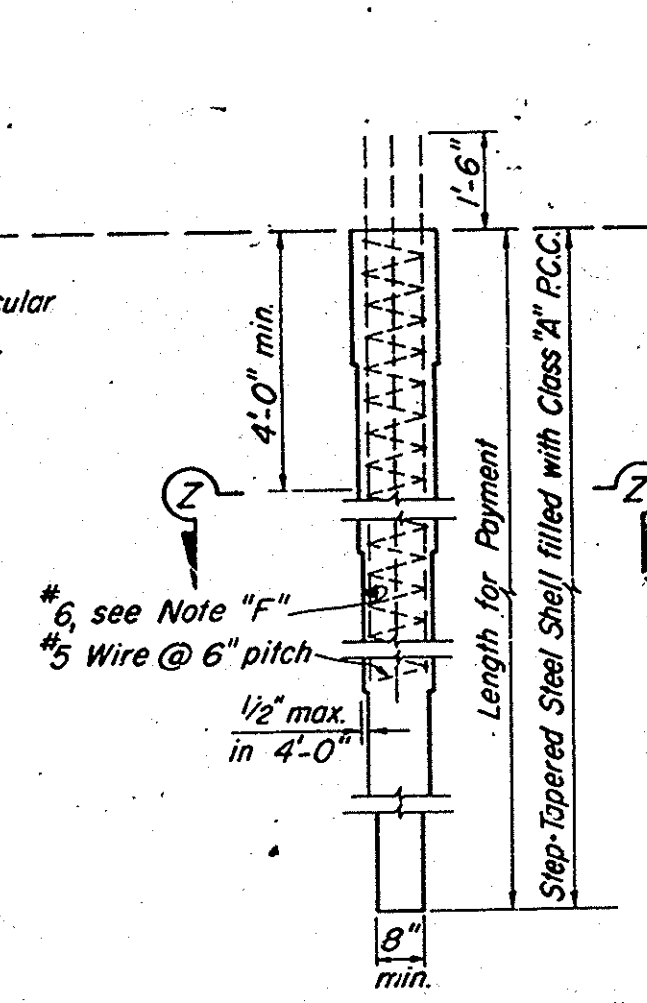

ALTERNATIVE "Z"

10" min. dia. pipe extension may be used at the tip when step taper is 30' or more in length.

Minimum thickness of pipe extension = 0.1793"

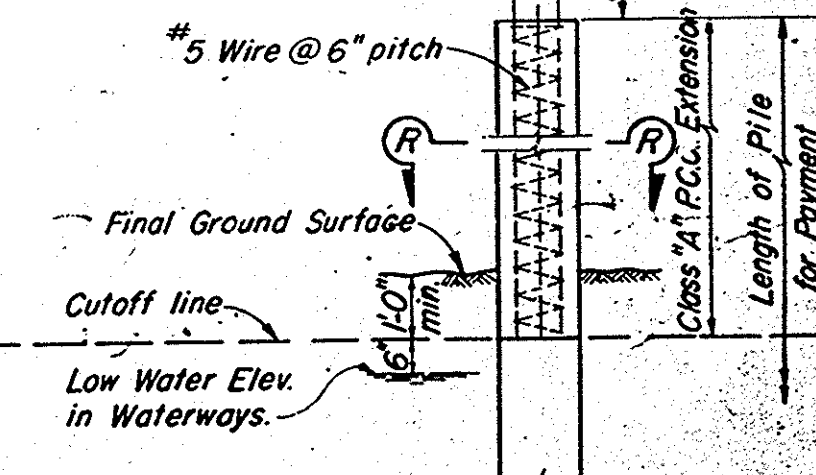

PILE EXTENSION "R"

Permitted with Class I Piles only

PILE NOTES

Alternatives "W" & "Y" may be driven full length or may be extended. All exposed piles or pile extensions shall be consistent in cross-section throughout the project.

Alternatives "X" & "Y" (Precast Prestressed)
P = Prestressing Force (after losses)
Concrete stress:
f_{ci} = 6,000 p.s.i. (Alt. "X"); 4,500 p.s.i. (Alt. "Y") @ 28 days
f_{ci} = 3,500 p.s.i. @ transfer (3/8" strand)
f_{ci} = 4,000 p.s.i. @ transfer (7/16" strand and 1/2" strand)
Note: In Alternatives "U", "V", & "Z" the #6 bars shall extend a minimum of 12' below the lowest of the following:

1. Bottom of footing.
2. Top of final ground surface.
3. Top of original ground surface when piles are driven through fills.

Class I Piles may be substituted for Class II Piles.

Unless indicated to the contrary all piles shall be Class I Piles.

Alternative "X" may not extend above ground line nor be used with Pile Extension "R".

DESIGN LOADING = 45 TONS

AS BUILT

9247
Santa Ana Ave. Bridge
Sheet 6 of 6
Rev. 22.5.1 Scale as shown
Sepia

ORANGE COUNTY ROAD DEPARTMENT
SANTA ANA AVE.
BRIDGE WIDENING DE-12
ACROSS
SANTA ANA-DELHI CHANNEL
PILE DETAILS

SCALE: NONE

NOV 17 1969